

Indice Index	Data Date	Modificare Modification/Revision	Proiectant Designer	Aprobat Consultant Approved Consultant	Aprobat CFR Approved CFR



**GUVERNUL ROMANIEI
ROMANIAN GOVERNMENT**

**PROIECT FINANȚAT DE UNIUNEA EUROPEANĂ
EUROPEAN UNION FINANCED PROJECT**



C.N.C.F. C.F.R. - S.A.

CLIENT / CLIENT



CONSULTANT / CONSULTANT

			Data Date	Semnătură Signature
Aprobat Approved	Șef proiect Project manager	R. Liuzza	12.2011	
Aprobat Approved	Coordonator Secțiune 1 Section 1 Coordinator	C. Gambelli	12.2011	
Verificat Checked	Expert Verificator Checking Expert	G. Buffarini	12.2011	

SUBCONTRACTANT / SUBCONTRACTOR



	Responsabil Subconsultant Subconsultant Responsible		Data Date	Semnătură Signature
Aprobat Approved	A. Stanciu - Dinulescu		12.2011	
Întocmit Elaborated	Proiectant Designer	D. Dan	12.2011	

Reabilitarea liniei de cale ferată Brașov - Simeria, parte componentă a coridorului IV Pan European, pentru circulația trenurilor cu viteză maximă de 160 km/h,
Tronsonul: Brașov - Sighișoara
Rehabilitation of the railway line Brașov - Simeria, component Part of the IV Pan-European Corridor, for the trains circulation with maximum speed of 160 km/h,
Section: Brașov - Sighișoara

Proiect/Project
2004/RO/16/P/PA/003
Faza / Phase:
P.Th. / T.D.

Denumire desen / Drawing Title:

**Desene de baza generale / Basic design general
Linie de contact / Contact line**

Codificare / Codification System	Scara / Scale	LOT / LOT	Nr. / No 01 / 01
----------------------------------	---------------	-----------	---------------------

E A 5 1 0 1 C 0 0 B X L C 0 0 0 1 0 0 5 1

Nr. Crt.	DENOMINATION	No. BDG	Nr. Revizie
1	CRITERII GENERALE PENTRU DEFINIREA OCS PENTRU LINIA PRINCIPALA GENERAL CRITERIA FOR OCS DEFINITION ON MAIN LINE	01LC00BDG002	0
2	CABLU PURTATOR DIN BRONZ 50mmp MESSENGER BRONZE CABLE 50 mmp	01LC00BDG003	0
3	CRITERII GENERALE PENTRU DEFINIREA OCS PENTRU LINIA SECUNDARA GENERAL CRITERIA FOR OCS DEFINITION SECONDARY LINE	01LC00BDG004	0
4	PROTECTIA STALPILOR DICE PROTECTION	01LC00BDG008	0
5	TIPURI DE STALPI SI REFERINTE MAST TYPES AND REFERENCES	01LC00BDG010	0
6	STALP PENTRU TRAVERSA RIGIDA MAST FOR GANTRY BEAM	01LC00BDG011	0
7	SPECIFICATII PENTRU LIVRAREA STALPILOR H SPECIFICATION FOR SUPPLYING H BEAM	01LC00BDG012	0
8	FIR DE CONTACT 100 mmp CONTACT WIRE 100 mm	01LC00BDG013	0
9	FIR DE CONTACT 80mmp CONTACT WIRE 80mmp	01LC00BDG014	0
10	CABLU DE BRONZ PENTRU PENDULE 10 mmp DROPPER BRONZE CABLE 10 mmp	01LC00BDG015	0
11	CABLU PURTATOR DIN BRONZ 70mmp MESSENGER BRONZE CABLE 70mmp	01LC00BDG016	0
12	CONDUCTOR PENTRU CABLUL COLECTOR 95/15 ACSR 95/15 ACSR WIRE FOR EARTHING CONDUCTOR	01LC00BDG017	0
13	IZOLATOR COMPOZIT DE ANCORARE COMPOSITE ANCHORING INSULATOR	01LC00BDG018	0
14	IZOLATOR COMPOZIT PENTRU TIRANT SI CONTRAFISA COMPOSITE INSULATOR FOR STRUT TUBE AND TOP TUBE	01LC00BDG019	0
15	PENDULA (L>=250mm.) DROPPER (L>=250mm.)	01LC00BDG020	0
16	IZOLATOR DE SECTIONARE SECTION INSULATOR	01LC00BDG021	0
17	CARACTERISTICILE PANTOGRAFULUI PANTOGRAPH ENVELOPE	01LC00BDG028	0
18	LINIA DE CONTACT LA MACAZE SI DIAGONALE CATENARY AT CROSS-OVER AND TURNOUT	01LC00BDG029	0
19	ZONA NEIZOLATA DE ANCORARE UNINSULATED OVERLAPS	01LC00BDG030	0
20	ZONA IZOLATA DE ANCORARE INSULATED OVERLAPS	01LC00BDG031	0
21	ANCORARE MEDIANA IN LINIE DIRECTA MID POINT ANCHOR ON OPEN ROUTE	01LC00BDG032	0
22	ALEGERE ZIG-ZAG CATENARA IN FUNCTIE DE DESCHIDERE STAGGERING OF CONDUCTORS ALLOCATION OF SPANS	01LC00BDG033	0
23	ANCORAREA CONDUCTOARELOR CONDUCTORS ANCHORING	01LC00BDG034	0
24	ECHIPARE TIP CATENARA IN LINIE CURENTA (CONSOLA TENSIONATA) TYPICAL CATENARY EQUIPAMENT ON OPEN ROUTE (PULL OFF ASSEMBLY)	01LC00BDG035	0
25	ECHIPARE TIP CATENARA IN LINIE CURENTA (CONSOLA TENSIONATA) TYPICAL CATENARY EQUIPAMENT ON OPEN ROUTE (PUSH OFF ASSEMBLY)	01LC00BDG036	0
26	ECHIPARE TIP CATENARA (CU DISTANTA INTRE CONSOLE DE 1m) TYPICAL CATENARY EQUIPMENT (WITH EQUIPMENTS SPACING 1m)	01LC00BDG037	0
27	ECHIPARE TIP A CATENAREI PENTRU ZONA DE IZOLATIE MECANICA (DISTANTA INTRE CONSOLE DE 1.60 m) TYPICAL CATENARY EQUIPMENT FOR UNINSULATED OVERLAP AXIS (WITH EQUIPMENTS SPACING 1.60m)	01LC00BDG038	0
28	ECHIPARE TIP A CATENAREI PENTRU STALPII MEDIANI AI ZONEI IZOLATE (DISTANTA INTRE CONSOLE DE 1.60 m) TYPICAL CATENARY EQUIPMENT FOR INSULATED OVERLAP AXIS (WITH EQUIPMENTS SPACING 1.60m)	01LC00BDG039	0
29	ECHIPARE TIP A CATENAREI PE TRAVERSA RIGIDA TYPICAL CATENARY EQUIPMENT ON GANTER BEAM	01LC00BDG040	0
30	MONTAJ TIP PENTRU INCRUCISARE TYPICAL MOUNTING FOR CROSS-OVER	01LC00BDG042	0
31	ANCORA LA NIVEL LEVEL ANCHOR	01LC00BDG047	0
32	ANCORARE CABLU COLECTOR EARTHING CONDUCTOR ANCHORING	01LC00BDG048	0
33	ANCORA SUPRAINALTATA SUPERELEVATED ANCHOR	01LC00BDG049	0
34	LEGATURA LONGITUDINALA LONGITUDINAL CONNECTION	01LC00BDG050	0
35	DEPLASAREA CATENAREI IN LUNGUL LINIEI FUNCTIE DE TEMPERATURA ALONG TRACK MOVEMENT OF EQUIPMENT ACCORDING TO TEMPERARE RANGE	01LC00BDG052	0
36	REGLAJUL CONTRAGREUTATILOR BALANCE WEIGHT SETTINGS	01LC00BDG053	0
37	SUPORT PENTRU FIBRA OPTICA OPTICAL FIBER BRACKET	01LC00BDG054	0
38	SUPORT PENTRU DOUA FIBRE OPTICE BRACKET FOR TWO OPTICAL FIBRES	01LC00BDG055	0


Nr. Crt.	DENOMINATION	No. BDG	Nr. Revizie
39	SUPPORT PENTRU ANCORAREA FIBRAEI OPTICE OPTICAL FIBER BRACKET ANCHORING	01LC00BDG056	0
40	FIXARE PENTRU TIRANT SI CONTRAFISA CU GABARITUL STALPULUI>3.1m FASTENING FOR TOP AND STRUT TUBE WITH OFFSET>3.1m	01LC00BDG057	0
41	FIXARE PENTRU CONTRAFISA FASTERNING FOR STRUT TUBE	01LC00BDG058	0
42	FIXARE PENTRU TIRANT FASTENING FOR TOP TUBE	01LC00BDG059	0
43	TRAVERSA DE TRECERE PENTRU 2 SAU 3 CONTRAFISE (distanța 1m) SPREADER ASSEMBLY FOR 2 OR 3 STRUT TUBES (spacing 1m)	01LC00BDG060	0
44	TRAVERSA DE TRECERE PENTRU 2 SAU 3 TIRANTI (distanța 1m) SPREADER ASSEMBLY FOR 2 OR 3 TOP TUBES (spacing 1m)	01LC00BDG061	0
45	TIRANT IZOLAT Ø 60 INSULATED FOR TOP TUBE Ø 60	01LC00BDG064	0
46	CONTRAFISA IZOLATA Ø 60 INSULATED FOR STRUT TUBE Ø 60	01LC00BDG066	0
47	FIXARE PENTRU TIRANT FASTENING FOR TOP TUBE	01LC00BDG069	0
48	SUPPORT PENTRU 1 SAU 2 CABLURI PURTATOARE SUSPENSION FOR 1 OR 2 MESSENGERS	01LC00BDG070	0
49	CRAPODINA CU SUSTINEREA CABLULUI COLECTOR PENTRU TIRANT FASTENING FOR STRUT TUBE WITH EARTHING CONDUCTOR	01LC00BDG071	0
50	FIXARE PENTRU CABLUL COLECTOR EARTHING CONDUCTOR FASTENING	01LC00BDG072	0
51	TRAVERSA CU SUSTINEREA CABLULUI COLECTOR PENTRU 2 SAU 3 CONTRAFISE (distanța 1m) SPREADER ASSEMBLY FOR 2 OR 3 STRUT TUBES WITH EARTHING CONDUCTOR (spacing 1m)	01LC00BDG078	0
52	TRAVERSA CU SUSTINEREA CABLULUI COLECTOR PENTRU 2 SAU 3 TIRANTI (distanța 1.60m) SPREADER ASSEMBLY FOR 2 OR 3 TOP TUBES WITH EARTHING CONDUCTOR (spacing 1.60m)	01LC00BDG079	0
53	TRAVERSA PENTRU 2 SAU 3 CONTRAFISE (distanța 1.60m) SPREADER ASSEMBLY FOR 2 OR 3 STRUT TUBES (spacing 1.60m)	01LC00BDG080	0
54	TRAVERSA CU SUSTINEREA CABLULUI COLECTOR PENTRU 2 SAU 3 CONTRAFISE (distanța 1.60m) SPREADER ASSEMBLY FOR 2 OR 3 STRUT TUBES WITH EARTHING CONDUCTOR (spacing 1.60m)	01LC00BDG081	0
55	TRAVERSA PENTRU 2 SAU 3 TIRANTI (distanța 1.40m) SPREADER ASSEMBLY FOR 2 OR 3 TOP TUBES (spacing 1.40m)	01LC00BDG082	0
56	BARA DE RIGIDIZARE AUXILIARY STRUT TUBE	01LC00BDG083	0
57	ANSAMBLU DE FIXARE ROTATIV ROTATING FASTENING ASSEMBLY	01LC00BDG084	0
58	SUPPORT PENTRU FIBRA OPTICA SUPPORT FOR OPTICAL FIBER	01LC00BDG086	0
59	CONTRASUPPORT PENTRU FIBRA OPTICA COUNTERPLATE FOR OPTICAL FIBER	01LC00BDG087	0
60	SUPPORT PENTRU BALAMA HINGE SUPPORT	01LC00BDG088	0
61	TRAVERSA (distanța 1m) SPREADER (spacing 1m)	01LC00BDG089	0
62	CONTRASUPPORT PENTRU TIRANT SI CONTRAFISA COUNTREREPLATE FOR TOP AND STRUT TUBE	01LC00BDG090	0
63	CONTRASUPPORT PENTRU SPREADER (PENTRU HE200 LA HE320 COUNTERPLATE FOR SPREADER (FOR HE200 TO HE320)	01LC00BDG094	0
64	TEAVA Ø60-4 PENTRU TIRANT Ø60-4 TUBE FOR TOP TUBE	01LC00BDG095	0
65	TEAVA Ø49-4.5 PENTRU FIXARE FIXATOR Ø49-4.5 TUBE FOR STEADY ARM FASTENING	01LC00BDG100	0
66	TEAVA Ø60-4 PENTRU CONTRAFISA Ø60-4 TUBE FOR STRUT TUBE	01LC00BDG101	0
67	CONTRASUPPORT CU FIXAREA CABLULUI COLECTOR COUNTERPLATE WITH EARTHING CONDUCTOR	01LC00BDG102	0
68	SUPPORT PENTRU DOUA FIBRE OPTICE SUPPORT FOR TWO OPTICAL FIBERS	01LC00BDG106	0
69	SUPPORT PENTRU ANCORAREA FIBREI OPTICE SUPPORT FOR OPTICAL FIBER ANCHORING	01LC00BDG107	0
70	CONTRASUPPORT PENTRU ANCORAREA FIBREI OPTICE COUNTERPLATE FOR OPTICAL FIBER ANCHORING	01LC00BDG113	0
71	SUPPORT BALAMA PENTRU 2 SAU 3 CONSOLE HINGE SUPPORT FOR 2 OR 3 TUBES	01LC00BDG114	0
72	TRAVESRA (distanța 1.60m) SPREADER (spacing 1.60m)	01LC00BDG115	0
73	TEAVA Ø28-3 TUBE Ø28-3	01LC00BDG116	0
74	SUPPORT ROTATIV ROTATING STAND OFF BRACKET	01LC00BDG117	0
75	FLANSA ROTATIVA PENTRU TEAVA Ø60-4 ROTATING HALF FLANGE FOR TUBE Ø60-4	01LC00BDG118	0
76	FIXARE L=900 PENTRU TIRANT SI CONTRAFISA FASTENING FOR TOP AND STRUT TUBE L=900	01LC00BDG120	0
77	ANSAMBLU TRAVERSA RIGIDA PE STALP ASSEMBLIES GANTRY BEAM ON MAST	01LC00BDG121	0
78	CONTRASUPPORT PENTRU TRAVERSA RIGIDA COUNTERPLATE FOR GANTRY BEAM	01LC00BDG122	0
79	CONTRASUPPORT COUNTERPLATE	01LC00BDG129	0

Nr. Crt.	DENOMINATION	No. BDG	Nr. Revizie
80	TENSOR ANCORARE ANCHOR TIE ROD	01LC00BDG130	0
81	CONTRASUPPORT PENTRU CABLUL COLECTOR ANGLE FOR EARTHING ANCHORING	01LC00BDG131	0
82	TRAVERSA PENTRU ANCORĂ LA NIVEL LEVEL ANCHOR BEAM	01LC00BDG132	0
83	CONTRASUPPORT PENTRU CABLU COLECTOR COUNTERPLATE FOR EARTHING ANCHORING	01LC00BDG133	0
84	FIXARE TIRANT SI CONTRAFISA PENTRU GABRIT>4.10M FASTENING FOR TOP TUBE AND STRUT TUBE WITH OFFSET>4.10M	01LC00BDG134	0
85	CRAPODINA PENTRU TIRANT CU SUTINEREA CABLULUI COLECTOR FASTENING FOR TOP TUBE WITH EARTHING CONDUCTOR	01LC00BDG135	0
86	TRAVERSA PENTRU 2 SAU 3 TIRANTI CU SUTINEREA CABLULUI COLECTOR SPREADER ASSEMBLY FOR 2 OR 3 TOP TUBES WITH EARTHING CONDUCTOR	01LC00BDG136	0
87	CRAPODINA PENTRU TIRANT CU FIXAREA CABLULUI COLECTOR FASTENING FOR TOP TUBE WITH EARTHING CONDUCTOR	01LC00BDG137	0
88	TRAVERSA PENTRU 2 SAU 3 TIRANTI CU FIXAREA CABLULUI PURTATOR SPREADER ASSEMBLY FOR 2 OR 3 TOP TUBES WITH EARTHING CONDUCTOR	01LC00BDG138	0
89	CARPODINA PENTRU CONTRAFISA PENTRU STALP MU (300X120) FASTENING FOR STRUT TUBE FOR MU (300X120)	01LC00BDG139	0
90	FIXARE PENTRU ANCORAREA CABLULUI COLECTOR PENTRU STALP HEA SAU HEB 200 LA 240 FASTENING FOR ANCHORING OF EARTH CONDUCTOR FOR MAST HEA OR HEB 200 TO 240	01LC00BDG140	0
91	PREZON THREADED ROD	01LC00BDG141	0
92	SAIBA WASHER	01LC00BDG142	0
93	BOLT TIP U U-BOLT	01LC00BDG143	0
94	BOLT BOLT	01LC00BDG144	0
95	SPLINT SPLIT PIN	01LC00BDG145	0
96	AX AXIS	01LC00BDG146	0
97	PORTFIXATOR ϕ 34-4 CU FIXATOR 0.9m PENTRU LINIE DREAPTA ϕ 34-4 REGISTRATION ARM WITH 0.9m STEADY ARM FOR STRAIGHT LINE	01LC00BDG150	0
98	PORTFIXATOR ϕ 34-4 CU FIXATOR 1.1m PENTRU LINIE CURBA ϕ 34-4 REGISTRATION ARM WITH 1.1m STEADY ARM FOR CURVE	01LC00BDG151	0
99	PORTFIXATOR ϕ 34-4 CU FIXATOR 1.1m PENTRU ZONA IZOLATA ϕ 34-4 REGISTRATION ARM WITH 1.1m STEADY ARM FOR INSULATED OVERLAP	01LC00BDG152	0
100	PORTFIXATOR ϕ 34-4 CU FIXATOR 1.1m PENTRU INCRUCISARE ϕ 34-4 REGISTRATION ARM WITH 1.1m STEADY ARM FOR CROSS-OVER	01LC00BDG153	0
101	ANCORAREA RIGIDA A CATENAREI CATENARY RIGID ANCHORING	01LC00BDG154	0
102	ANCORARE MEDIANA MID POINT ANCHORING	01LC00BDG155	0
103	SUPPORT SUPPORT	01LC00BDG156	0
104	AX SUPORT COGWHEEL SUPORT AXIS	01LC00BDG157	0
105	PLACA PLATE	01LC00BDG158	0
106	PLACA PLATE	01LC00BDG159	0
107	PROFIL II FRAME II	01LC00BDG165	0
108	PROFIL II FRAME II	01LC00BDG168	0
109	PROFIL II FRAME II	01LC00BDG171	0
110	CONTRAGREUTATE DIN BETON CONCRETE COUNTERWEIGHT	01LC00BDG172	0
111	CONTRAGREUTATE DIN FONTA CAST IRON COUNTERWEIGHT	01LC00BDG173	0
112	OCHI TIP I EYE I	01LC00BDG174	0
113	OCHI TIP II EYE II	01LC00BDG175	0
114	DISPOZITIV CU 3 PRINDERI 3 PIN CLEVIS	01LC00BDG179	0
115	CLEMA DE PRINDERE IN COLT CORNER CRAMP	01LC00BDG180	0
116	ANCORAREA TOTAL COMPENSATA A CATENAREI FULL COMPENSATED CATENARY ANCHORING	01LC00BDG182	0
117	FIXARE SUPERIOARA PENTRU MU 10-5/8.2 SAU STALP HEB UPPER FASTENING FOR MU 10-5/8.2 OR HEB POLE	01LC00BDG183	0
118	FIXARE SUPERIOARA PENTRU STALP SECP6 UPPER FASTENING FOR SECP6 POLE	01LC00BDG184	0
119	FIXARE SUPERIOARA PENTRU STALP SMT273 UPPER FASTENING FOR SMT273 POLE	01LC00BDG185	0
120	AX SUPORT COGWHEEL SUPORT AXIS	01LC00BDG186	0

Nr. Crt.	DENOMINATION	No. BDG	Nr. Revizie
121	GHIDAJ GUIDEWAY	01LC00BDG187	0
122	BARA BAR	01LC00BDG188	0
123	LEGATURA CU 3 GAURI THREE PIN STRAP	01LC00BDG189	0
124	SURUB SCREW	01LC00BDG190	0
125	CAPAC COVER	01LC00BDG191	0
126	PRINDERE RASUCITA CU OCHI CLEVIS WITH EYE TWISTED	01LC00BDG192	0
127	FIXARE INFERIOARA PE STALP HEB SAU MU INFERIOR FASTENING ON HEB OR MU POLE	01LC00BDG193	0
128	PROFIL I FRAME I	01LC00BDG194	0
129	FIXARE INFERIOARA PENTRU STALP SECP6 INFERIOR FASTENING ON SECP6 POLE	01LC00BDG195	0
130	PROFIL I FRAME I	01LC00BDG196	0
131	FIXARE INFERIOARA PENTRU STALP SMT INFERIOR FASTENING ON SMT POLE	01LC00BDG197	0
132	PROFIL I FRAME I	01LC00BDG198	0
133	ZONA NEUTRA NEUTRAL SECTION	01LC00BDG199	0
134	CADRU PENTRU CONTRAGREUTATI DIN BETON CADRE FOR CONCRETE COUNTERWEIGHTS	01LC00BDG201	0
135	BARA PENTRU CONTRAGREUTATI DIN FONTA ROD FOR CAST IRON COUNTERWEIGHTS	01LC00BDG202	0
136	FIXARE CABLUL COLECTOR PENTRU STALP MU EARTHING CONDUCTOR FASTENING FOR MU POLE	01LC00BDG203	0
137	FIXARE PENTRU ANCORAREA CABLULUI COLECTOR PENTRU STALP MU FASTENING FOR ANCHORING OF EARTH CONDUCTOR FOR MU POLE	01LC00BDG204	0
138	ANCORARE MEDIANA PENTRU STALP MU MID POINT ANCHORING ON MU POLES	01LC00BDG205	0
139	PROFIL PENTRU ANCORAREA RIGIDA PE STALP MU ANGLE FOR RIGID ANCHORING ON MU POLE	01LC00BDG206	0
140	PLACA PLATE	01LC00BDG209	0
141	ECHIPARE TIP PENTRU CATENARA CU FIXARE PENTRU 2 CONSOLE L=900 TYPICAL CATENARY EQUIPMENT WITH FASTENING FOR 2 CANTILEVER L=900	01LC00BDG210	0
142	FIXARE TIRANT PENTRU 2 CONSOLE L=900 FASTENING FOR TOP TUBE FOR 2 CANTILEVER L=900	01LC00BDG211	0
143	FIXARE CONTRAFISA PENTRU 2 CONSOLE L=900 FASTENING FOR STRUT TUBE FOR 2 CANTILEVER L=900	01LC00BDG212	0
144	FIXARE PENTRU 2 CONSOLE L=900 FASTENING FOR 2 CANTILEVER L=900	01LC00BDG213	0
145	INTINZATOR TURNBUCKLE	01LC00BDG214	0
146	CORP INTINZATOR TURNBUCKLE BOADY	01LC00BDG215	0
147	BARA CU URECHE ROD WITH CLEVIS	01LC00BDG216	0
148	BARA CU OCHI ROD WITH EYE	01LC00BDG217	0
149	MONTARE IZOLATOR DE SECTIONARE IN ZONA MACAZURILOR SECTION INSULATOR MOUNTING ON TURN-OUT	01LC00BDG220	0
150	PIESA DE EXTENSIE PENTRU STALP H EXTENSION PIECE FOR H POLES	01LC00BDG222	0
151	MONTARE TIP ECHIPAMENT MEDIAN PENTRU LINIE CURENTA (ANSAMBLU TENSIONAT) TYPICAL MID POINT EQUIPMENT ON OPEN ROUTE (PULL OF ASSEMBLY)	01LC00BDG230	0
152	MONTARE TIP ECHIPAMENT MEDIAN PENTRU LINIE CURENTA (ANSAMBLU COMPRIMAT) TYPICAL MID POINT EQUIPMENT ON OPEN ROUTE (PUSH OFF ASSEMBLY)	01LC00BDG231	0
153	VARFAR CU INEL PENTRU FIBRA OPTICA SURELEVATED SUPPORT FOR OPTICAL FIBER WITH RING	01LC00BDG250	0
154	VARFAR CU ROLA PENTRU FIBRA OPTICA SURELEVATED SUPPORT FOR OPTICAL FIBER WITH PULLEY	01LC00BDG251	0
155	SUPPORT PENTRU FIBRA OPTICA SUPPORT FOR OPTICAL FIBER	01LC00BDG252	0
156	BOLT STRUT	01LC00BDG253	0
157	CONTRASUPPORT COUNTERPLATE	01LC00BDG254	0
158	CONEXIUNE DE IMPAMANTARE EARTH CONNECTION	01LC00BDG260	0
159	CONTRASUPPORT SPECIAL SPECIAL COUNTERPLATE	01LC00BDG261	0
160	ANSAMBLU SUPPORT PENTRU FIBRA OPTICA OPTICAL FIBER SUPPORT ASSEMBLY	01LC00BDG270	0
161	SUPPORT FIBRA OPTICA OPTICAL FIBER SUPPORT	01LC00BDG271	0

Nr. Crt.	DENOMINATION	No. BDG	Nr. Revizie
162	PORTFIXATOR $\varnothing 42 \times 4$ CU FIXATOR 1.1m PENTRU LINIE CURBA $\varnothing 42 \times 4$ REGISTRATION ARM WITH 1.1m STEADY ARM FOR CURVE	01LC00BDG272	0
163	ATASAMENT PENTRU FIXATOR $\varnothing 34$ STEADY ARM BRACKET ATTACHMENT $\varnothing 34$	01LC00BDG273	0
164	SUPORT PENTRU REZERVA DE FIBRA OPTICA (pentru joctiune FO) SUPPORT FOR RESERVE OF OPTICAL FIBER (for OF junction)	01LC00BDG275	0
165	SUPORT FIBRA OPTICA (pentru jonctiune FO) OPTICAL FIBER SUPPORT (for OF junction)	01LC00BDG276	0
166	SUPORT FIBRA OPTICA PENTRU JONCTIUNE OPTICAL FIBER SUPPORT FOR PLUG JUNCTION	01LC00BDG277	0
167	CONTRASUPORT PENTRU FIXARE JONCTIUNE COUNTERPLATE FOR OF PLUG JUNCTION	01LC00BDG278	0
168	PANA TIP II	E-LC 2 - 3.3	0
169	CLEMA DE LEGATURAPENTRU CONDUCTOARE DE PUNERE LA PAMANT	E-LC 2 - 4.0	0
170	FALCA CLEMEI	E-LC 2 - 4.1	0
171	COLIER	ELC 5 - 4B	0
172	CLEMA TERMINALA CU PANA SI FURCA	E-LC 9.29.0	0
173	CORP	E-LC 9.29.1	0
174	PANA TIP I	E-LC 9.29.2	0
175	CONTRAFISA CU IZOLATOR	E-LC 13 - 1.2.0	0
176	BRIDA CU CERCEL	E-LC 13 - 1.2.3.0	0
177	URECHE NESECTIONATA	E-LC 13 - 1.2.3.1	0
178	BRATARA	E-LC 13 - 1.2.3.2	0
179	BRATARA CU PIVOT	ELC 13 - 1.3.1A	0
180	CERCEL	E-LC 13 - 1.3.2.0	0
181	SA TIP I	E-LC 13 - 1.4.0	0
182	SA-I	ELC 13 - 1.4.0A	0
183	SA-II	ELC 13 - 1.4.0B	0
184	SA I	ELC 13 - 1.4.1A	0
185	ETRIER	ELC 13 - 1.4.2A	0
186	FILIERA	ELC 13 - 1.4.3A	0
187	FILIERA PENTRU UN CABLU	E-LC 13 - 1.4.6	0
188	FILIERA PENTRU 2 CABLURI	E-LC 13 - 1.4.9	0
189	SURUB	E-LC 13 - 3.3.8	0
190	BALAMA PENTRU TIRANT	ELC 13 - 9.10 A	0
191	BALAMA PENTRU CONTRAFISA	ELC 13 - 9.11 A	0
192	CRAPODINA PENTRU O CONSOLA SIMPLA PE PINTEN	ELC 13 - 13.0A	0
193	SUPORT	ELC 13 - 13.1A	0
194	BRIDA	E-LC 13 - 13.2	0
195	BRIDA	ELC 13 - 13.3B	0
196	CONTRAFISA	ELC 13 - 14.0B	0
197	CAPAC CU FURCA	ELC 13 - 14.7.0B	0
198	PORTFIXATOR DREPT	ELC 13 - 15.0 B	0
199	PORTFIXATOR $\varnothing 42-4$	ELC 13 - 15.0 BM	0
200	STUT	ELC 13 - 15.3 BM	0
201	BRIDA	ELC 13 - 15.6 BM	0
202	PASTILA	ELC 13 - 15.7 BM	0
203	SAIBA DE COLT	E-LC 16 - 12.3.0	0
204	SUPORT	E-LC 16 - 12.3.1	0
205	SAIBA SFERICA	E-LC 16 - 12.3.2	0
206	MUFA 1" CU CERCEL	E-LC 26 - 4.7.0	0
207	MUFA	E-LC 26 - 4.7.1	0
208	MUFA 1" CU PINTEN SI OCHI	E-LC 27 - 4.8.0	0
209	MUFA	E-LC 27 - 4.8.1	0
210	SAIBA SFERICA	E-LC 31 - 5	0
211	MUFA TERMINALA 1" CU CARLIG	E-LC 32 - 2.2	0
212	STUT	E-LC 32 - 2.4	0
213	DOP	ELC 32 - 9.2A	0
214	MUFA TERMINALA 3/4" CU CARLIG	E-LC 32 - 9.3	0
215	CLEMA DE FIXARE PREIN SERTIZARE PE FIR TTF100	ELC 32 - 9.5.5.0B	0
216	FALCA CLEMA	ELC 32 - 9.5.5.1B	0
217	CIOC	ELC 32 - 9.6A	0
218	DISTANTIER	ELC 32 - 9.11.6B	0
219	FIXATOR CURBAT DC	ELC 32 - 10.0A	0
220	FIXATOR CURBAT PENTRU ACE DCA	ELC 32 - 11.0A	0
221	FIXATOR CURBAT PENTRU STALPUL MEDIAN DCM	ELC 32 - 12.0A	0
222	FIXATOR DE ANCORARE A	ELC 32 - 13.0A	0
223	CIOC FILETAT	ELC 32 - 13.6A	0
224	MUFA	ELC 32 - 13.7A	0
225	PLACA DE REGLARE	E-LC 49 - 17	0
226	TRAVERSA PENTRU SECP6	ELC 50 - 3.1A	0
227	TRAVERSA PENTRU mu10-5/8.2 SI HEB	ELC 50 - 4.1A	0
228	TRAVERSA PENTRU SMT273	ELC 50 - 5.1A	0
229	TRAVERSA	ELC 50 - 13.1A	0
230	TRAVERSA	ELC 50 - 14.1A	0
231	TRAVERSA	ELC 50 - 15.1A	0
232	SCOABA	E-LC 51 - 22	0
233	ANCORA SPECIALA AS	ELC-CFO 1 - 6.0	0

Nr. Crt.	DENOMINATION	No. BDG	Nr. Revizie
234	RODANTA	ELC-CFO 1 - 8	0
235	CLEMA DE LEGARE CU TREI SURUBURI	ELC-CFO 1 - 12.0	0
236	FALCA CLEMA	ELC-CFO 1 - 12.1	0
237	CARLIG	ELC-CFO 3-15.0	0
238	CARLIG TIP A	ELC-CFO 3 - 15.0B	0
239	CARLIG	ELC-CFO 3 - 15.1B	0
240	ANCORAREA CONDUCTORULUI COLECTOR IN LINIE CURENTA	EP 2610 - 4.0A	0
241	SEMIBRIDA	EP 2610 - 4.1A	0
242	CLEMA DE LEGATURA PENTRU CABLUL PURATATOR	LECP 00	0
243	CLEMA DE LEGATURA PENTRU FIRUL DE CONTACT	LEFC 00	0

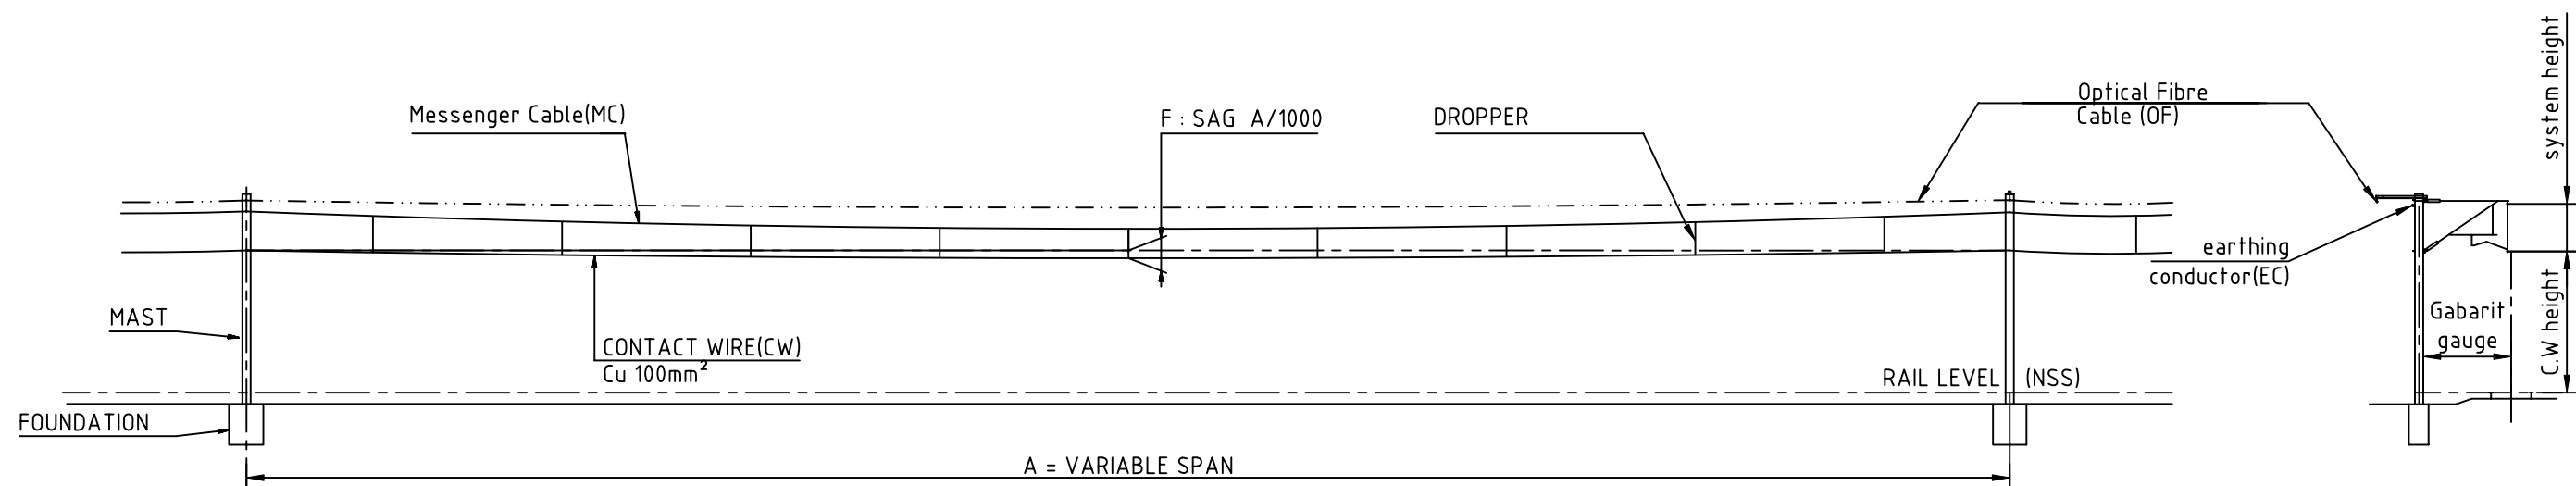


CATENARY CHARACTERISTICS

CONSTITUTION OF OVERHEAD SYSTEM FOR MAIN LINE					
DESCRIPTION	DESIGNATION	NOMINAL CROSS SECTION	TENSION APPLIED	METHOD OF TENSIONNING	
1 messenger Cable	Bz 70	65.81mm ²	1000 daN	Auto tensioning	from -33°C to +32°C average temp.: +9°C
1 contact wire	Cu 100	100 mm ²	1000 daN	Auto tensioning	
1 earthing conductor	95/15 ACSR	105 mm ²	1000 daN	Fixed tensioning	

CATENARY CONDUCTIVITY

Description	Conductivity	Copper Standard
1 messenger Cable	72%	47.38 mm ²
1 contact wire	98%	98.00 mm ²
	Total	145.38 mm²

CRITERII GENERALE PENTRU DEFINIREA OCS PENTRU LINIA PRINCIPALA GENERAL CRITERIA FOR OCS DEFINITION ON MAIN LINE	Numele fisierului/ CAD file name:	Scara/ Scale:	Part	Rev.
	01LC00BDG002		1 / 1	0

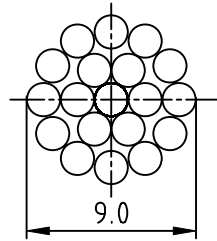

50mm ² Bronze Cable for messenger		
Specification designation	Unit	Specified value
Wire designation	N/A	BZ 50
Composition and make up	N/A	19x1.8mm
Raw material	N/A	BZ II
Nominal diameter	mm	9.0
Nominal cross section	mm ²	48.35
Wire lay	N/A	
Thermic linear expansion coefficient	m/m.°C	0.000017
Mechanical extension coefficient	m/N	0.000118
Conductivity(%equivalent Copper)	%	72
Weight per meter	kg/m	0.438
Minimum breaking load	kN	28.39
Applicable standard	N/A	DIN 48 201

joints are not allowed (even by welding or hard silver soldering)

Notes:

*Cable to be delivered on wood drums closed with flanges

*Quantity (in meter) on each drum to be allocated and provided with purchase order

*Product marking label to display:

Compania Nationala de Cai Ferate


Rehabilitation of OCS Contract Lot

Wire designation : BZ 50

Wire actual length : (m)

CABLU PURTATOR DIN BRONZ 50mmp
MESSENGER BRONZE CABLE 50 mmp

Numele fisierului/ CAD file name:	Scara/ Scale:	Part	Rev.
01LC00BDG003	-	1 / 1	0

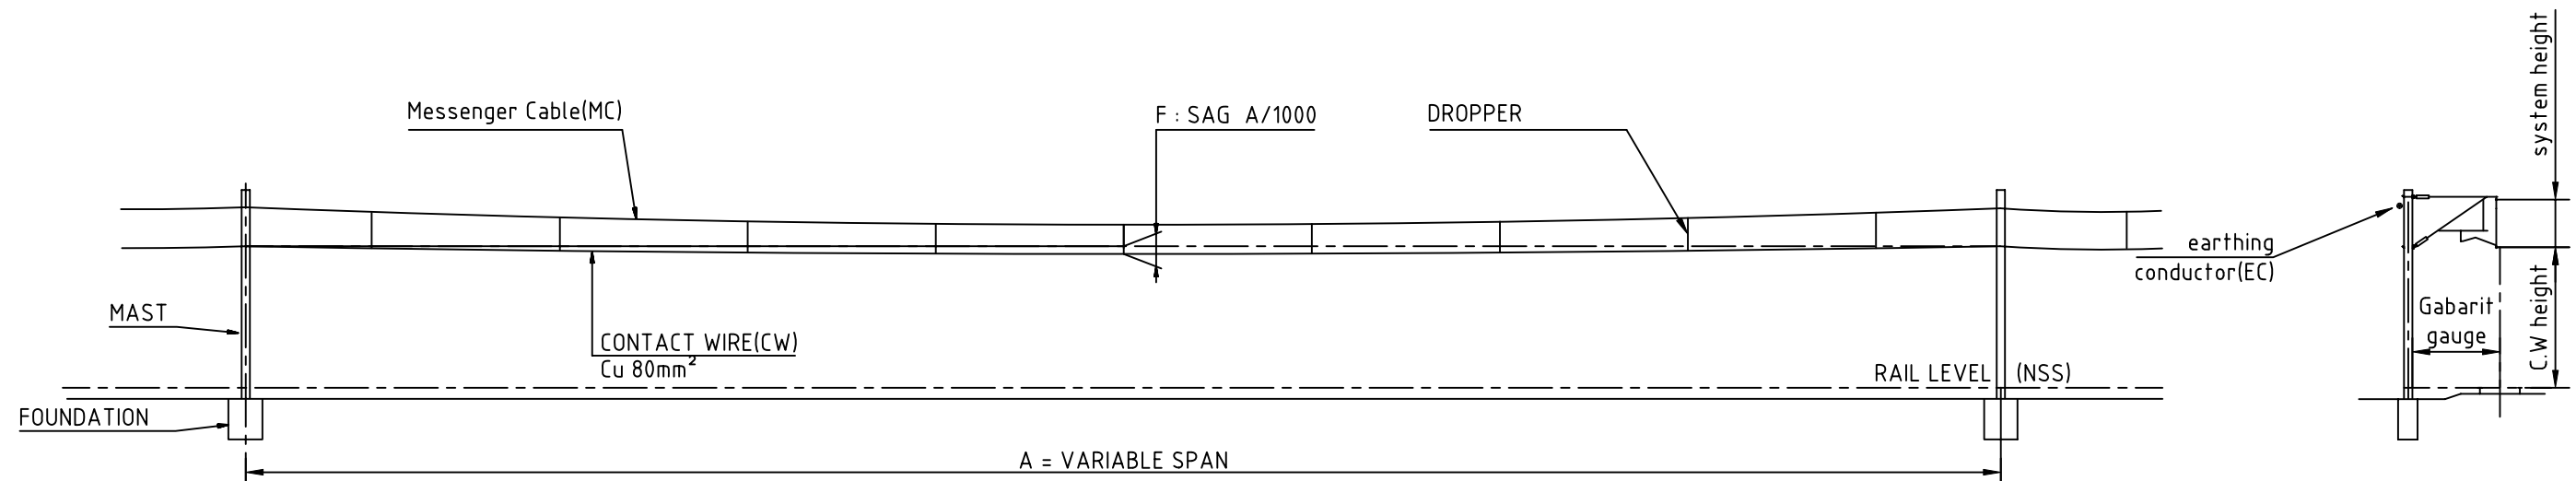

CATENARY CHARACTERISTICS



CONSTITUTION OF OVERHEAD SYSTEM FOR SECONDARY LINE					
DESCRIPTION	DESIGNATION	NOMINAL CROSS SECTION	TENSION APPLIED	METHOD OF TENSIONNING	
1 messenger cable	Bz 50	48.35 mm ²	1000 daN	Auto tensioning	from -33°C to +40°C
1 contact wire	Cu 80	80 mm ²	1000 daN	Auto tensioning	average temp.: +15°C
1 earthing conductor	95/15 ACSR	105 mm ²	1000 daN	Fixed tensioning	

CATENARY CONDUCTIVITY

Description	Conductivity	Copper Standard
1 messenger cable	72%	34.81 mm ²
1 contact wire	98%	78.40 mm ²
	Total	113.21 mm ²

CRITERII GENERALE PENTRU DEFINIREA OCS PENTRU LINIA SECUNDARA GENERAL CRITERIA FOR OCS DEFINITION SECONDARY LINE	Numele fisierului/ CAD file name:	Scara/ Scale:	Part	Rev.
	01LC00BDG004		1 / 1	0



STANDARD DICE PROTECTION

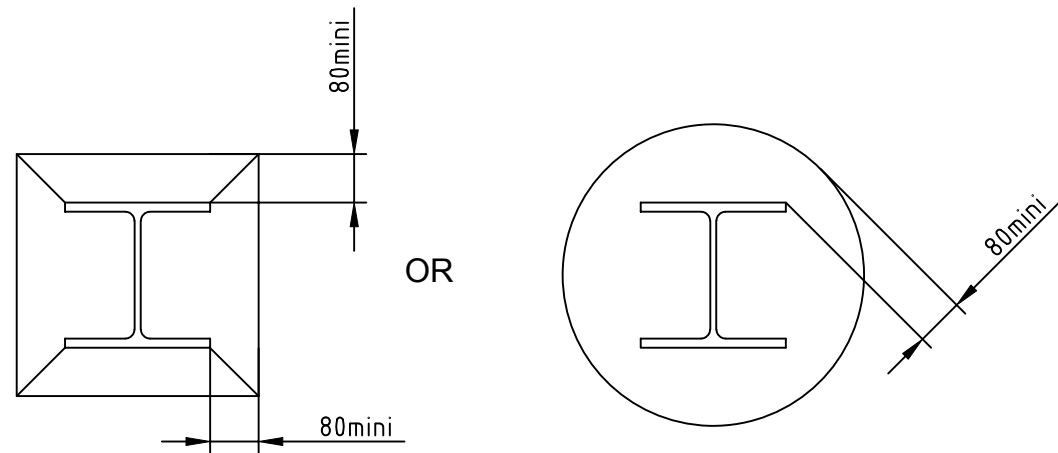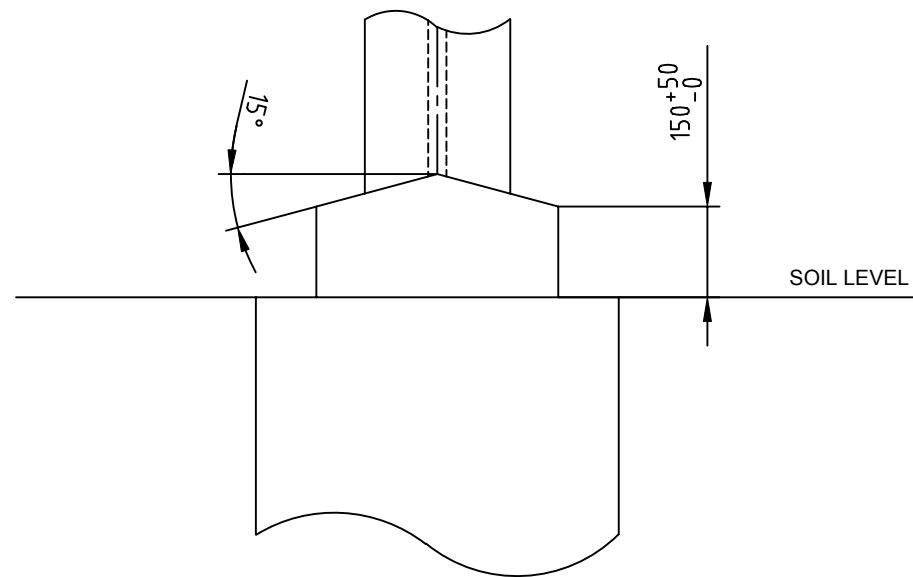

NOTE :

- THE DICE PROTECTION WILL BE DONE AFTER CATENARY INSTALLATION (LOADED MAST)
- THE DICE PROTECTION MAKING IS FORBIDDEN DURING RAINING WEATHER
- BEFORE INSTALLATION , THE FOUNDATION SURFACE MUST BE CLEANED AND PRICKED
- MORTAR CEMENT : 350 kg OF CEMENT / m³

ELEVATED DICE PROTECTION

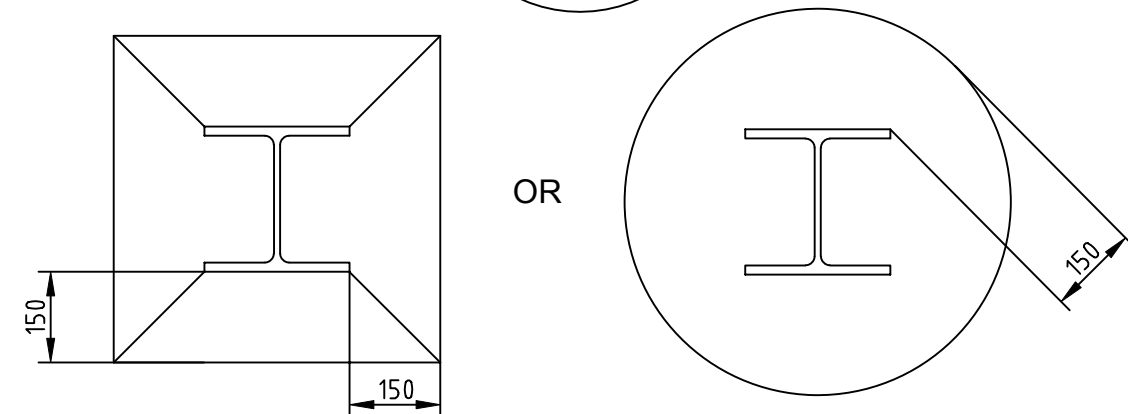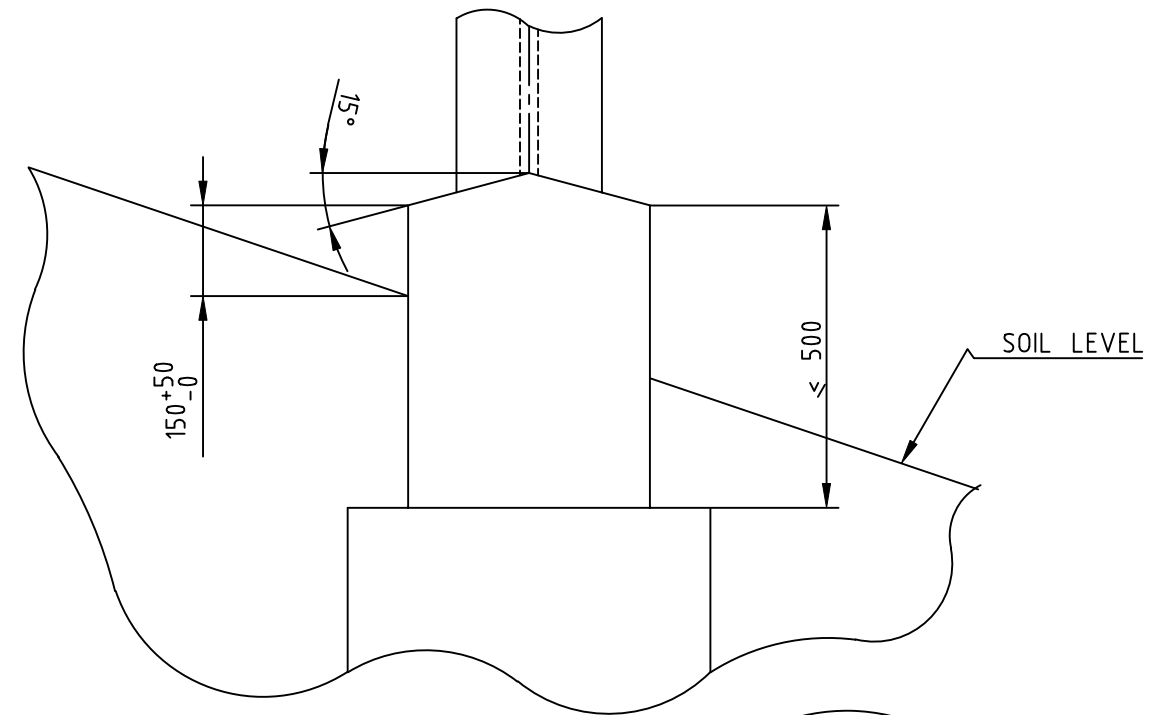

PROTECTIA STALPILOR
DICE PROTECTION

Numele fisierului/
CAD file name:
01LC00BDG008


Scara/
Scale:

Part


Rev.

1 / 1

0

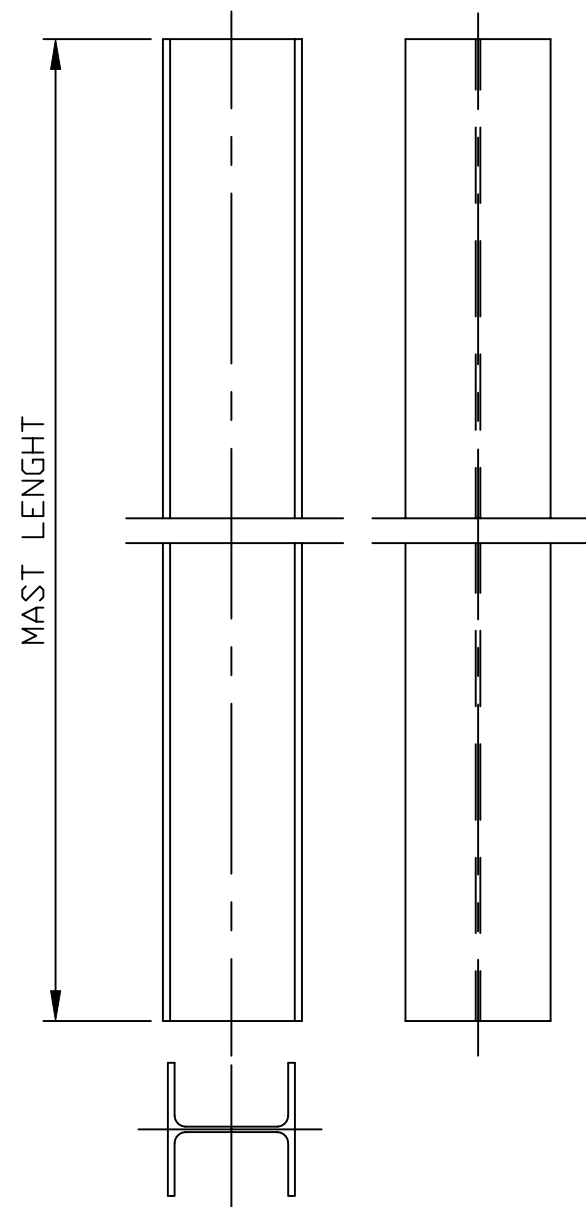

THE EXPLANATION OF EACH DIGIT IS AS FOLLOWS :

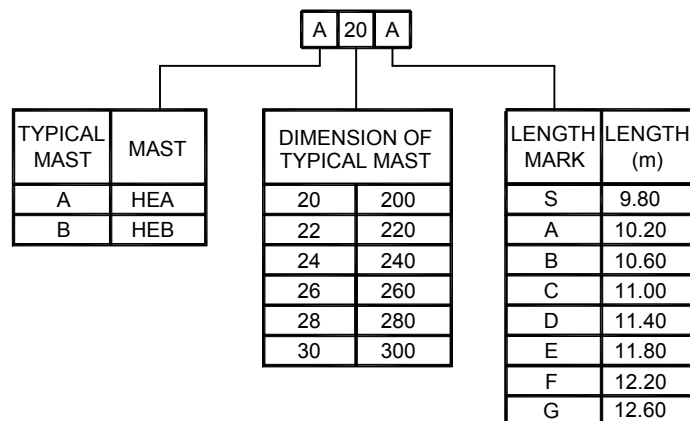

HEA 200		
MARK	LENGTH (m)	MASS (kg)
A20S	9.80	415
A20A	10.20	431
A20B	10.60	448
A20C	11.00	465
A20D	11.40	482

HEA 220		
MARK	LENGTH (m)	MASS (kg)
A22S	9.80	495
A22A	10.20	515
A22B	10.60	535
A22C	11.00	556
A22D	11.40	576

HEA 240		
MARK	LENGTH (m)	MASS (kg)
A24S	9.80	591
A24A	10.20	615
A24B	10.60	639
A24C	11.00	663
A24D	11.40	687

HEA 260		
MARK	LENGTH (m)	MASS (kg)
A26A	10.20	696
A26B	10.60	723
A26C	11.00	750
A26D	11.40	777

HEA 280		
MARK	LENGTH (m)	MASS (kg)
A28A	10.20	779
A28B	10.60	810
A28C	11.00	840
A28D	11.40	871

HEB 240		
MARK	LENGTH (m)	MASS (kg)
B24A	10.20	849
B24B	10.60	882
B24C	11.00	915
B24D	11.40	948
B24E	11.80	982
B24F	12.20	1015
B24G	12.60	1049


HEB 260		
MARK	LENGTH (m)	MASS (kg)
B26A	10.20	949
B26B	10.60	986
B26C	11.00	1023
B26D	11.40	1060
B26E	11.80	1097
B26F	12.20	1134
B26G	12.60	1171

HEB 280		
MARK	LENGTH (m)	MASS (kg)
B28A	10.20	1051
B28B	10.60	1092
B28C	11.00	1133
B28D	11.40	1175
B28E	11.80	1216
B28F	12.20	1257
B28G	12.60	1298

HEB 300		
MARK	LENGTH (m)	MASS (kg)
B30A	10.20	1193
B30B	10.60	1240
B30C	11.00	1287
B30D	11.40	1334
B30E	11.80	1381
B30F	12.20	1427
B30G	12.60	1474

01LC00BDG011		MAST FOR GANTRY BEAM	Material: min S235JR Hot galvanized AT/DL/Zn 500-STAS 7221-90	
DRAWING NUMBER	MARK	DESIGNATION	MATERIAL TECHNICAL SPECIFICATION	UNIT MASS kg

TIPURI DE STALPI SI REFERINTE MAST TYPES AND REFERENCES	Numele fisierului/ CAD file name:	Scara/ Scale:	Part	Rev.
	01LC00BDG010		1 / 1	0

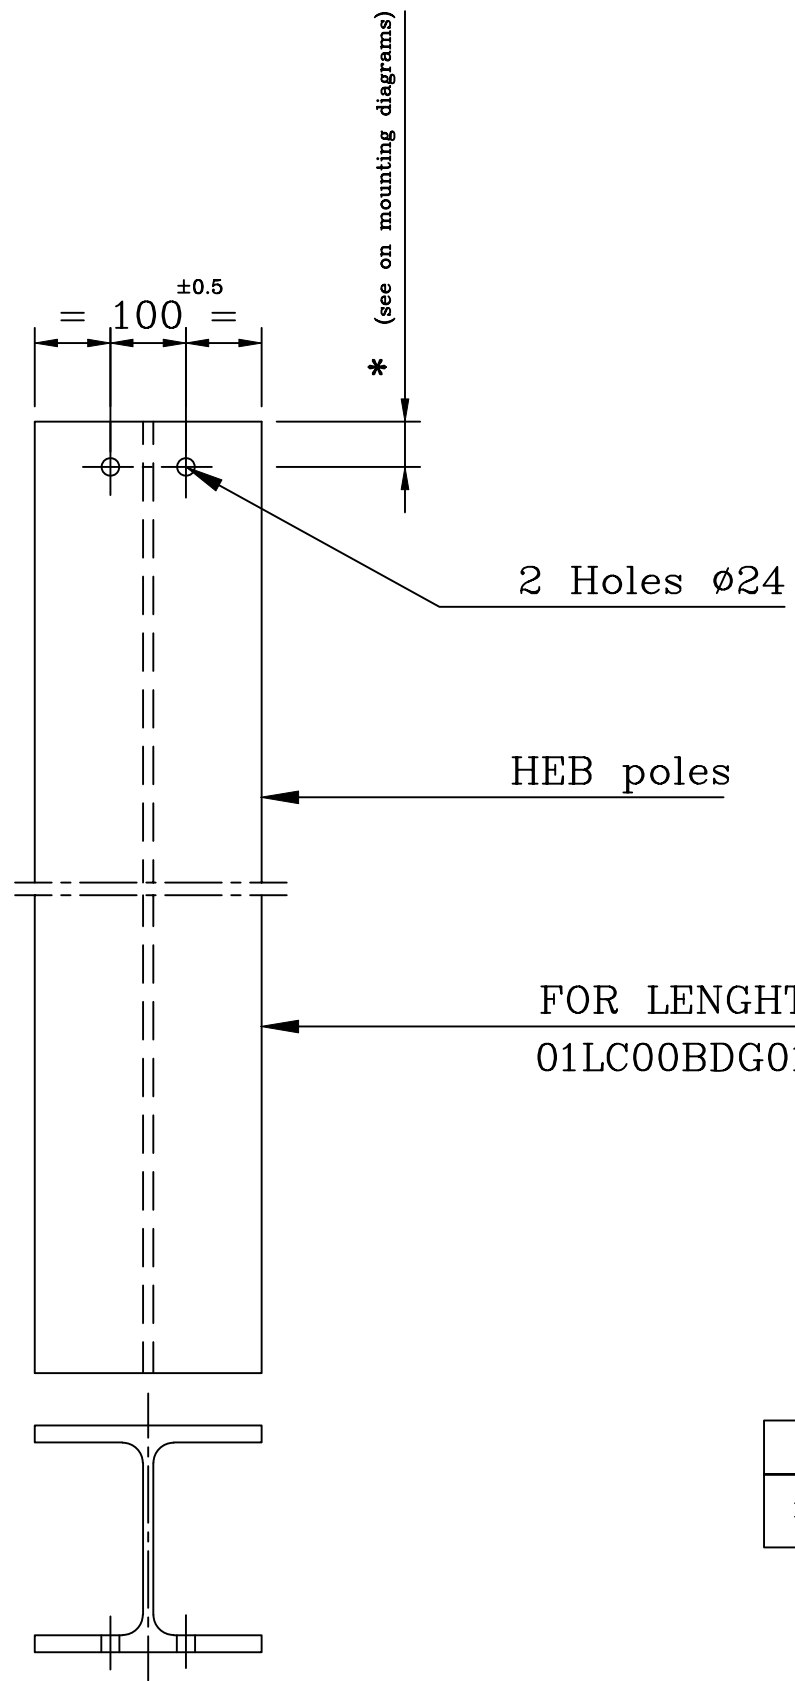

2 Holes $\phi 24$

HEB poles

FOR LENGHT SEE DRAWING:
01LC00BDG010

01LC00BDG011		MAST FOR GANTRY BEAM	Material: min S235JR Hot galvanized AT/DL/Zn 500-STAS 7221-90	
DRAWING NUMBER	MARK	DESIGNATION	MATERIAL TECHNICAL SPECIFICATION	UNIT MASS kg

STALP PENTRU TRAVERSA RIGIDA
MAST FOR GANTRY BEAM

Numele fisierului/
CAD file name:
01LC00BDG011

Scara/ Scale:	Part	Rev.
	1 / 1	0

1) H BEAMS NOT GALVANIZED

- STEEL SUITED FOR GALVANIZATION-CLASS 2 FOLLOWING NF A 35503

- STANDARDS:

NF A 35.503

NF A 45.201

NF EN 10034

NF EN 10.163-3 CLASS C SUBCLASS 3

- TOLERANCE ON THE LENGTH : $\begin{matrix} +100 \text{ mm} \\ 0 \end{matrix}$

HOLLOW MARKING ON EXTREMITIES :

- SET OF INITIALS OF MANUFACTURER

- CASTING NUMBER

- RAW MATERIAL

ALLOWABLE SEAMS

2 mm OR 20% OF t 1 OR t 2 ; THE SMALLER OF THE TWO VALUES IS REQUIRED.

ANGLE OF CUT

MAXI 2% OF HEIGHT H AND OF THE WIDTH B.

DELIVERY STATE

NO PAINT, NO GREASE, NO OIL.

2) BEAMS GALVANIZED

- BEAMS SHOWING AFTER GALVANIZING A SAG $0,15\% \leq F < 0,6\%$ OF THE LENGTH

WILL BE STRAIGHTENED UP TO OBTAIN A SAG $< 0,15\%$ OF THE LENGTH.


- WHEN THE SAG F OF A BEAM EXCEED 0,6% OF THE LENGTH, THE BEAM WILL BE REJECTED.

- ZINC THICKNESS, GALVANIZATION SIGHT, CONTROL OPERATING SEE STANDARD: NF EN ISO 1461

- SURFACE IMPERFECTIONS SEE STANDARD: NF EN 10163-3 CLASS C SUBCLASS 3

- ALL STANDARD DRILLINGS MUST BE UNDERTAKEN BEFORE GALVANIZING

SPECIFICATION

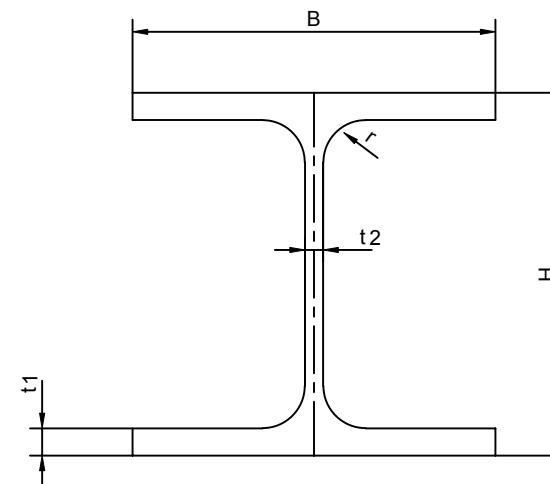

HEIGHT : H

WIDTH : B


FLANGE THICKNESS : t1

WEB THICKNESS : t2

RADIUS : r

SPECIFICATII PENTRU LIVRAREA STALPILOR H
SPECIFICATION FOR SUPPLYNG H BEAM

Numele fisierului/ CAD file name:	Scara/ Scale:	Part	Rev.
01LC00BDG012		1 / 1	0

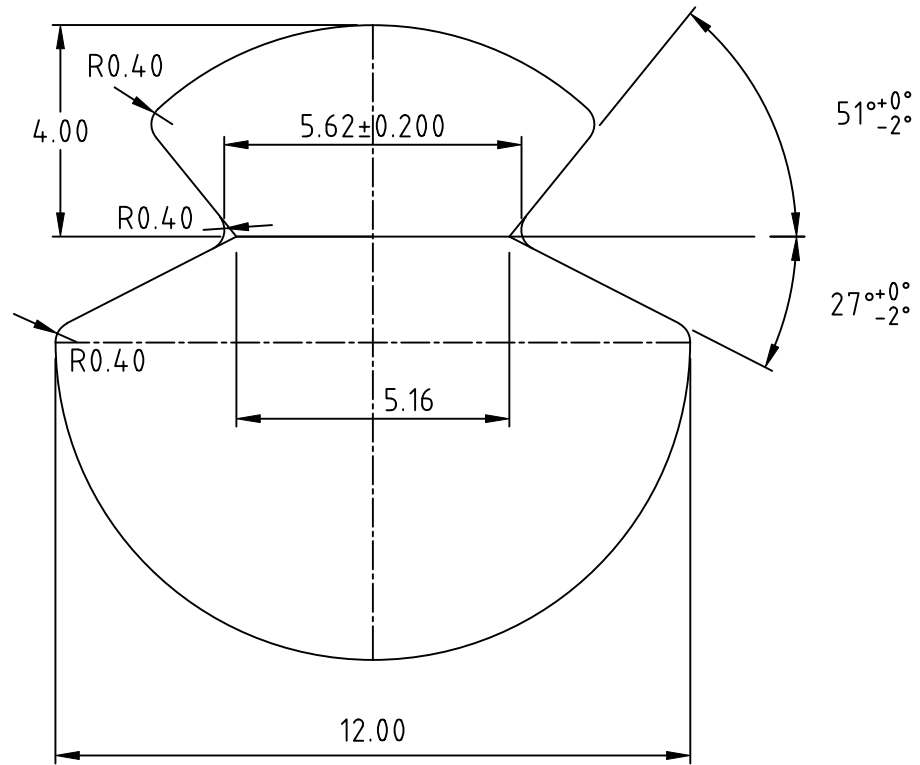

Contact Wire 100mm ²		
Specification designation	Unit	Specified value
Wire designation	N/A	AC-100
Composition and make up	N/A	Solid rod
Raw material	N/A	Copper (Cu-FRHC)
Nominal diameter	mm	12
Nominal cross section	mm ²	100
Wire lay	N/A	N/A
Thermic linear expansion coefficient	m/m.°C	0.000017
Mechanical extension coefficient	m/N	0.000083
Maximum guaranteed resistance at 20°C	Ω/km	0.183
Conductivity(%equivalent Copper)	%	98
Weight per meter	kg/m	0.889
Minimum breaking load	kN	34.5
Applicable standard	N/A	DIN 43141(EN 50149)

joints are not allowed (even by welding or hard silver soldering)

Notes:

*Cable to be delivered on wood drums closed with flanges

*Quantity (in meter) on each drum to be allocated and provided with purchase order

*Product marking label to display:

Compania Nationala de Cai Ferate


Rehabilitation of OCS Contract Lot

Wire designation : AC-100

Wire actual length : (m)

FIR DE CONTACT 100 mmp
CONTACT WIRE 100 mmp

Numele fisierului/ CAD file name:	Scara/ Scale:	Part	Rev.
01LC00BDG013		1 / 1	0

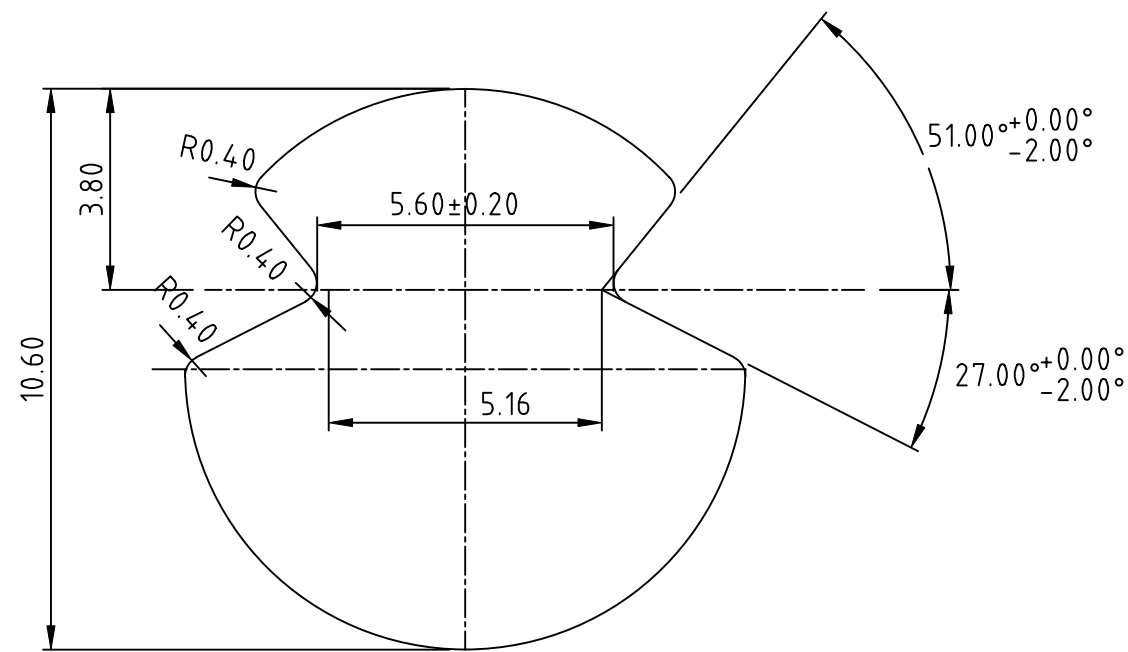


Contact Wire 80mm ²		
Specification designation	Unit	Specified value
Wire designation	N/A	AC-80
Composition and make up	N/A	Solid rod
Raw material	N/A	Copper (Cu-FRHC)
Nominal diameter	mm	10.6
Nominal cross section	mm ²	80
Wire lay	N/A	N/A
Thermic linear expansion coefficient	m/m.°C	0.000017
Mechanical extension coefficient	m/N	0.000083
Maximum guaranteed resistance at 20°C	Ω/km	0.229
Conductivity(%equivalent Copper)	%	98
Weight per meter	kg/m	0.711
Minimum breaking load	kN	27.5
Applicable standard	N/A	DIN 43141(EN 50149)

joints are not allowed (even by welding or hard silver soldering)

Notes:

- *Cable to be delivered on wood drums closed with flanges
- *Quantity (in meter) on each drum to be allocated and provided with purchase order
- *Product marking label to display:
 Compania Nationala de Cai Ferate
 Rehabilitation of OCS Contract Lot
 Wire designation : AC-80
 Wire actual lenght : (m)

FIR DE CONTACT 80mmp CONTACT WIRE 80mmp	Numele fisierului/ CAD file name:	Scara/ Scale:	Part	Rev.
	01LC00BDG014		1 / 1	0

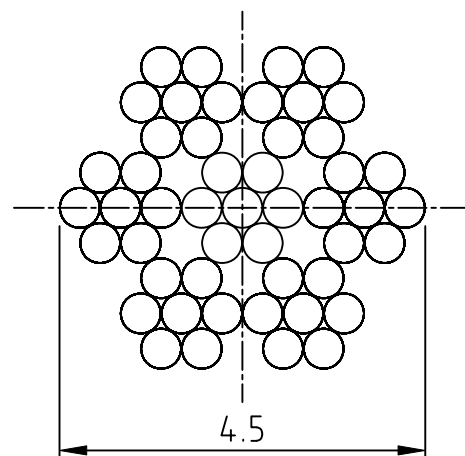

10mm ² Bronze Cable for droppers		
Specification designation	Unit	Specified value
Wire designation	N/A	BZ 10
Composition and make up	N/A	7x7x0.5mm
Raw material	N/A	Bz II
Nominal diameter	mm	4.5
Nominal cross section	mm ²	9.6
Wire lay	N/A	"Z" (Right hand)
Thermic linear expansion coefficient	m/m.*C	0.000017
Mechanical extension coefficient	m/N	0.000118
Conductivity(%equivalent Copper)	%	72
Weight per meter	kg/m	0.089
Minimum breaking load	kN	5.68
Applicable standard	N/A	DIN 43 138

joints are not allowed (even by welding or hard silver soldering)

Notes:

*Cable to be delivered on wood drums closed with flanges

*Quantity (in meter) on each drum to be allocated and provided with purchase order

*Product marking label to display:


Compania Nationala de Cai Ferate

Rehabilitation of OCS Contract Lot

Wire designation : BZ 10

Wire actual length : (m)

CABLU DE BRONZ PENTRU PENDULE 10mmp DROPPER BRONZE CABLE 10 mmp	Numele fisierului/ CAD file name:	Scara/ Scale:	Part	Rev.
	01LC00BDG015		1 / 1	0

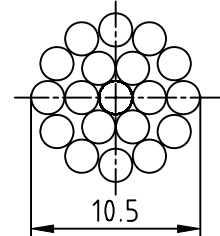


70mm ² Bronze Cable for messenger		
Specification designation	Unit	Specified value
Wire designation	N/A	BZ 70
Composition and make up	N/A	19x2.1mm
Raw material	N/A	BZ II
Nominal diameter	mm	10.5
Nominal cross section	mm ²	65.81
Wire lay	N/A	
Thermic linear expansion coefficient	m/m.°C	0.000017
Mechanical extension coefficient	m/N	0.000118
Conductivity(%equivalent Copper)	%	72
Weight per meter	kg/m	0.596
Minimum breaking load	kN	38.64
Applicable standard	N/A	DIN 48 201

joints are not allowed (even by welding or hard silver soldering)

Notes:

- *Cable to be delivered on wood drums closed with flanges
- *Quantity (in meter) on each drum to be allocated and provided with purchase order
- *Product marking label to display:
 Compania Nationala de Cai Ferate
 Rehabilitation of OCS Contract Lot
 Wire designation : BZ 70
 Wire actual lenght : (m)

CABLU PURTATOR DIN BRONZ 70mmp MESSENGER BRONZE CABLE 70mmp	Numele fisierului/ CAD file name:	Scara/ Scale:	Part	Rev.
	01LC00BDG016		1 / 1	0

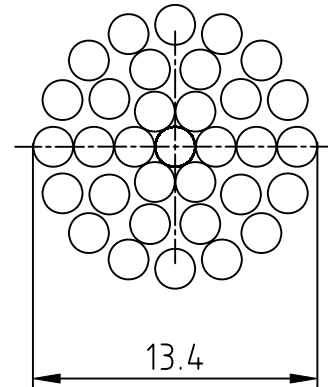

95/15 ACSR wire for earthing Conductor

Specification designation	Unit	Specified value
Wire designation	N/A	95/15
Composition and make up	N/A	26 x 2.10 (Alu) 7 x 1.65 (Steel)
Raw material	N/A	Aluminium conductor steel reinforced(ACSR) outside and inside greased
Nominal diameter	mm	13.4
Nominal cross section	mm ²	105
Wire lay	N/A	Direction of the outside lay of wire : "right handed" "Z"
Weight per meter	kg/m	0.381
Lenght of drum	m	1500±50m
Applicable standard		
- Aluminium wire		STAS 3033-87
- Steel wire		SR CEI 60888-1994
- ACSR manufacturing		CEI 1089

Notes:

- *Cable to be delivered on wood drums closed with flanges
- *Quantity (in meter) on each drum to be allocated and provided with purchase order
- *Product marking label to display:


Compania Nationala de Cai Ferate

Rehabilitation of OCS Contract Lot

Wire designation : 95/15 ACSR

Wire actual lenght : (m)

CONDUCTOR PENTRU CABLUL COLECTOR 95/15 ACSR 95/15 ACSR WIRE FOR EARTHING CONDUCTOR	Numele fisierului/ CAD file name:	Scara/ Scale:	Part	Rev.
	01LC00BDG017		1 / 1	0

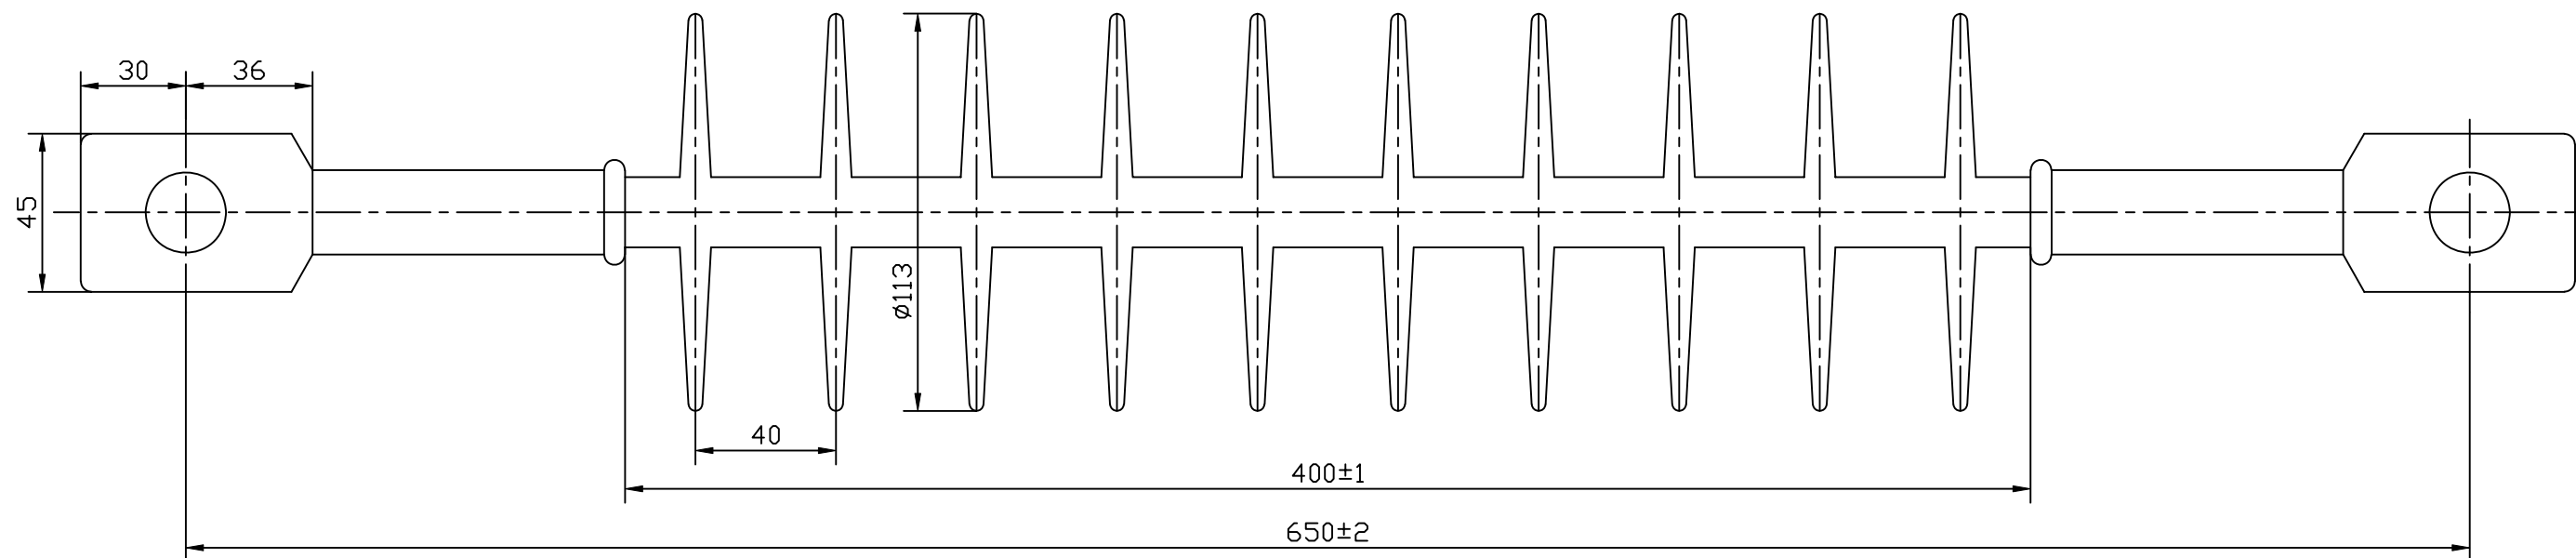

1. General characteristics

- Ambient temperature Minimum : -33°C
- Ambient temperature Maximum: +40°C
- Temperature of hoard frost apparition : -5°C
- Wind pressure Maximum 55 daN/m²
- Environment Normal and polluted areas
- Nominal voltage 25000V AC
- Rated frequency 50Hz
- Maximum voltage 27500V AC

2. Material


Composite with glass fibre bar covered by Teflon and silicon rubber cap according EN 50151 and EN 50124

3. Minimum electrical requirements

- Creepage distance Minimum : 1295mm
- Maximum flashover voltage
 - impulse positive 307 kV
 - impulse negative 350 kV
- Withstand voltage for 50 Hz, 1 min..... 95 kV
- Maximum withstand voltage
 - impulse positive 250 kV
 - impulse negative 331 kV
- Maximum dry condition flashover 184.1 kV
- Maximum wet condition flashover 163 kV

4. Minimum mechanical requirements

- Minimum break load (SML) 12000 daN
- Routine test (RTL) 6000 daN



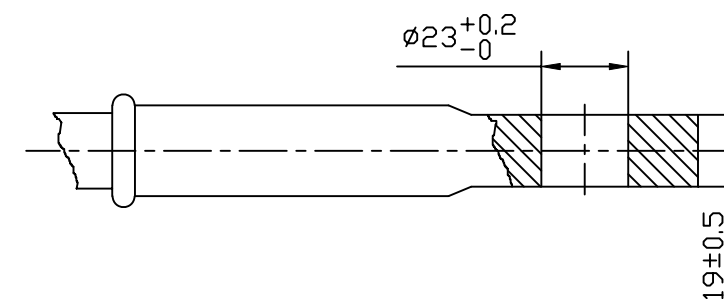


01LC00BDG018		COMPOSITE ANCHORING INSULATOR	-	3
DRAWING NUMBER	MARK	DESIGNATION	MATERIAL TECHNICAL SPECIFICATION	UNIT MASS kg

NOTES :

- 1/ THE INSULATOR CAPS AND THE INSULATED COMPONENT ARE DEFINITED TO SATISFY ALL REQUIRED SPECIFICATIONS FOR COMPLETE INSULATOR.
- 2/ THE MANUFACTURER WILL SUPPLY FOR ACCEPTANCE DETAILED DRAWINGS OF CONSTITUENT COMPONENTS (ESPECIALLY IN THE COUPLING AREA).
- 3/ CARE MUST BE TAKEN SO AS NO TO SCRATCH THE OUTSIDE COATING WITH A SHARP OBJECT WHEN UNPACKING.

IZOLATOR COMPOZIT DE ANCORARE COMPOSITE ANCHORING INSULATOR	Numele fisierului/ CAD file name:	Scara/ Scale:	Part	Rev.
	01LC00BDG018		1 / 1	0

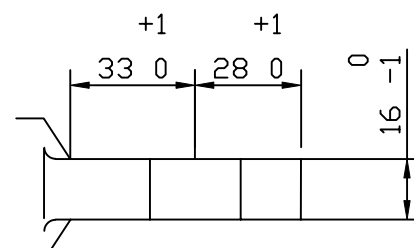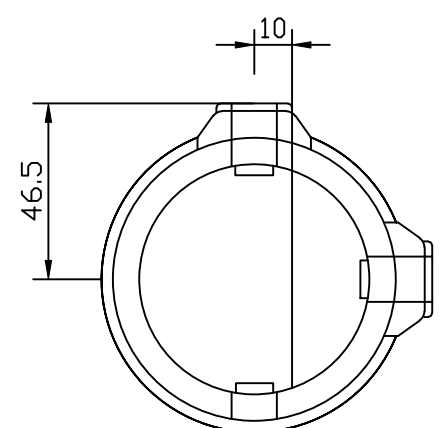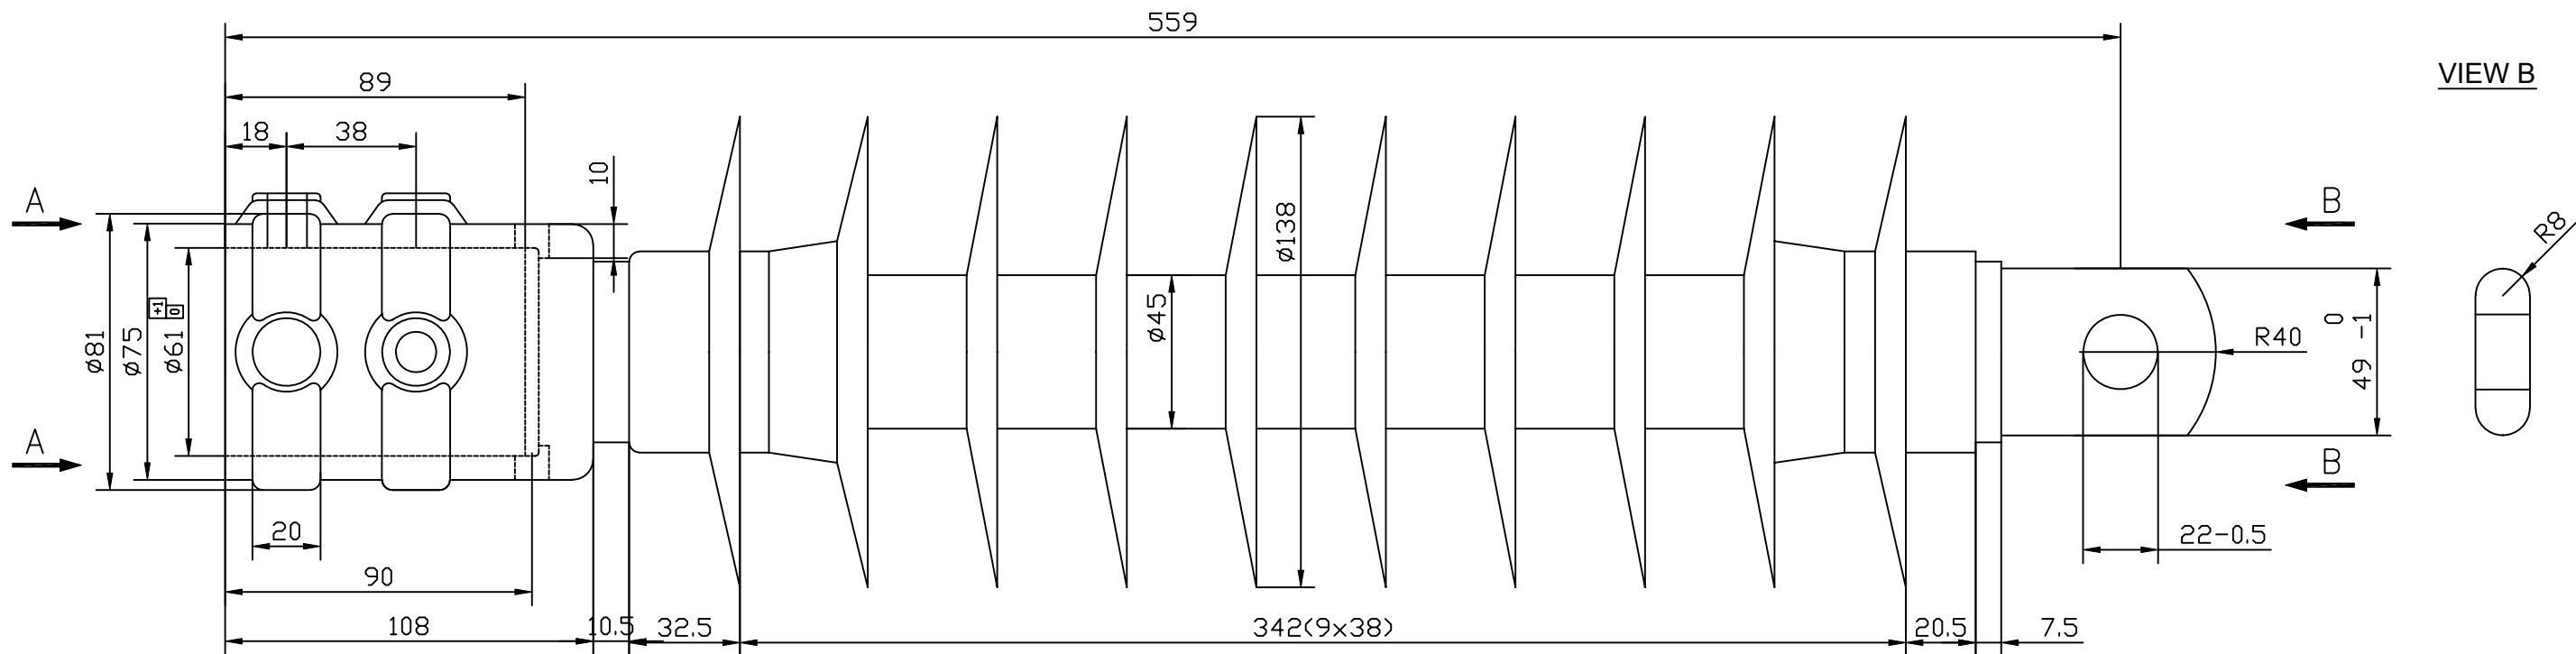

1. General characteristics

- Ambient temperature Minimum : -33°C
- Ambient temperature Maximum: +40°C
- Temperature of hoard frost apparition : -5°C
- Wind pressure Maximum 55 daN/m²
- Environment Normal and polluted areas
- Nominal voltage 25000V AC
- Rated frequency 50Hz
- Maximum voltage 27500V AC

2. Material

Composite with glass fibre bar covered by Teflon and silicon rubber cap according EN 50151 and EN 50124

3. Minimum electrical requirements

- Creepage distance Minimum : 1100mm
- Maximum flashover voltage
 - impulse positive 250 kV
 - impulse negative 250 kV
- Withstand voltage for 50 Hz, 1 min..... 95 kV
- Maximum withstand voltage
 - impulse positive 250 kV
 - impulse negative 331 kV
- Effective dry power frequency voltage
 - flashover 154.8 kV
 - withstand 150 kV
- Effective wet power frequency at industrial frequency
 - Flashover in horizontal position 125 kV
 - Flashover at 45° 125 kV
 - Withstand in horizontal position 115 kV
 - Withstand in vertical position 80 kV
 - Withstand at 45° 115 kV

4.4 Minimum mechanical requirements



- Minimum break load (SML) 7000 daN
- Routine test (RTL) 6000 daN
- Bending moment 200 daN.m

NOTES :

- 1/ ALL DIMENSIONS IN MILLIMETRES UNLESS OTHERWISE STATED.
- 2/ THE INSULATOR CAPS AND THE INSULATED COMPONENT ARE DEFINED TO SATISFY ALL REQUIRED SPECIFICATIONS FOR COMPLETE INSULATOR.
- 3/ THE MANUFACTURER WILL SUPPLY FOR ACCEPTANCE DETAILED DRAWINGS OF CONSTITUENT COMPONENTS (ESPECIALLY IN THE COUPLING AREA)
- 4/ AVOID DAMAGE TO THE OUTSIDE HOUSING OF THE INSULATOR WITH A CUTTER WHEN UNPACKING

01LC00BDG019		COMPOSITE INSULATOR FOR STRUT TUBE AND TOP TUBE	-	5.7
DRAWING NUMBER	MARK	DESIGNATION	MATERIAL TECHNICAL SPECIFICATION	UNIT MASS kg

IZOLATOR COMPOZIT PENTRU TIRANT SI CONTRAFISA COMPOSITE INSULATOR FOR STRUT TUBE AND TOP TUBE	Numele fisierului/ CAD file name:	Scara/ Scale:	Part	Rev.
	01LC00BDG019		1 / 1	0

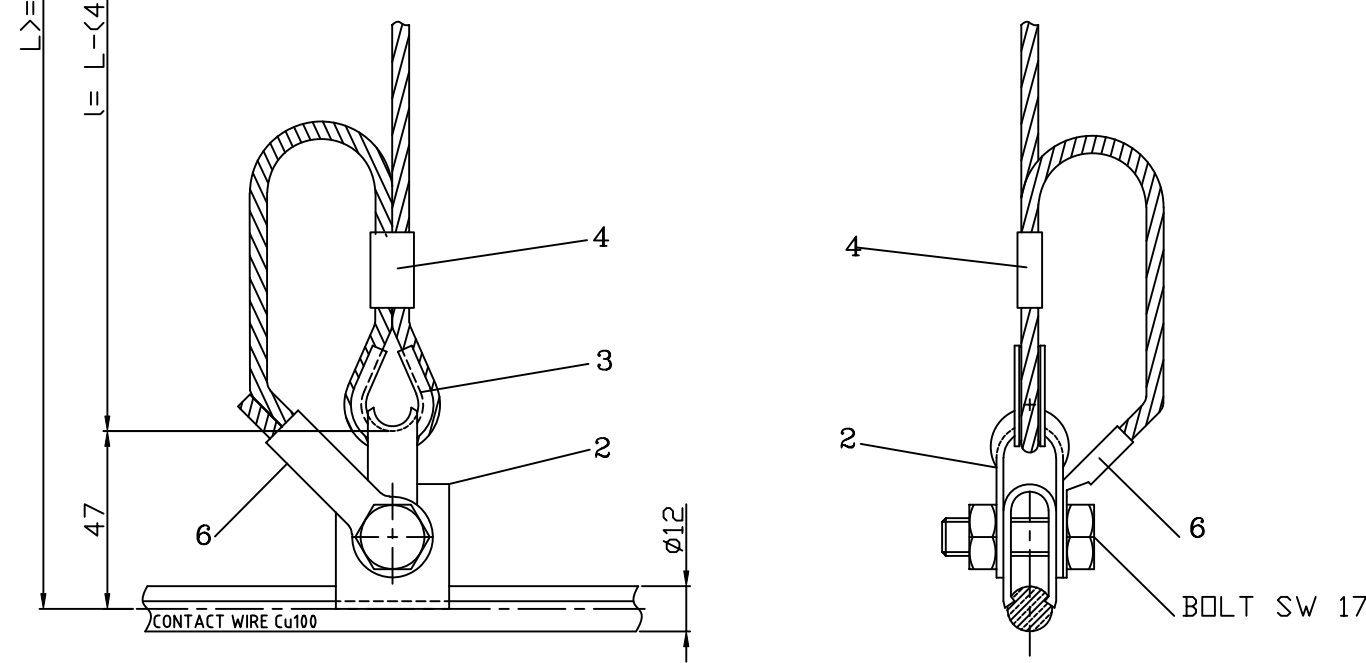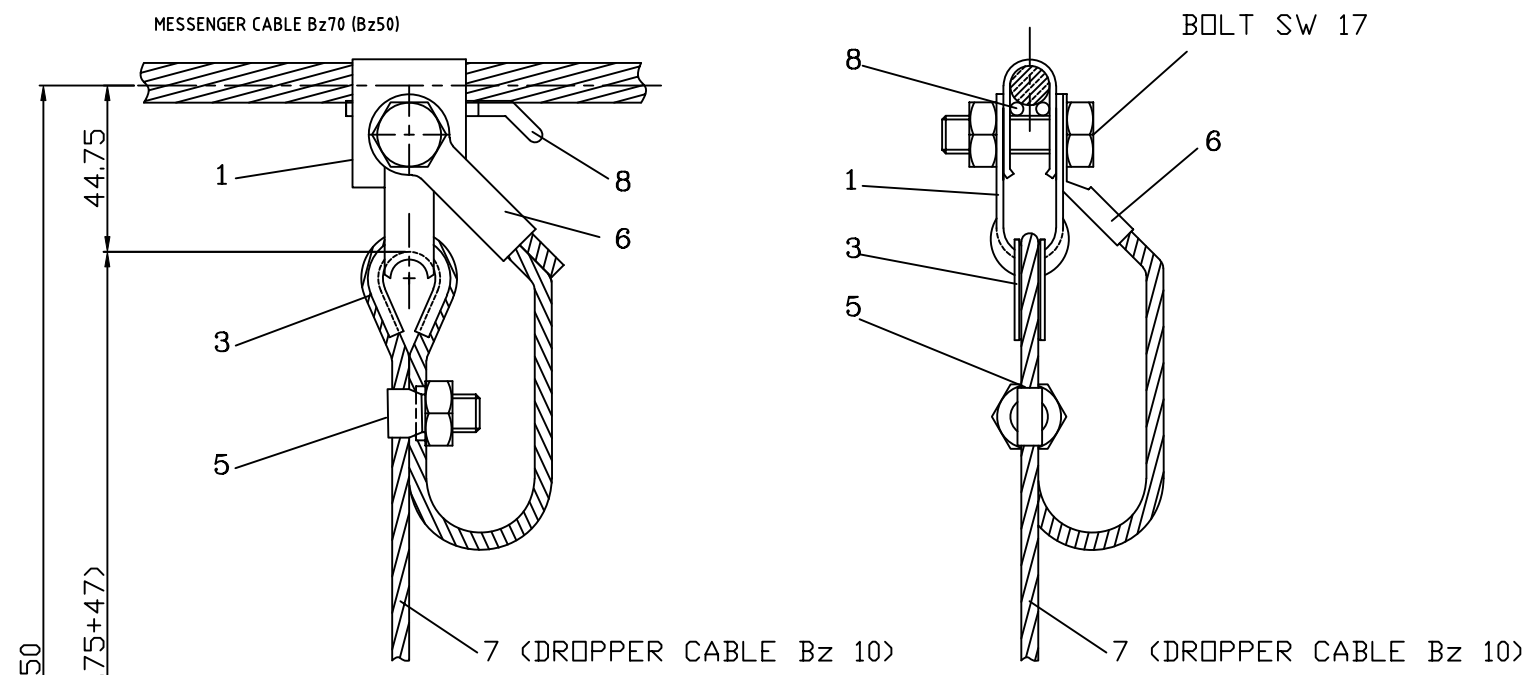


DROPPER (L >= 250mm)

* EXAMPLE : FOR l=1m, THE LENGHT OF CABLE Bz10 IS 1.55m

MARK GROUP	ITEM	DESIGNATION	UNIT MASS	REFERENCE DRAWING	MARK
1	8	CLIP	0.011	RIBE 5991142	
*	7	DROPPER CABLE BZ 10 ϕ 4.5		01LC00BDG015	
2	6	CABLE LUGS		RIBE4F01918-05A1	
1	5	BOLT		RIBE 16-KU-S	
1	4	CONNECTOR	0.0045	RIBE 031104	
2	3	THIMBLE	0.007	RIBE B6 15001A07	
1	2	CONTACT WIRE CLAMP	0.11	RIBE 5311115	
1	1	MESSANGER CLAMP	0.11	RIBE 5311182A2	

PENDULA (L >= 250mm.) DROPPER (L >= 250mm.)	Numele fisierului/ CAD file name:	Scara/ Scale:	Part	Rev.
	01LC00BDG020		1 / 1	0

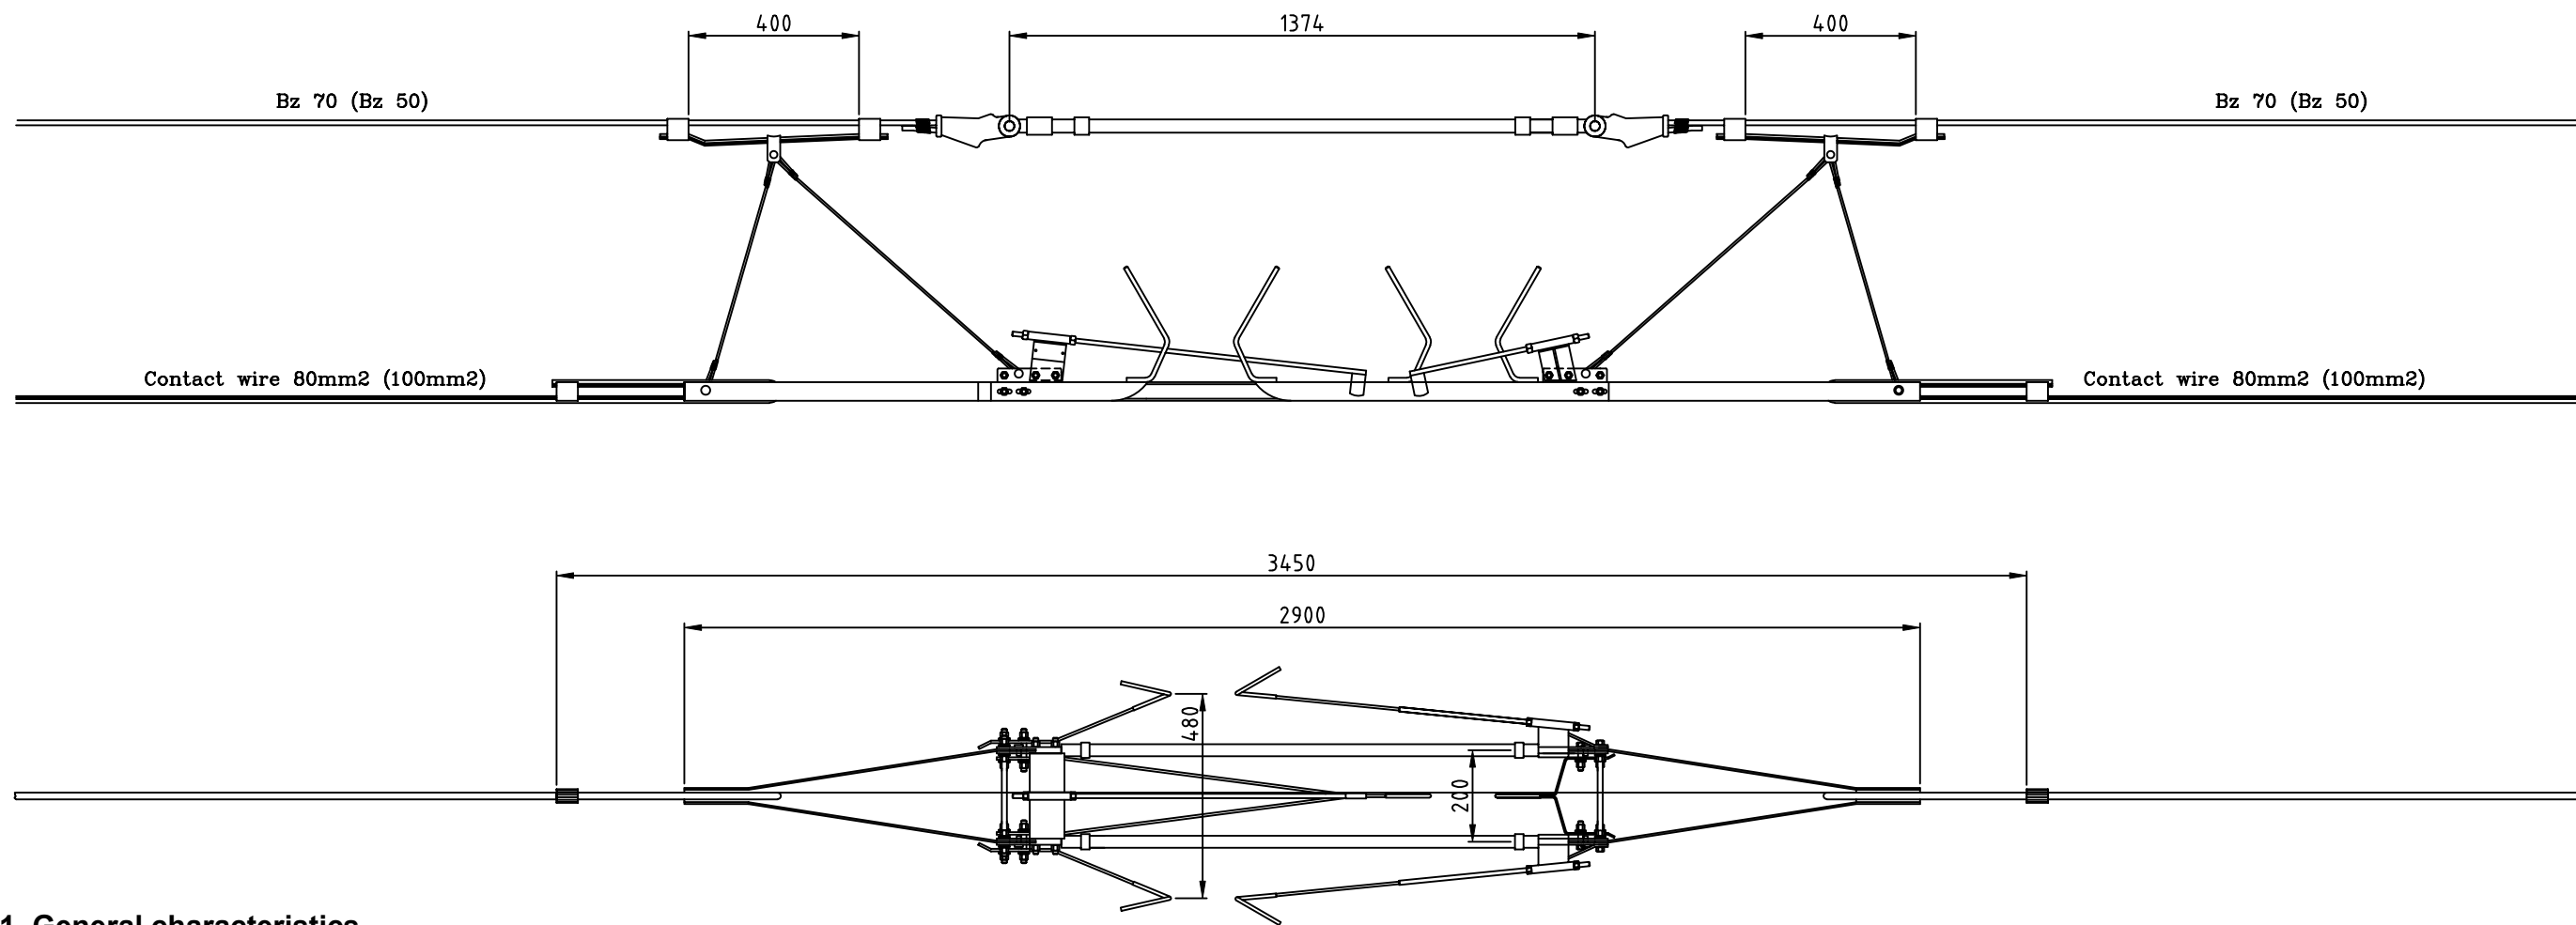

1. General characteristics

- Ambient temperature Minimum : -33°C
- Ambient temperature Maximum: +40°C
- Temperature of hoard frost apparition : -5°C
- Wind pressure Maximum 55 daN/m²
- Environment Normal and polluted areas
- Nominal voltage 25000V AC
- Rated frequency 50Hz
- Maximum voltage 27500V AC

01LC00BDG021		SECTION INSULATOR	-	26
DRAWING NUMBER	MARK	DESIGNATION	MATERIAL TECHNICAL SPECIFICATION	UNIT MASS kg

2. Material

Insulated bar with glass fibre covered by Teflon

3. Minimum electrical requirements


- Creepage distance Minimum : 1100mm
- Dry withstand frequency voltage Minimum : 290 kV
- Withstand voltage for 50 Hz, 1 min..... 95 kV
- Wet withstand frequency voltage Minimum : 190 kV
- Impulse withstand voltage 1.2/50 µs..... 250 kV

4. Minimum mechanical requirements

- Minimum break load (SML) 3500 daN
- Routine test (RTL) 1500 daN

MARK GROUP QUANT.	1	...	SECTION INSULATOR	IS - MMN 1	
	...	ITEM	DESIGNATION	REFERENCE DRAWING	MARK

IZOLATOR DE SECTIONARE SECTION INSULATOR	Numele fisierului/ CAD file name:	Scara/ Scale:	Part	Rev.
	01LC00BDG021	-	1 / 1	0

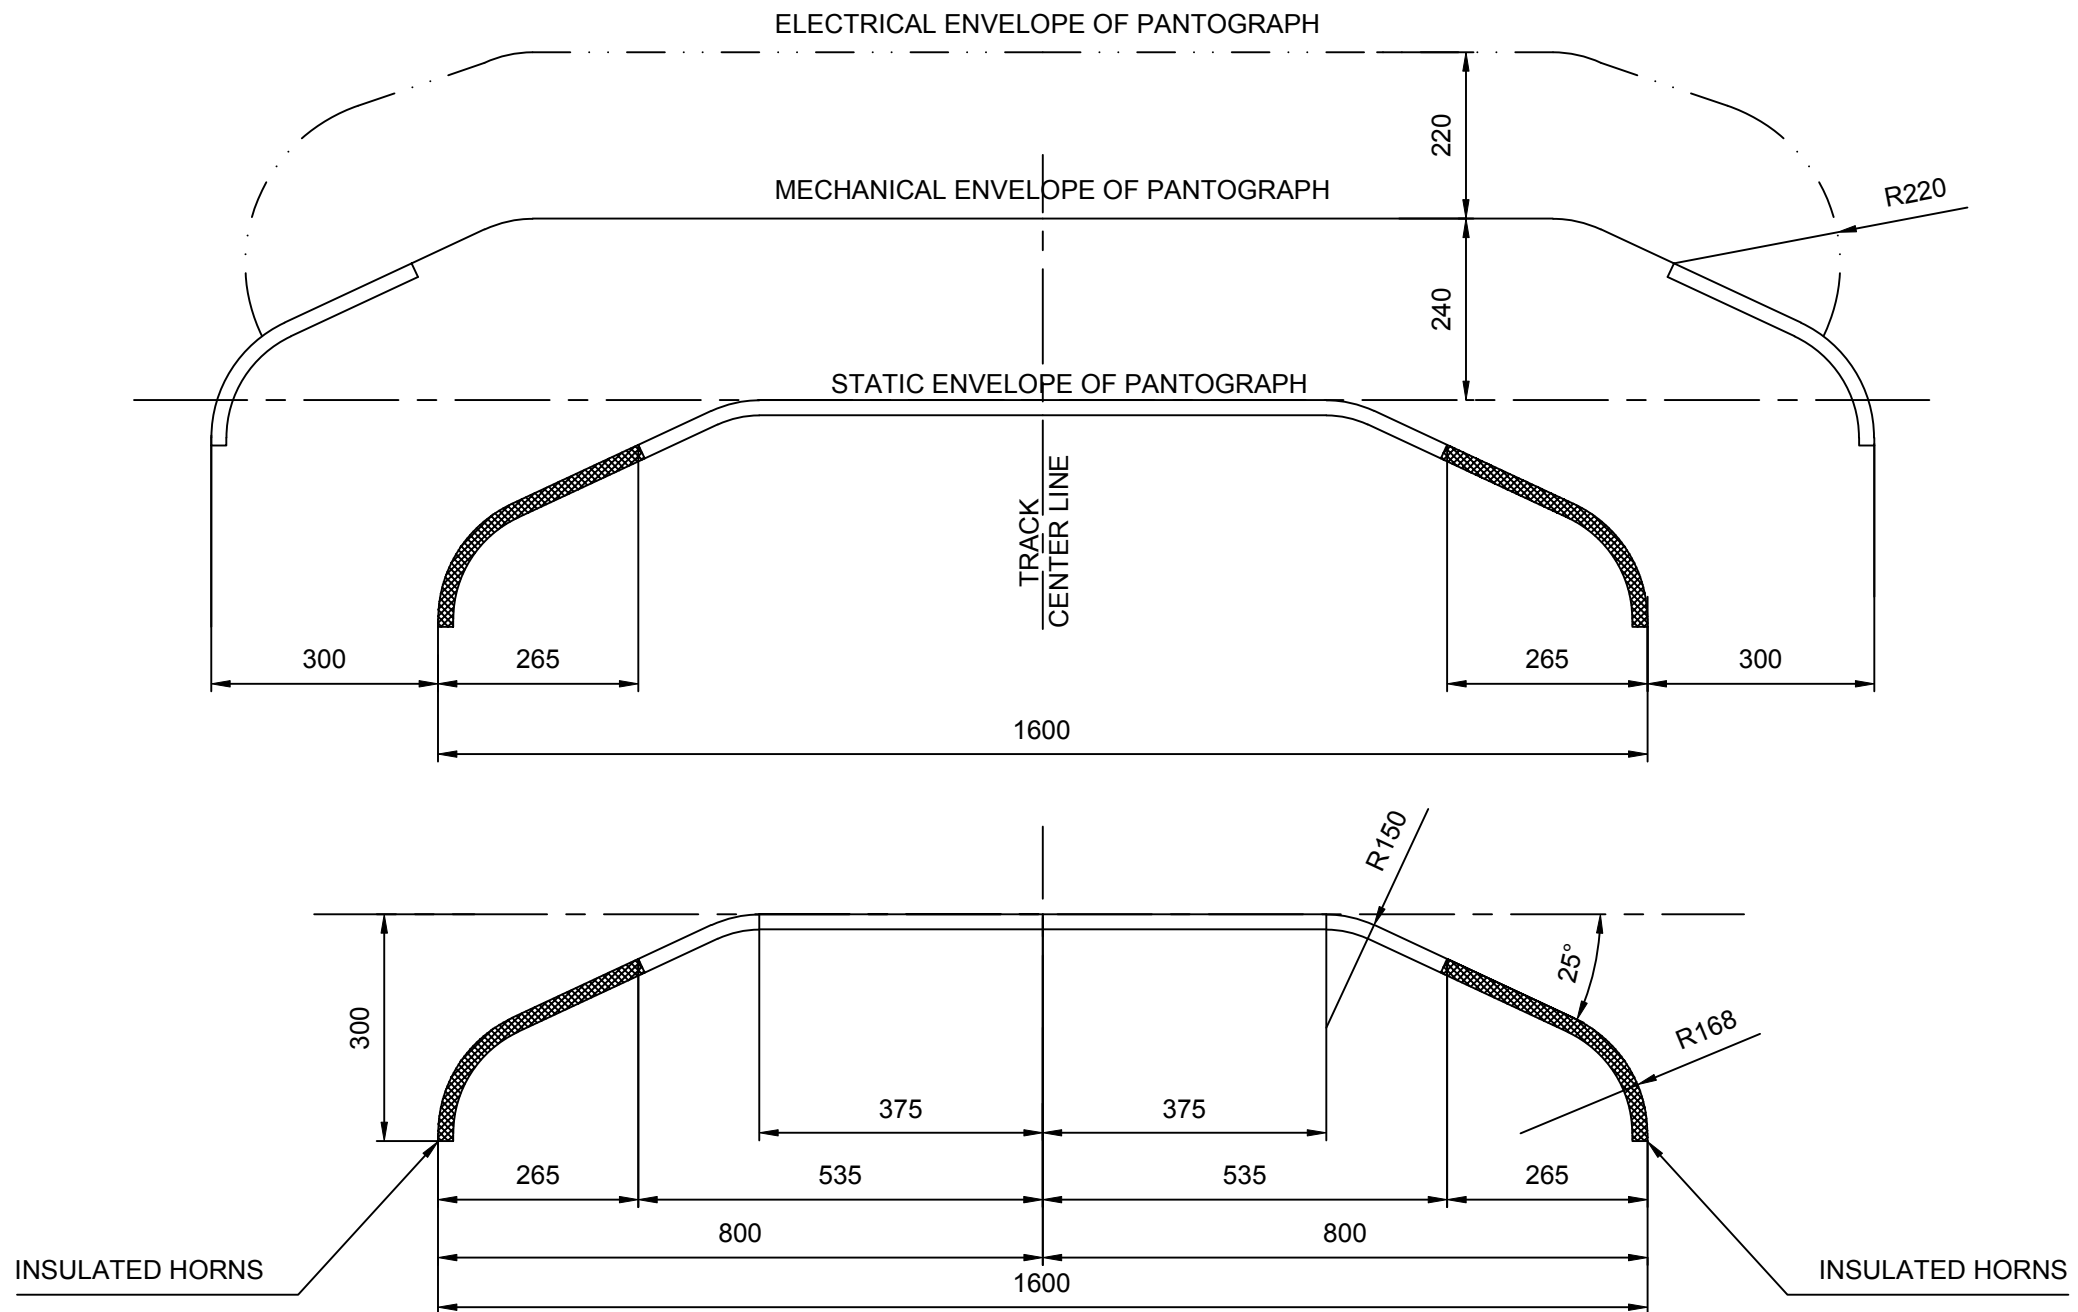

NOTES:



- 1/ PANTOGRAPH ENVELOPE ACCORDING TO UIC608 ANNEX 3
- 2/ THE MECHANICAL ENVELOPE OF THE PANTOGRAPH TAKES INTO ACCOUNT THE 0.24m UPLIFT OF THE CONTACT WIRE
- 3/ THE ELECTRICAL ENVELOPE OF THE PANTOGRAPH TAKES INTO ACCOUNT AN ELECTRICAL CLEARANCE OF 0.22m
IN STATIC SITUATION , THE ELECTRICAL CLEARANCE IS 0.32m (LEAFLET UIC 606)
- 4/ ANY CLEARANCE PROBLEM HAS TO BE NOTIFIED TO SPIE DROUARD DESIGN OFFICE

CARACTERISTICILE PANTOGRAFULUI
PANTOGRAPH ENVELOPE





Numele fisierului/ CAD file name:	Scara/ Scale:	Part	Rev.
01LC00BDG028		1 / 1	0

CROSS - OVER

TURNOUT

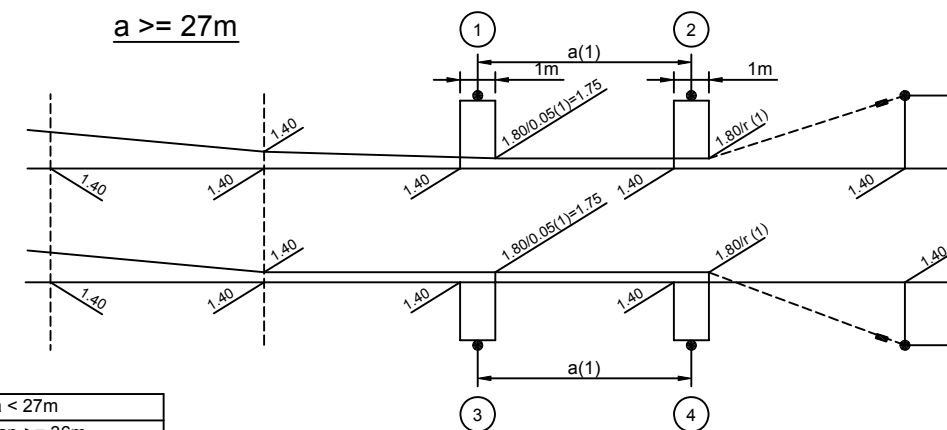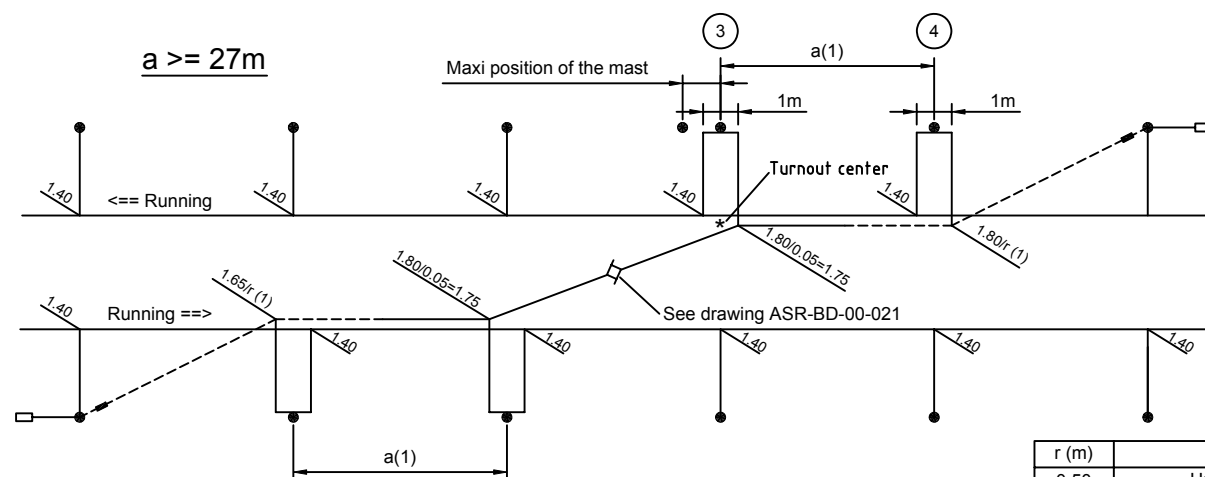


r (m)	(1) a > 27m	(2) a < 27m
0.50	Uplift span >= 36m	Uplift span >= 36m
0.35	36 m > Uplift span > 27m	27m < Uplift span < 36m

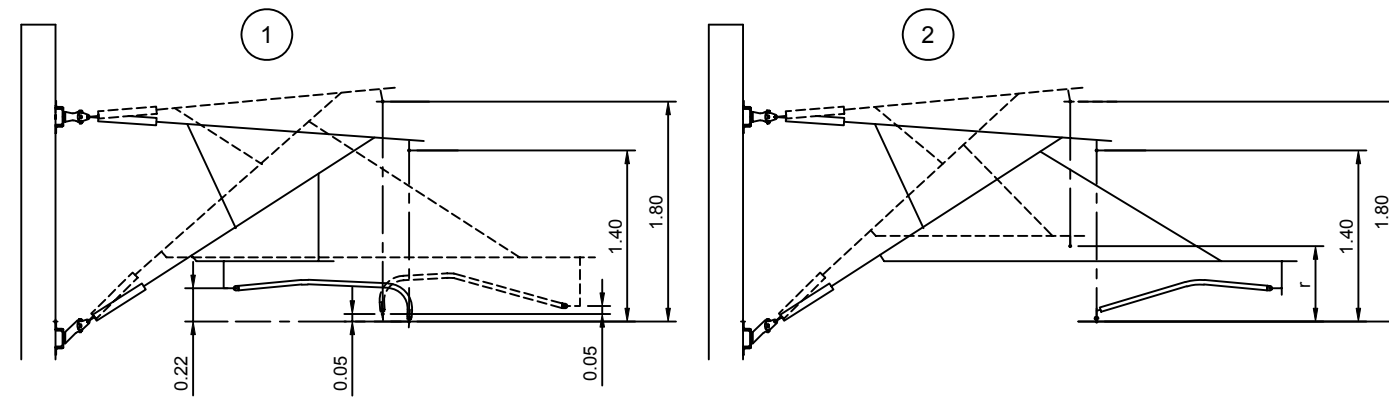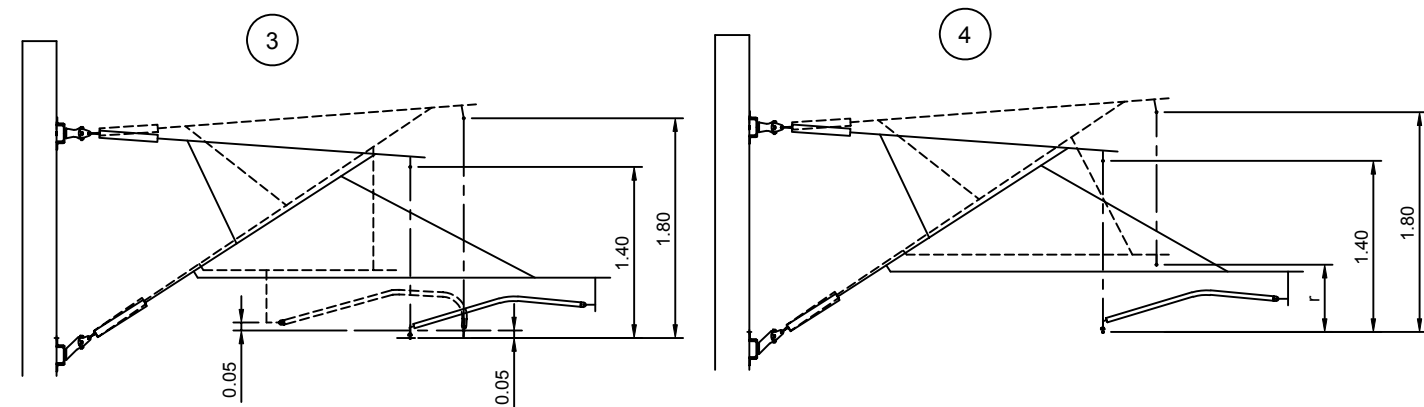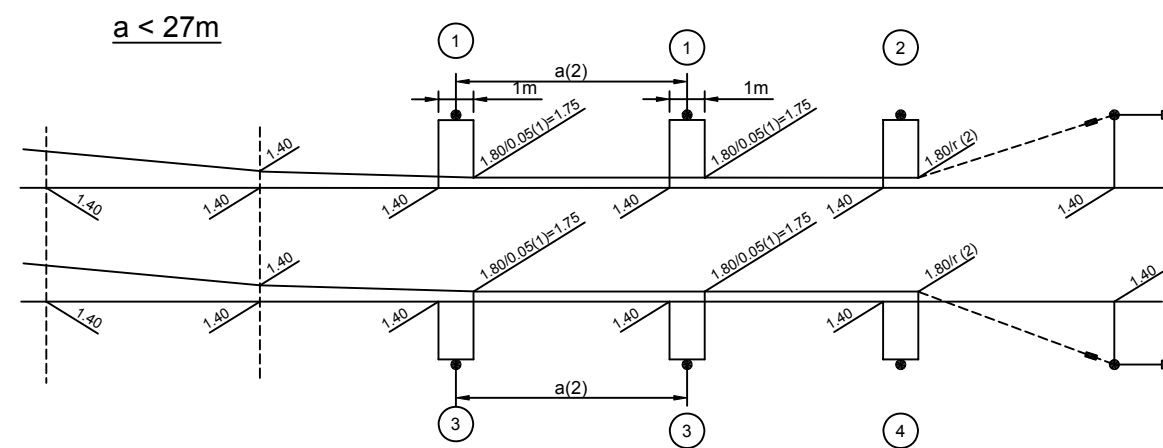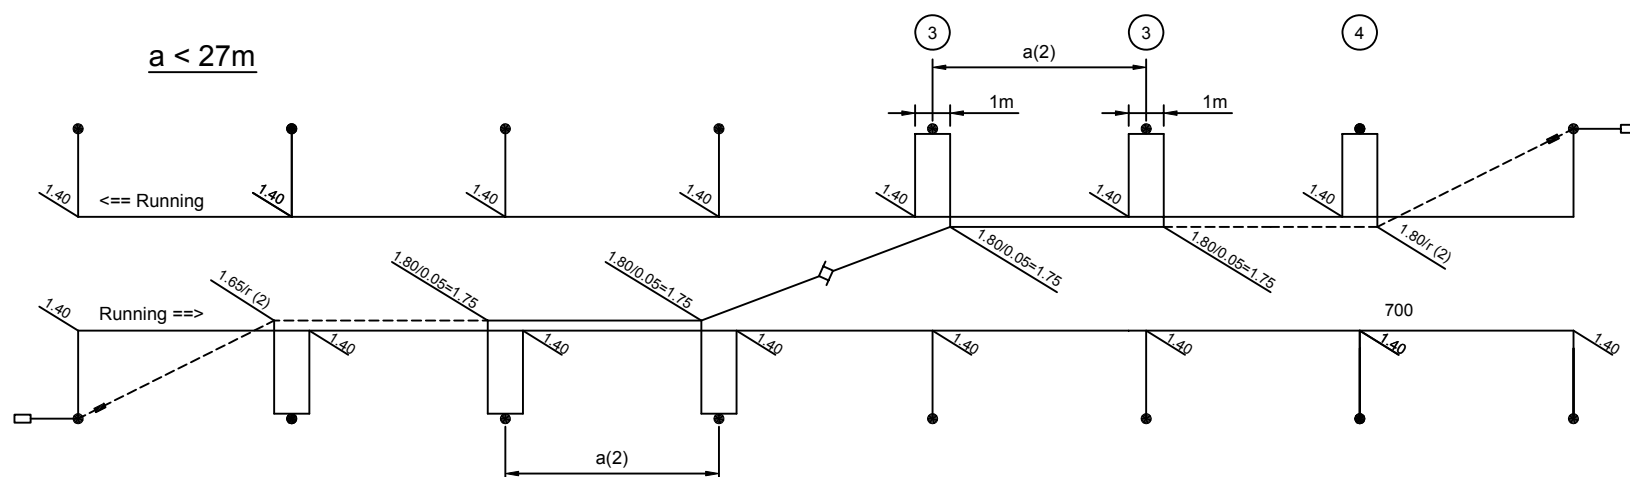


LINIA DE CONTACT LA MACAZE SI DIAGONALE
CATENARY AT CROSS-OVER AND TURNOUT

Numele fisierului/ CAD file name:	Scara/ Scale:	Part	Rev.
01LC00BDG029		1 / 1	0


UNINSULATED OVERLAP WITH THREE SPANS

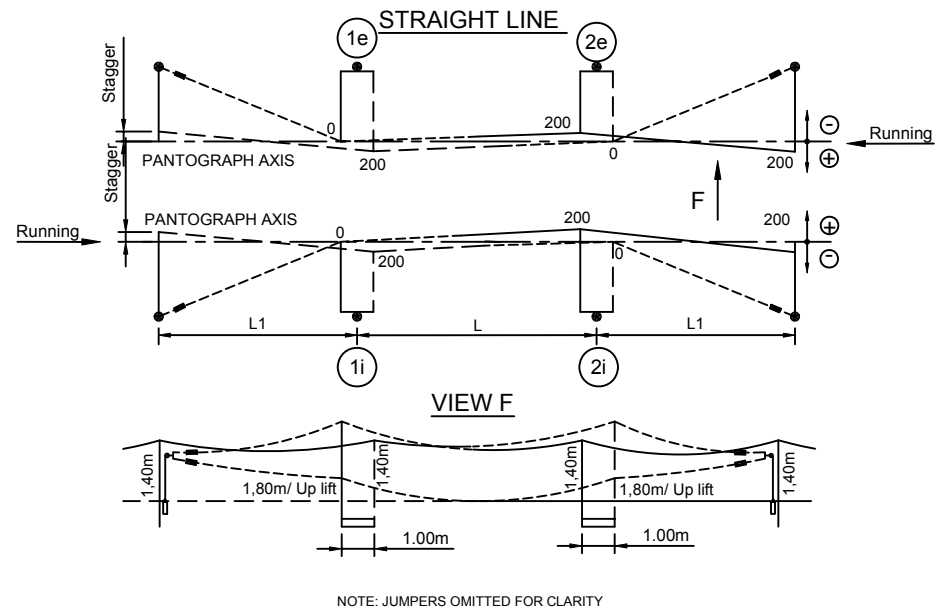


UNINSULATED OVERLAP WITH FOUR SPANS IN CURVE

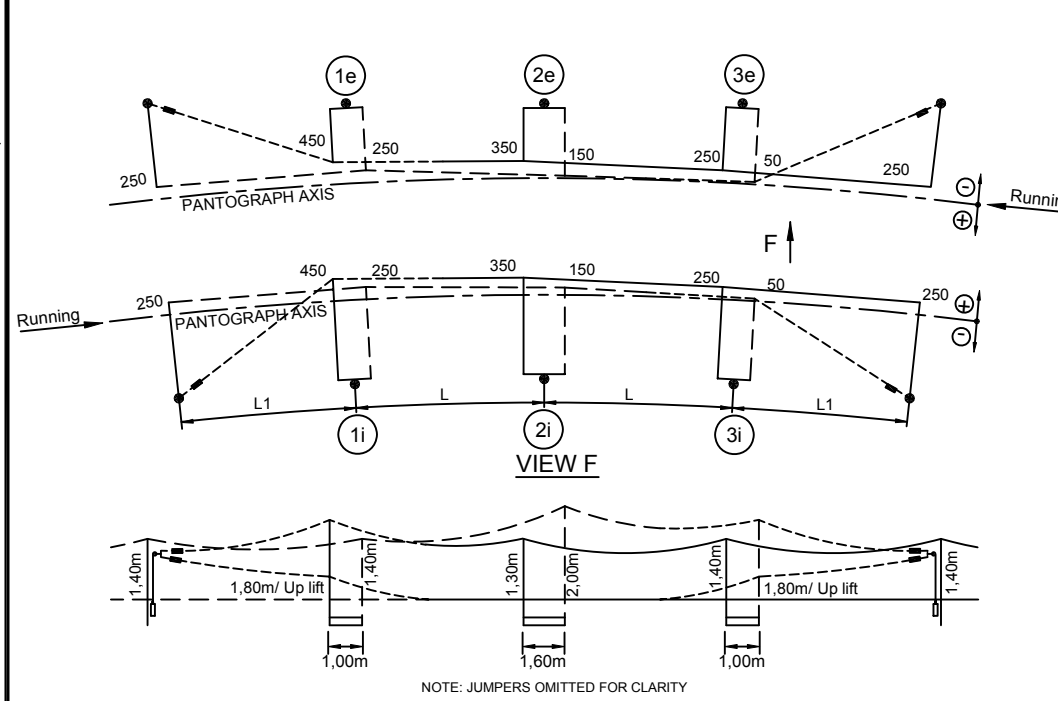

CANTILEVERS ARRANGEMENT

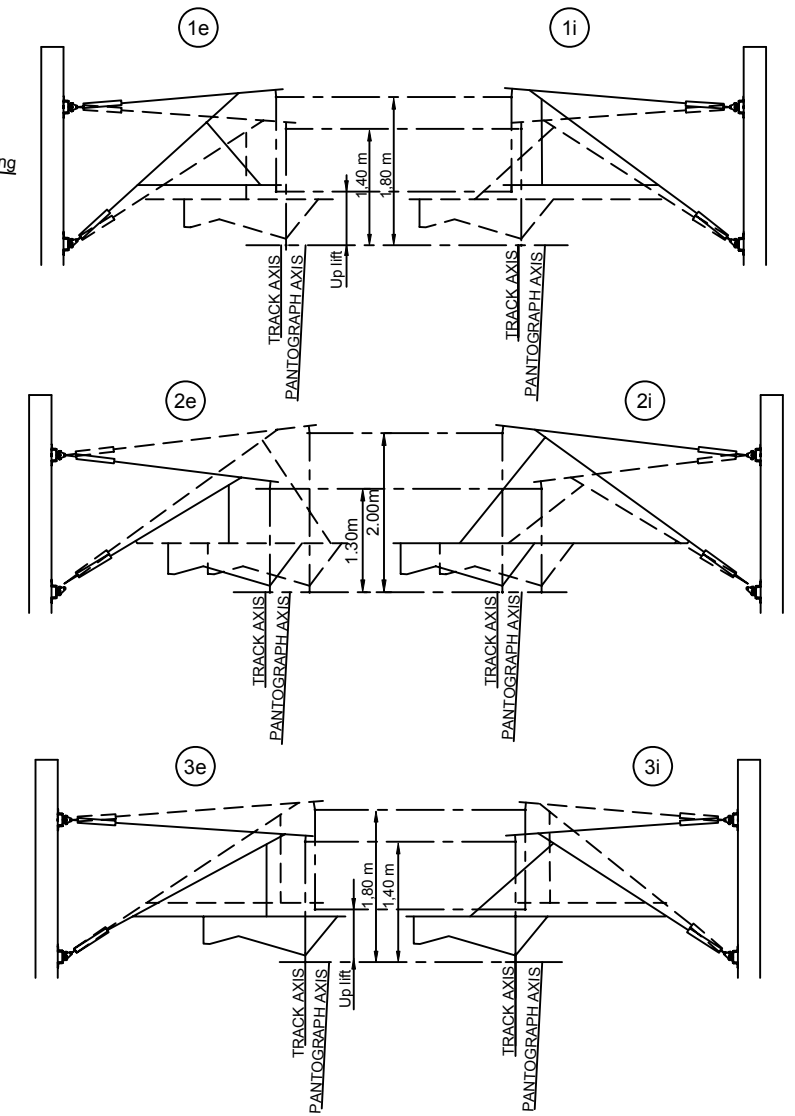



CANTILEVERS ARRANGEMENT

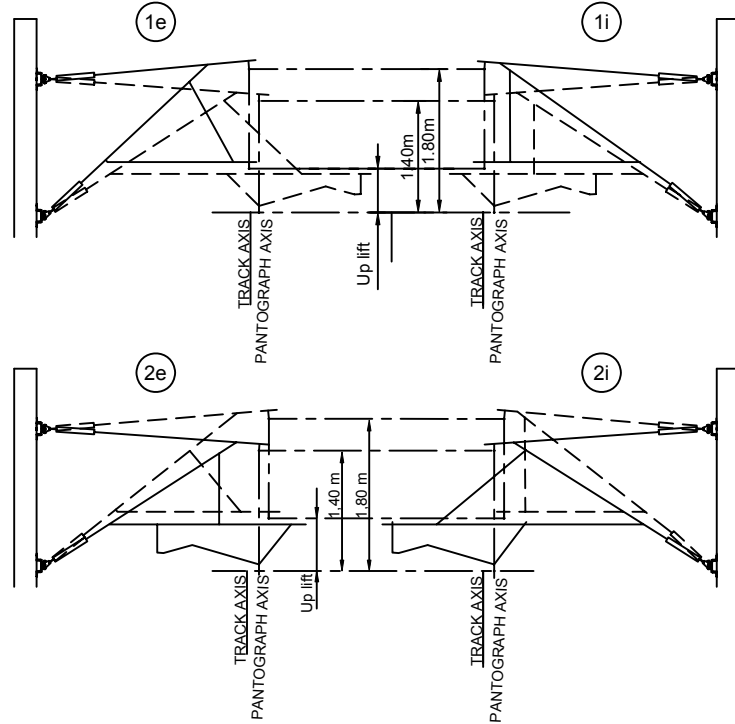

ZONA NEIZOLATA DE ANCORARE
UNINSULATED OVERLAPS



Numele fisierului/ CAD file name:	Scara/ Scale:	Part	Rev.
01LC00BDG030		1 / 1	0

INSULATED OVERLAP WITH FOUR SPANS IN TANGENT TRACKS AND CURVE

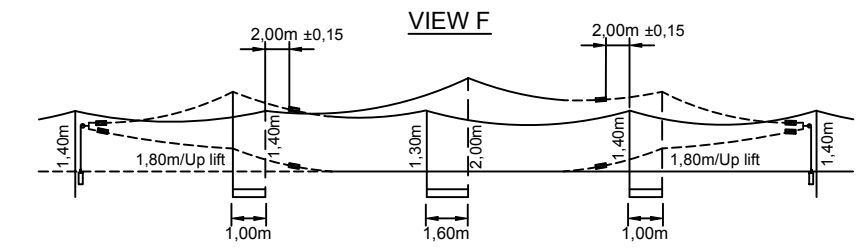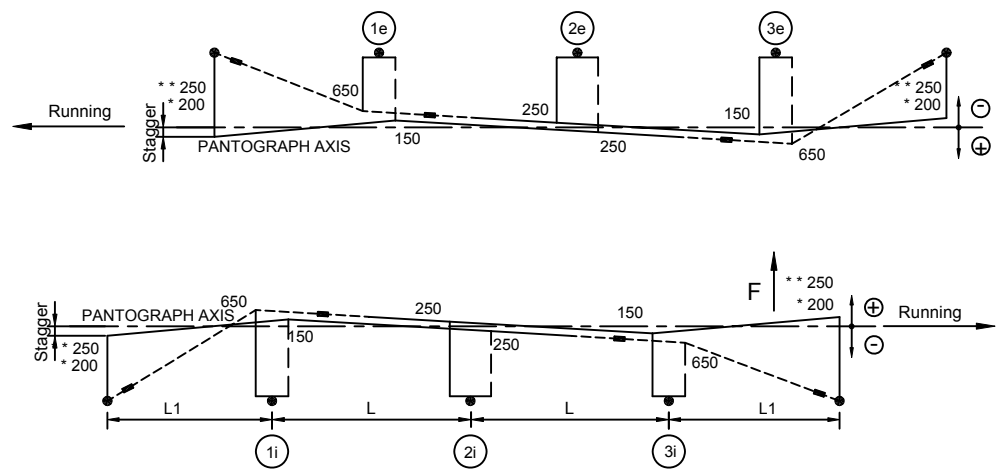


* the stagger is equal to 200 mm for tangent tracks
 ** the stagger is equal to 250 mm for curve tracks

INSULATED OVERLAP WITH FOUR SPANS IN CURVE

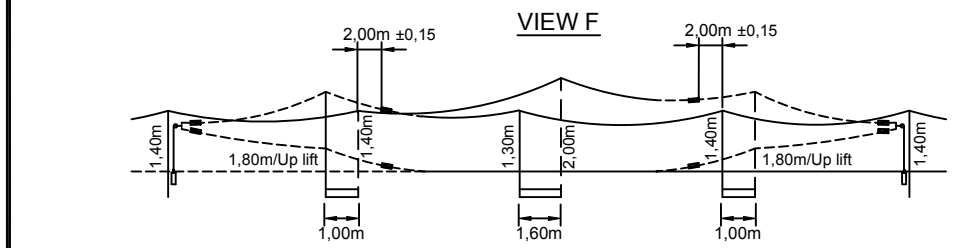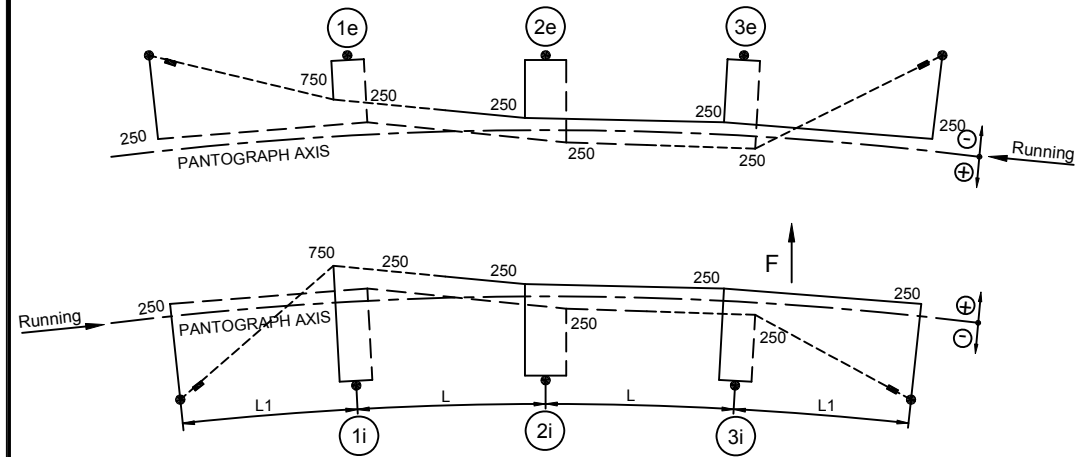

CANTILEVERS ARRANGEMENT

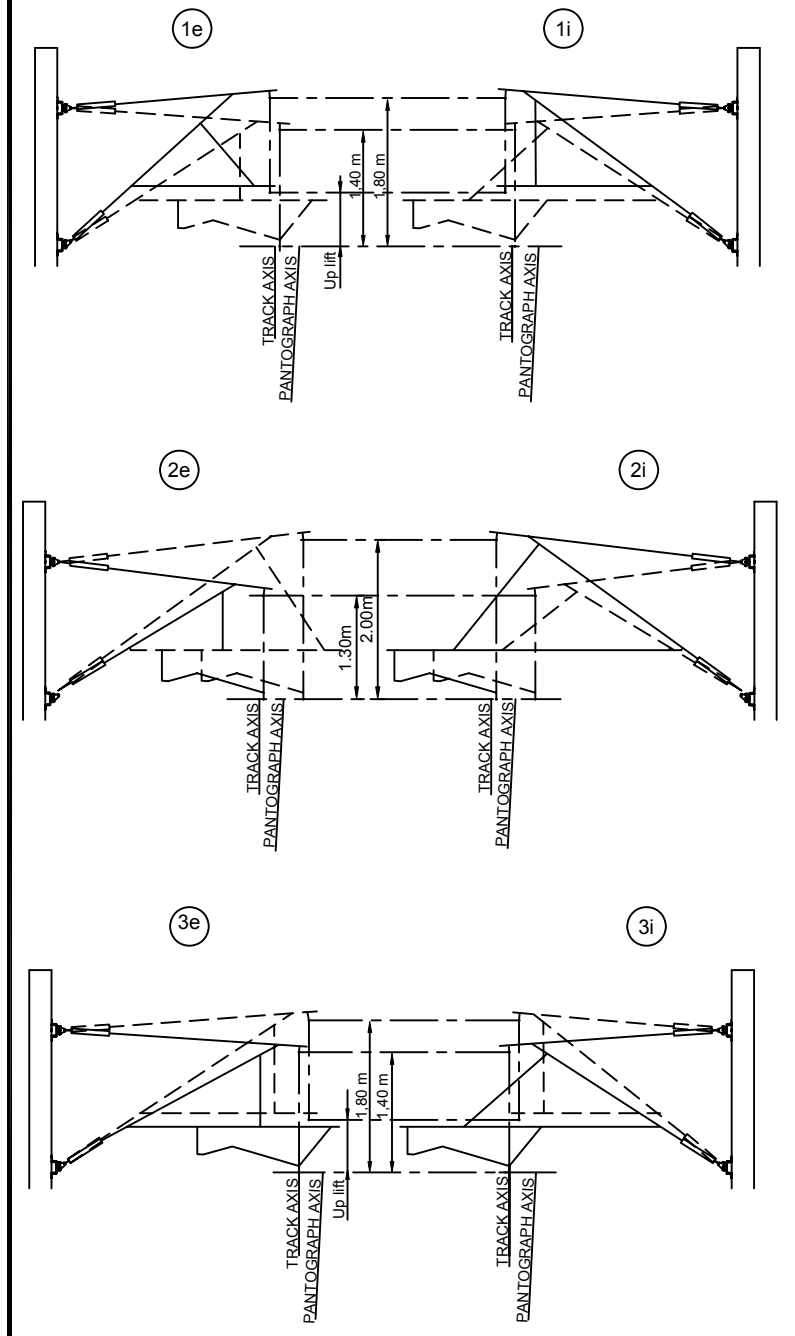


ZONA IZOLATA DE ANCORARE
 INSULATED OVERLAPS

Numele fisierului/ CAD file name:	Scara/ Scale:	Part	Rev.
01LC00BDG031		1 / 1	0


ANCHOR WITH TENSIONING DEVICE

MIDPOINT ANCHOR


ANCHOR WITH TENSIONING DEVICE

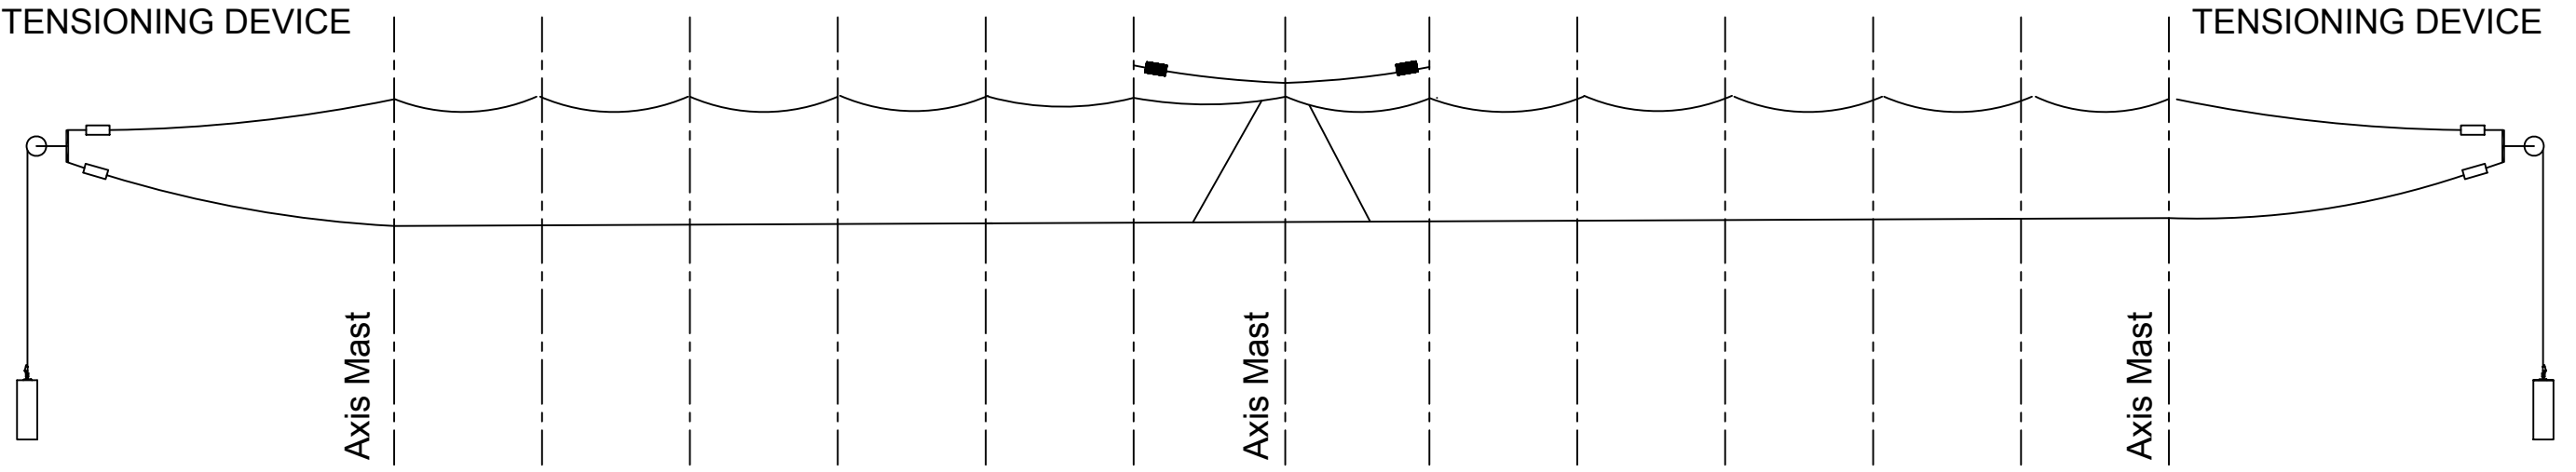

DETAIL A


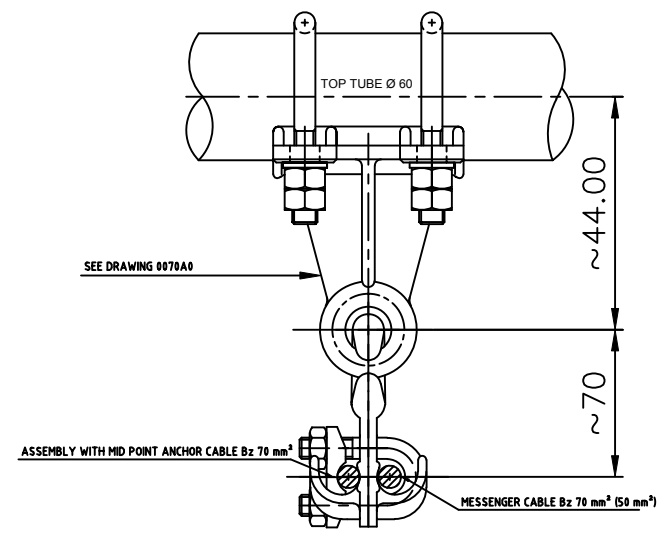


MECHANICAL TENSION FOR MID POINT ANCHOR WIRE = 1000 daN at 15°C
 MECHANICAL TENSION FOR "Z" ANCHOR WIRE = daN at 15°C



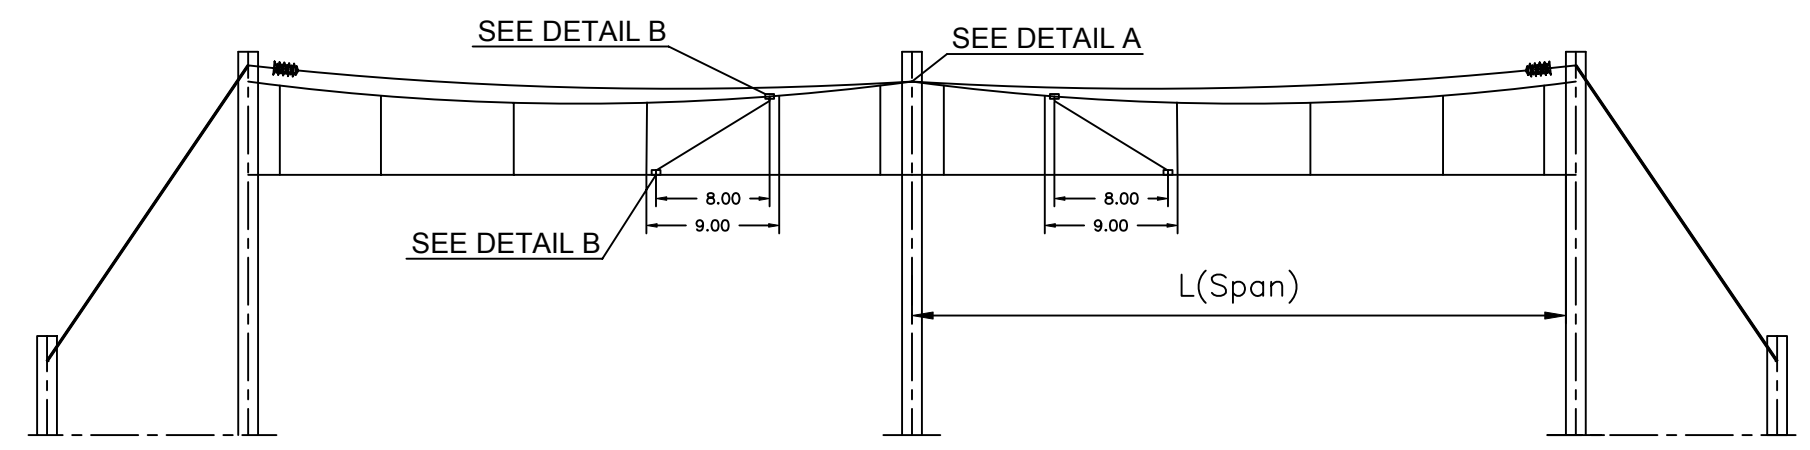


MID POINT ANCHOR WIRE Bz 70 mm²

DETAIL B

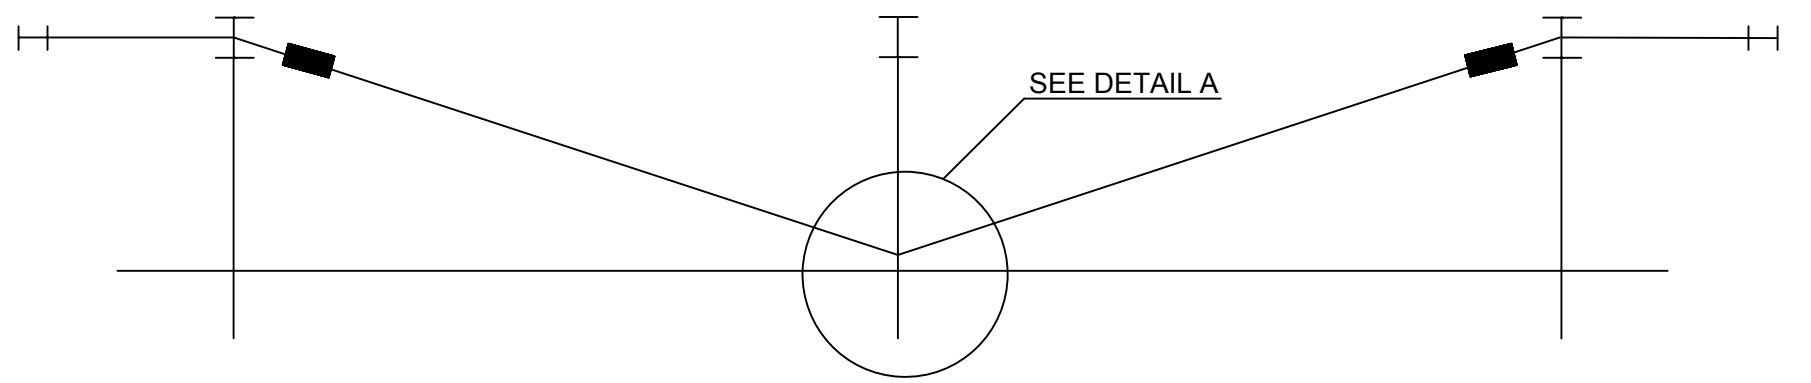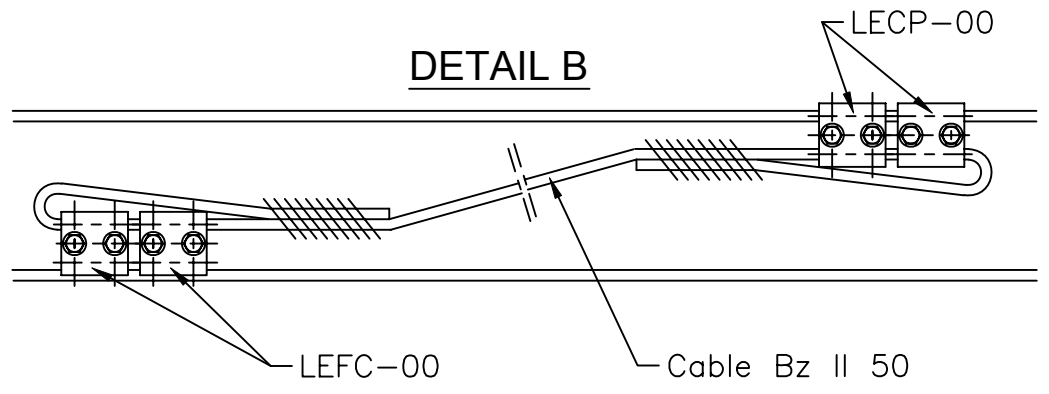


ANCORARE MEDIANA IN LINEA DIRECTA MID POINT ANCHOR ON OPEN ROUTE	Numele fisierului/ CAD file name:	Scara/ Scale:	Part	Rev.
	01LC00BDG032		1 / 1	0

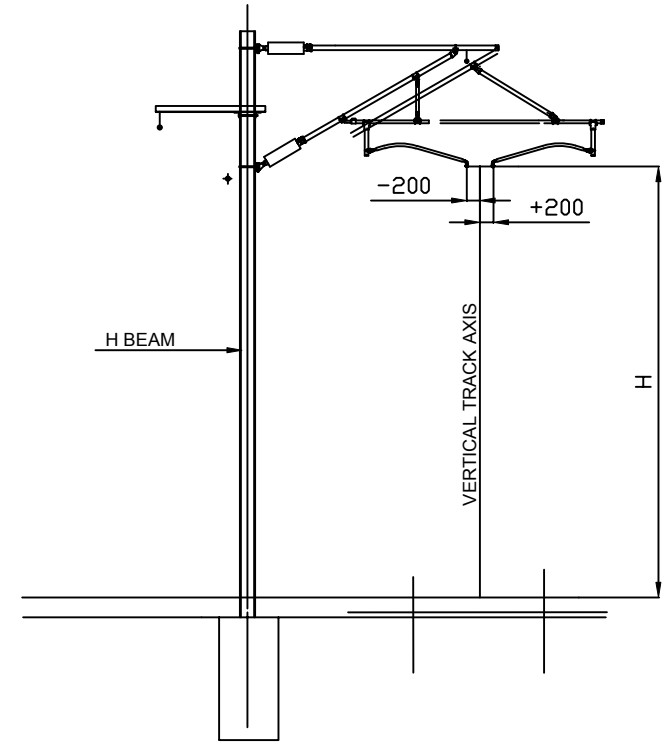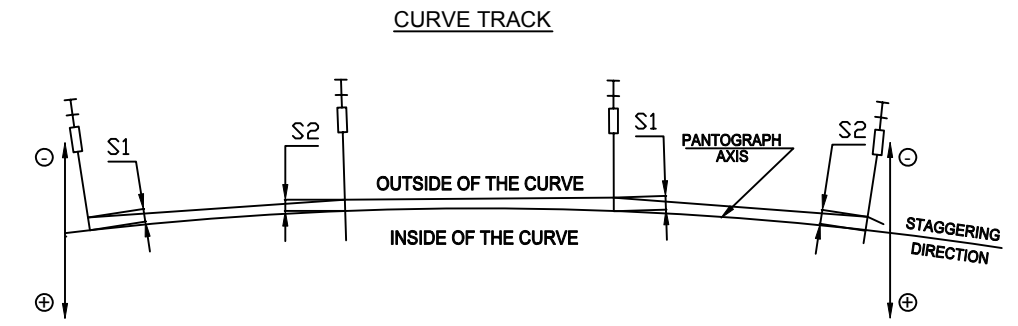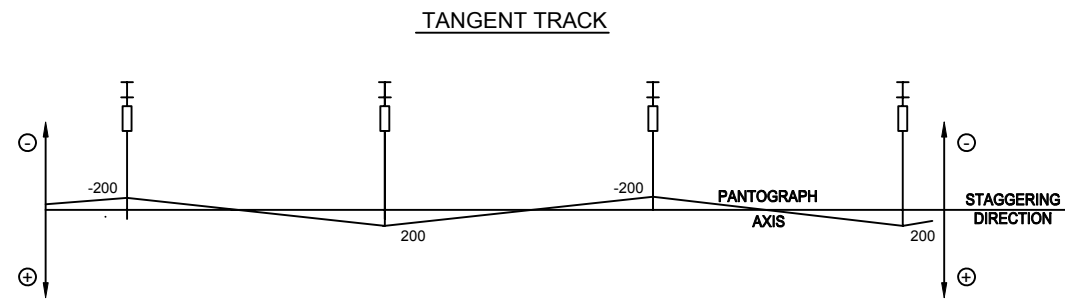

MAXIMUM STAGGERING IN RUNNING TRACK

Wind speed : 38 m/s	
Radius (m)	Stagger (mm)
∞	-200 / +200
$\infty > R \geq 7500$	-250 / -250
$7500 > R \geq 5000$	-250 / +150
$5000 > R \geq 4000$	-250 / +100
$4000 > R \geq 3000$	-250 / +50
$3000 > R \geq 2500$	-250 / 0
$2500 > R \geq 2000$	-250 / -50
$2000 > R \geq 1800$	-250 / -100
$1800 > R \geq 1600$	-250 / -150
$1600 > R \geq 150$	-250 / -250

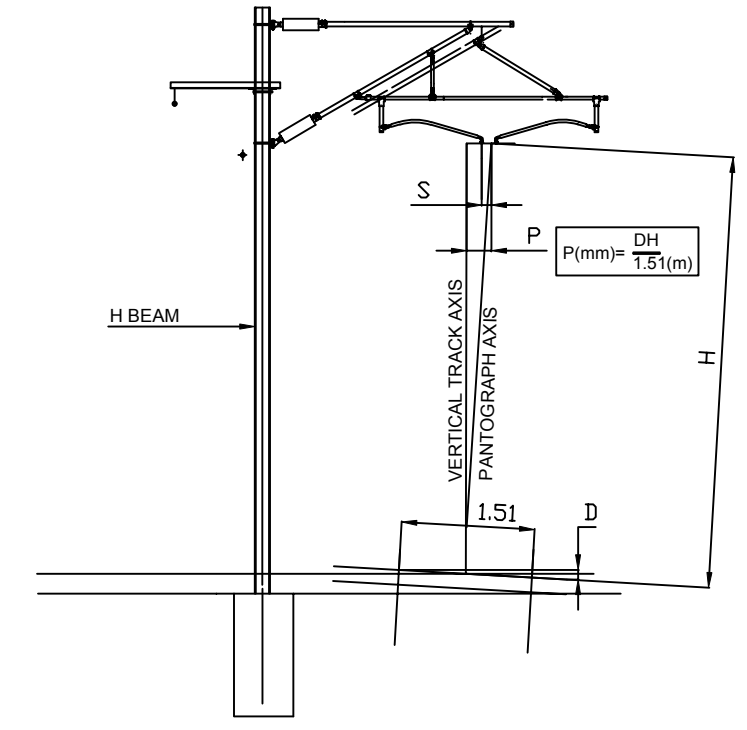

ALLOCATION SPANS

NOTE : THE DIFFERENCES BETWEEN TWO ADJACENT SPANS WILL NOT EXCEED 15 m

FC: 100mmp; CP: 70mmp


Radius (m)	∞	$\infty > R > 1200$	$1200 \geq R > 800$	$800 \geq R > 500$	$500 \geq R > 300$	$300 \geq R > 250$	$250 \geq R > 180$	$180 \geq R$
Span Length (m)	49.5	49.5	45	40.5	36	32	28	21

FC: 80mmp; CP: 50mmp

Radius (m)	∞	$\infty \geq R > 1000$	$1000 \geq R > 600$	$600 \geq R > 400$	$400 \geq R > 250$	$250 \geq R > 180$	$180 \geq R$
Span Length (m)	45	45	40.5	36	32	28	21

ALEGERE ZIG-ZAG CATENARA IN FUNCTIE DE DESCHIDERE STAGGERING OF CONDUCTORS ALLOCATION OF SPANS	Numele fisierului/ CAD file name:	Scara/ Scale:	Part	Rev.
	01LC00BDG033		1 / 2	0


ALLOCATION STEADY ARMS AND REGISTRATIONS

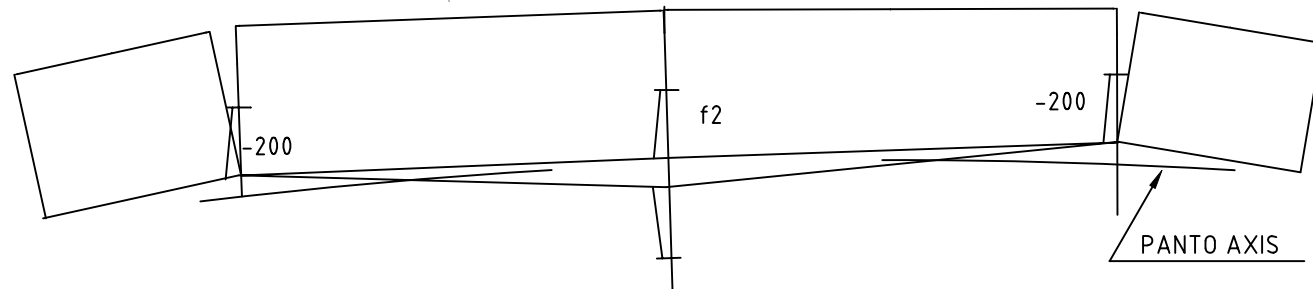

IN ① { SUPPORT OUTSIDE THE CURVE, COMPRESSION REGISTRATION TUBE } WHEN $\frac{(L1 + L2)^2}{8R} - f2 < 200$
 { SUPPORT INSIDE THE CURVE, TENSION REGISTRATION TUBE }

THIS RULE IS NOT USED AT THE END OF OVERLAP AND TURNOUT

RADIUS CALCULATION IN TRANSITION CURVE

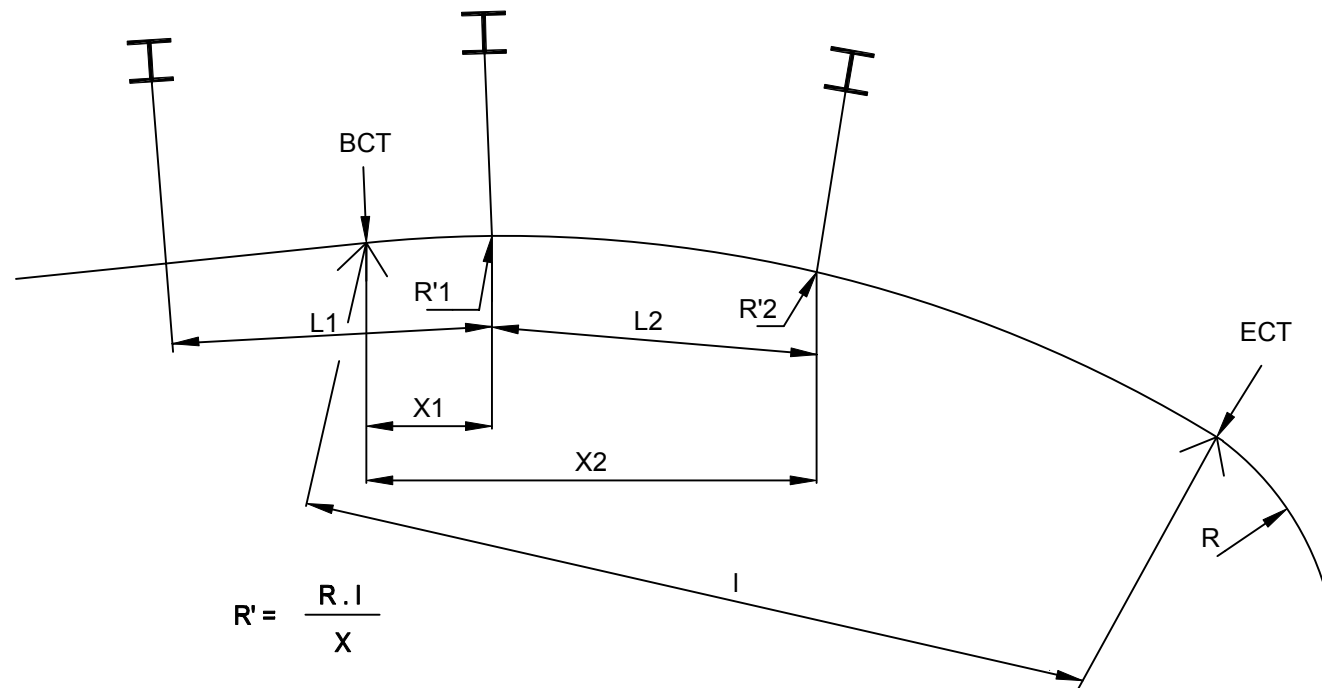

$$R' = \frac{R \cdot I}{X}$$

R : CURVE RADIUS IN METRE
 I : LENGTH OF TRANSITION CURVE
 X : DISTANCE FROM BEGINNING CURVE TRANSITION TO NEEDED SUPPORT

BCT : BEGINNING CURVE TRANSITION
 ECT : END CURVE TRANSITION


CONDUCTOR STAGGERING IN TRANSITION CURVE

THE CATENARY STAGGER AT THE SUPPORT IN TRANSITION CURVE WILL BE DEFINED IN ORDER TO RESPECT THE LIMIT VALUES OF MID-SPAN STAGGER f'. STAGGERS f1 AND f2 AT ADJACENT MASTS OF A GIVEN SPAN WILL BE DEFINED AS FOLLOWS :

$$S1 + S2 = 2(f' + F) \text{ WITH } F = \frac{L^2}{8R}$$

S1, S2 : STAGGER AT ADJACENT MASTS
 f' : STAGGER AT MID-SPAN
 F : CATENARY OFFSET DUE TO CURVE RADIUS
 L : AVERAGE SPAN LENGTH
 R : CURVE RADIUS

THE MID-SPAN STAGGER f' SHOULD BE TAKEN AS LOW AS POSSIBLE, AND SHOULD BE INCLUDED IN THE RANGE [f'1 ; f'2]

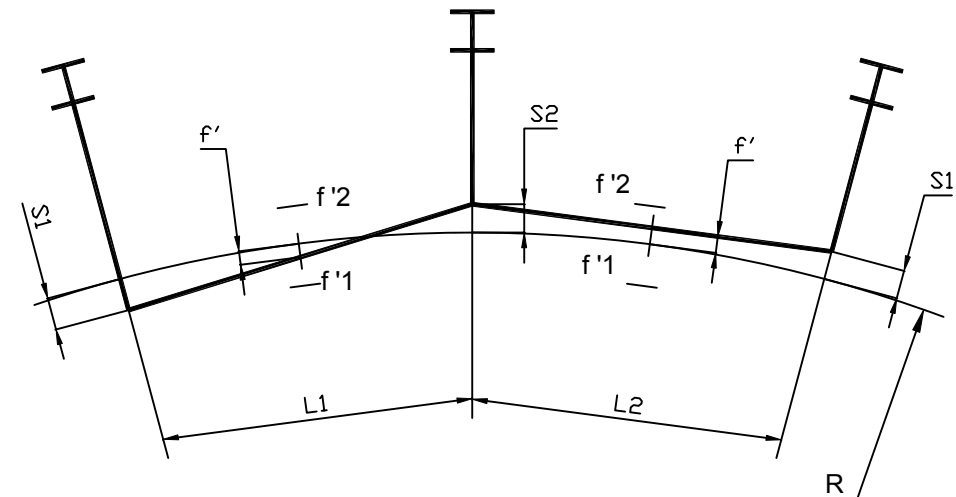


THE VALUES f1 AND f2 HAVE TO BE ADDED WHEN CATENARY IS STAGGERED AT THE SAME SIDE OF THE TRACK AXIS, AND THE LOWER VALUE SHOULD BE SUBTRACT FROM THE HIGHER WHEN f1 AND f2 ARE NOT AT THE SAME SIDE OF THIS AXIS. THE MID-SPAN STAGGER f' HAS TO BE SUBTRACT FROM F WHEN MEASURED FROM TRACK CENTRELINE TO INSIDE CURVE, AND ADDED WHEN MEASURED IN OUTSIDE CURVE.


GENERAL ARRANGEMENT
 STAGGERING OF CONDUCTORS ALLOCATION OF SPANS AND
 REGISTRATION TUBE FOR MAIN TRACK

ALEGERE ZIG-ZAG CATENARA IN FUNCTIE DE DESCHIDERE STAGGERING OF CONDUCTORS ALLOCATION OF SPANS	Numele fisierului/ CAD file name: 01LC00BDG033	Scara/ Scale:	Part 2 / 2	Rev. 0
--	--	------------------	---------------	-----------


FULL COMPENSATED CATENARY ANCHORING

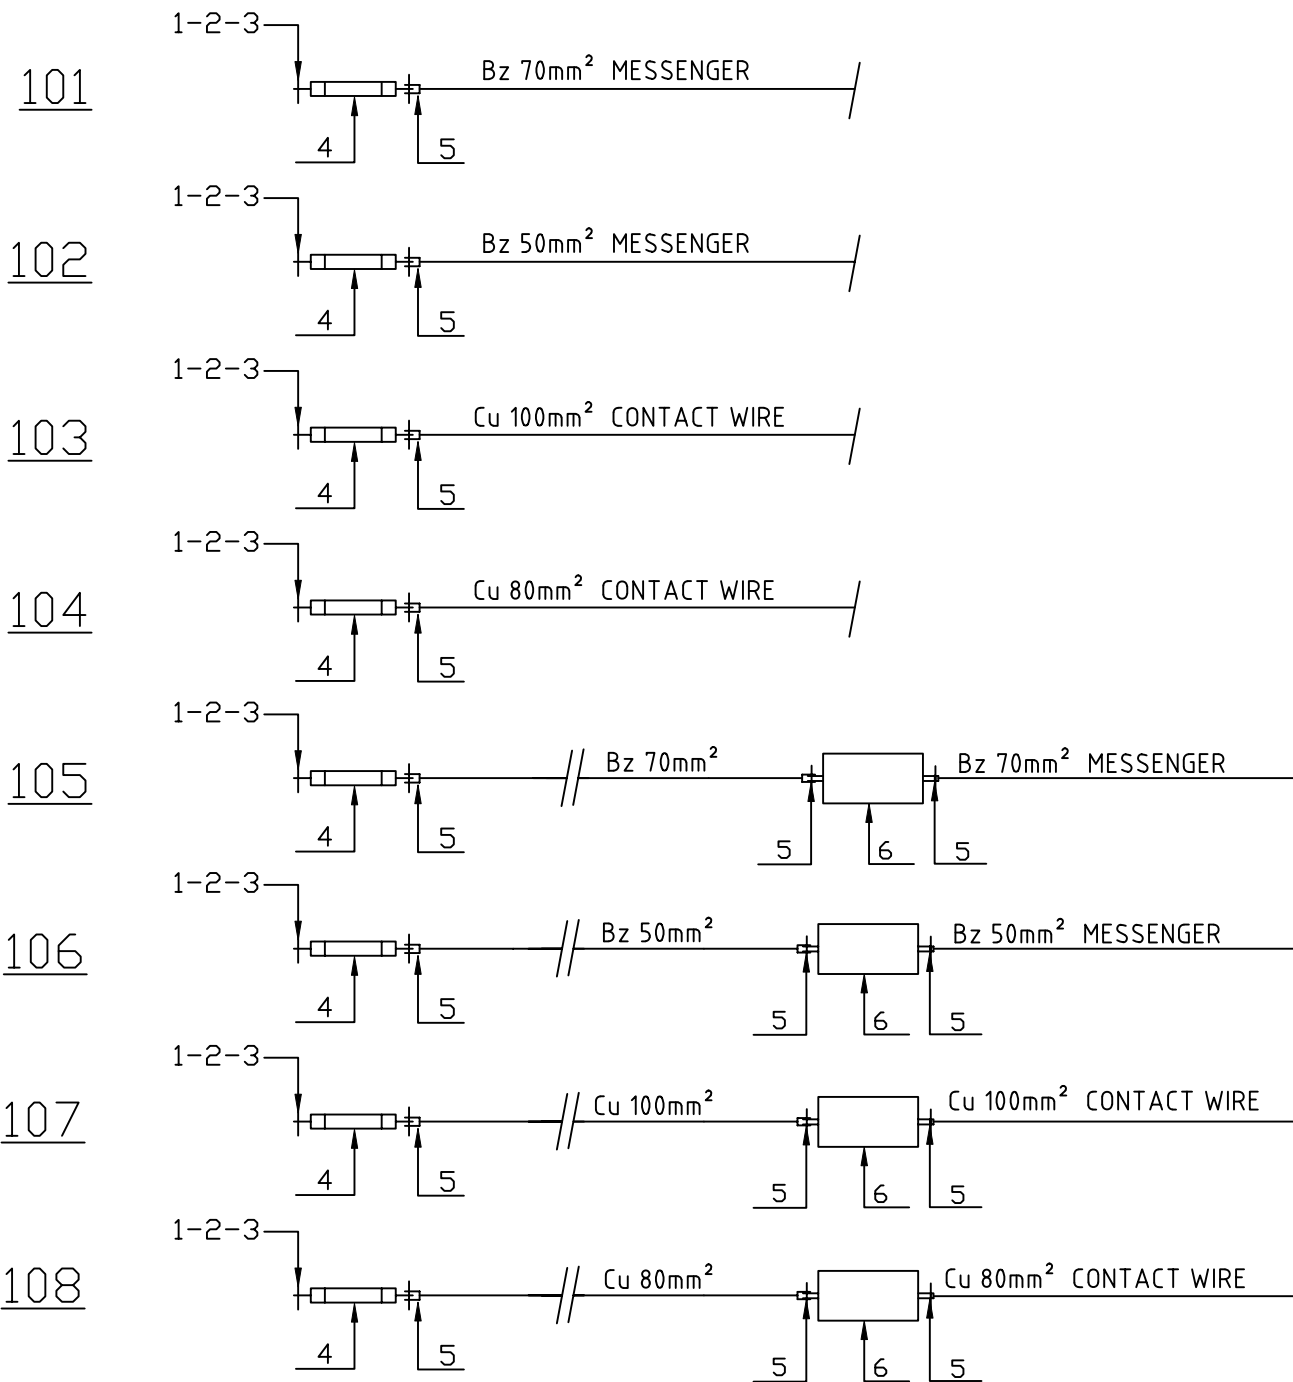

CATENARY RIGID ANCHORING

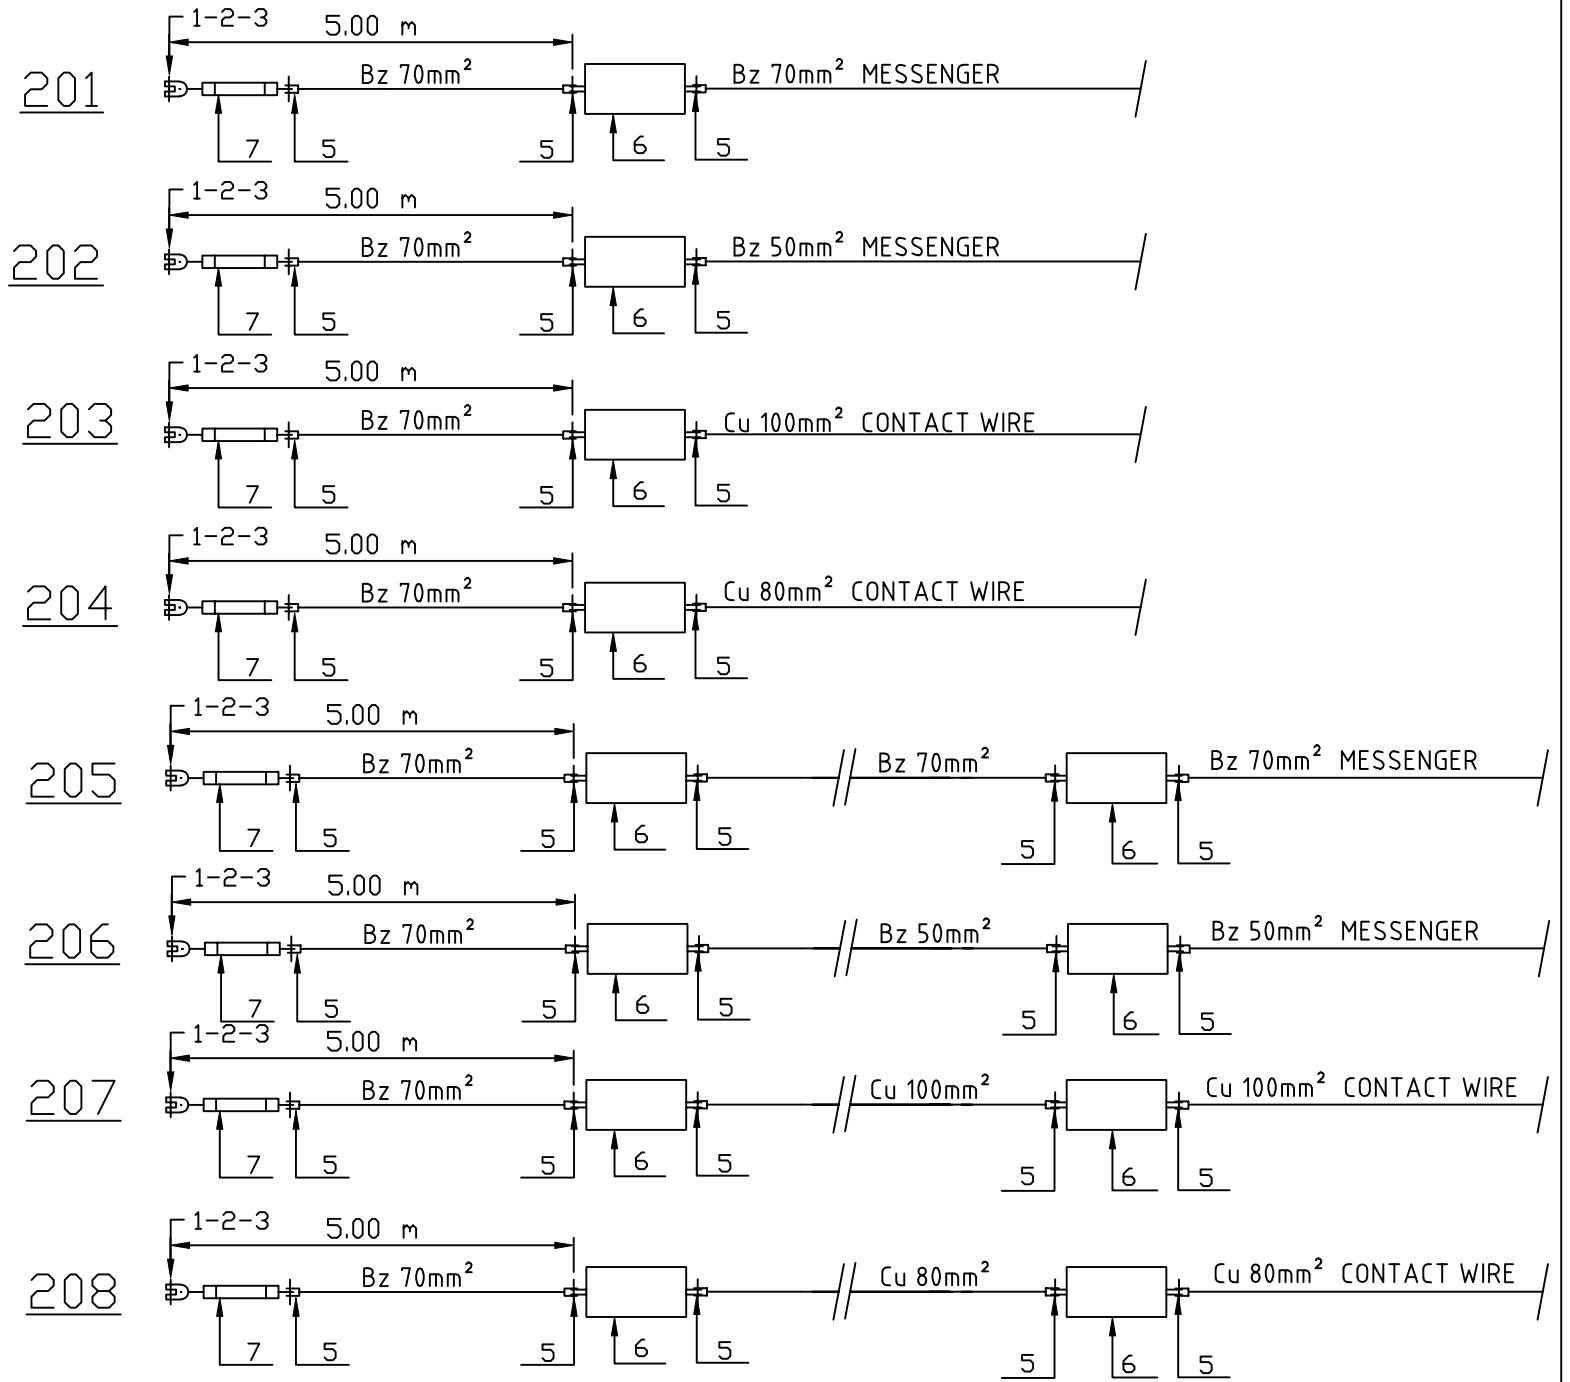


SUPPLEMENTARY INSULATOR

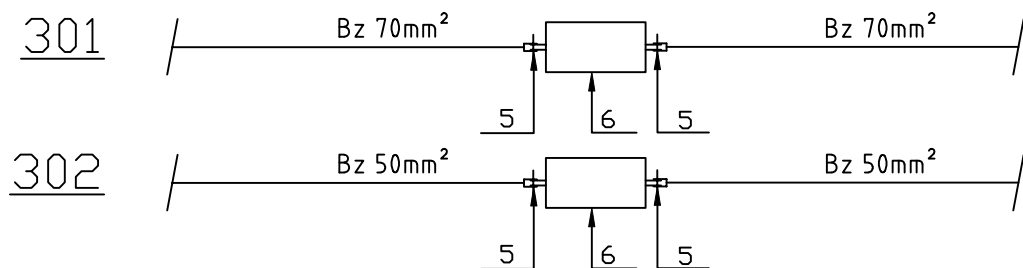

MARK GROUP	QUANTITY	ITEM	DESIGNATION	REFERENCE DRAWING	MARK
302	1	7	TURNBUCKLE	01LC00BDG214	102
301	1	6	COMPOSITE INSULATOR	01LC00BDG018	
208	2	5	CLAMP	ELC 9-29.0	
207	2	5	CLAMP	ELC 9-29.0	
206	2	5	CLAMP	ELC 9-29.0	
205	2	5	CLAMP	ELC 9-29.0	
204	3	3	CLAMP	ELC 9-29.0	
203	3	3	CLAMP	ELC 9-29.0	
202	3	3	CLAMP	ELC 9-29.0	
201	3	3	CLAMP	ELC 9-29.0	
108	1	1	TURNBUCKLE	01LC00BDG214	103
107	1	1	TURNBUCKLE	01LC00BDG214	103
106	1	1	TURNBUCKLE	01LC00BDG214	103
105	1	1	TURNBUCKLE	01LC00BDG214	103
104	1	1	TURNBUCKLE	01LC00BDG214	103
103	1	1	TURNBUCKLE	01LC00BDG214	103
102	1	1	TURNBUCKLE	01LC00BDG214	103
101	1	1	TURNBUCKLE	01LC00BDG214	103
	1	3	PIN	01LC00BDG145	22A40
	1	2	WASHER	01LC00BDG142	22A11
	1	1	BOLT	01LC00BDG146	221055

ANCORAREA CONDUCTOARELOR CONDUCTORS ANCHORING	Numele fisierului/ CAD file name:	Scara/ Scale:	Part	Rev.
	01LC00BDG034		1 / 1	0

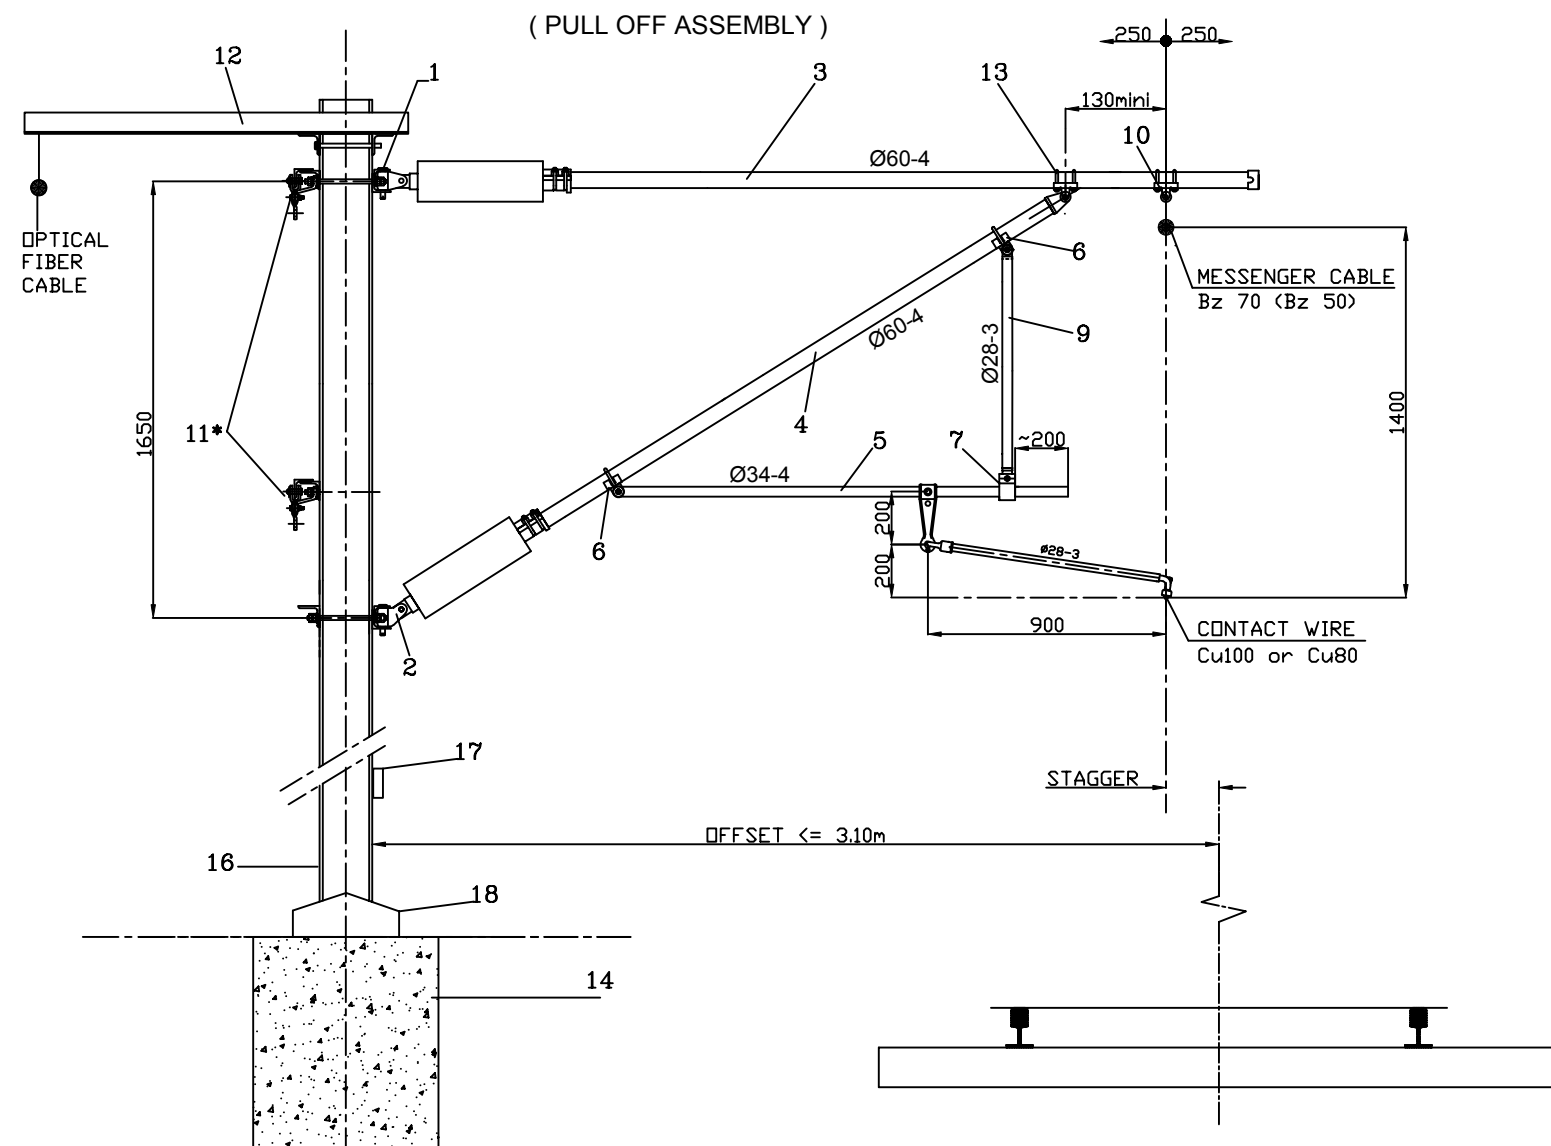


18	DICE PROTECTION	01LC00BDG008	
17	ASSEMBLY OF SAFETY DEVICES		
16	MAST TYPES AND REFERENCES	01LC00BDG010	
15	-	-	
14	POLE FOUNDATION	01LC00BDG006	
13	FASTENING FOR TOP TUBE	01LC00BDG069	
12	OPTICAL FIBER BRACKET	01LC00BDG054	
11	EARTHING SUSPENSION	or 01LC00BDG071 01LC00BDG072	
10	SUSPENSION FOR 1 or 2 MESSENGERS	01LC00BDG070	
9	AUXILIARY STRUT TUBE	01LC00BDG083	
8	AUXILIARY STRUT TUBE	01LC00BDG083	
7	FASTENING ON TUBE $\phi 34$	ELC 26-4.7.0	
6	FASTENING ON TUBE $\phi 60$	ELC 13-1.2.3.0	
5	$\phi 34-4$ REGISTRATION ARM WITH 0.9m STEADY ARM FOR STRAIGHT LINE	01LC00BDG150	
4	INSULATED FOR STRUT TUBE $\phi 60$	01LC00BDG066	
3	INSULATED FOR TOP TUBE $\phi 60$	01LC00BDG064	
2	FASTENING FOR STRUT TUBE	or 01LC00BDG058 01LC00BDG071	
1	FASTENING FOR TOP TUBE	or 01LC00BDG059 01LC00BDG135	
ITEM	DESIGNATION	REFERENCE DRAWING	MARK

NOTE:

* EXACTE POSITION (HEIGHT, FIELD OR TRACK SIDE) WILL BE DEFINED DURING DETAIL DESIGN STAGE

ECHIPARE TIP CATENARA IN LINE CURENTA (CONSOLA TENSIONATA) TYPICAL CATENARY EQUIPMENT ON OPEN ROUTE (PULL OFF ASSEMBLY)	Numele fisierului/ CAD file name:	Scara/ Scale:	Part	Rev.
	01LC00BDG035		1 / 2	0

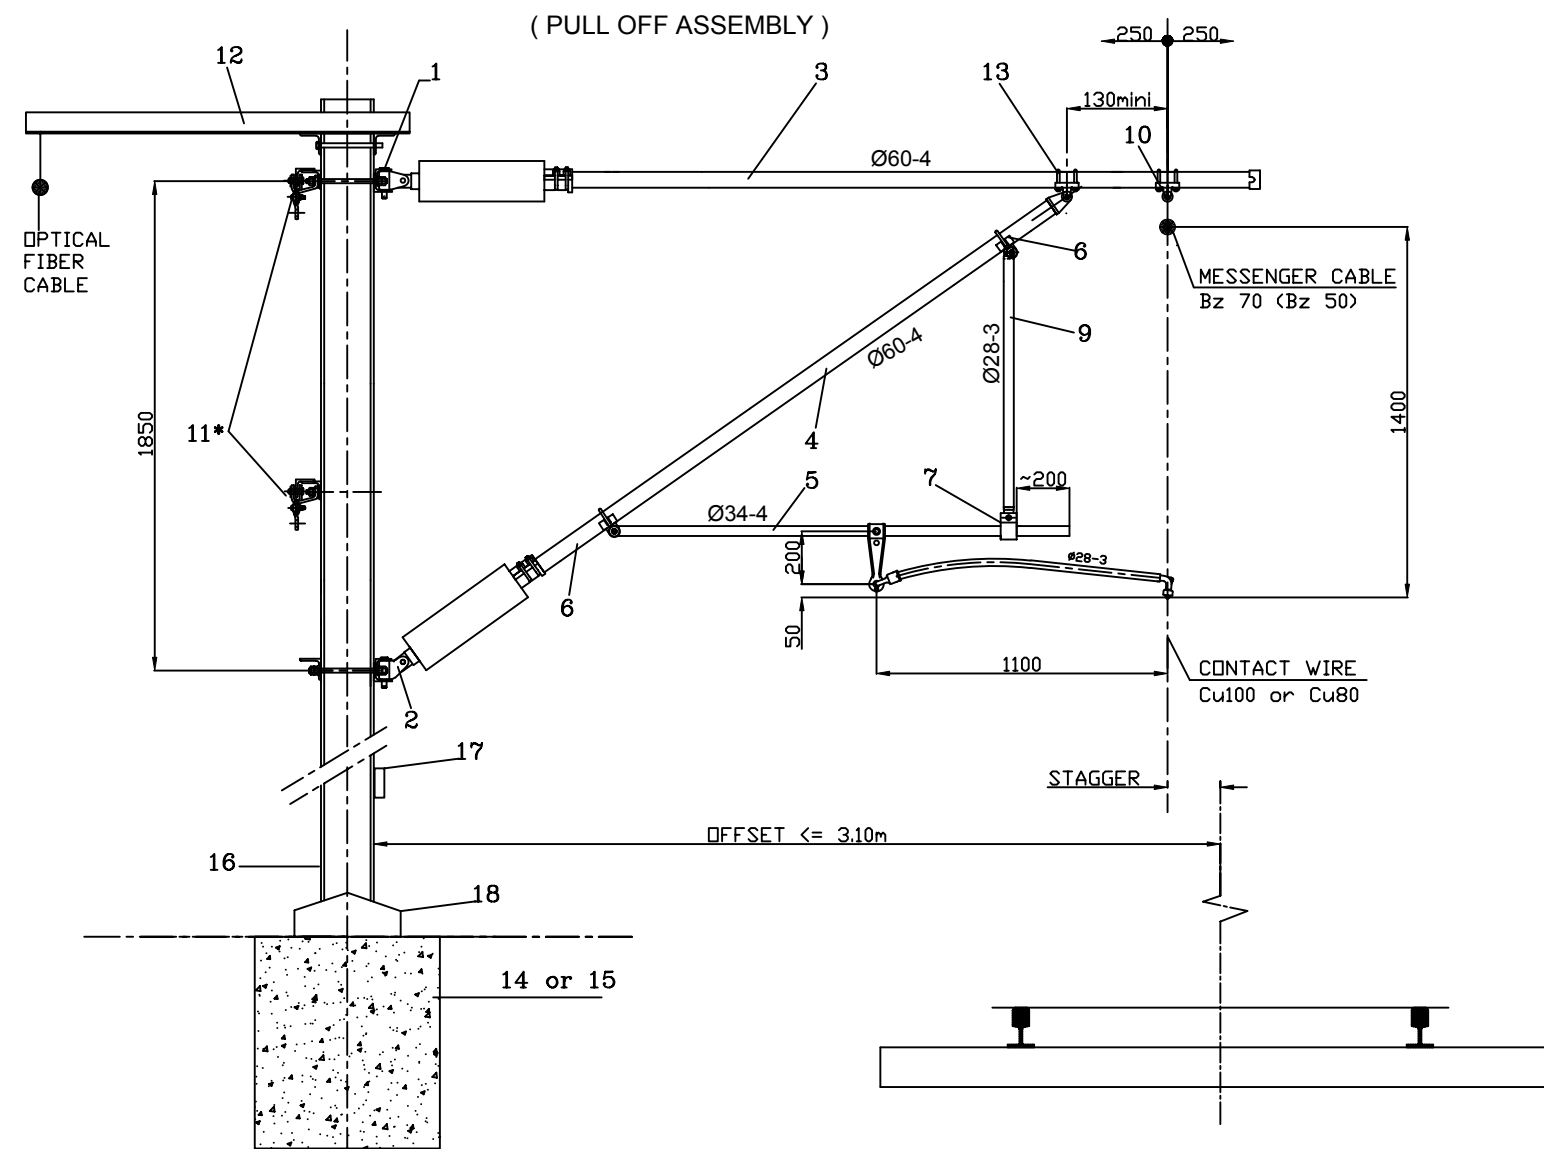


18	DICE PROTECTION	01LC00BDG008	
17	ASSEMBLY OF SAFETY DEVICES		
16	MAST TYPES AND REFERENCES	01LC00BDG010	
15	-	-	
14	POLE FOUNDATION	01LC00BDG006	
13	FASTENING FOR TOP TUBE	01LC00BDG069	
12	OPTICAL FIBER BRACKET	01LC00BDG054	
11	EARTHING SUSPENSION	or 01LC00BDG071 01LC00BDG072	
10	SUSPENSION FOR 1 or 2 MESSENGERS	01LC00BDG070	
9	AUXILIARY STRUT TUBE	01LC00BDG083	
8	AUXILIARY STRUT TUBE	01LC00BDG083	
7	FASTENING ON TUBE Ø34	ELC 26-4.7.0	
6	FASTENING ON TUBE Ø60	ELC 13-1.2.3.0	
5	Ø34-4 REGISTRATION ARM WITH 1.1m STEADY ARM FOR CURVE	01LC00BDG151	
4	INSULATED FOR STRUT TUBE Ø60	01LC00BDG066	
3	INSULATED FOR TOP TUBE Ø60	01LC00BDG064	
2	FASTENING FOR STRUT TUBE	or 01LC00BDG058 01LC00BDG071	
1	FASTENING FOR TOP TUBE	or 01LC00BDG059 01LC00BDG135	
ITEM	DESIGNATION	REFERENCE DRAWING	MARK

NOTE:

* EXACTE POSITION (HEIGHT, FIELD OR TRACK SIDE) WILL BE DEFINED DURING DETAIL DESIGN STAGE

ECHIPARE TIP CATENARA IN LINE CURENTA (CONSOLA TENSIONATA) TYPICAL CATENARY EQUIPMENT ON OPEN ROUTE (PULL OFF ASSEMBLY)	Numele fisierului/ CAD file name:	Scara/ Scale:	Part	Rev.
	01LC00BDG035		2 / 2	0

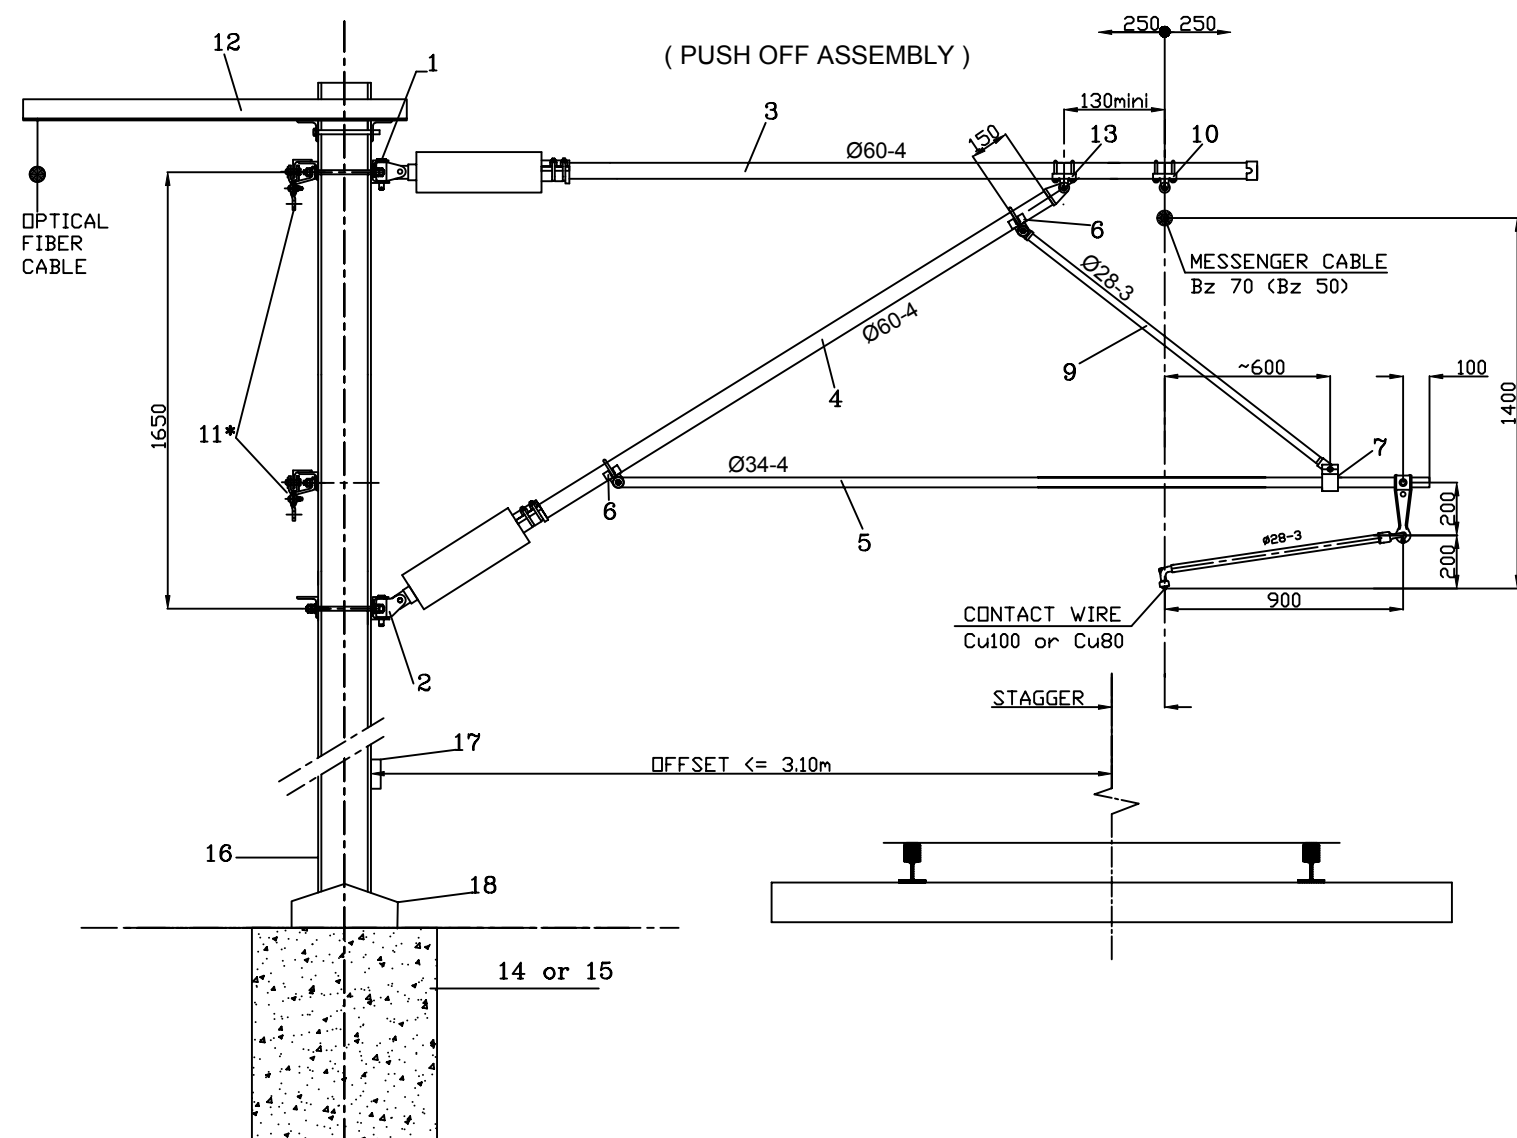


18	DICE PROTECTION	01LC00BDG008	
17	ASSEMBLY OF SAFETY DEVICES		
16	MAST TYPES AND REFERENCES	01LC00BDG010	
15	-	-	
14	POLE FOUNDATION	01LC00BDG006	
13	FASTENING FOR TOP TUBE	01LC00BDG069	
12	OPTICAL FIBER BRACKET	01LC00BDG054	
11	EARTHING SUSPENSION	or 01LC00BDG071 01LC00BDG072	
10	SUSPENSION FOR 1 or 2 MESSENGERS	01LC00BDG070	
9	AUXILIARY STRUT TUBE	01LC00BDG083	
7	FASTENING ON TUBE $\varnothing 34$	ELC 26-4.7.0	
6	FASTENING ON TUBE $\varnothing 60$	ELC 13-1.2.3.0	
5	$\varnothing 34-4$ REGISTRATION ARM WITH 0.9m STEADY ARM FOR STRAIGHT LINE	01LC00BDG150	
4	INSULATED FOR STRUT TUBE $\varnothing 60$	01LC00BDG066	
3	INSULATED FOR TOP TUBE $\varnothing 60$	01LC00BDG064	
2	FASTENING FOR STRUT TUBE	or 01LC00BDG058 01LC00BDG071	
1	FASTENING FOR TOP TUBE	or 01LC00BDG059 01LC00BDG135	
ITEM	DESIGNATION	REFERENCE DRAWING	MARK

NOTE:

* EXACTE POSITION (HEIGHT, FIELD OR TRACK SIDE) WILL BE DEFINED DURING DETAIL DESIGN STAGE

ECHIPARE TIP CATENARA IN LINE CURENTA (CONSOLA TENSIONATA) TYPICAL CATENARY EQUIPMENT ON OPEN ROUTE (PUSH OFF ASSEMBLY)	Numele fisierului/ CAD file name:	Scara/ Scale:	Part	Rev.
	01LC00BDG036		1 / 3	0

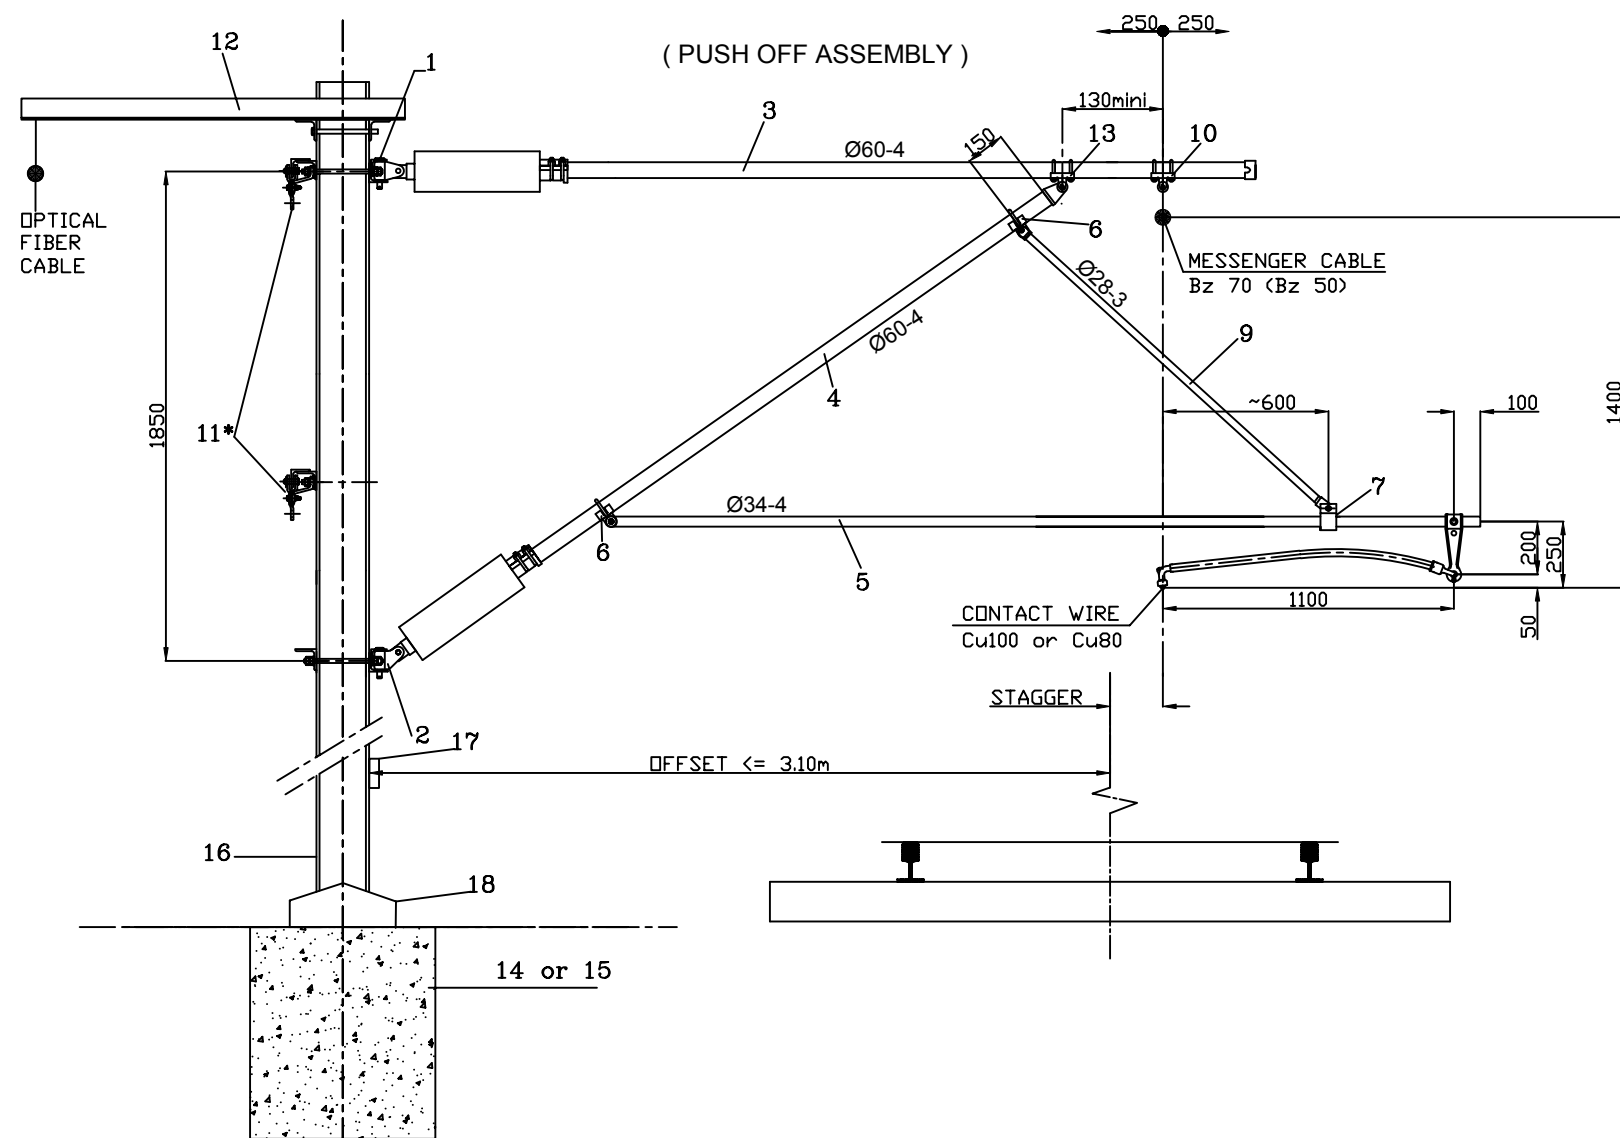


18	DICE PROTECTION	01LC00BDG008	
17	ASSEMBLY OF SAFETY DEVICES		
16	MAST TYPES AND REFERENCES	01LC00BDG010	
15	-	-	
14	POLE FOUNDATION	01LC00BDG006	
13	FASTENING FOR TOP TUBE	01LC00BDG069	
12	OPTICAL FIBER BRACKET	01LC00BDG054	
11	EARTHING SUSPENSION	or 01LC00BDG071 01LC00BDG072	
10	SUSPENSION FOR 1 or 2 MESSENGERS	01LC00BDG070	
9	AUXILIARY STRUT TUBE	01LC00BDG083	
7	FASTENING ON TUBE Ø34	ELC 26-4.7.0	
6	FASTENING ON TUBE Ø60	ELC 13-1.2.3.0	
5	Ø34-4 REGISTRATION ARM WITH 1.1m STEADY ARM FOR CURVE	01LC00BDG151	
4	INSULATED FOR STRUT TUBE Ø60	01LC00BDG066	
3	INSULATED FOR TOP TUBE Ø60	01LC00BDG064	
2	FASTENING FOR STRUT TUBE	or 01LC00BDG058 01LC00BDG071	
1	FASTENING FOR TOP TUBE	or 01LC00BDG059 01LC00BDG135	
ITEM	DESIGNATION	REFERENCE DRAWING	MARK

NOTE:

* EXACTE POSITION (HEIGHT, FIELD OR TRACK SIDE) WILL BE DEFINED DURING DETAIL DESIGN STAGE

ECHIPARE TIP CATENARA IN LINE CURENTA (CONSOLA TENSIONATA) TYPICAL CATENARY EQUIPMENT ON OPEN ROUTE (PUSH OFF ASSEMBLY)	Numele fisierului/ CAD file name:	Scara/ Scale:	Part	Rev.
	01LC00BDG036		2 / 3	0

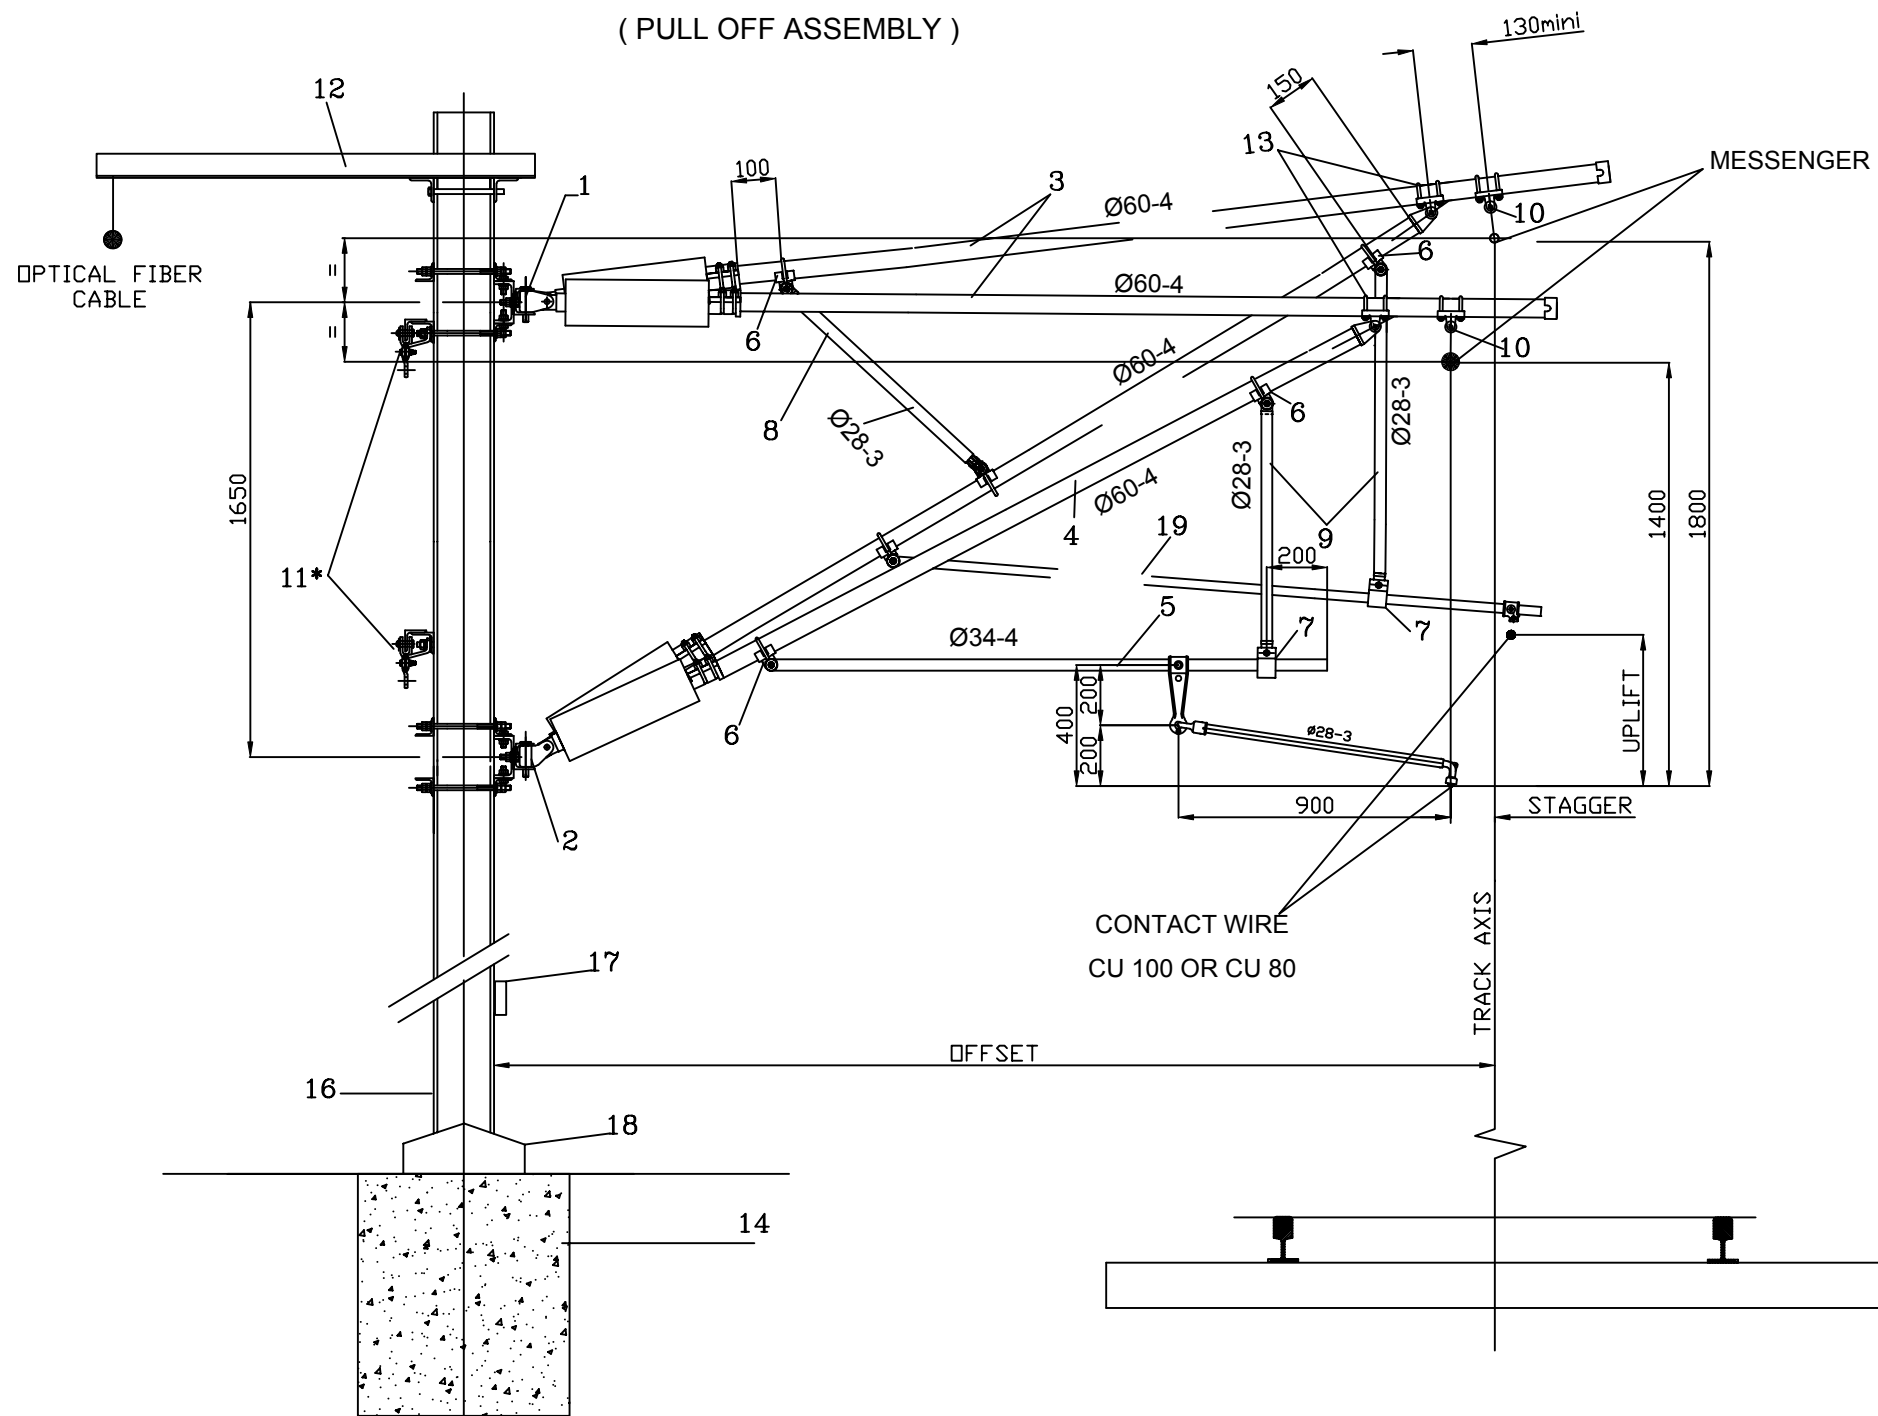


19	REGISTRATION ARM FOR UPLIFT C.W.	ELC 32-13.D.A	
18	DICE PROTECTION	01LC00BDG008	
17	ASSEMBLY OF SAFETY DEVICES		
16	MAST TYPES AND REFERENCES	01LC00BDG010	
15	-	-	
14	POLE FOUNDATION	01LC00BDG006	
13	FASTENING FOR TOP TUBE	01LC00BDG069	
12	OPTICAL FIBER BRACKET	01LC00BDG054	
11	EARTHING SUSPENSION	or 01LC00BDG0136 01LC00BDG072	
10	SUSPENSION FOR 1 OR 2 MESSENGER	01LC00BDG070	
9	AUXILIARY STRUT TUBE	01LC00BDG083	
8	AUXILIARY STRUT TUBE	01LC00BDG083	
7	FASTENING ON TUBE Ø34	ELC 26-4.7.0	
6	FASTENING ON TUBE Ø60	ELC 13-1.2.3.0	
5	Ø34-4 REGISTRATION ARM WITH 0.9m STEADY ARM FOR STRAIGHT LINE	01LC00BDG150	201
4	INSULATED FOR STRUT TUBE Ø60	01LC00BDG066	
3	INSULATED FOR TOP TUBE Ø60	01LC00BDG064	
2	FASTENING FOR STRUT TUBE	or 01LC00BDG060 01LC00BDG078	
1	FASTENING FOR TOP TUBE	or 01LC00BDG061 01LC00BDG136	
ITEM	DESIGNATION	REFERENCE DRAWING	MARK

NOTE:

* EXACTE POSITION (HEIGHT, FIELD OR TRACK SIDE) WILL BE DEFINED DURING DETAIL DESIGN STAGE

ECHIPARE TIP CATENARA (CU DISTANTA INTRE CONSOLE DE 1m) TYPICAL CATENARY EQUIPMENT (WITH EQUIPMENTS SPACING 1m)	Numele fisierului/ CAD file name:	Scara/ Scale:	Part	Rev.
	01LC00BDG037		1 / 4	0

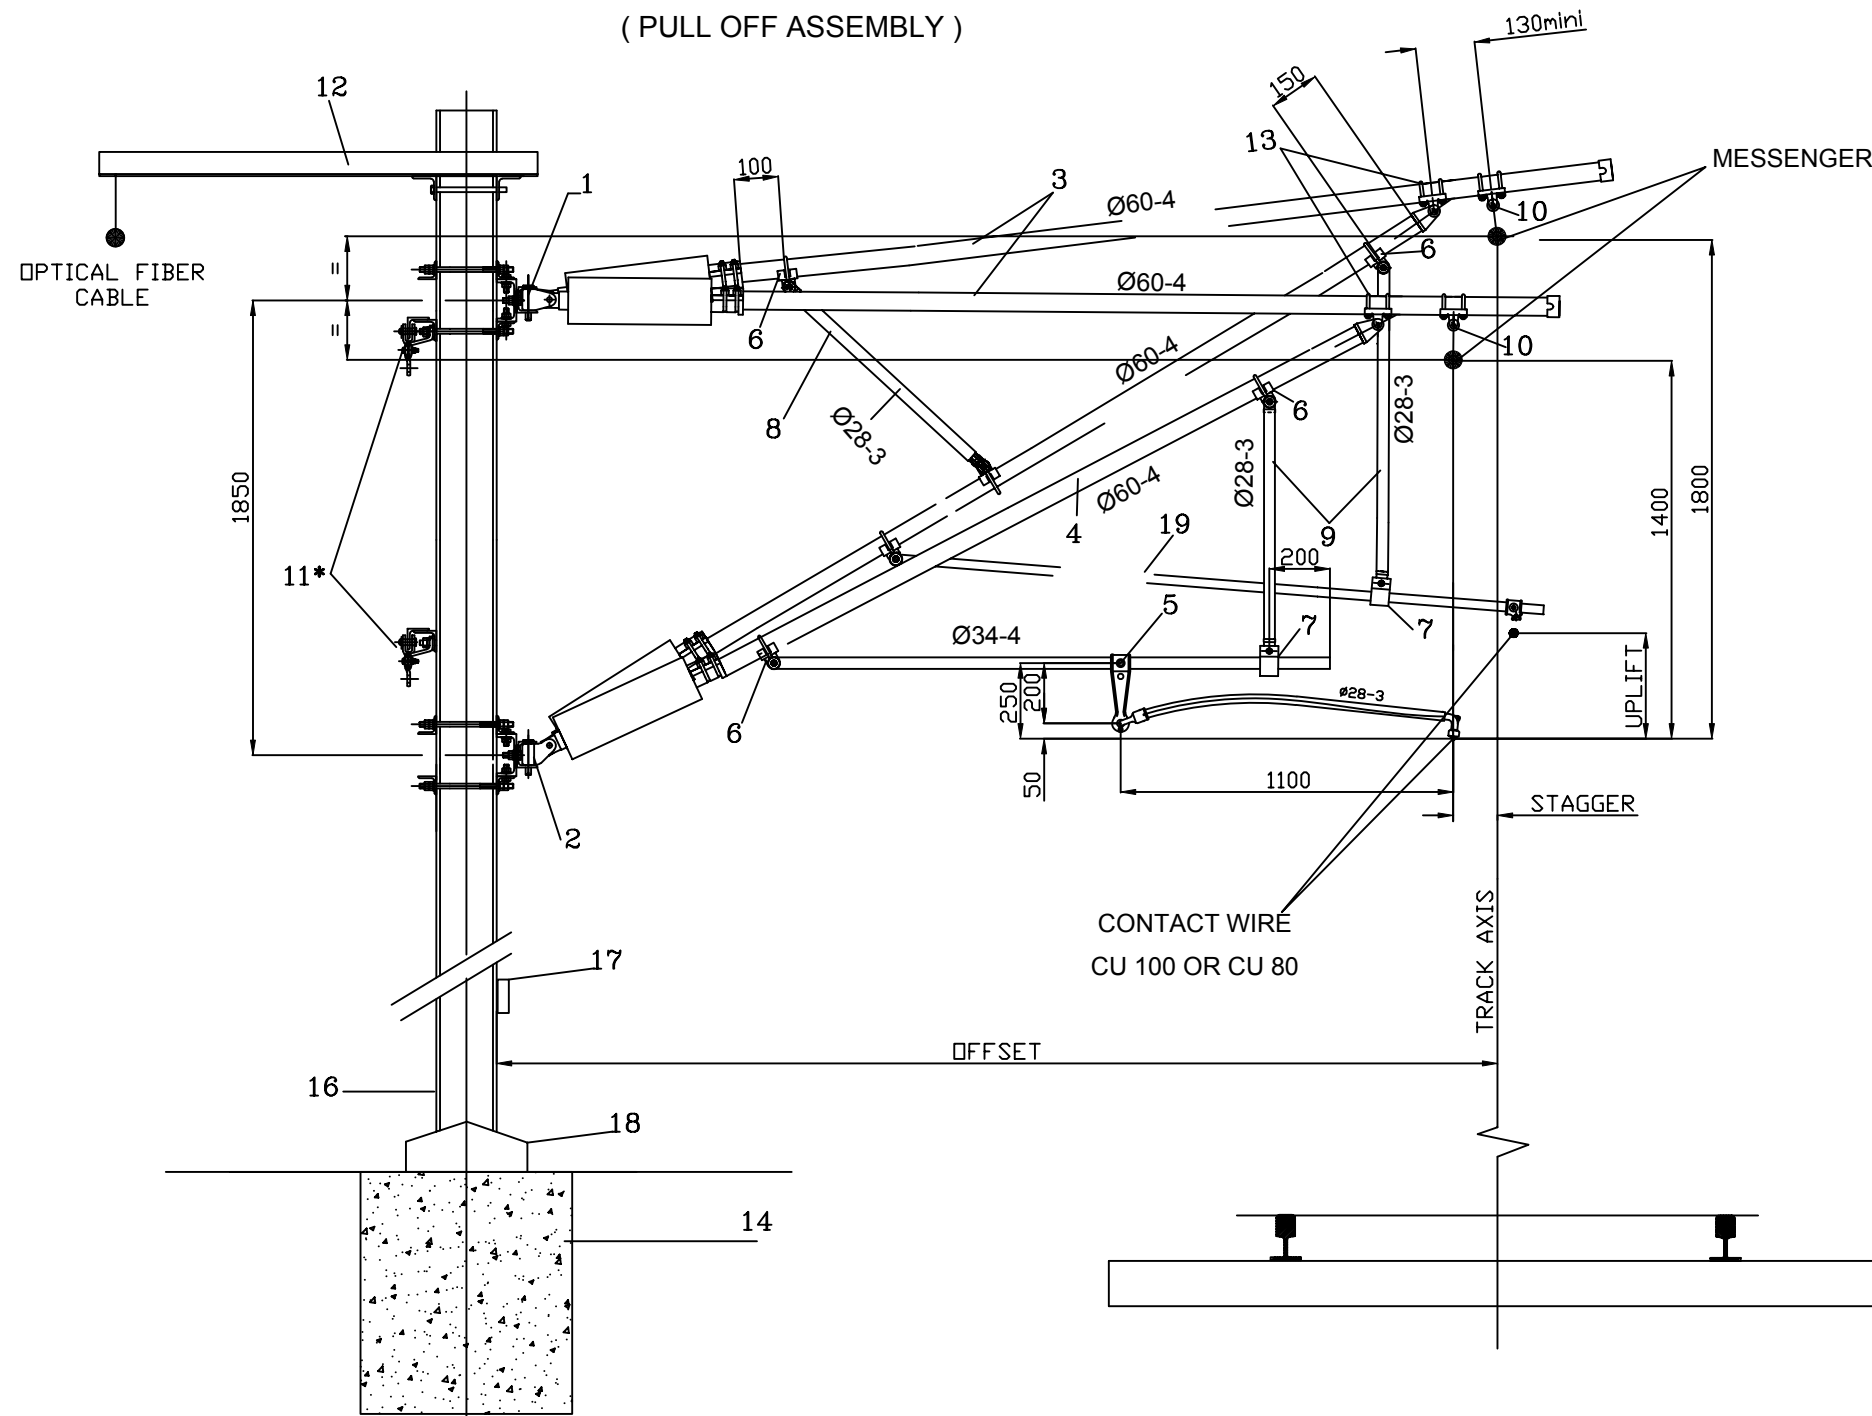


19	REGISTRATION ARM FOR UPLIFT C.W.	ELC 32-13.0.A	
18	DICE PROTECTION	01LC00BDG008	
17	ASSEMBLY OF SAFETY DEVICES		
16	MAST TYPES AND REFERENCES	01LC00BDG010	
15	-	-	
14	POLE FOUNDATION	01LC00BDG006	
13	FASTENING FOR TOP TUBE	01LC00BDG069	
12	OPTICAL FIBER BRACKET	01LC00BDG054	
11	EARTHING SUSPENSION	or 01LC00BDG0136 01LC00BDG072	
10	SUSPENSION FOR 1 OR 2 MESSENGER	01LC00BDG070	
9	AUXILIARY STRUT TUBE	01LC00BDG083	
8	AUXILIARY STRUT TUBE	01LC00BDG083	
7	FASTENING ON TUBE Ø34	ELC 26-4.7.0	
6	FASTENING ON TUBE Ø60	ELC 13-1.2.3.0	
5	Ø34-4 REGISTRATION ARM WITH 1.1m STEADY ARM FOR CURVE	01LC00BDG151	201
4	INSULATED FOR STRUT TUBE Ø60	01LC00BDG066	
3	INSULATED FOR TOP TUBE Ø60	01LC00BDG064	
2	FASTENING FOR STRUT TUBE	or 01LC00BDG060 01LC00BDG078	
1	FASTENING FOR TOP TUBE	or 01LC00BDG061 01LC00BDG136	
ITEM	DESIGNATION	REFERENCE DRAWING	MARK

NOTE:

* EXACTE POSITION (HEIGHT, FIELD OR TRACK SIDE) WILL BE DEFINED DURING DETAIL DESIGN STAGE

ECHIPARE TIP CATENARA (CU DISTANTA INTRE CONSOLE DE 1m) TYPICAL CATENARY EQUIPMENT (WITH EQUIPMENTS SPACING 1m)	Numele fisierului/ CAD file name:	Scara/ Scale:	Part	Rev.
	01LC00BDG037		2 / 4	0

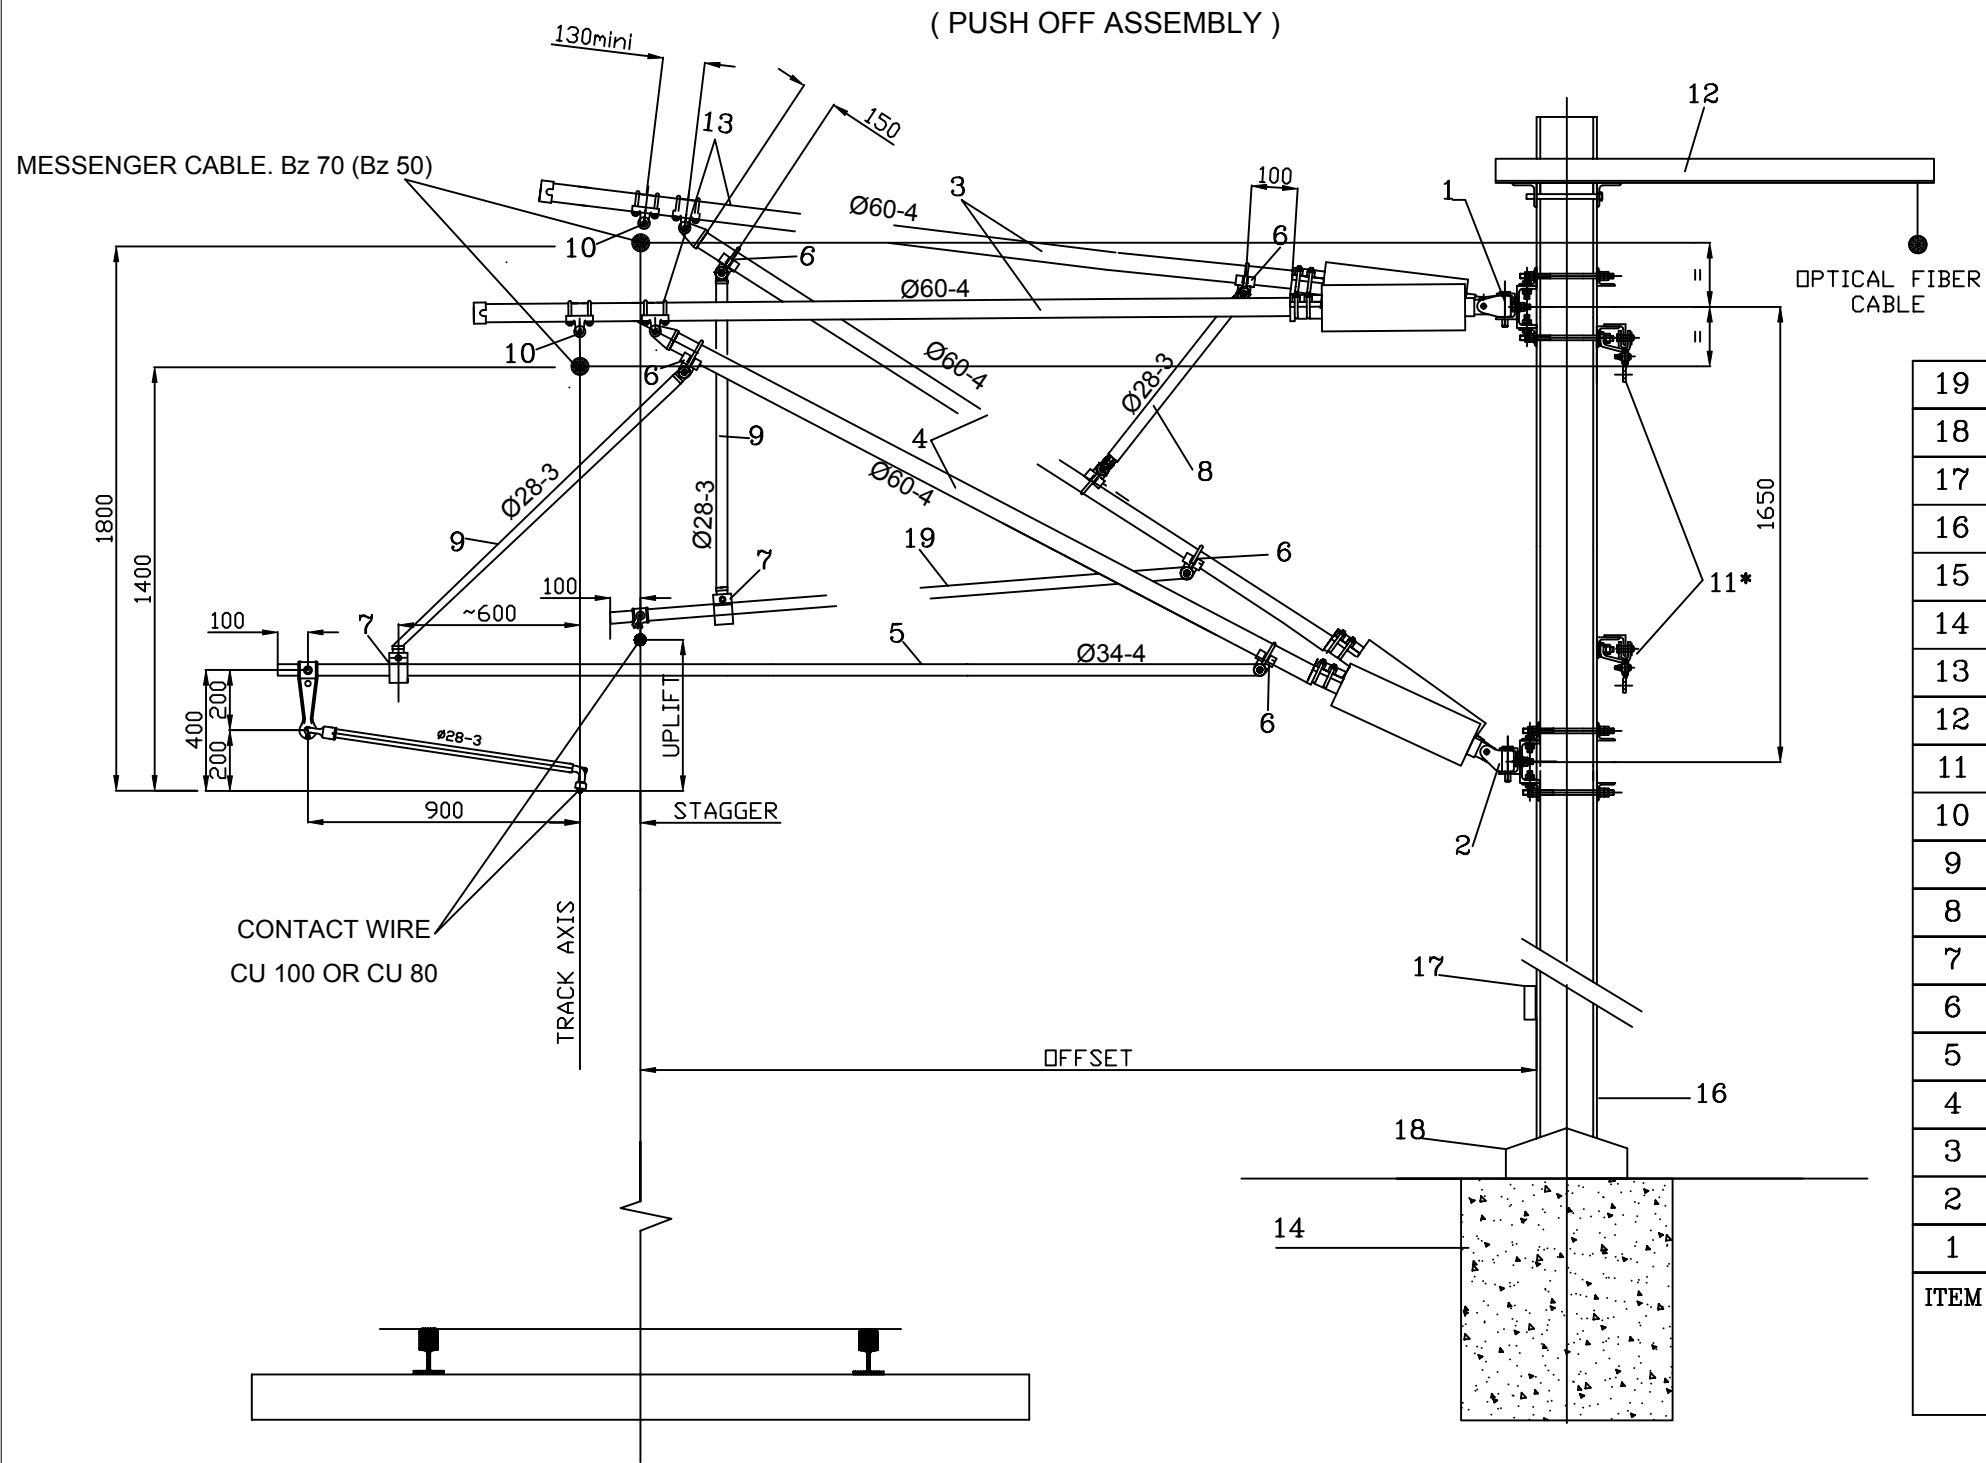


19	REGISTRATION ARM FOR UPLIFT C.W.	ELC 32-13.0.A	
18	DICE PROTECTION	01LC00BDG008	
17	ASSEMBLY OF SAFETY DEVICES		
16	MAST TYPES AND REFERENCES	01LC00BDG010	
15	-	-	
14	POLE FOUNDATION	01LC00BDG006	
13	FASTENING FOR TOP TUBE	01LC00BDG069	
12	OPTICAL FIBER BRACKET	01LC00BDG054	
11	EARTHING SUSPENSION	or 01LC00BDG0136 01LC00BDG072	
10	SUSPENSION FOR 1 OR 2 MESSENGER	01LC00BDG070	
9	AUXILIARY STRUT TUBE	01LC00BDG083	
8	AUXILIARY STRUT TUBE	01LC00BDG083	
7	FASTENING ON TUBE $\phi 34$	ELC 26-4.7.0	
6	FASTENING ON TUBE $\phi 60$	ELC 13-1.2.3.0	
5	$\phi 34-4$ REGISTRATION ARM WITH 0.9m STEADY ARM FOR STRAIGHT LINE	01LC00BDG150	202
4	INSULATED FOR STRUT TUBE $\phi 60$	01LC00BDG066	
3	INSULATED FOR TOP TUBE $\phi 60$	01LC00BDG064	
2	FASTENING FOR STRUT TUBE	or 01LC00BDG060 01LC00BDG078	
1	FASTENING FOR TOP TUBE	or 01LC00BDG061 01LC00BDG136	
ITEM	DESIGNATION	REFERENCE DRAWING	MARK

NOTE:

* EXACTE POSITION (HEIGHT, FIELD OR TRACK SIDE) WILL BE DEFINED DURING DETAIL DESIGN STAGE

ECHIPARE TIP CATENARA (CU DISTANTA INTRE CONSOLE DE 1m) TYPICAL CATENARY EQUIPMENT (WITH EQUIPMENTS SPACING 1m)	Numele fisierului/ CAD file name:	Scara/ Scale:	Part	Rev.
	01LC00BDG037		3 / 4	0

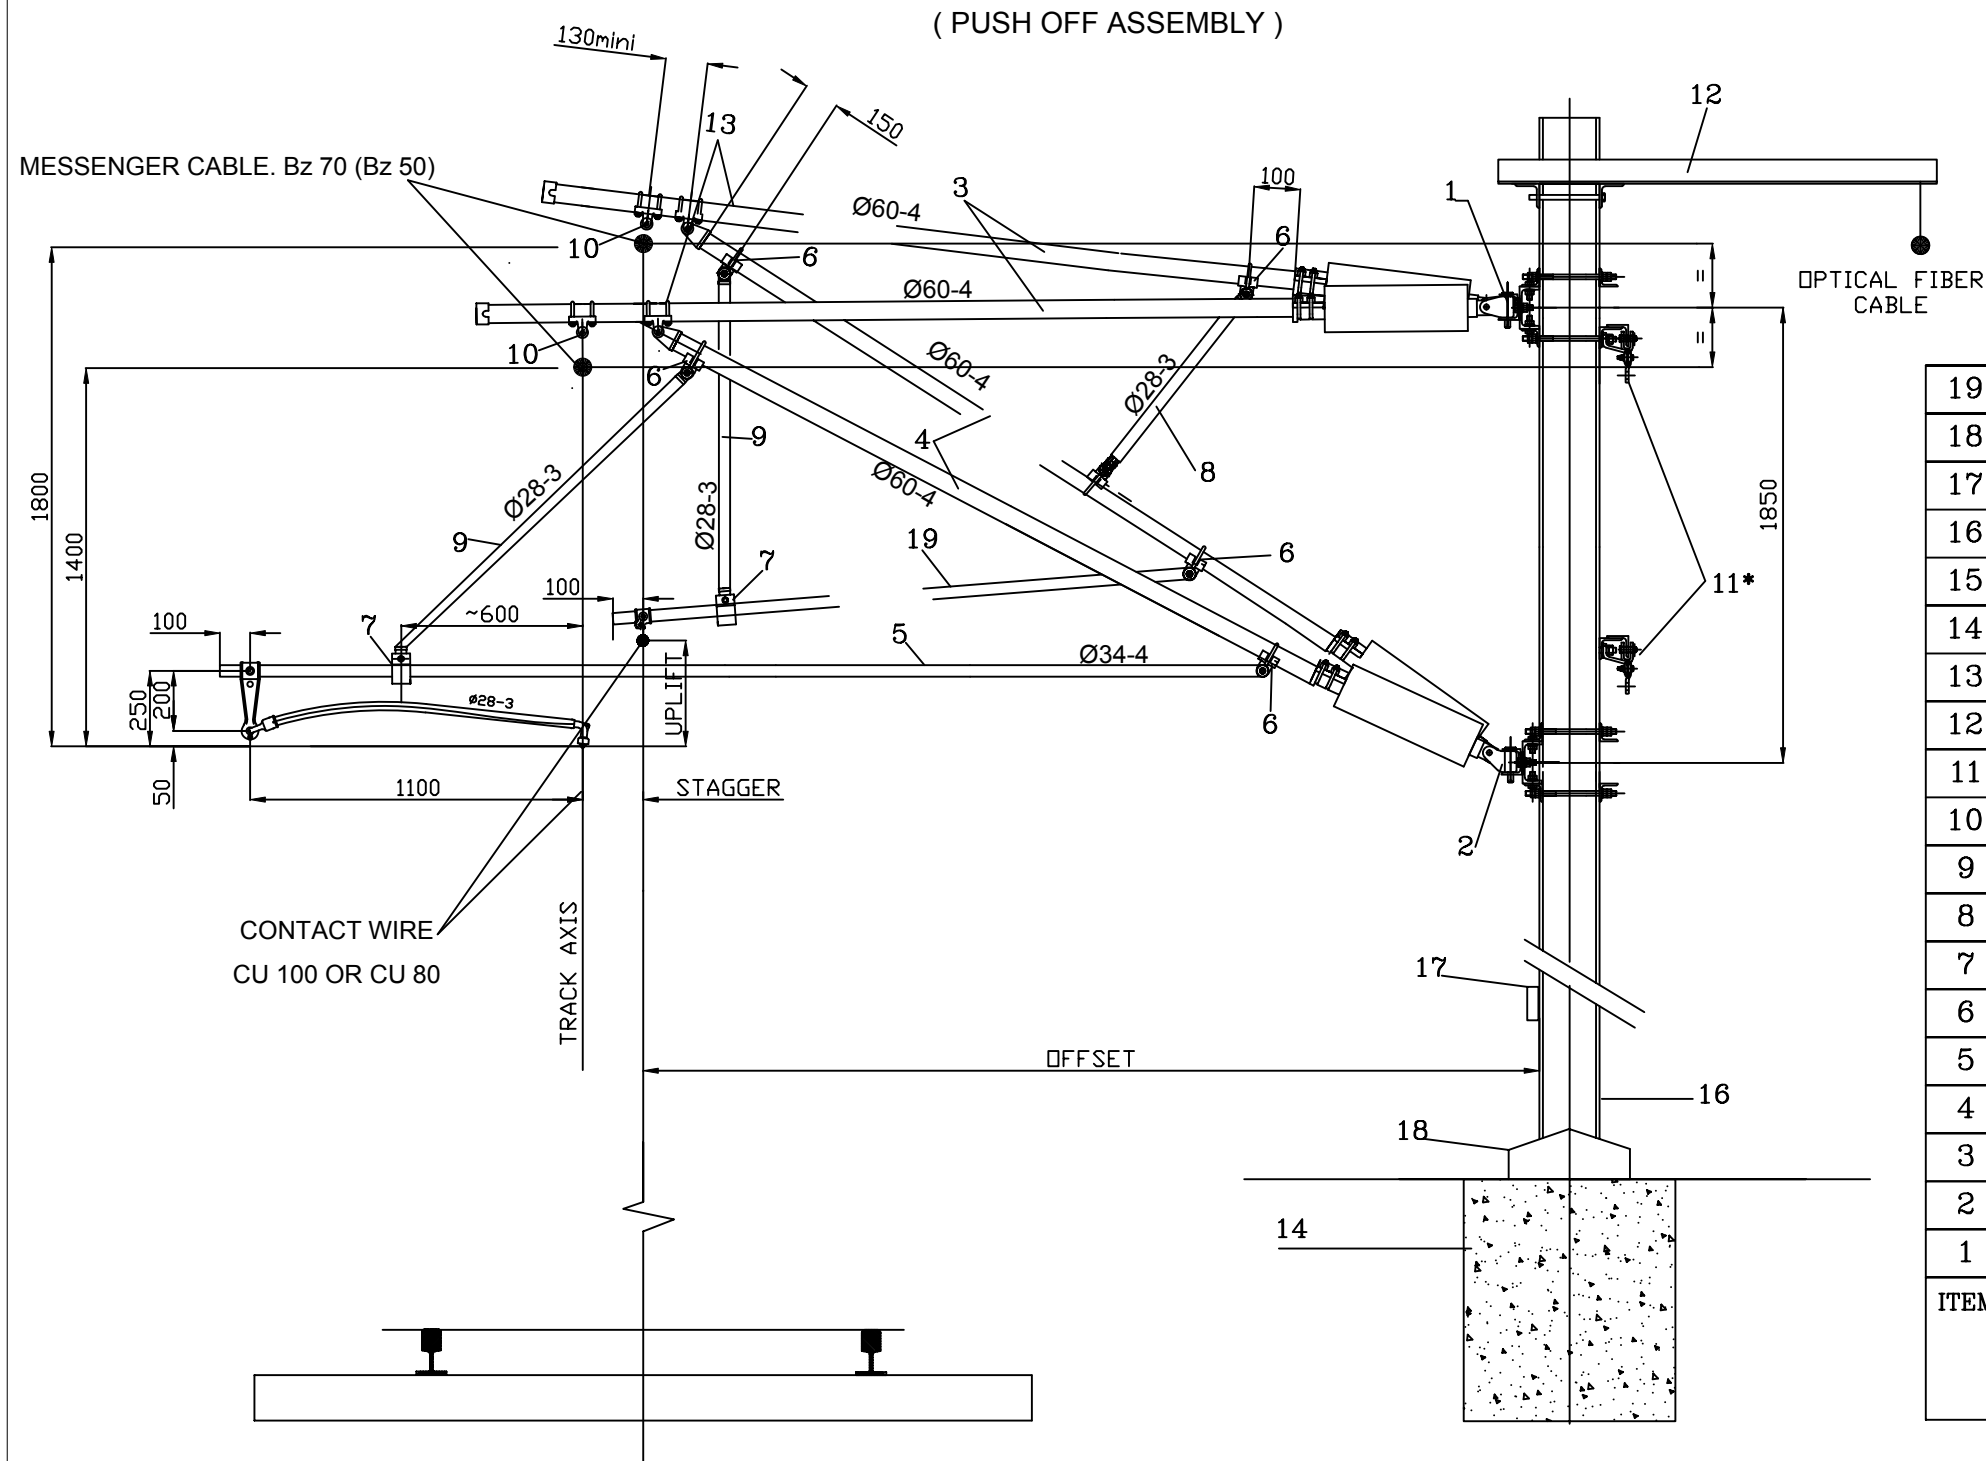


19	REGISTRATION ARM FOR UPLIFT C.W.	ELC 32-13.D.A	
18	DICE PROTECTION	01LC00BDG008	
17	ASSEMBLY OF SAFETY DEVICES		
16	MAST TYPES AND REFERENCES	01LC00BDG010	
15	-	-	
14	POLE FOUNDATION	01LC00BDG006	
13	FASTENING FOR TOP TUBE	01LC00BDG069	
12	OPTICAL FIBER BRACKET	01LC00BDG054	
11	EARTHING SUSPENSION	or 01LC00BDG0136 01LC00BDG072	
10	SUSPENSION FOR 1 OR 2 MESSENGER	01LC00BDG070	
9	AUXILIARY STRUT TUBE	01LC00BDG083	
8	AUXILIARY STRUT TUBE	01LC00BDG083	
7	FASTENING ON TUBE $\phi 34$	ELC 26-4.7.0	
6	FASTENING ON TUBE $\phi 60$	ELC 13-1.2.3.0	
5	$\phi 34-4$ REGISTRATION ARM WITH 1.1m STEADY ARM FOR CURVE	01LC00BDG151	202
4	INSULATED FOR STRUT TUBE $\phi 60$	01LC00BDG066	
3	INSULATED FOR TOP TUBE $\phi 60$	01LC00BDG064	
2	FASTENING FOR STRUT TUBE	or 01LC00BDG060 01LC00BDG078	
1	FASTENING FOR TOP TUBE	or 01LC00BDG061 01LC00BDG136	
ITEM	DESIGNATION	REFERENCE DRAWING	MARK

NOTE:

* EXACTE POSITION (HEIGHT,FIELD OR TRACK SIDE) WILL BE DEFINED DURING DETAIL DESIGN STAGE

ECHIPARE TIP CATENARA (CU DISTANTA INTRE CONSOLE DE 1m) TYPICAL CATENARY EQUIPMENT (WITH EQUIPMENTS SPACING 1m)	Numele fisierului/ CAD file name:	Scara/ Scale:	Part	Rev.
	01LC00BDG037		4 / 4	0

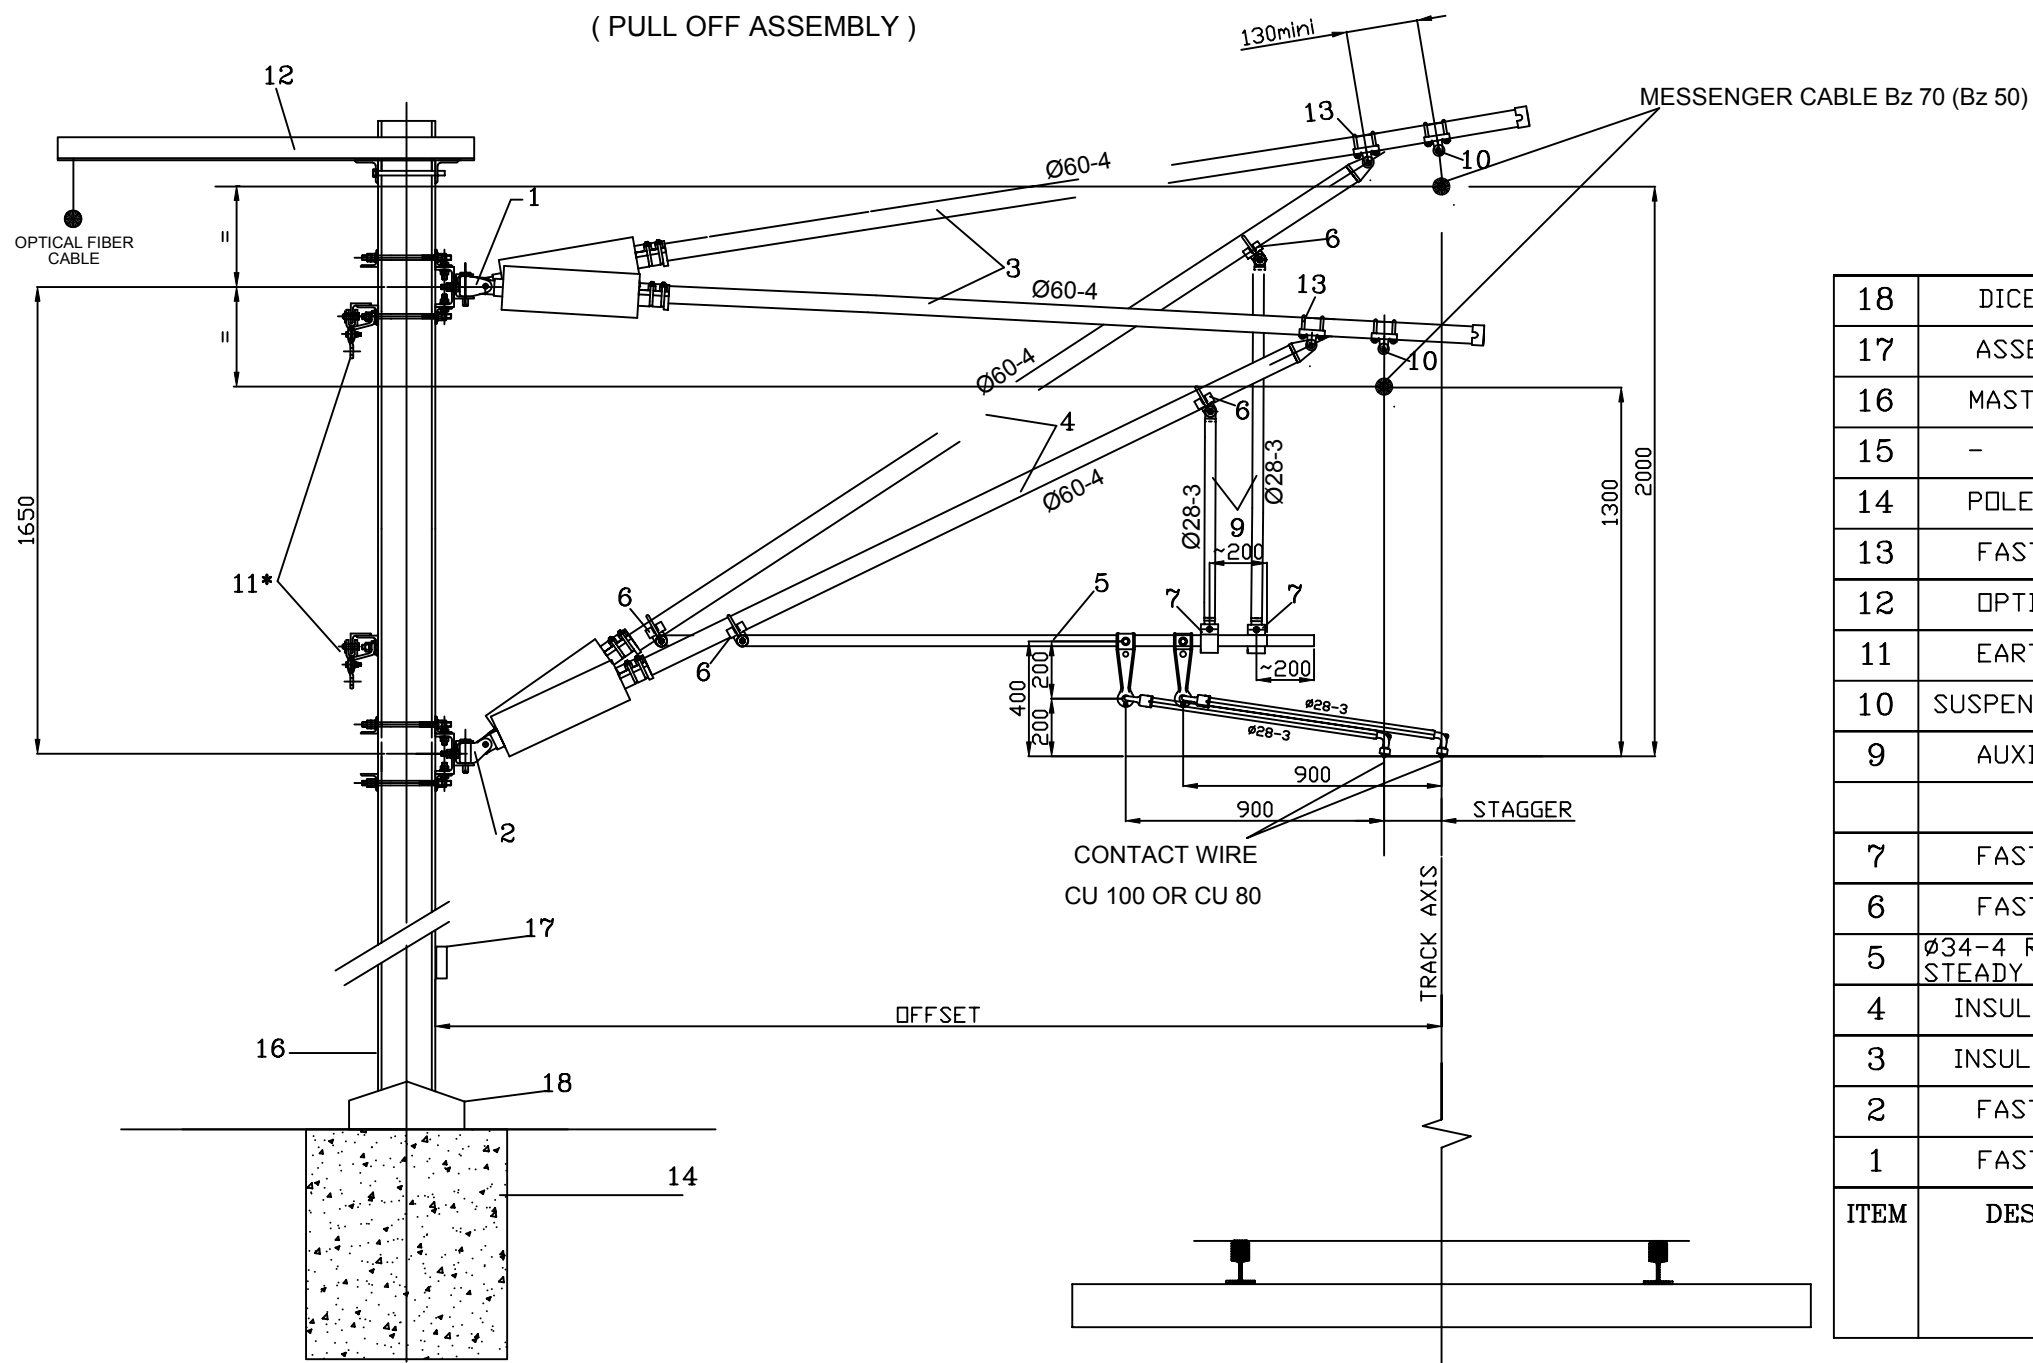


18	DICE PROTECTION	01LC00BDG008	
17	ASSEMBLY OF SAFETY DEVICES		
16	MAST TYPES AND REFERENCES	01LC00BDG010	
15	-	-	
14	POLE FOUNDATION	01LC00BDG006	
13	FASTENING FOR TOP TUBE	01LC00BDG069	
12	OPTICAL FIBER BRACKET	01LC00BDG054	
11	EARTHING SUSPENSION	or 01LC00BDG081 01LC00BDG072	
10	SUSPENSION FOR 1 OR 2 MESSENGER	01LC00BDG070	
9	AUXILIARY STRUT TUBE	01LC00BDG083	
7	FASTENING ON TUBE $\phi 34$	ELC 26-4.7.0	
6	FASTENING ON TUBE $\phi 60$	ELC 13-1.2.3.0	
5	$\phi 34-4$ REGISTRATION ARM WITH 0.9m STEADY ARM FOR STRAIGHT LINE	01LC00BDG150	201
4	INSULATED FOR STRUT TUBE $\phi 60$	01LC00BDG066	
3	INSULATED FOR TOP TUBE $\phi 60$	01LC00BDG064	
2	FASTENING FOR STRUT TUBE	or 01LC00BDG080 01LC00BDG081	
1	FASTENING FOR TOP TUBE	or 01LC00BDG079 01LC00BDG136	
ITEM	DESIGNATION	REFERENCE DRAWING	MARK

NOTE:

* EXACTE POSITION (HEIGHT, FIELD OR TRACK SIDE) WILL BE DEFINED DURING DETAIL DESIGN STAGE

ECHIPARE TIP A CATENAREI PENTRU ZONA DE IZOLATIE MECANICA (DISTANTA INTRE CONSOLE DE 1.60 m)
TYPICAL CATENARY EQUIPMENT FOR UNINSULATED OVERLAP AXIS (WITH EQUIPMENTS SPACING 1.60m)

Numele fisierului/ CAD file name:	Scara/ Scale:	Part	Rev.
01LC00BDG038		1 / 4	0

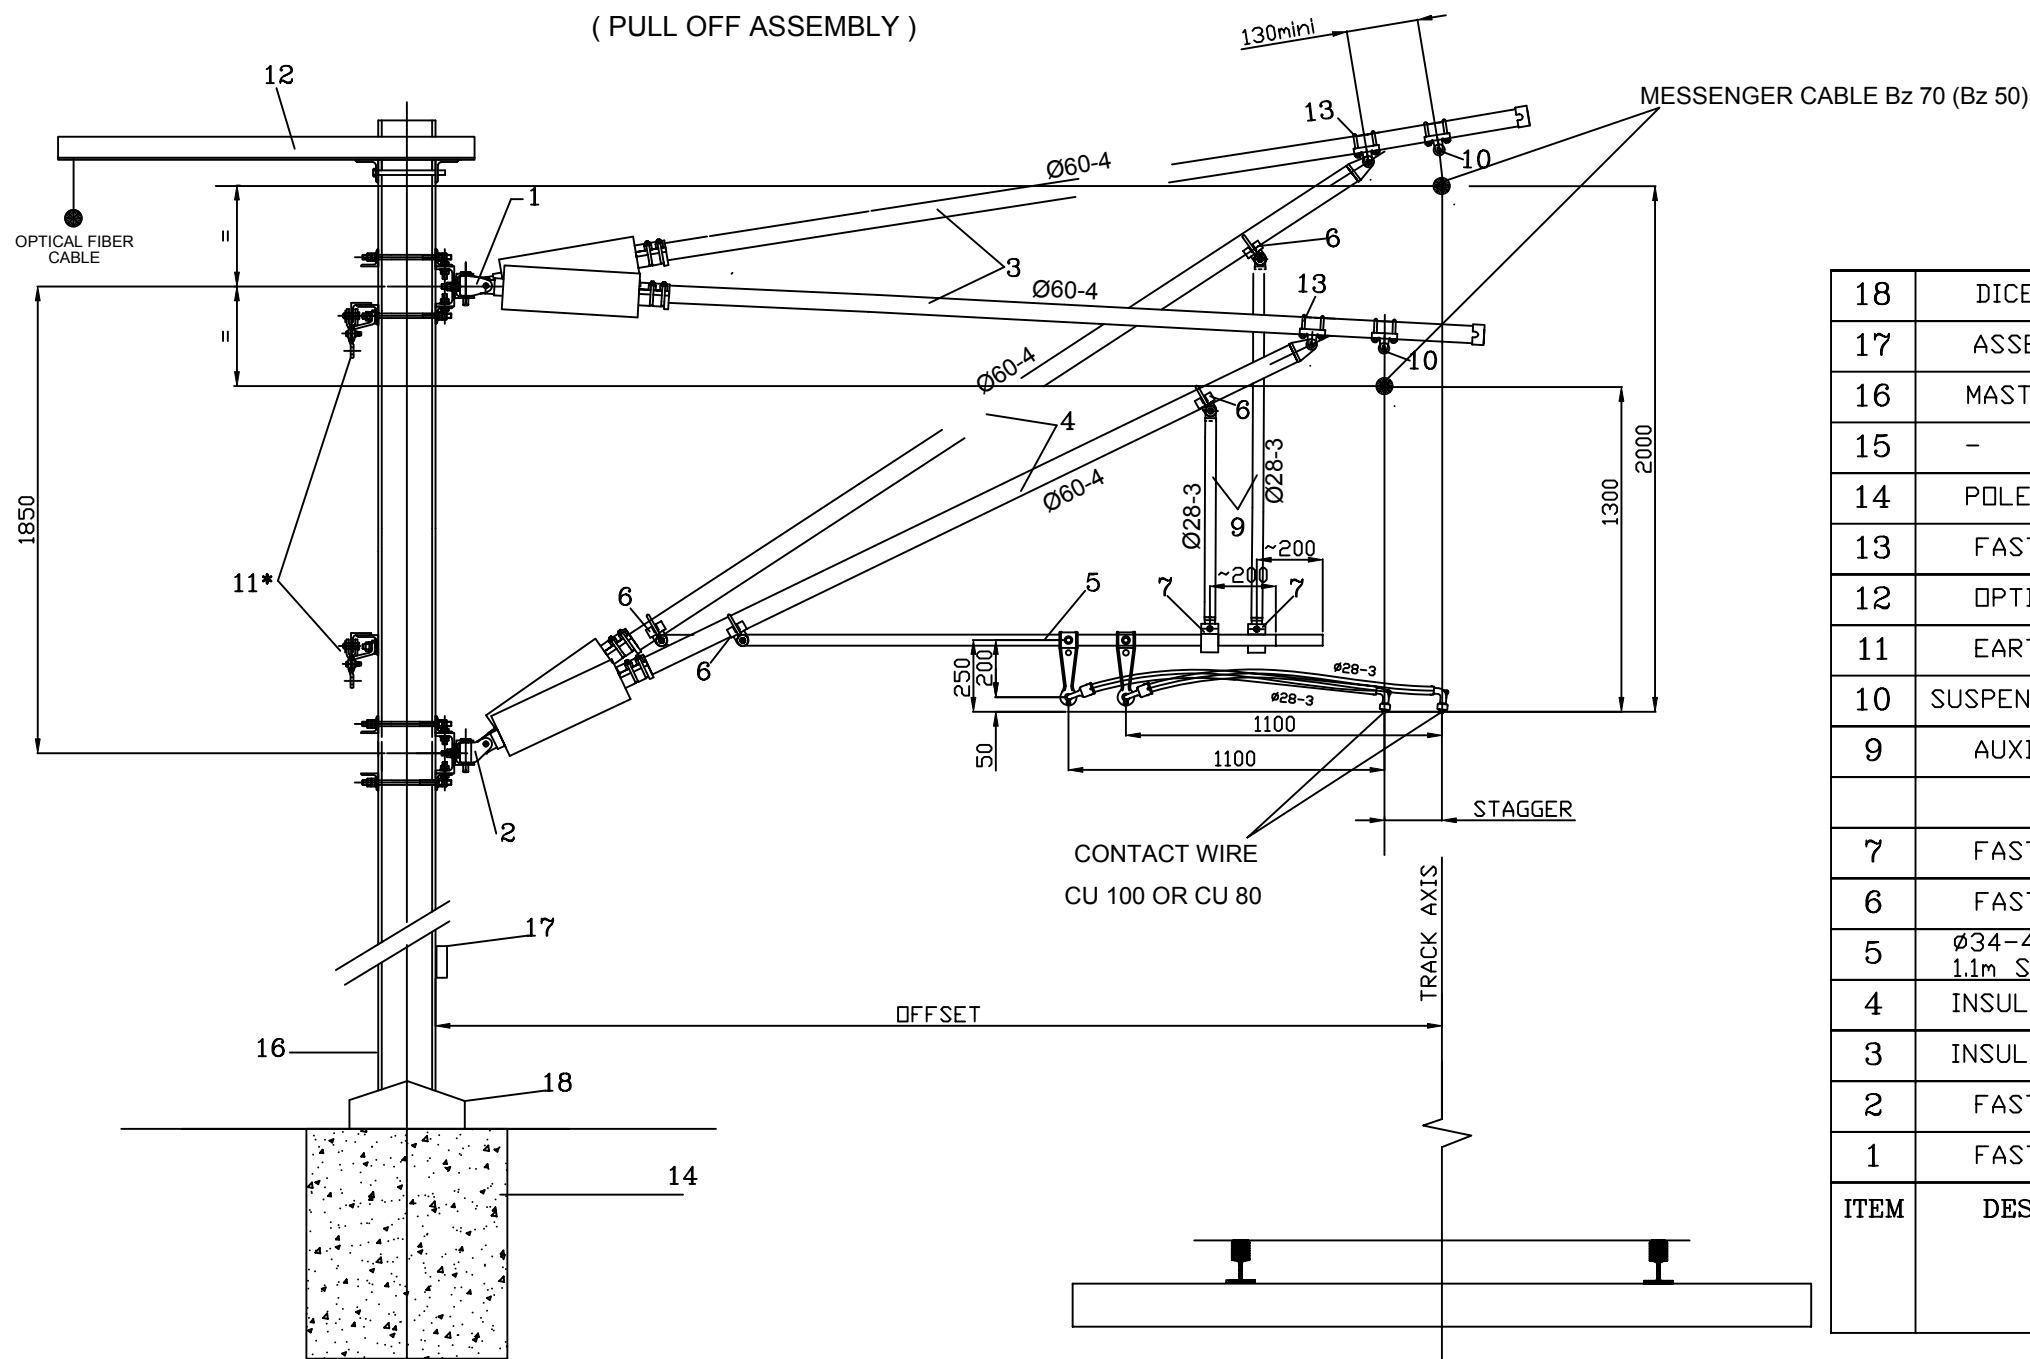


18	DICE PROTECTION	01LC00BDG008	
17	ASSEMBLY OF SAFETY DEVICES		
16	MAST TYPES AND REFERENCES	01LC00BDG010	
15	-	-	
14	POLE FOUNDATION	01LC00BDG006	
13	FASTENING FOR TOP TUBE	01LC00BDG069	
12	OPTICAL FIBER BRACKET	01LC00BDG054	
11	EARTHING SUSPENSION	or 01LC00BDG081 01LC00BDG072	
10	SUSPENSION FOR 1 OR 2 MESSENGER	01LC00BDG070	
9	AUXILIARY STRUT TUBE	01LC00BDG083	
7	FASTENING ON TUBE Ø34	ELC 26-4.7.0	
6	FASTENING ON TUBE Ø60	ELC 13-1.2.3.0	
5	Ø34-4 REGISTRATION ARM WITH 1.1m STEADY ARM FOR CURVE	01LC00BDG151	201
4	INSULATED FOR STRUT TUBE Ø60	01LC00BDG066	
3	INSULATED FOR TOP TUBE Ø60	01LC00BDG064	
2	FASTENING FOR STRUT TUBE	or 01LC00BDG080 01LC00BDG081	
1	FASTENING FOR TOP TUBE	or 01LC00BDG079 01LC00BDG136	
ITEM	DESIGNATION	REFERENCE DRAWING	MARK

NOTE:

* EXACTE POSITION (HEIGHT, FIELD OR TRACK SIDE) WILL BE DEFINED DURING DETAIL DESIGN STAGE

ECHIPARE TIP A CATENAREI PENTRU ZONA DE IZOLATIE MECANICA (DISTANTA INTRE CONSOLE DE 1.60 m) TYPICAL CATENARY EQUIPMENT FOR UNINSULATED OVERLAP AXIS (WITH EQUIPMENTS SPACING 1.60m)	Numele fisierului/ CAD file name:	Scara/ Scale:	Part	Rev.
	01LC00BDG038		2 / 4	0

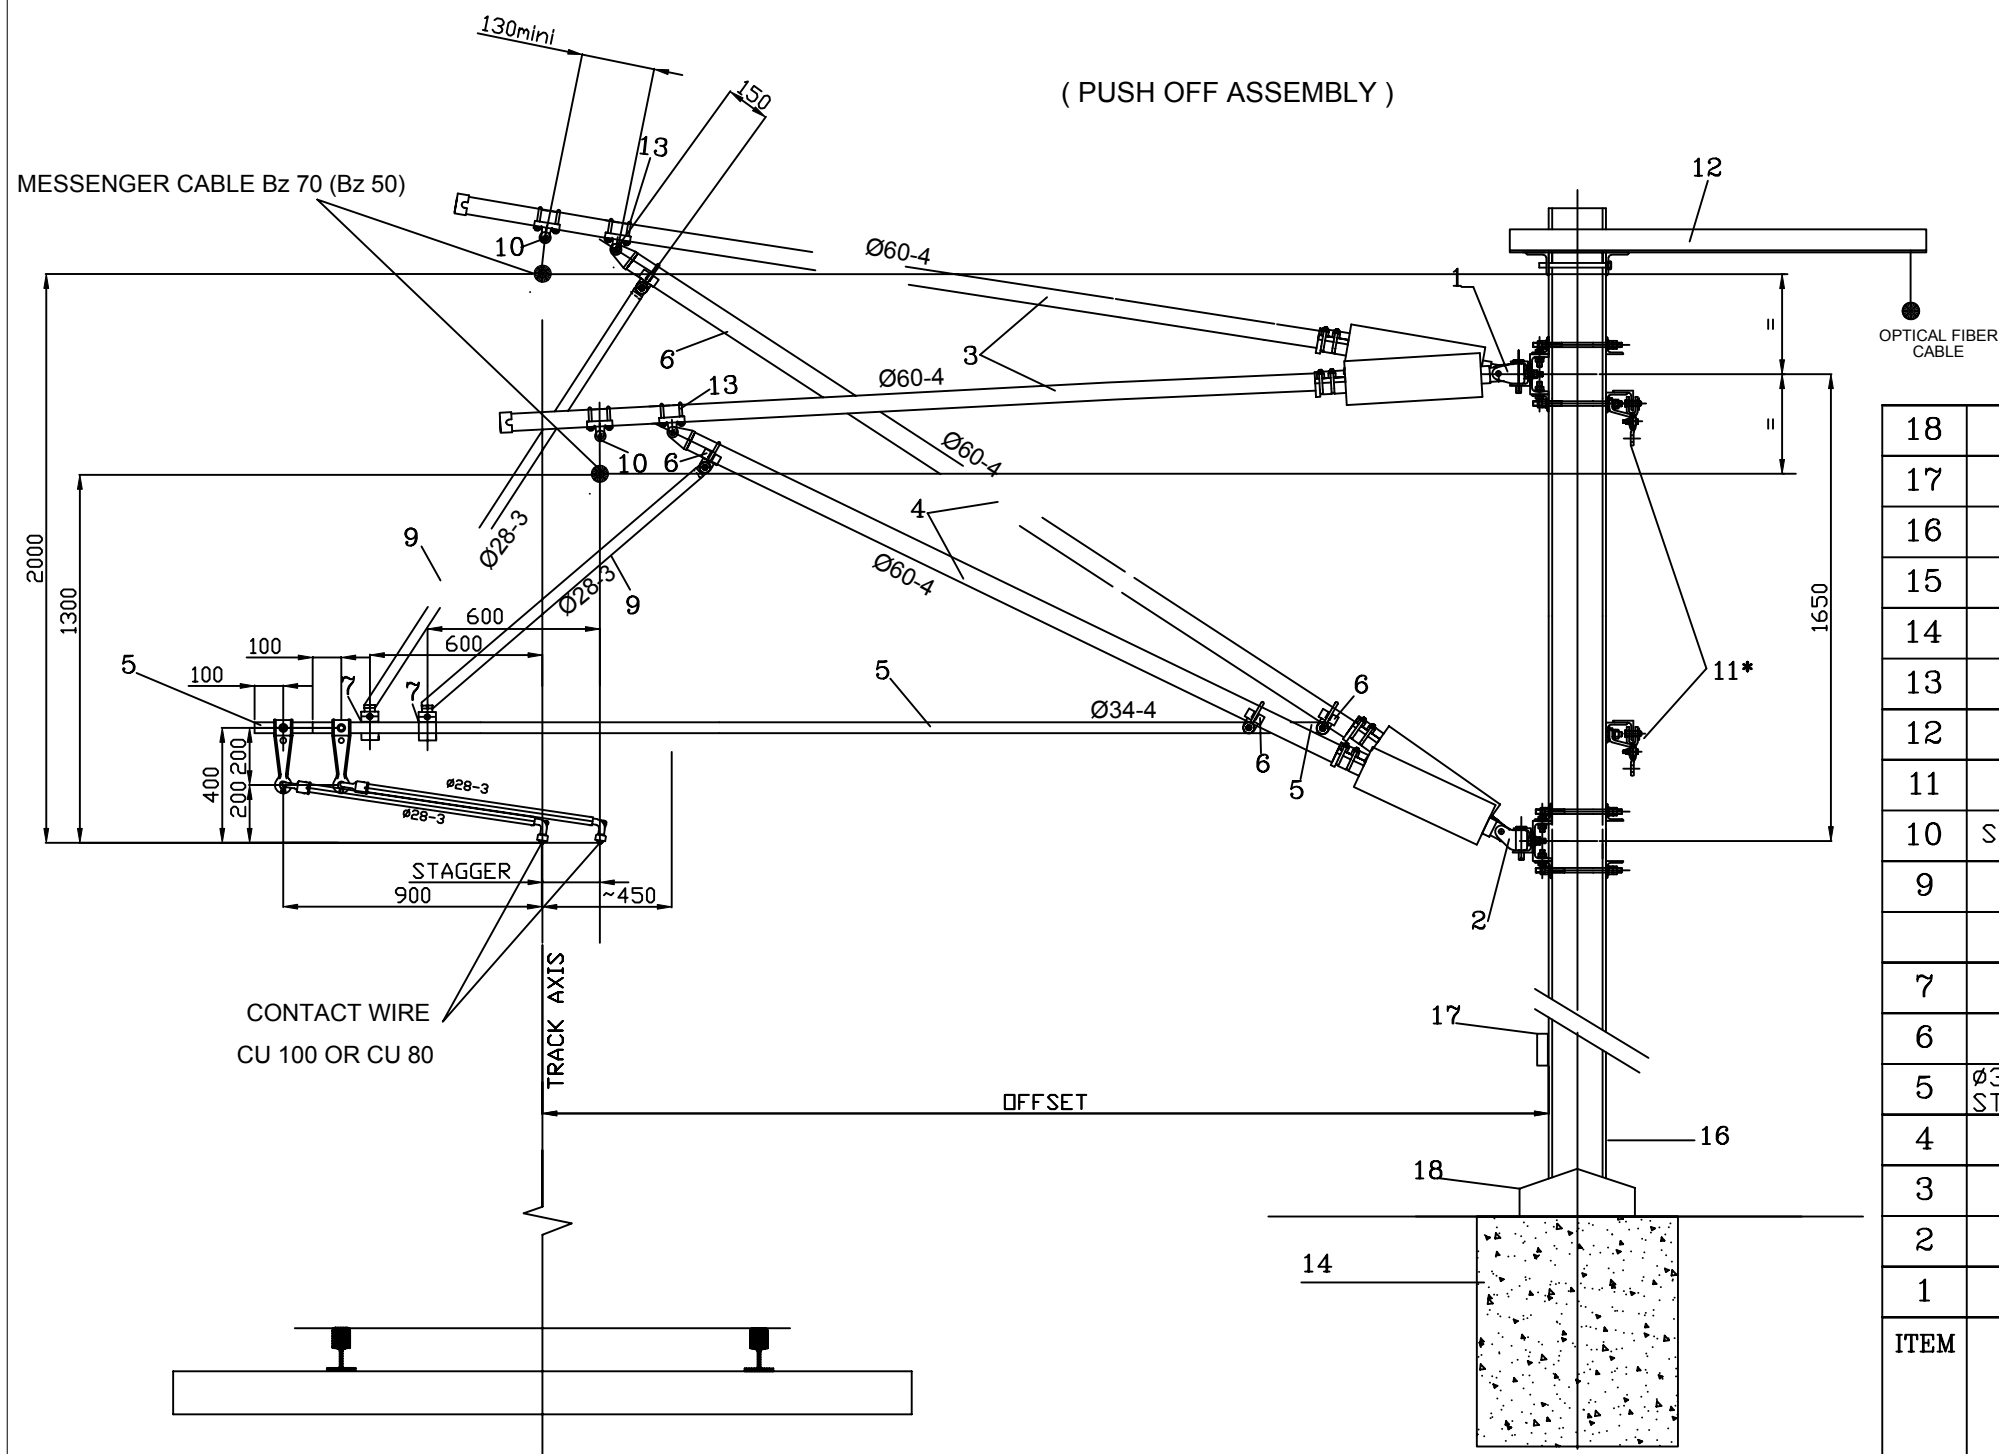


18	DICE PROTECTION	01LC00BDG008	
17	ASSEMBLY OF SAFETY DEVICES		
16	MAST TYPES AND REFERENCES	01LC00BDG010	
15	-	-	
14	POLE FOUNDATION	01LC00BDG006	
13	FASTENING FOR TOP TUBE	01LC00BDG069	
12	OPTICAL FIBER BRACKET	01LC00BDG054	
11	EARTHING SUSPENSION	or 01LC00BDG081 01LC00BDG072	
10	SUSPENSION FOR 1 OR 2 MESSENGER	01LC00BDG070	
9	AUXILIARY STRUT TUBE	01LC00BDG083	
7	FASTENING ON TUBE Ø34	ELC 26-4.7.0	
6	FASTENING ON TUBE Ø60	ELC 13-1.2.3.0	
5	Ø34-4 REGISTRATION ARM WITH 0.9m STEADY ARM FOR STRAIGHT LINE	01LC00BDG150	202
4	INSULATED FOR STRUT TUBE Ø60	01LC00BDG066	
3	INSULATED FOR TOP TUBE Ø60	01LC00BDG064	
2	FASTENING FOR STRUT TUBE	or 01LC00BDG080 01LC00BDG081	
1	FASTENING FOR TOP TUBE	or 01LC00BDG079 01LC00BDG136	
ITEM	DESIGNATION	REFERENCE DRAWING	MARK

NOTE:

- * EXACTE POSITION (HEIGHT, FIELD OR TRACK SIDE) WILL BE DEFINED DURING DETAIL DESIGN STAGE

ECHIPARE TIP A CATENAREI PENTRU ZONA DE IZOLATIE MECANICA (DISTANTA INTRE CONSOLE DE 1.60 m) TYPICAL CATENARY EQUIPMENT FOR UNINSULATED OVERLAP AXIS (WITH EQUIPMENTS SPACING 1.60m)	Numele fisierului/ CAD file name:	Scala/ Scale:	Part	Rev.
	01LC00BDG038		3 / 4	0

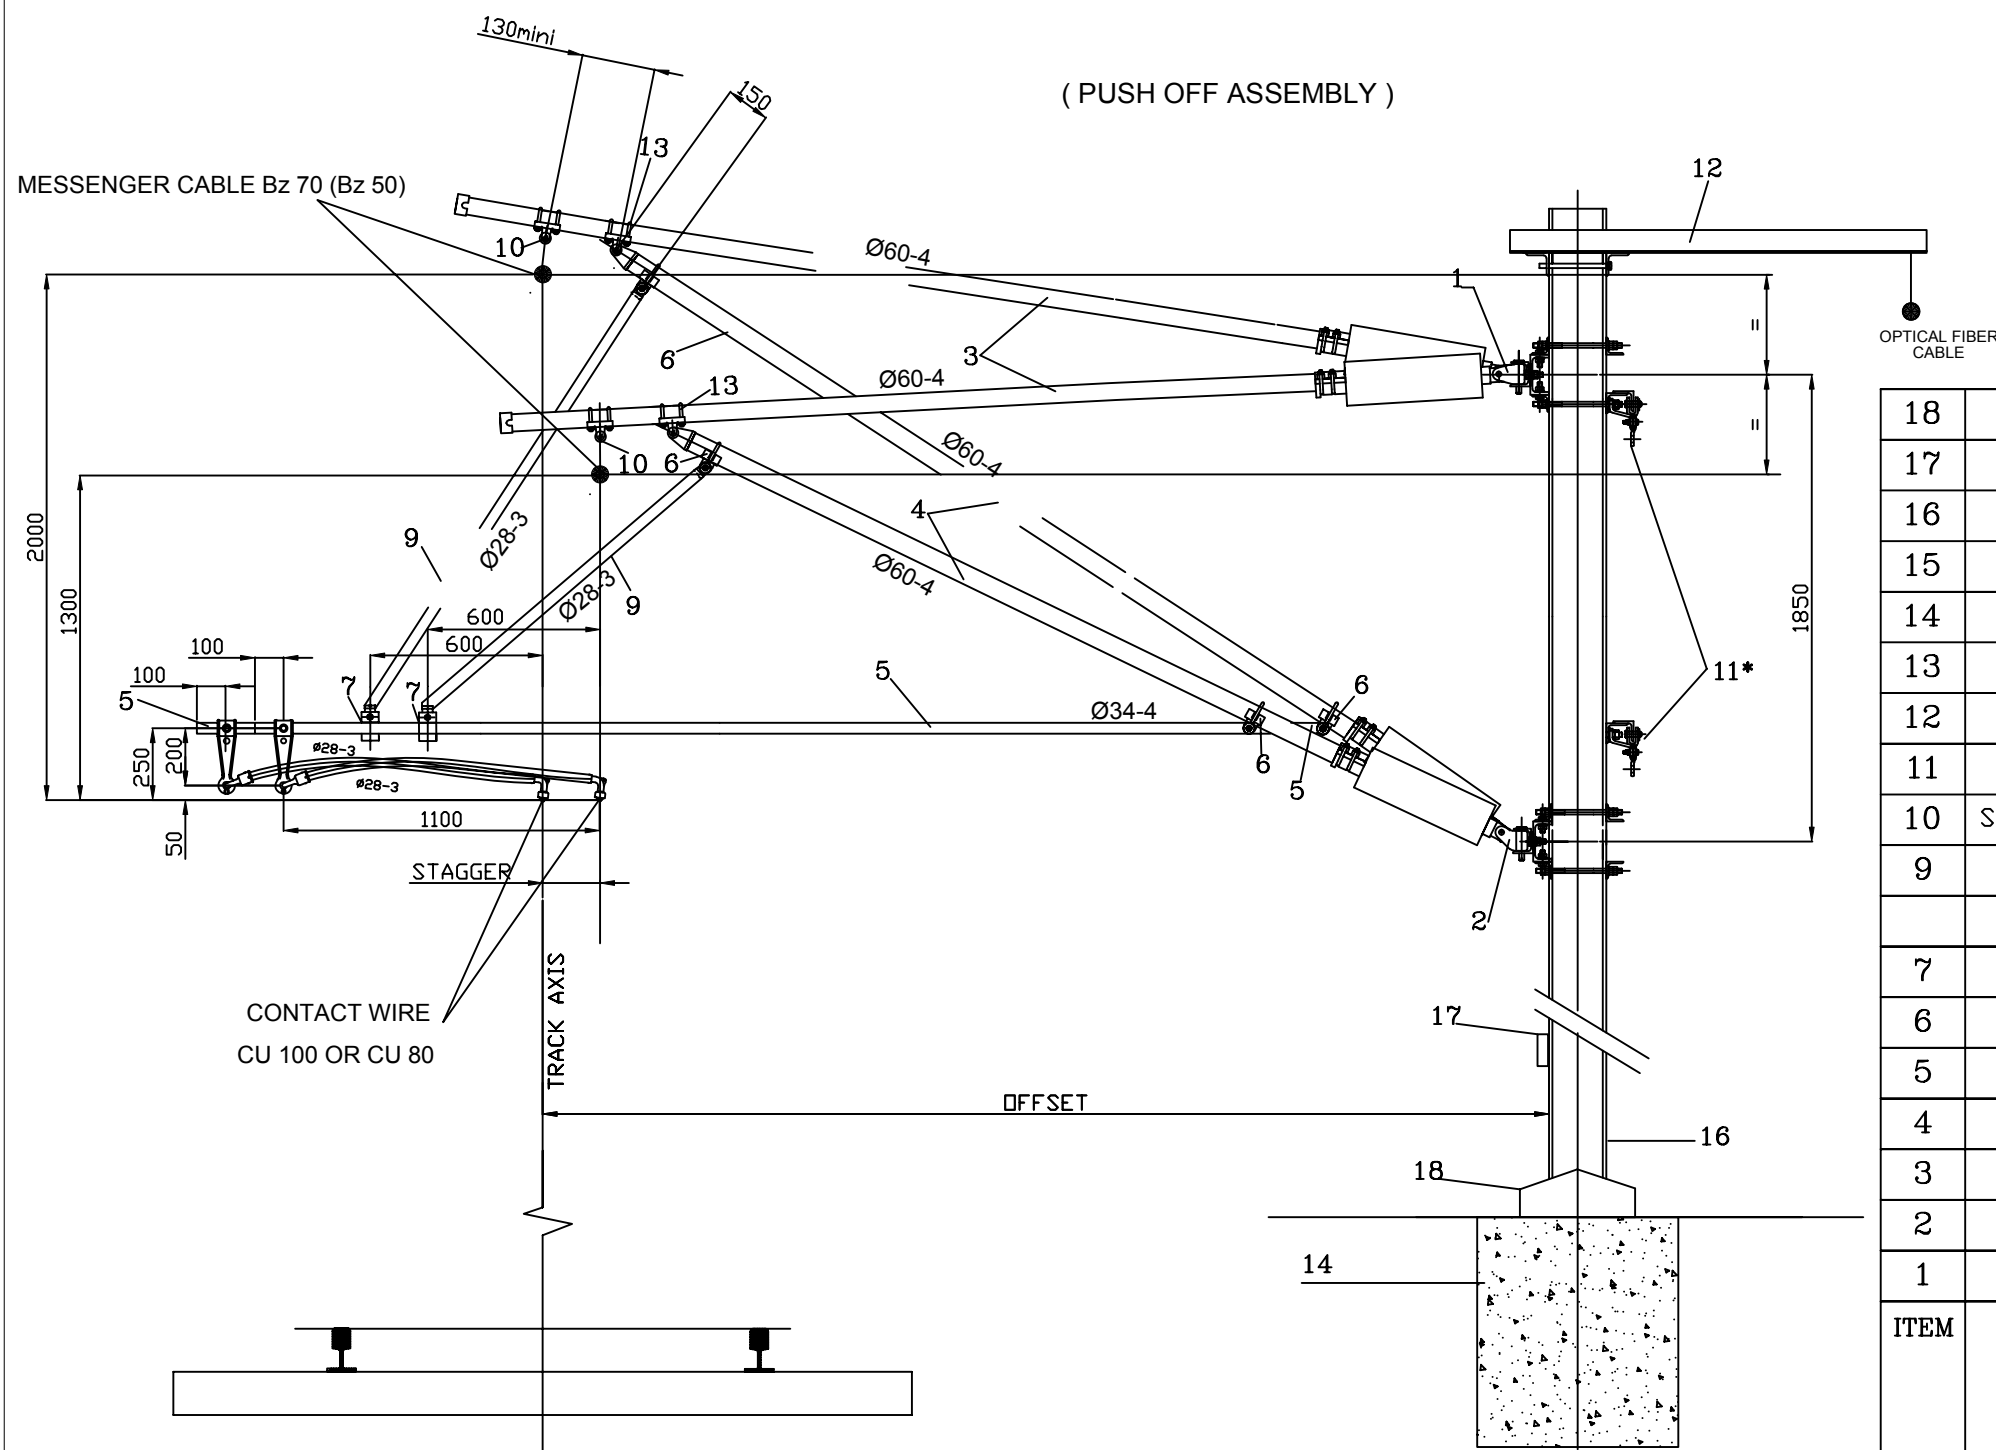


18	DICE PROTECTION	01LC00BDG008	
17	ASSEMBLY OF SAFETY DEVICES		
16	MAST TYPES AND REFERENCES	01LC00BDG010	
15	-	-	
14	POLE FOUNDATION	01LC00BDG006	
13	FASTENING FOR TOP TUBE	01LC00BDG069	
12	OPTICAL FIBER BRACKET	01LC00BDG054	
11	EARTHING SUSPENSION	or 01LC00BDG081 01LC00BDG072	
10	SUSPENSION FOR 1 OR 2 MESSENGER	01LC00BDG070	
9	AUXILIARY STRUT TUBE	01LC00BDG083	
7	FASTENING ON TUBE Ø34	ELC 26-4.7.0	
6	FASTENING ON TUBE Ø60	ELC 13-1.2.3.0	
5	Ø34-4 REGISTRATION ARM WITH 1.1m STEADY ARM FOR CURVE	01LC00BDG151	202
4	INSULATED FOR STRUT TUBE Ø60	01LC00BDG066	
3	INSULATED FOR TOP TUBE Ø60	01LC00BDG064	
2	FASTENING FOR STRUT TUBE	or 01LC00BDG080 01LC00BDG081	
1	FASTENING FOR TOP TUBE	or 01LC00BDG079 01LC00BDG136	
ITEM	DESIGNATION	REFERENCE DRAWING	MARK

NOTE:

* EXACTE POSITION (HEIGHT, FIELD OR TRACK SIDE) WILL BE DEFINED DURING DETAIL DESIGN STAGE

ECHIPARE TIP A CATENAREI PENTRU ZONA DE IZOLATIE MECANICA (DISTANTA INTRE CONSOLE DE 1.60 m) TYPICAL CATENARY EQUIPMENT FOR UNINSULATED OVERLAP AXIS (WITH EQUIPMENTS SPACING 1.60m)	Numele fisierului/ CAD file name:	Scara/ Scale:	Part	Rev.
	01LC00BDG038		4 / 4	0

(PULL OFF ASSEMBLY)

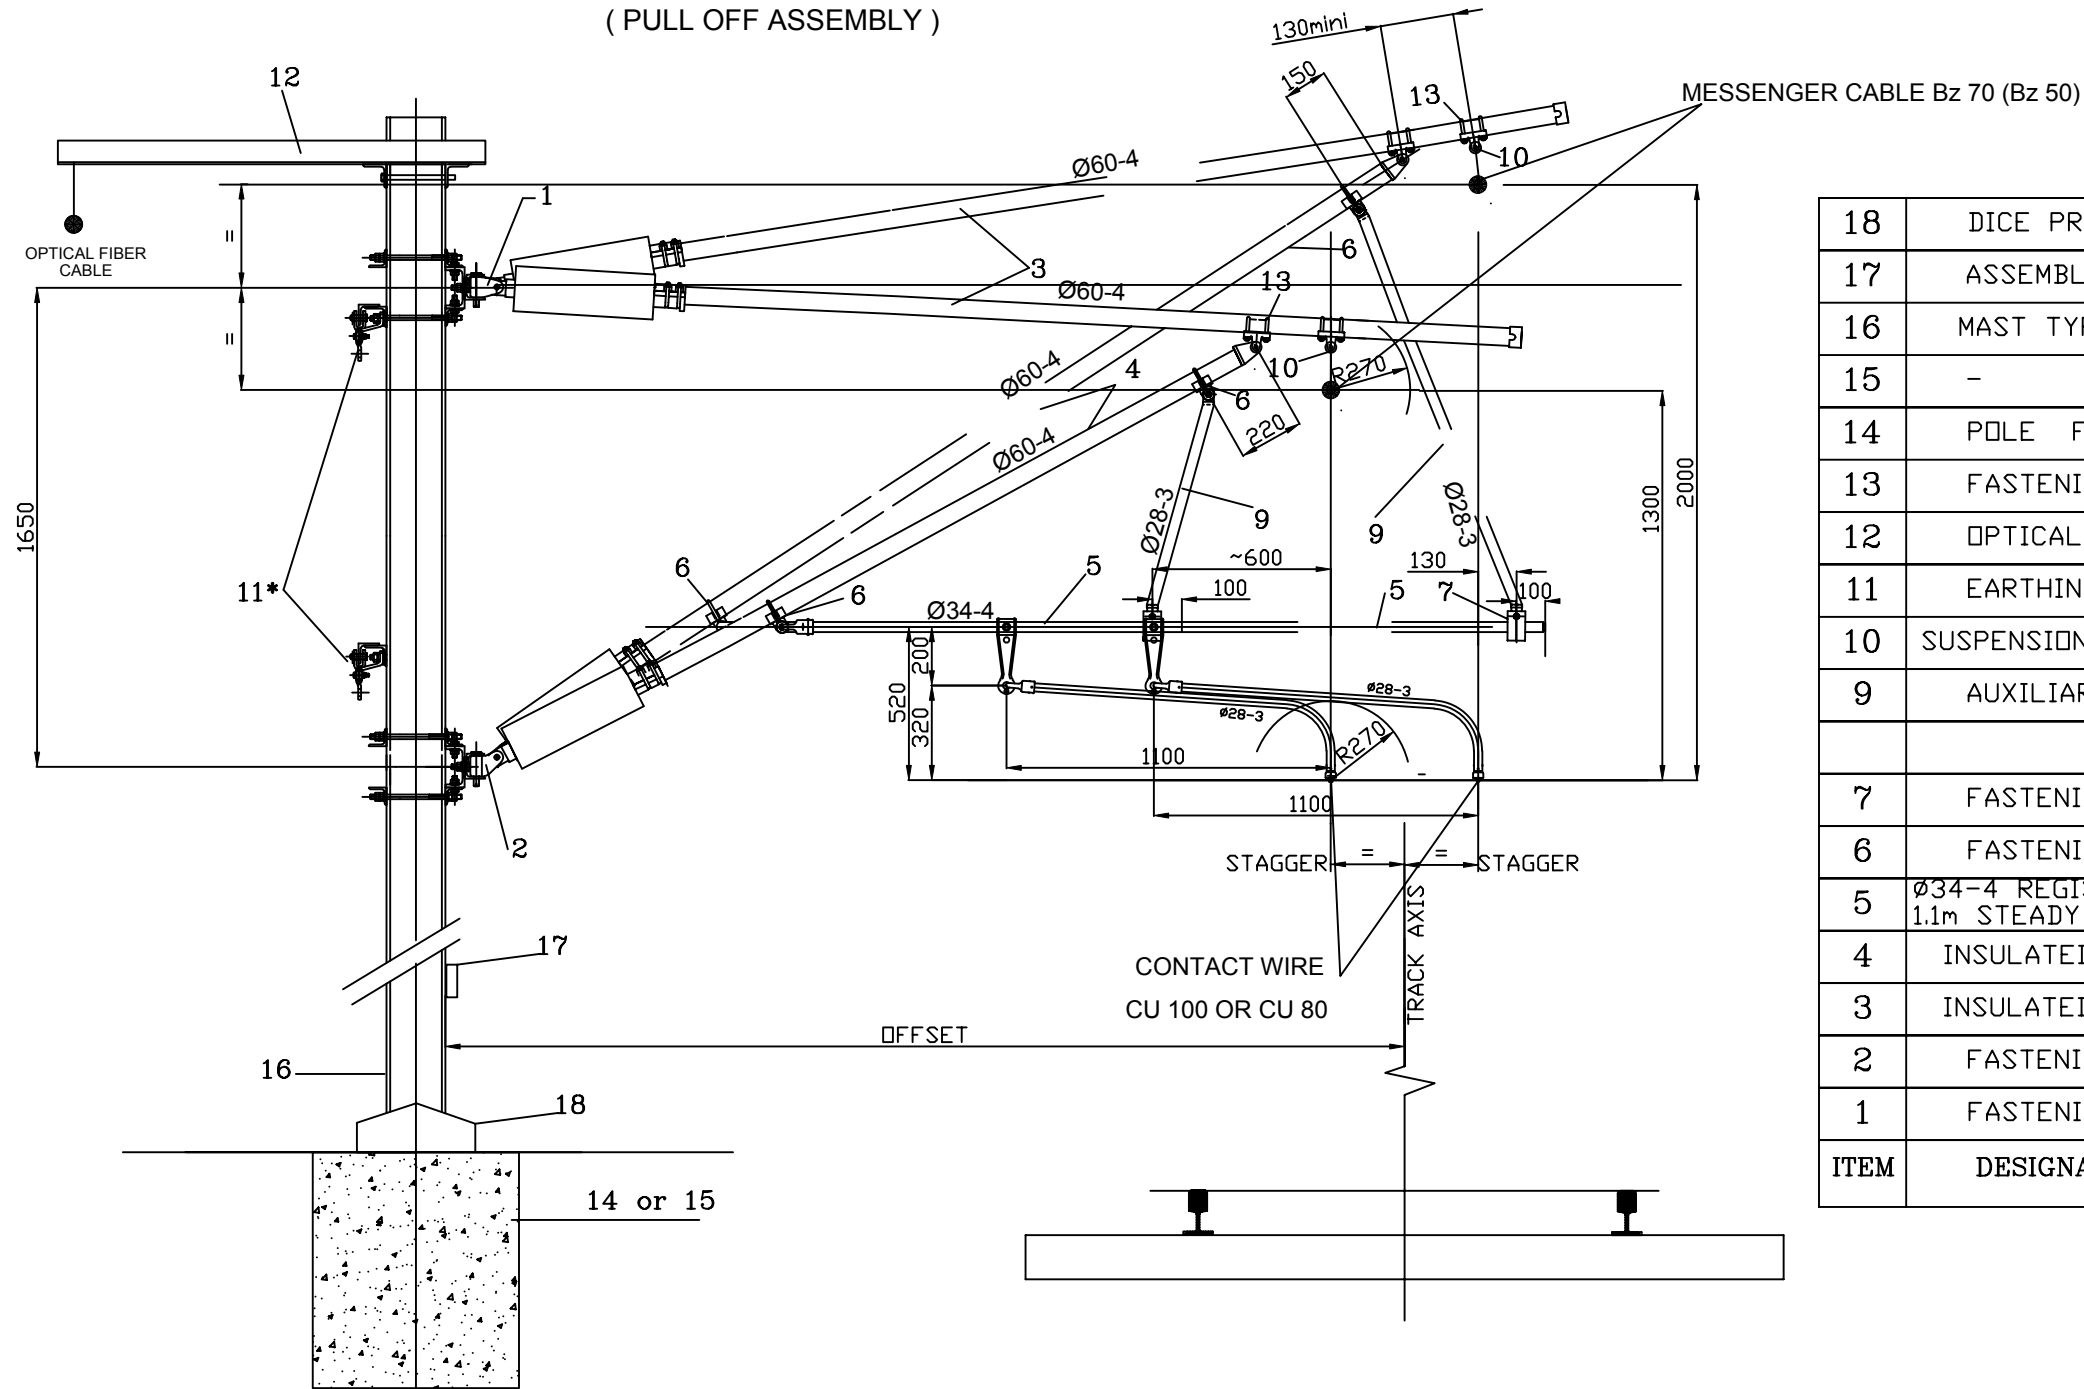


18	DICE PROTECTION	01LC00BDG008	
17	ASSEMBLY OF SAFETY DEVICES		
16	MAST TYPES AND REFERENCES	01LC00BDG010	
15	-	-	
14	POLE FOUNDATION	01LC00BDG006	
13	FASTENING FOR TOP TUBE	01LC00BDG069	
12	OPTICAL FIBER BRACKET	01LC00BDG054	
11	EARTHING SUSPENSION	or 01LC00BDG081 01LC00BDG072	
10	SUSPENSION FOR 1 OR 2 MESSENGER	01LC00BDG070	
9	AUXILIARY STRUT TUBE	01LC00BDG083	
7	FASTENING ON TUBE $\phi 34$	ELC 26-4.7.0	
6	FASTENING ON TUBE $\phi 60$	ELC 13-1.2.3.0	
5	$\phi 34-4$ REGISTRATION ARM WITH 1.1m STEADY ARM FOR INS. OVERLAP	01LC00BDG152	201
4	INSULATED FOR STRUT TUBE $\phi 60$	01LC00BDG066	
3	INSULATED FOR TOP TUBE $\phi 60$	01LC00BDG04	
2	FASTENING FOR STRUT TUBE	or 01LC00BDG080 01LC00BDG081	
1	FASTENING FOR TOP TUBE	or 01LC00BDG079 01LC00BDG136	
ITEM	DESIGNATION	REFERENCE DRAWING	MARK

NOTE:

* EXACTE POSITION (HEIGHT, FIELD OR TRACK SIDE) WILL BE DEFINED DURING DETAIL DESIGN STAGE

ECHIPARE TIP A CATENAREI PENTRU STALPII MEDIANI AI ZONEI IZOLATE (DISTANTA INTRE CONSOLE DE 1.60 m)
TYPICAL CATENARY EQUIPMENT FOR INSULATED OVERLAP AXIS (WITH EQUIPMENTS SPACING 1.60m)

Numele fisierului/ CAD file name:	Scara/ Scale:	Part	Rev.
01LC00BDG039		1 / 2	0

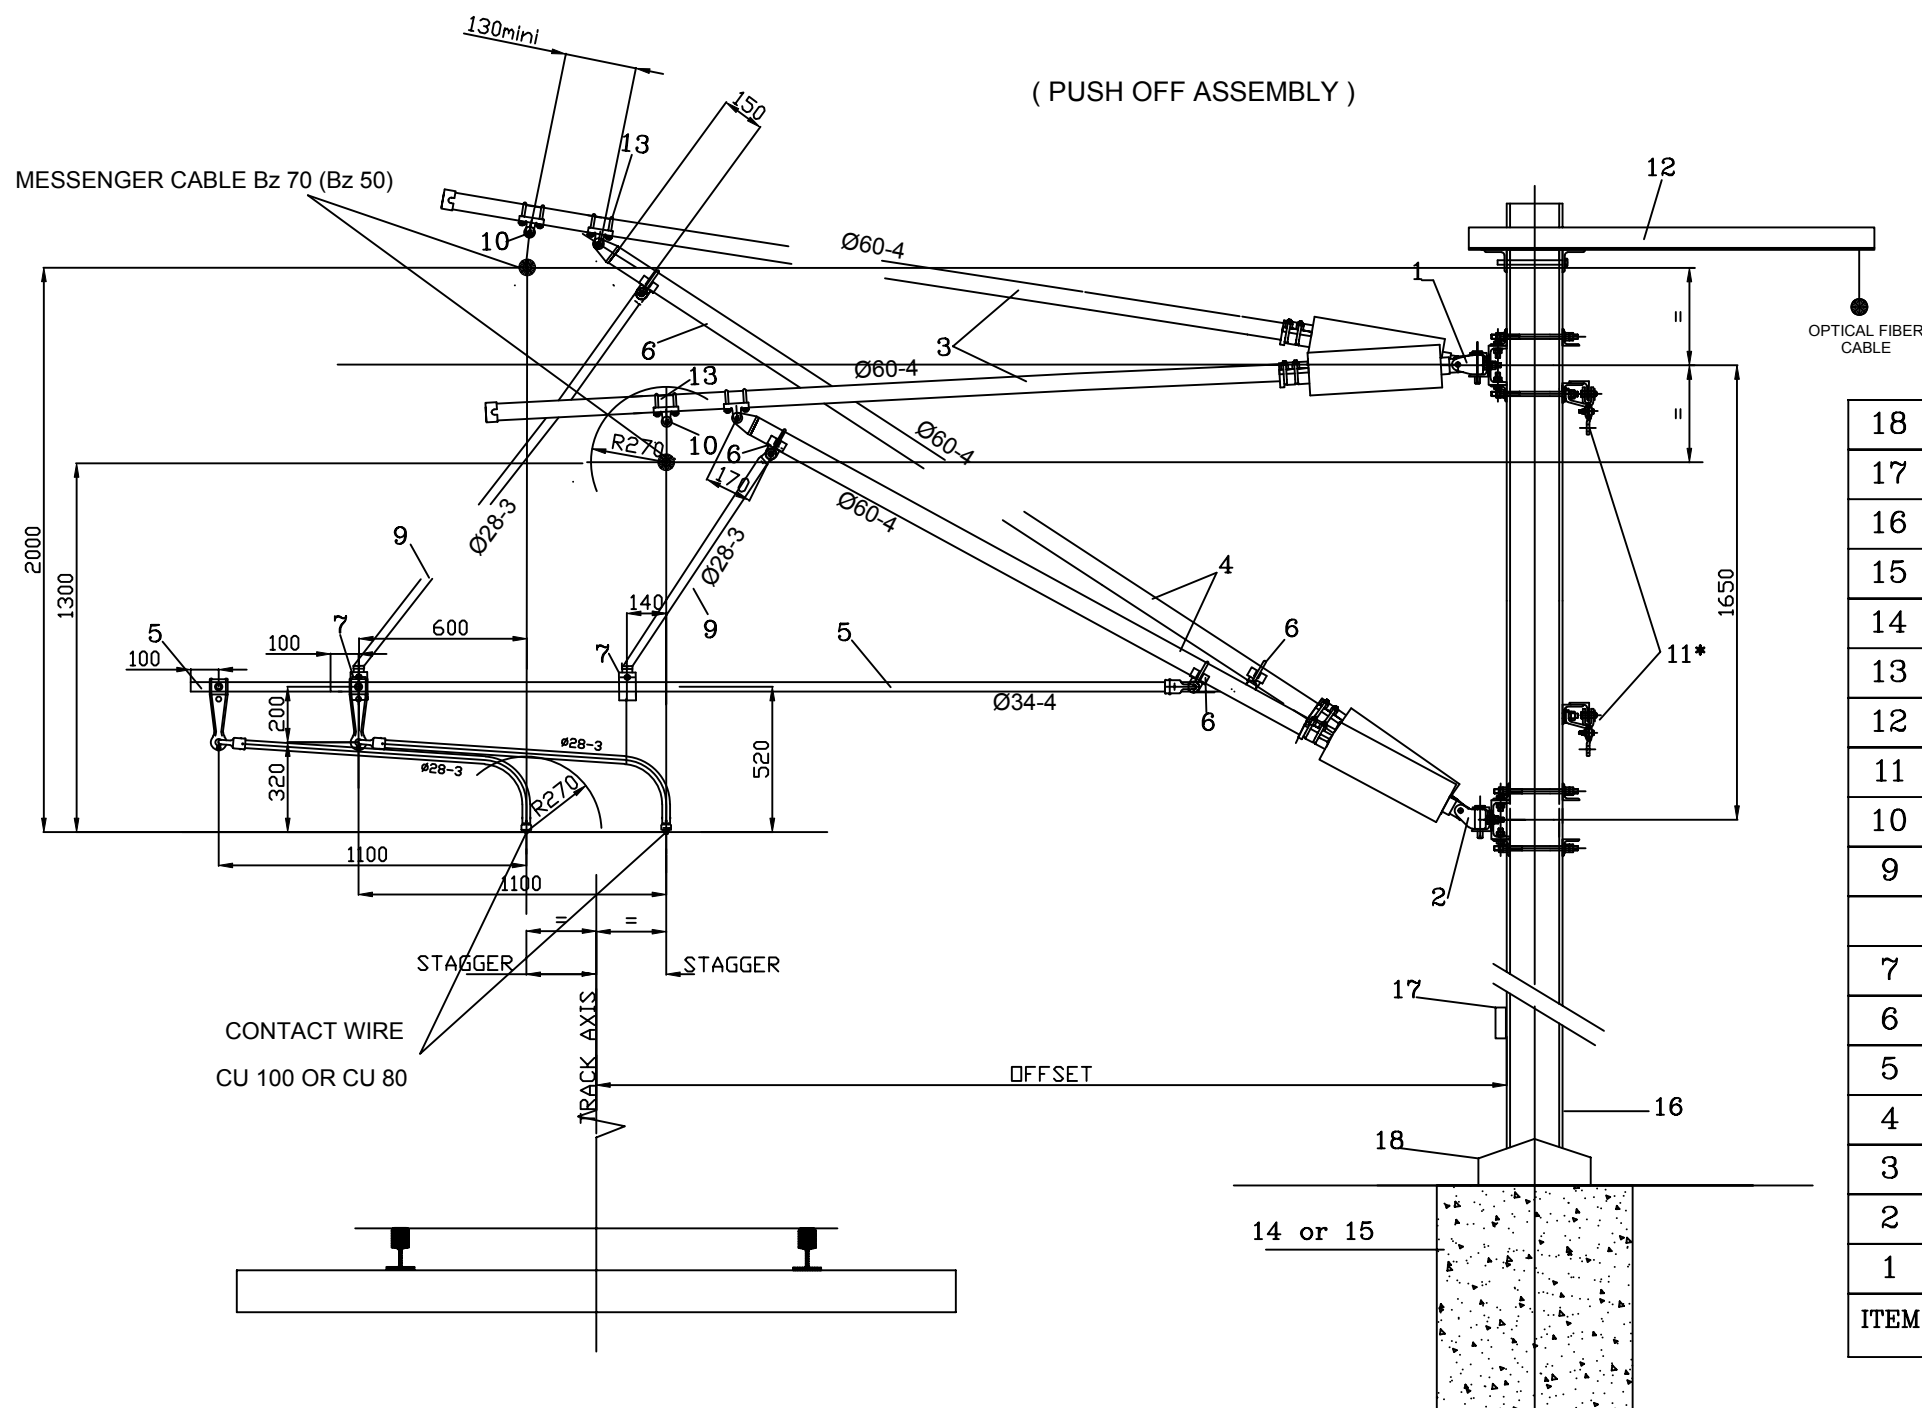


18	DICE PROTECTION	01LC00BDG008	
17	ASSEMBLY OF SAFETY DEVICES		
16	MAST TYPES AND REFERENCES	01LC00BDG010	
15	-	-	
14	POLE FOUNDATION	01LC00BDG006	
13	FASTENING FOR TOP TUBE	01LC00BDG069	
12	OPTICAL FIBER BRACKET	01LC00BDG054	
11	EARTHING SUSPENSION	or 01LC00BDG081 01LC00BDG072	
10	SUSPENSION FOR 1 OR 2 MESSENGER	01LC00BDG070	
9	AUXILIARY STRUT TUBE	01LC00BDG083	
7	FASTENING ON TUBE $\phi 34$	ELC 26-4.7.0	
6	FASTENING ON TUBE $\phi 60$	ELC 13-1.2.3.0	
5	$\phi 34-4$ REGISTRATION ARM WITH 1.1m STEADY ARM FOR INS. OVERLAP	01LC00BDG152	202
4	INSULATED FOR STRUT TUBE $\phi 60$	01LC00BDG066	
3	INSULATED FOR TOP TUBE $\phi 60$	01LC00BDG04	
2	FASTENING FOR STRUT TUBE	or 01LC00BDG080 01LC00BDG081	
1	FASTENING FOR TOP TUBE	or 01LC00BDG079 01LC00BDG136	
ITEM	DESIGNATION	REFERENCE DRAWING	MARK

NOTE:

* EXACTE POSITION (HEIGHT, FIELD OR TRACK SIDE) WILL BE DEFINED DURING DETAIL DESIGN STAGE

ECHIPARE TIP A CATENAREI PENTRU STALPII MEDIANI AI ZONEI IZOLATE (DISTANTA INTRE CONSOLE DE 1.60 m)
TYPICAL CATENARY EQUIPMENT FOR INSULATED OVERLAP AXIS (WITH EQUIPMENTS SPACING 1.60m)


Numele fisierului/ CAD file name:	Scara/ Scale:	Part	Rev.
01LC00BDG039		2 / 2	0

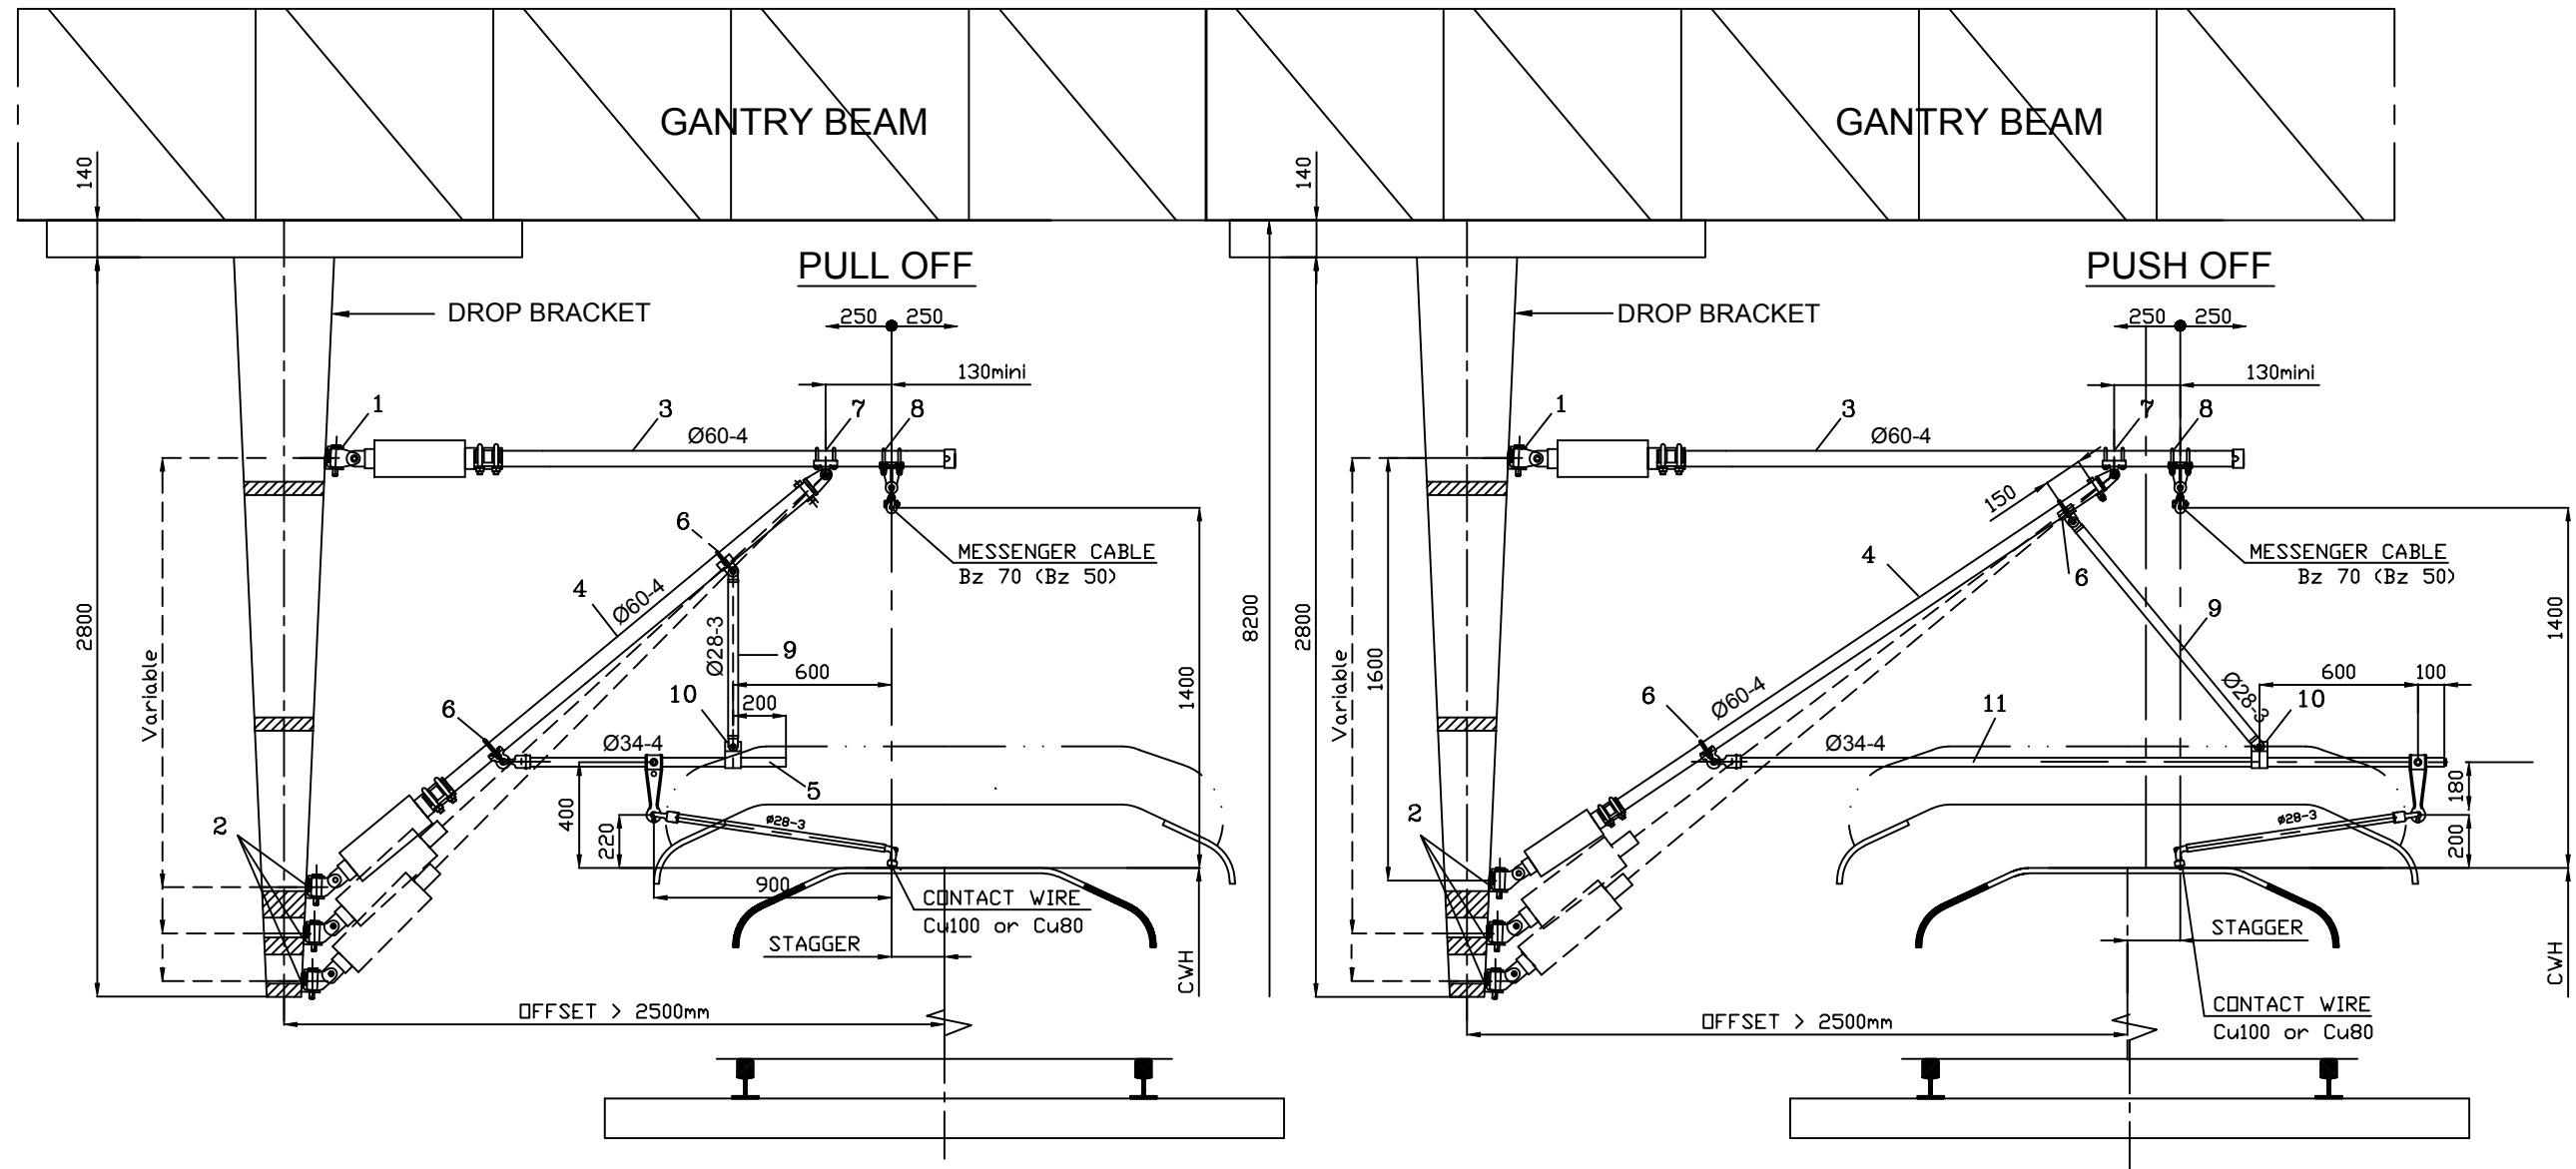

11	Ø34-4 REGISTRATION ARM WITH 0.9m STEADY ARM FOR STRAIGHT LINE	01LC00BDG150	202
10	FASTENING ON TUBE Ø34	ELC 26-4.7.0	
9	AUXILIARY STRUT TUBE	01LC00BDG083	
8	SUSPENSION FOR 1 or 2 MESSENGERS	01LC00BDG071	
7	FASTENING FOR TOP TUBE	01LC00BDG070	
6	FASTENING ON TUBE Ø60	ELC 13-1.2.3.0	
5	Ø34-4 REGISTRATION ARM WITH 0.9m STEADY ARM FOR STRAIGHT LINE	01LC00BDG150	201
4	INSULATED FOR STRUT TUBE Ø60	01LC00BDG066	
3	INSULATED FOR TOP TUBE Ø60	01LC00BDG064	
2	FASTENING FOR STRUT TUBE	ELC 13-13.0A	II
1	FASTENING FOR TOP TUBE	ELC 13-13.0A	I
ITEM	DESIGNATION	REFERENCE DRAWING	MARK

ECHIPARE TIP A CATENAREI PE TRAVERSA RIGIDA
TYPICAL CATENARY EQUIPMENT ON GANTER BEAM

Numele fisierului/ CAD file name:	Scara/ Scale:	Part	Rev.
01LC00BDG040	1 / 2	0	

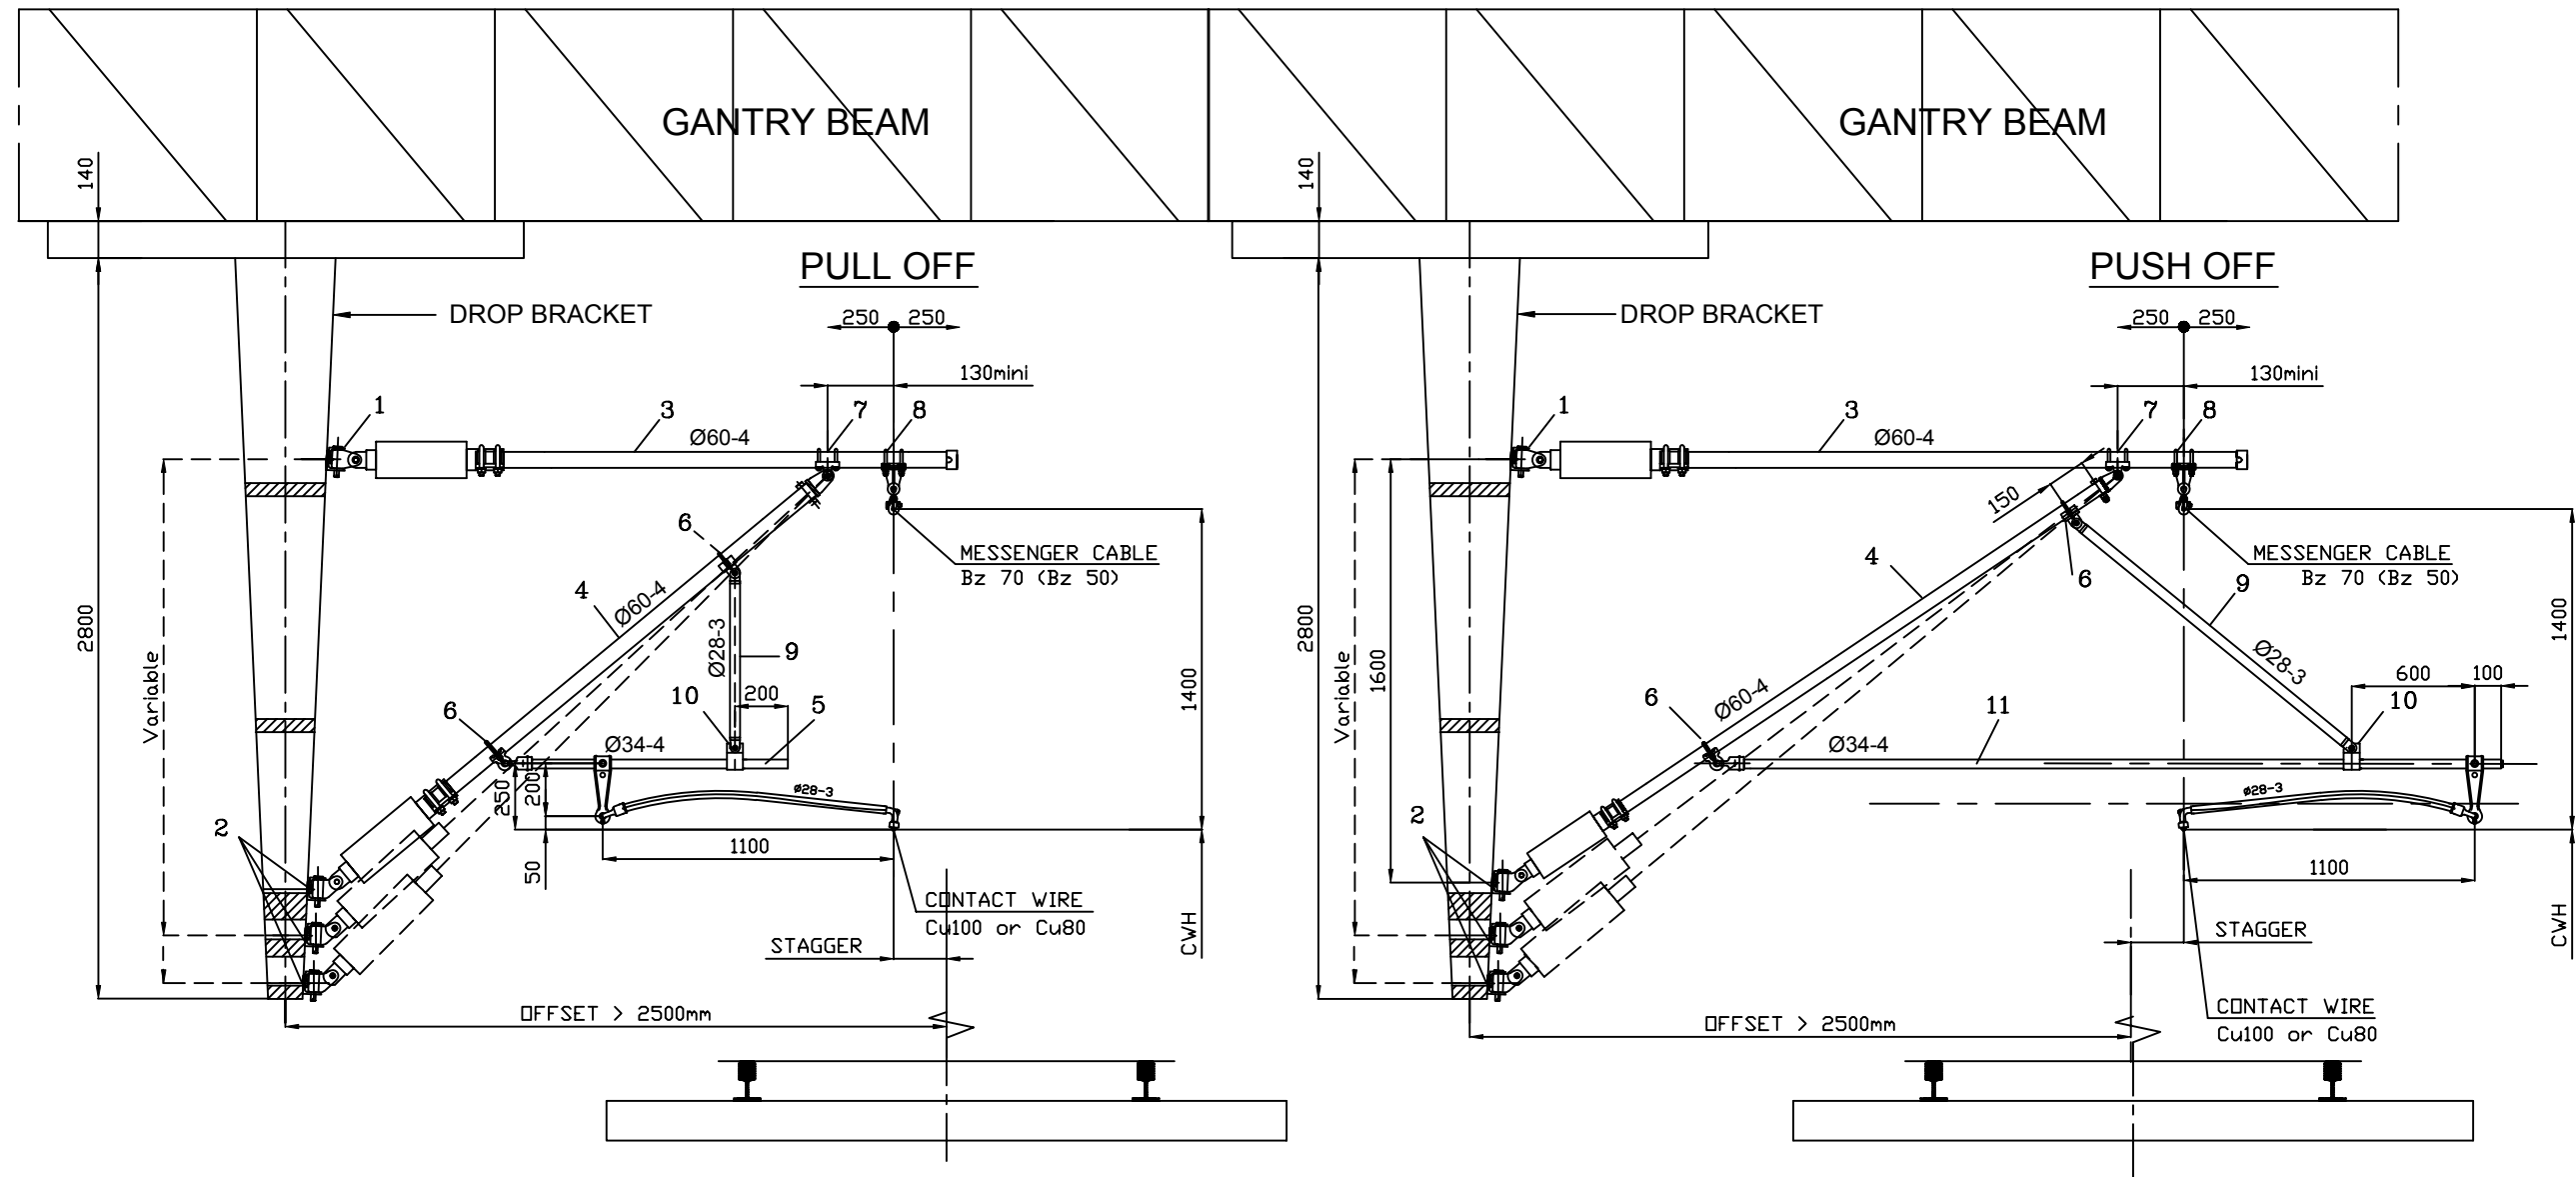


11	Ø34-4 REGISTRATION ARM WITH 1.1m STEADY ARM FOR CURVE	01LC00BDG151	202
10	FASTENING ON TUBE Ø34	ELC 26-4.7.0	
9	AUXILIARY STRUT TUBE	01LC00BDG083	
8	SUSPENSION FOR 1 or 2 MESSENGERS	01LC00BDG071	
7	FASTENING FOR TOP TUBE	01LC00BDG070	
6	FASTENING ON TUBE Ø60	ELC 13-1.2.3.0	
5	Ø34-4 REGISTRATION ARM WITH 1.1m STEADY ARM FOR CURVE	01LC00BDG151	201
4	INSULATED FOR STRUT TUBE Ø60	01LC00BDG066	
3	INSULATED FOR TOP TUBE Ø60	01LC00BDG064	
2	FASTENING FOR STRUT TUBE	ELC 13-13.0A	II
1	FASTENING FOR TOP TUBE	ELC 13-13.0A	I
ITEM	DESIGNATION	REFERENCE DRAWING	MARK


ECHIPARE TIP A CATENAREI PE TRAVERSA RIGIDA
TYPICAL CATENARY EQUIPMENT ON GANTER BEAM

Numele fisierului/ CAD file name:	Scara/ Scale:	Part	Rev.
01LC00BDG040		2 / 2	0

TYPICAL MOUNTING

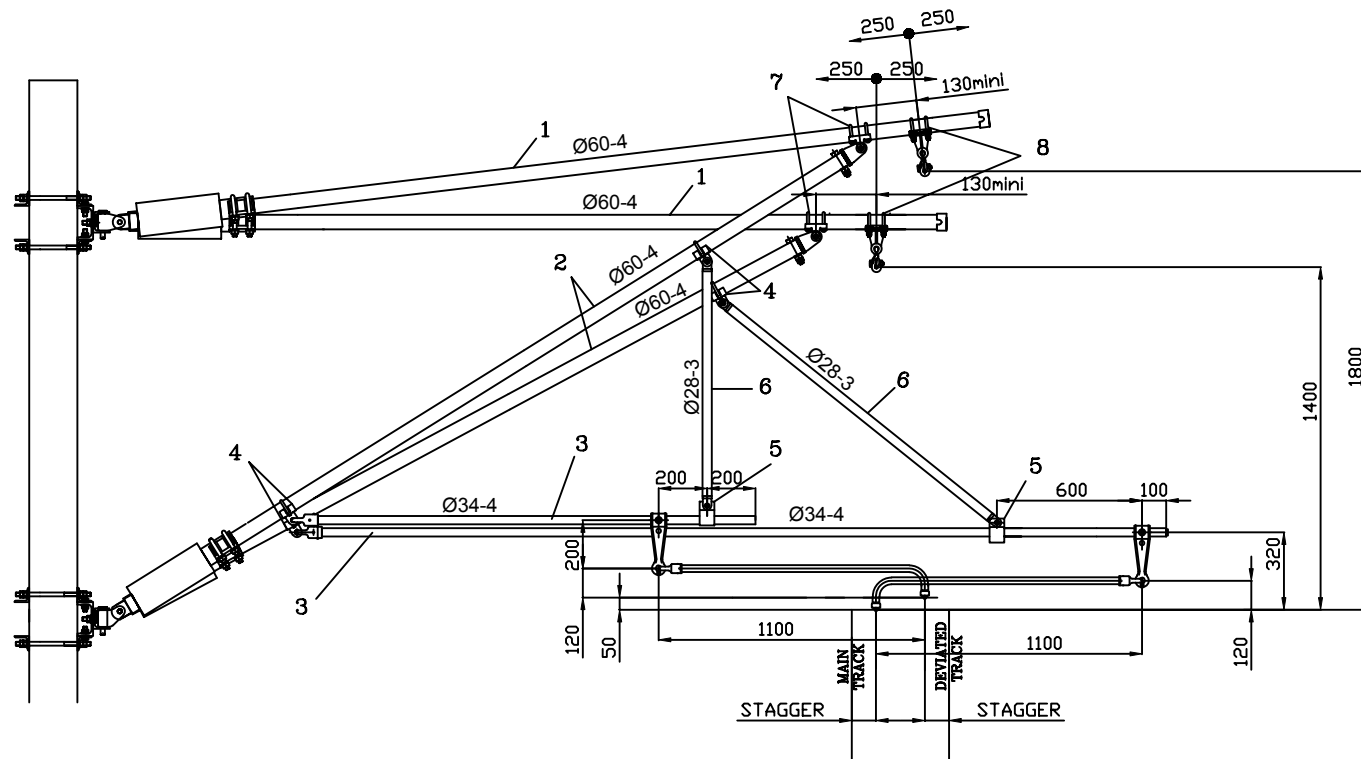


TYPICAL MOUNTING

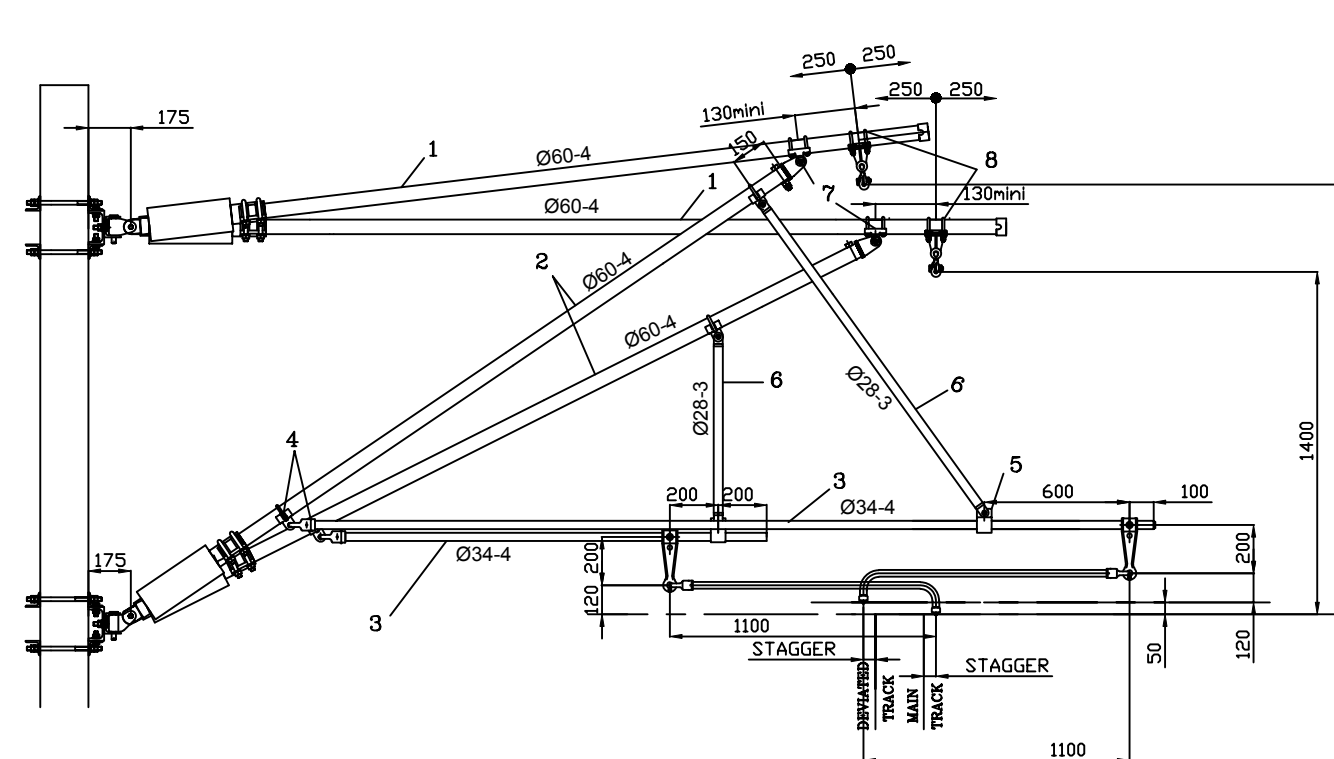


11	1.1m STEADY ARM FOR CROSS-OVER	ELC 32-11.0A	
10	ASSEMBLY CLAMP GROOVED CONTACT WIRE	ELC 32-9.5.5.0B	
9	ROTATING FASTENING ASSEMBLY	01LC00BDG084	
8	SUSPENSION FOR 1 OR 2 MESSENGERS	01LC00BDG070	
7	FASTENING FOR TOP TUBE	01LC00BDG069	
6	AUXILIARY STRUT TUBE	ELC 32-9.11.1B	
5	FASTENING ON TUBE Ø34	ELC 26-4.7.0	
4	FASTENING ON TUBE Ø60	ELC 13-1.2.3.0	
3	Ø34-4 REGISTRATION ARM WITH 1.1m STEADY ARM FOR CROSS-OVER	01LC00BDG153	
2	INSULATED FOR STRUT TUBE	01LC00BDG066	
1	INSULATED FOR TOP TUBE	01LC00BDG064	
ITEM	DESIGNATION	REFERENCE DRAWING	MARK

TYPICAL MOUNTING WITH SMALL OFFSET

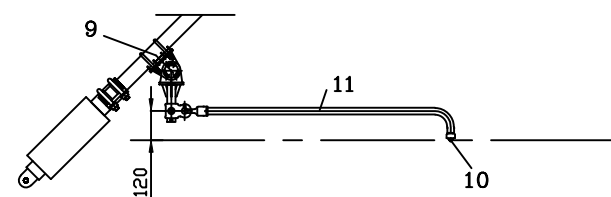


MONTAJ TIP PENTRU INCRUCISARE
TYPICAL MOUNTING FOR CROSS-OVER

Numele fisierului/ CAD file name:	Scara/ Scale:	Part	Rev.
01LC00BDG042		1 / 1	0

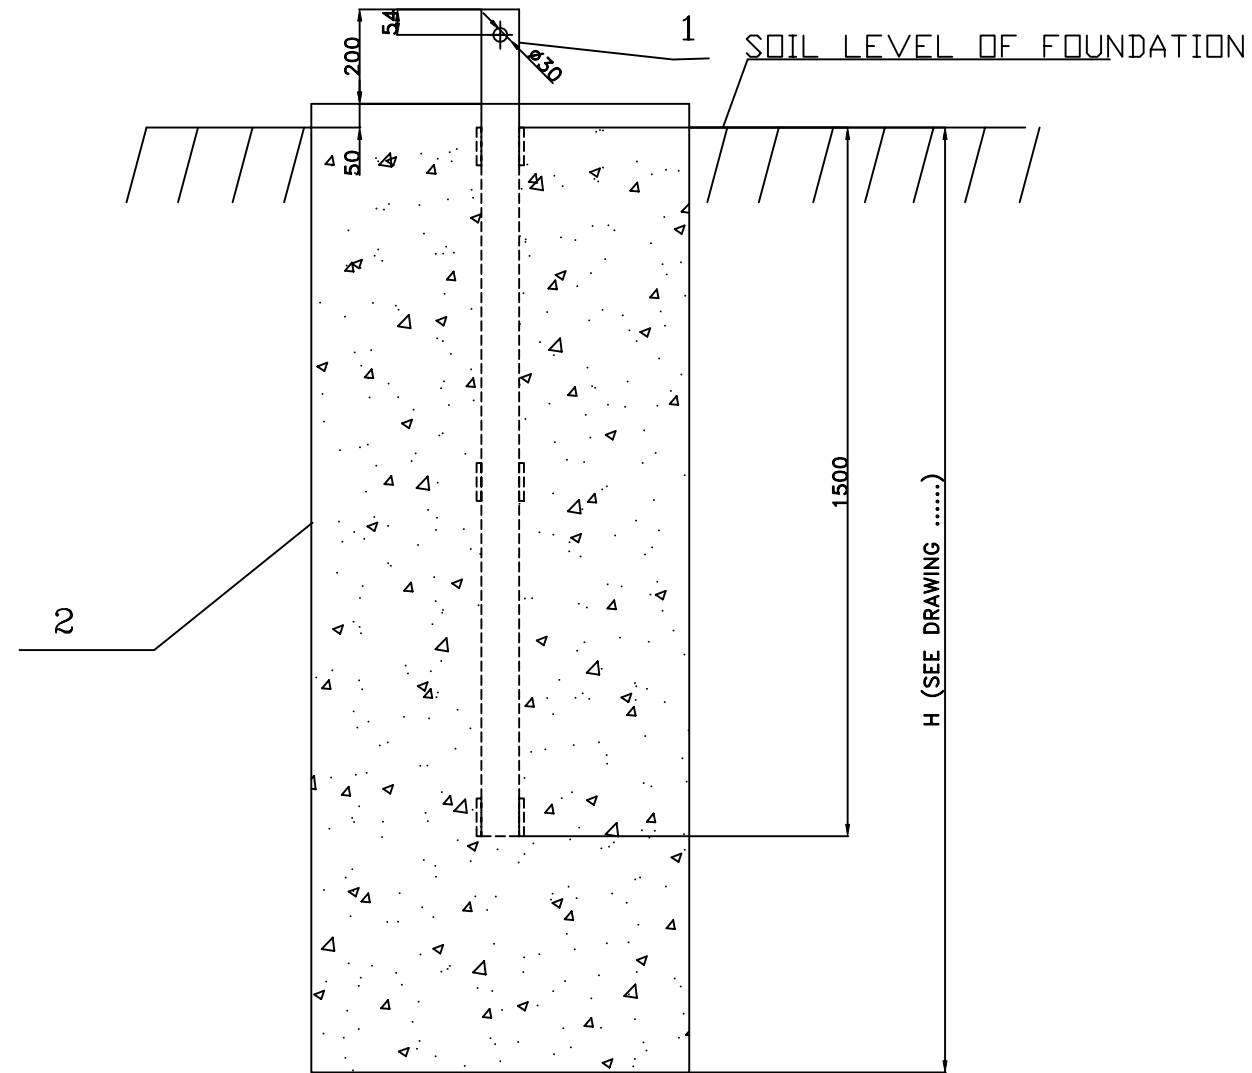

MARK GROUP	1	2	CYLINDRICAL FOUNDATION ALLOCATION TABLE	***	01LC00BDG006	
	1	1	LEVEL ANCHOR BEAM		01LC00BDG132	
QUANT.	*****	ITEM	DESIGNATION	UNIT MASS	REFERENCE DRAWING	MARK
				kg		


ANCORA LA NIVEL LEVEL ANCHOR	Numele fisierului/ CAD file name:	Scara/ Scale:	Part	Rev.
	01LC00BDG047		1 / 1	0

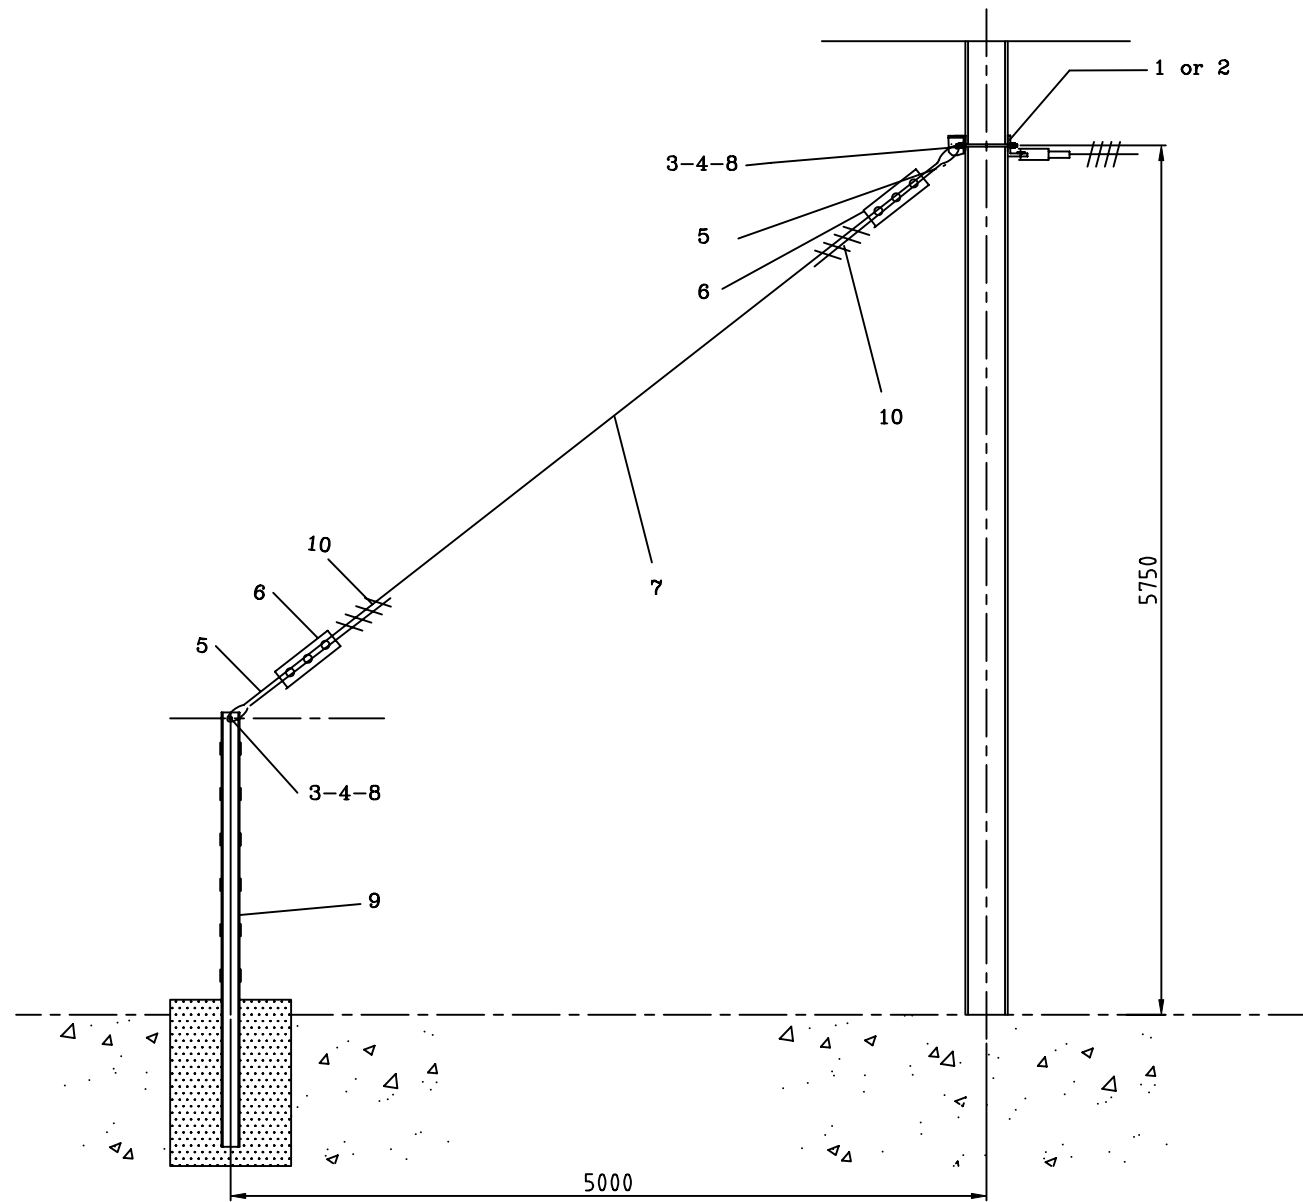

FROM HEA or HEB 200 TO 240 : MARK 103
 FROM HEA or HEB 260 TO 320 : MARK 104

MARK. GROUP	104	103	ITEM	DESIGNATION	REFERENCE DRAWING	MARK
QUANTITY	2	2	10	IRON	STAS 434-73	
	1	1	9	UPN ANCHOR IC 120	ELC/CFD 1-6.0	
	1	1	8	WASHER M20	01LC00BDG142	20A110
	1	1	7	CABLE 70mm ² < L = ~ 10m > DL2m	EP2610-4.0A/13	...
	2	2	6	EYES PLATE	ELC/CFD 1-12-0	
	2	2	5	TRIMBLE	ELC/CFD 1-8	
	1	1	4	PIN V5-36	01LC00BDG145	05A036
	1	1	3	AXIS Ø20-70	01LC00BDG146	201070
	1		2	FASTENING FOR ANCHORING OF EARTH CONDUCTOR	01LC00BDG140	102
		1	1	FASTENING FOR ANCHORING OF EARTH CONDUCTOR	01LC00BDG140	101

ANCORARE CABLU COLECTOR EARTHING CONDUCTOR ANCHORING	Numele fisierului/ CAD file name:	Scara/ Scale:	Part	Rev.
	01LC00BDG048		1 / 2	0

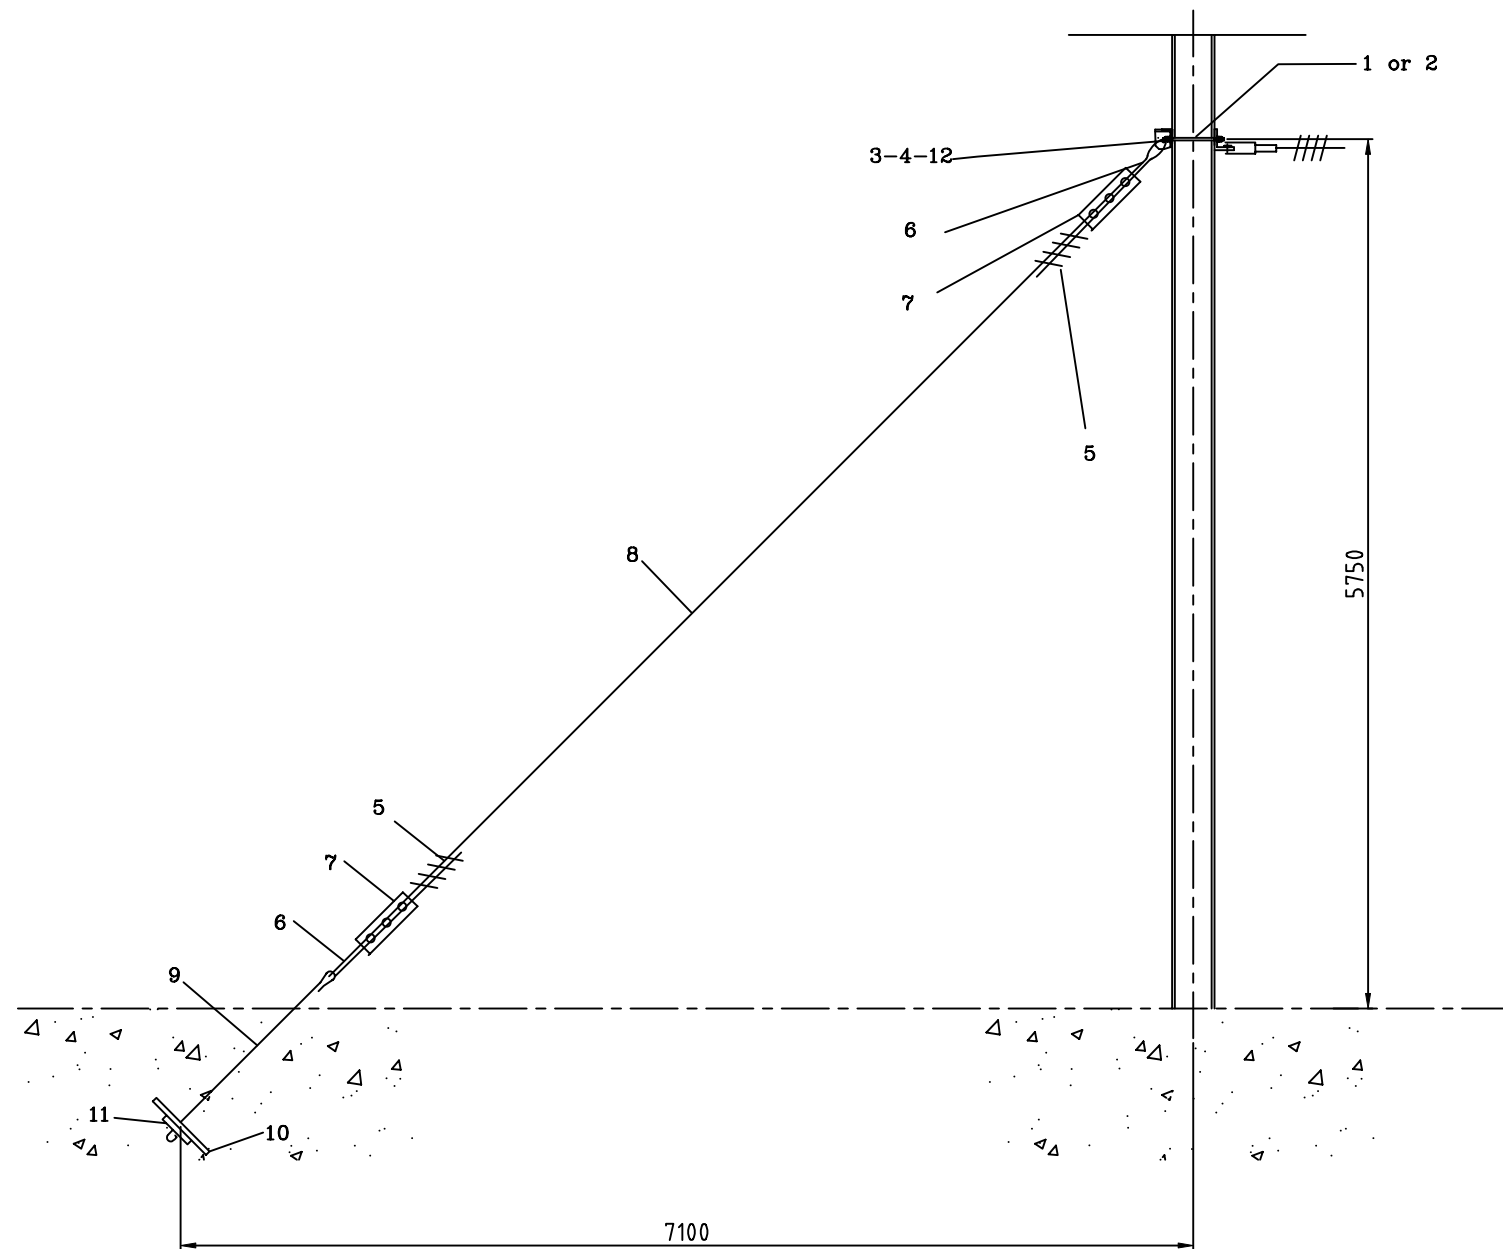

FROM HEA or HEB 200 TO 240 : MARK 101

FROM HEA or HEB 260 TO 320 : MARK 102

MARK.GROUP	QUANTITY		ITEM	DESIGNATION	REFERENCE DRAWING	MARK
	102	101				
	1	1	12	WASHER M20	01LC00BDG142	20A110
	1	1	11	SMALL PLATE	EP2610-16	...
	1	1	10	CONCRETE PLATE FOR ANCHORING	RA2-214/1978	...
	1	1	9	ANCHOR ROD RCA 37 (DL-37-2)	EP2610-4.0A/14	...
	1	1	8	CABLE 70mm2 < L= ~ 10m > DL2m	EP2610-4.0A/13	...
	2	2	7	EYES PLATE	ELC/CFD 1-12-0	
	2	2	6	TRIMBLE	ELC/CFD 1-8	
	2	2	5	IRON	STAS 434-73	
	1	1	4	PIN V5-36	01LC00BDG145	05A036
	1	1	3	AXIS Ø20-70	01LC00BDG146	201070
	1		2	FASTENING FOR ANCHORING OF EARTH CONDUCTOR	01LC00BDG140	102
		1	1	FASTENING FOR ANCHORING OF EARTH CONDUCTOR	01LC00BDG140	101
MARK.GROUP	102	101	ITEM	DESIGNATION	REFERENCE DRAWING	MARK


ANCORARE CABLU COLECTOR
EARTHING CONDUCTOR ANCHORING

Numele fisierului/
CAD file name:
01LC00BDG048

Scara/
Scale:

Part
2 / 2


Rev.
0

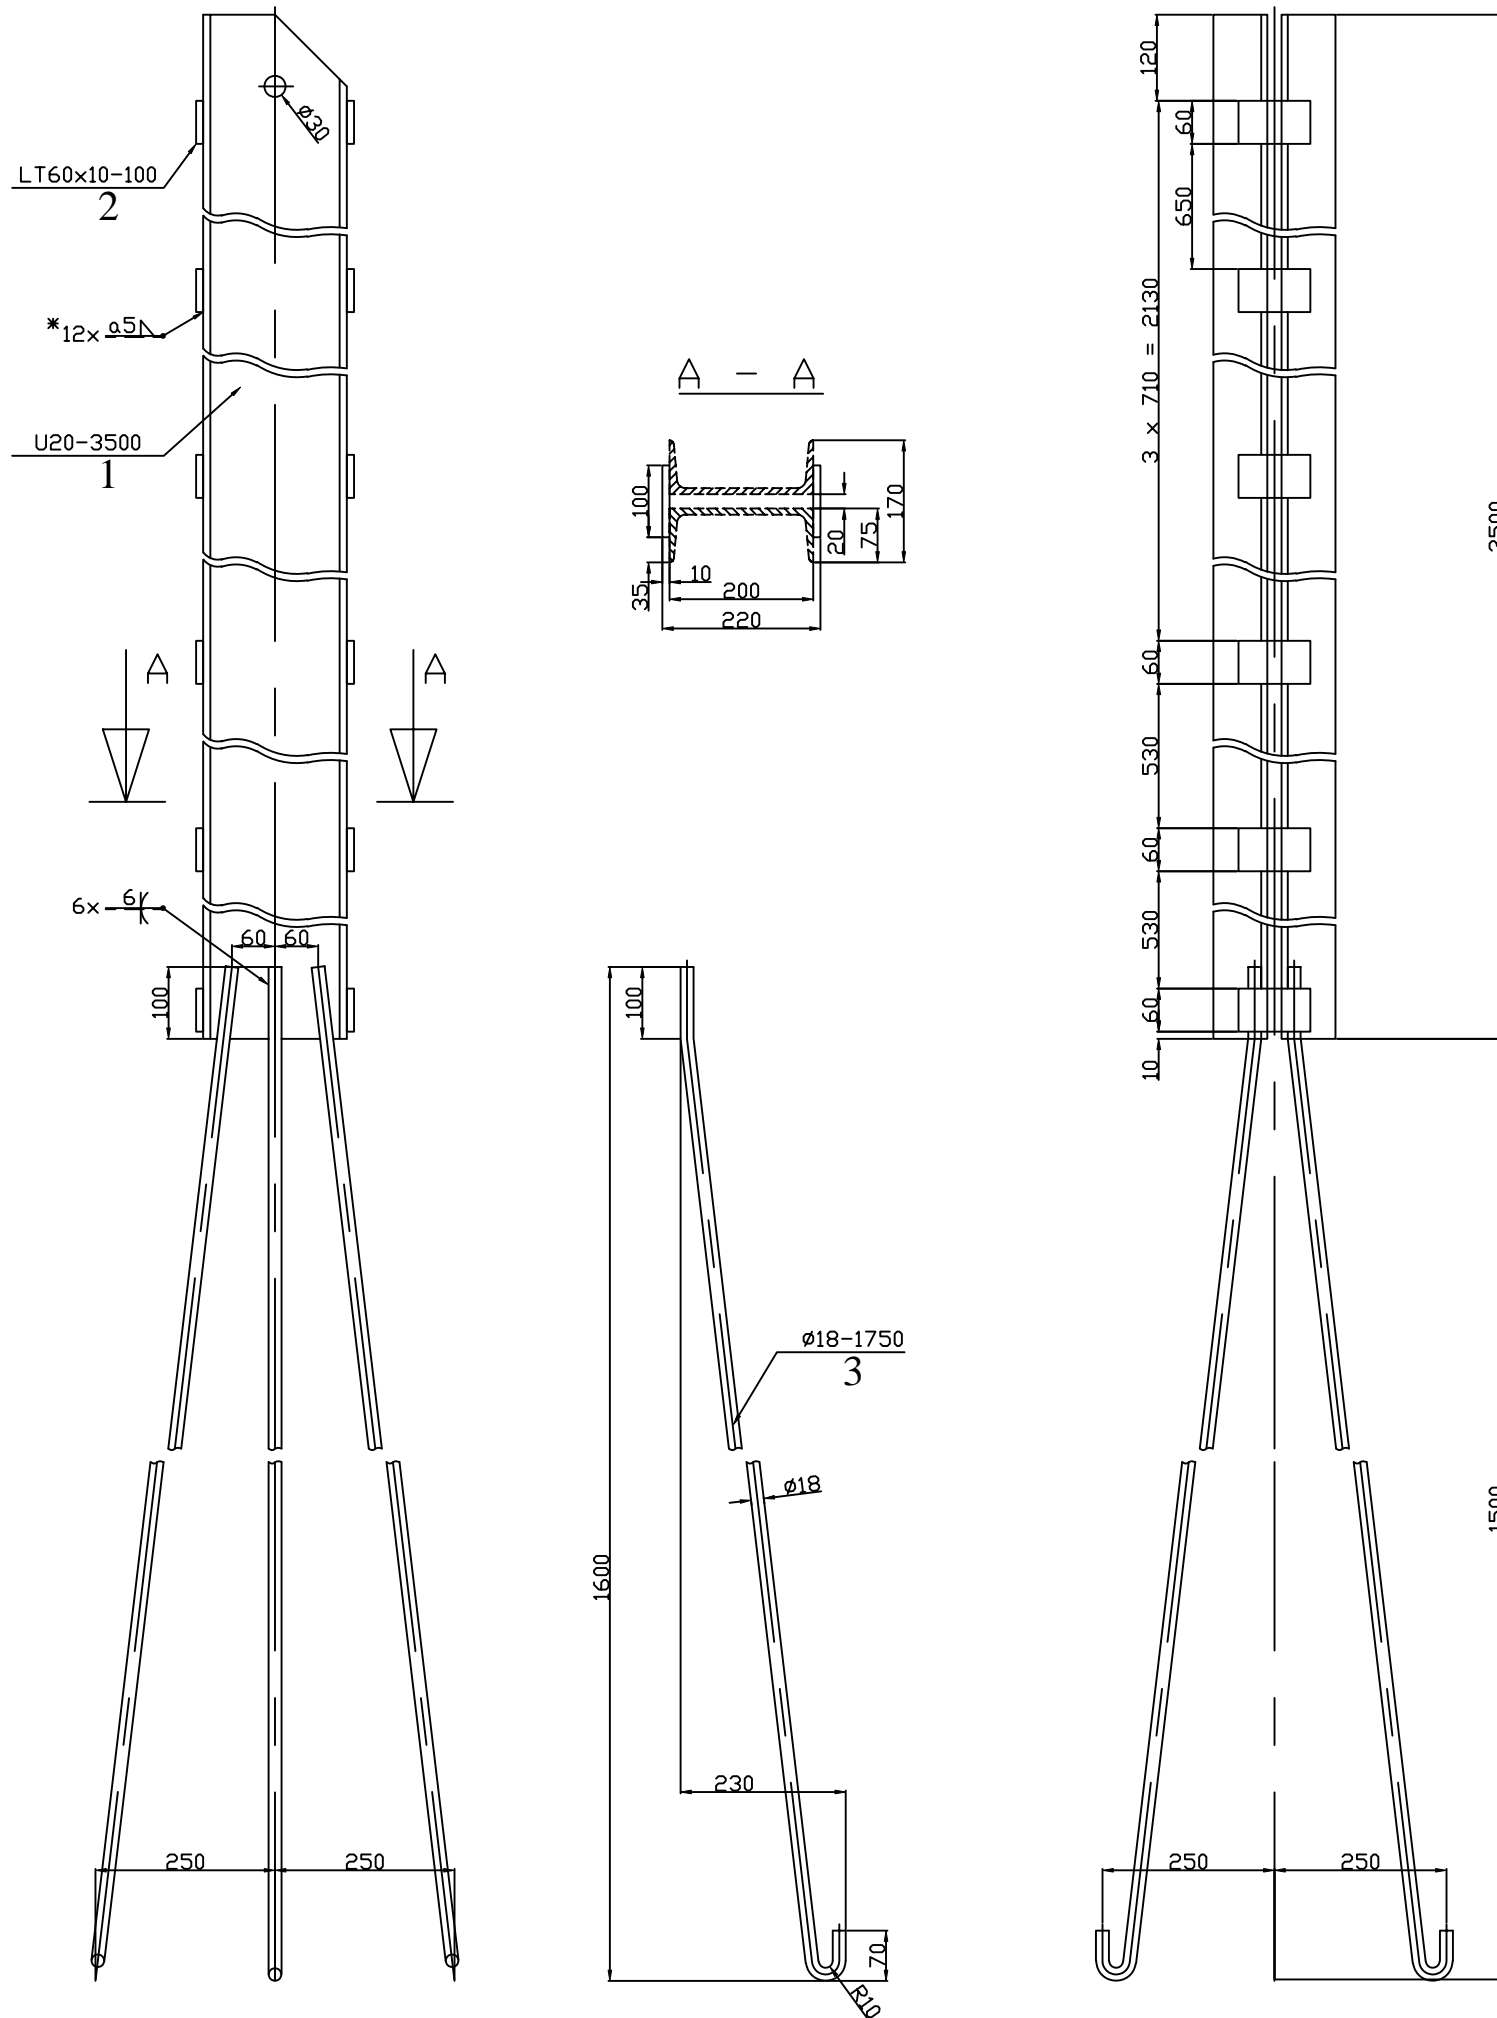

- NOTE:**
1. The welds marked with * will be made tight.
 2. After welding of items 1 and 2 and drilling, the assembly will be hot galvanized AT/OL/Zn600-STAS 7221-90.
 3. After hot galvanize will be made the weldings for armature item 3.

MARK GROUP	QUANTITY	ITEM	DESIGNATION	UNIT MASS	MATERIAL TECHNICAL SPECIFICATION
	6	3	ARMATURE		minim. S235JR
	12	2	STRAP		minim. S235JR
	2	1	LONGERON		minim. S235JR

ANCORA SUPRAINALTATA SUPERELEVATED ANCHOR	Numele fisierului/ CAD file name:	Scara/ Scale:	Part	Rev.
	01LC00BDG049		1 / 1	0

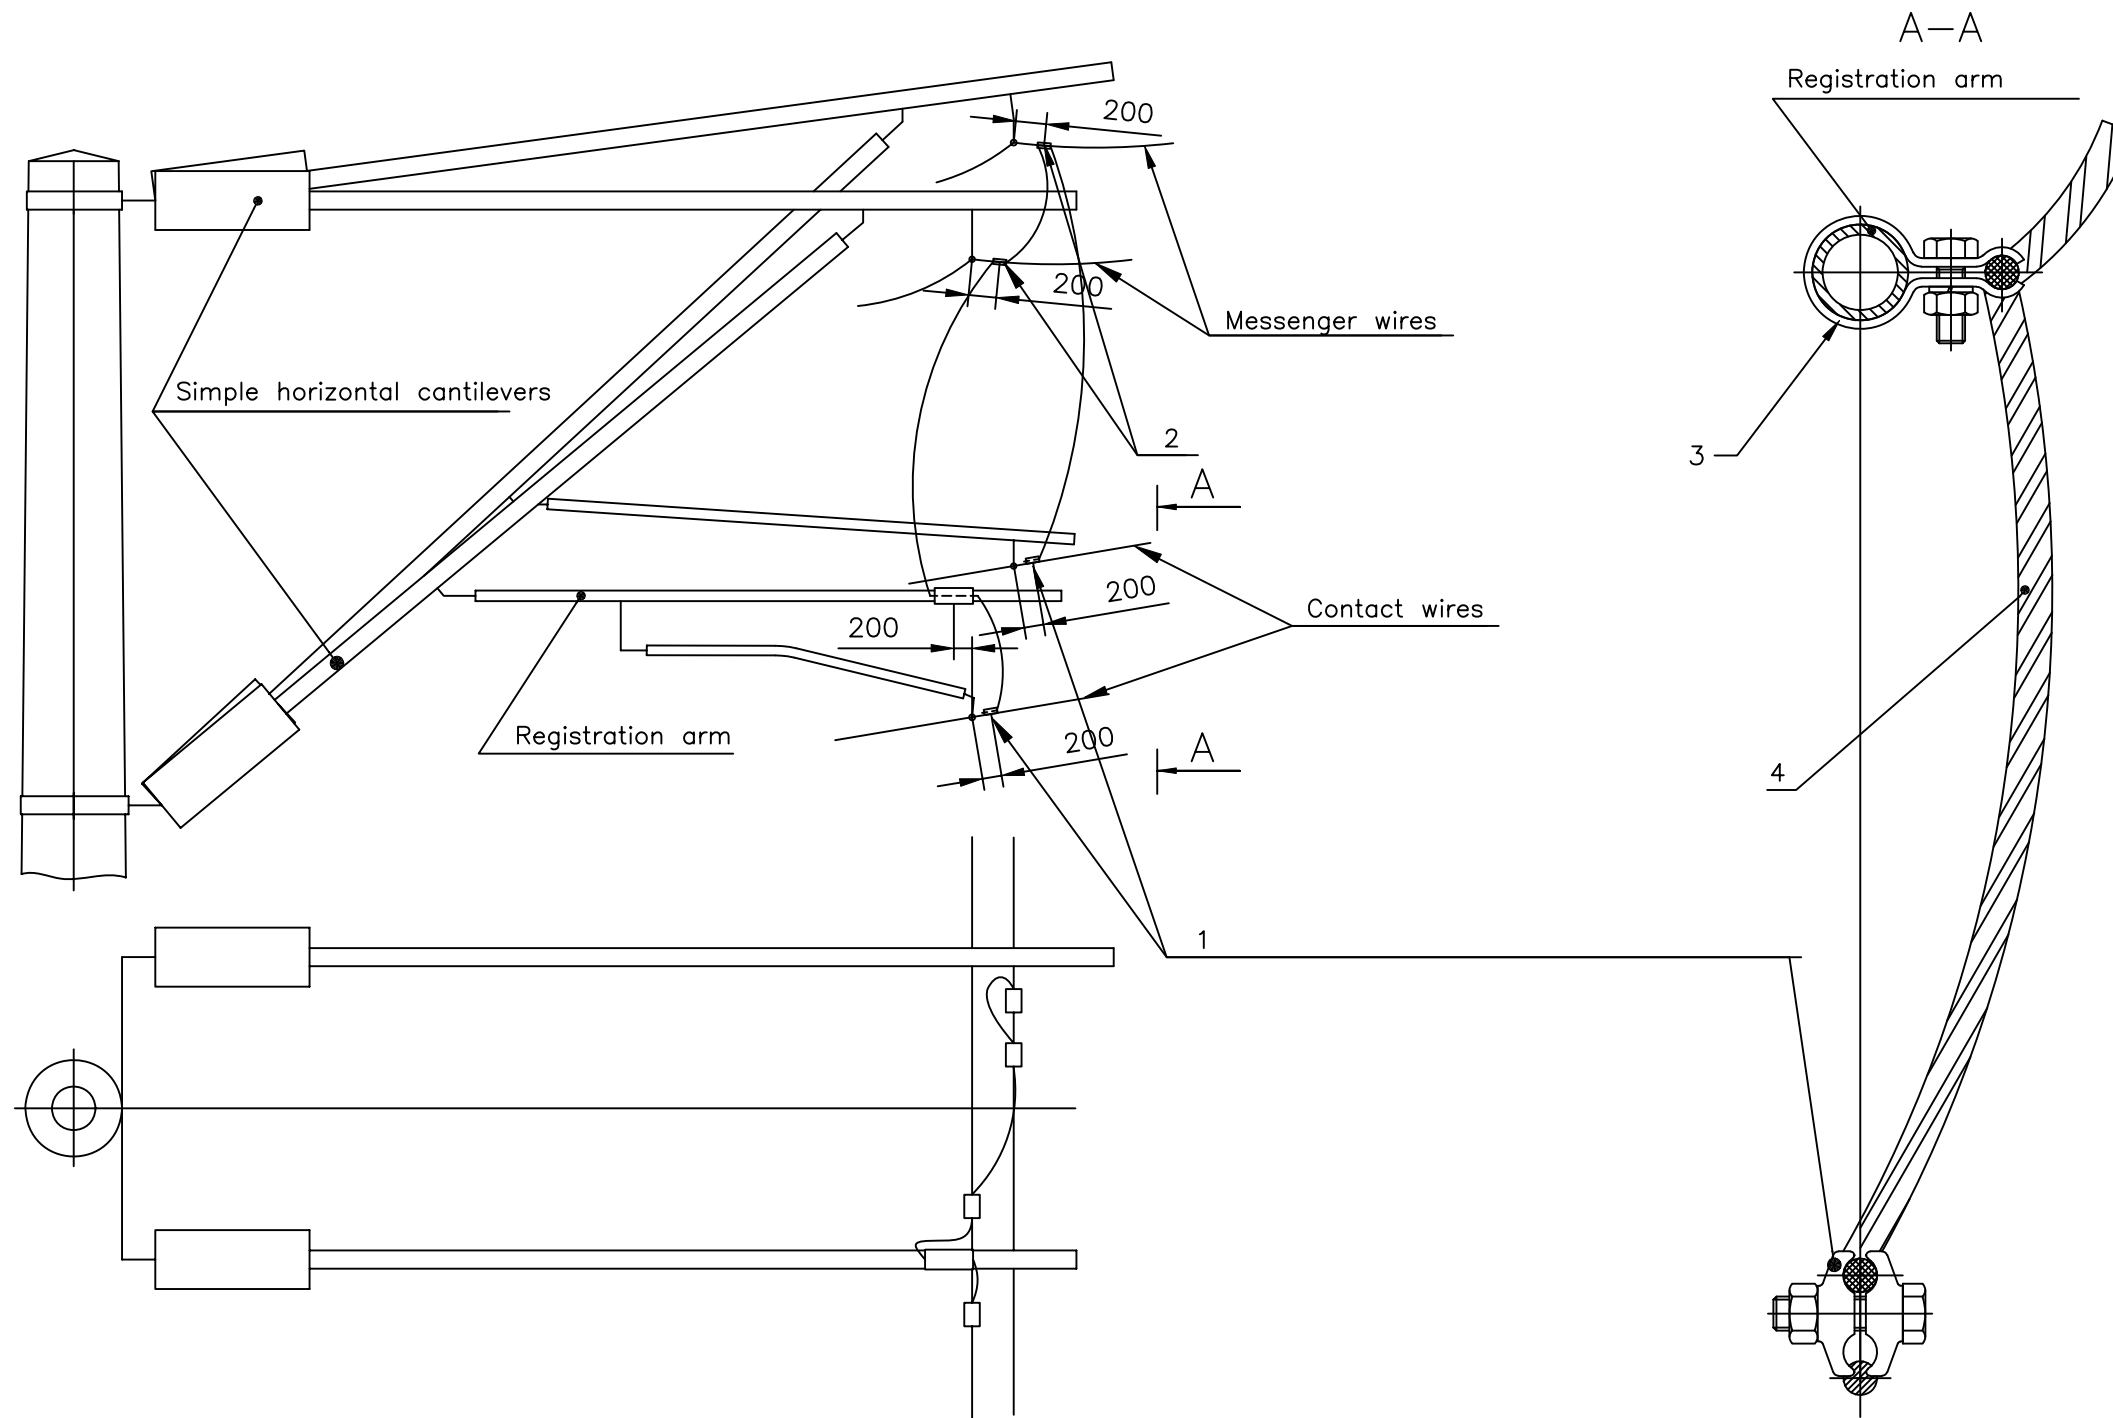


MARK GROUP	QUANTITY	-	4	ELECTRICAL CONNECTION WIRE 70mmp	L=5.2 m	
	SEE TABLE	1	3	CONNECTION CLAMP FOR REGISTRATION ARM	ELC 5-4.B	
		2	2	ELECTRICAL CONNECTION CLAMP FOR MESSENGER WIRE	LECP-00	
		2	1	ELECTRICAL CONNECTION CLAMP FOR CONTACT WIRE	LEFC-00	
		ITEM	DESIGNATION	REFERENCE DRAWING	MARK	

LEGATURA LONGITUDINALA
LONGITUDINAL CONNECTION

Numele fisierului/
CAD file name:
01LC00BDG050

Scara/
Scale:

Part	Rev.
1 / 1	0

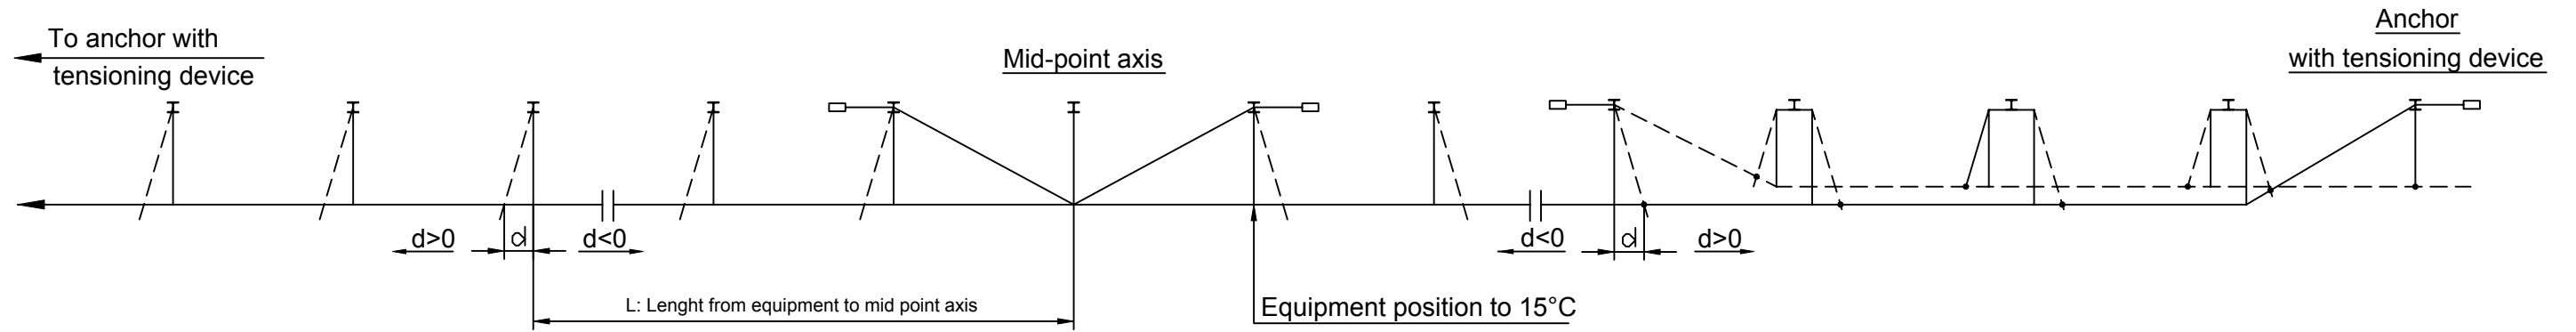

FOR : 15°C THE EQUIPMENT IS PERPENDICULAR TO THE TRACK. $d = 0$

FOR : $\theta > 15^\circ\text{C}$ $d > 0$ THE EQUIPMENT MOVED TOWARDS ANCHOR WITH TENSIONING DEVICE

FOR : $\theta < 15^\circ\text{C}$ $d < 0$ THE EQUIPMENT MOVED TOWARDS FIXED ANCHOR OR MID POINT AXIS

		"d" values (cm)													
		L (m) from L min to L max													
	L min	0	51	101	151	201	251	301	351	401	451	501	551	601	
	L max	50	100	150	200	250	300	350	400	450	500	550	600	650	
⊖	-33	-2	-5	-8	-11	-15	-18	-21	-24	-27	-31	-34	-37	-40	
⊖	-30	-1	-4	-7	-10	-13	-16	-19	-22	-25	-28	-31	-34	-37	
⊖	-25	-1	-4	-6	-9	-11	-14	-17	-19	-22	-24	-27	-29	-32	
⊖	-20	-1	-3	-5	-7	-10	-12	-14	-16	-18	-20	-22	-24	-27	
⊖	-15	-1	-3	-4	-6	-8	-9	-11	-13	-14	-16	-18	-20	-21	
⊖	-10	-1	-2	-3	-4	-6	-7	-8	-10	-11	-12	-13	-15	-16	
⊖	-5	0	-1	-2	-3	-4	-5	-6	-6	-7	-8	-9	-10	-11	
⊖	0	0	-1	-1	-1	-2	-2	-3	-3	-4	-4	-4	-5	-5	
⊕	5	0	0	0	0	0	0	0	0	0	0	0	0	0	
⊕	10	0	1	1	1	2	2	3	3	4	4	4	5	5	
⊕	15	0	1	2	3	4	5	6	6	7	8	9	10	11	
⊕	20	1	2	3	4	6	7	8	10	11	12	13	15	16	
⊕	25	1	3	4	6	8	9	11	13	14	16	18	20	21	
⊕	30	1	3	5	7	10	12	14	16	18	20	22	24	27	
⊕	35	1	4	6	9	11	14	17	19	22	24	27	29	32	

DEPLASAREA CATENAREI IN LUNGUL LINEI FUNCTIE DE TEMPERATURA ALONG TRACK MOVEMENT OF EQUIPMENT ACCORDING TO TEMPERATURE RANGE	Numele fisierului/ CAD file name:	Scara/ Scale:	Part	Rev.
	01LC00BDG052		1 / 1	0

GENERALITY

1 / THE MECHANICAL TENSIONS OF THE CONTACT WIRE AND CATENARY WIRE KEPT CONSTANT BETWEEN THE MINIMUM AND MAXIMUM TEMPERATURES WITH BALANCE WEIGHT ARRANGEMENTS INSTALLED ON THE OVERLAP ANCHORING MAST .

2 / TO MINIMISE THE WEIGHT OF THE BALANCE WEIGHT, THE TENSIONING DEVICE IS A PULLEY WHEEL TERMINATION ARRANGEMENT GIVING A REDUCTION RATIO EQUAL TO 3.

3 / THE BALANCE WEIGHT LOAD IS 1/3 OF THE CABLE TENSION AND THE BALANCE WEIGHT VERTICAL MOVEMENT IS 3 TIMES THE ELONGATION OR REDUCTION OF THE CABLE LENGTH CAUSED BY THE VARIATION OF THE TEMPERATURE .

ADJUSTMENT: THE TENSIONING DEVICE IS ADJUSTED SUCH THAT AT THE MAXIMUM TEMPERATURE, THE B AND C VALUES SHOWN HERE UNDER ARE : B = 130 cm
C = 0

DEFINITION OF B AND C

L = LENGTH OF CATENARY WIRE OR CONTACT WIRE FROM MID POINT AXIS OR FIXED ANCHOR



Θ° = OUTSIDE TEMPERATURE FOR ADJUSTMENT

$17 \cdot 10^{-6}$ = COEFFICIENT OF LINEAR EXPANSION FOR COPPER

$$B = 17 \cdot 10^{-6} \cdot L \cdot (\Theta_{MAXI} - \Theta)^6 + 130$$

$$C = 3 \cdot 17 \cdot 10^{-6} \cdot L \cdot (\Theta_{MAXI} - \Theta)^6$$

THE VALUES B, C AND L ARE IN CENTIMETRES

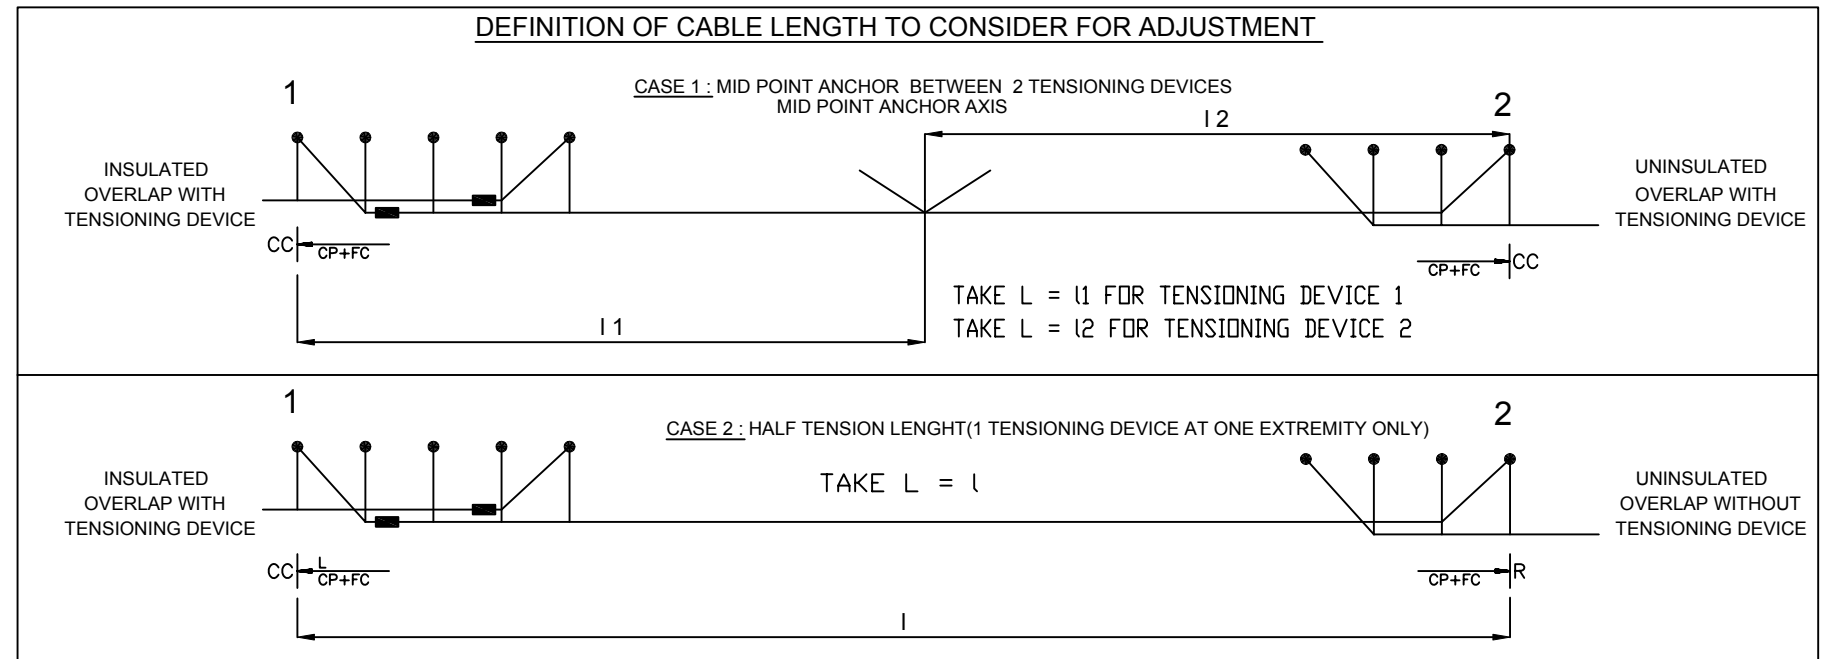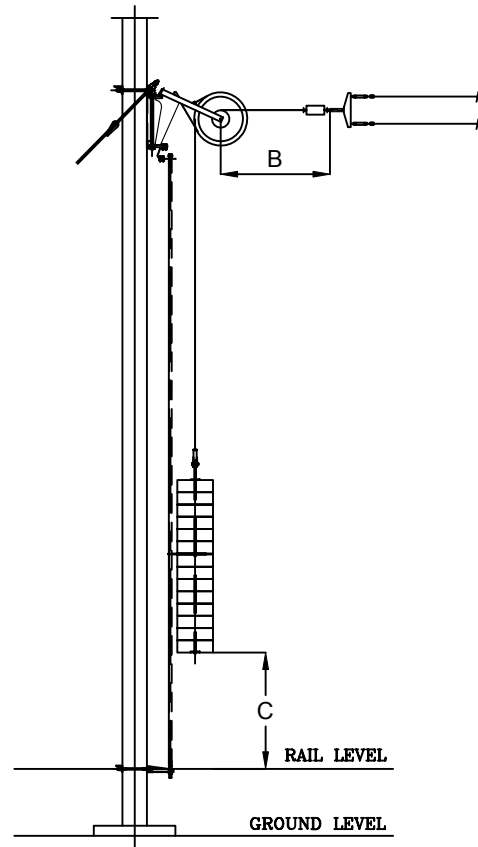

70 °C

Values of B (cm) for L

-35°C to 35°C	100	150	200	250	300	350	400	450	500	550	600	650	700
-35	148	157	166	175	184	192	201	210	219	228	237	246	255
-30	147	156	164	173	181	190	198	207	215	224	232	241	249
-25	146	154	162	170	178	187	195	203	211	219	227	235	243
-20	145	153	161	168	176	184	191	199	207	214	222	229	237
-15	144	152	159	166	173	181	188	195	202	209	217	224	231
-10	144	150	157	164	171	178	184	191	198	205	212	218	225
-5	143	149	156	162	168	175	181	187	194	200	207	213	219
0	142	148	154	160	166	172	178	184	190	195	201	207	213
5	141	147	152	158	163	169	174	180	185	191	196	202	207
10	140	145	150	156	161	166	171	176	181	186	191	196	201
15	139	144	149	153	158	163	167	172	177	181	186	191	195
20	139	143	147	151	156	160	164	168	173	177	181	185	190
25	138	141	145	149	153	157	161	164	168	172	176	180	184
30	137	140	144	147	150	154	157	161	164	167	171	174	178
35	136	139	142	145	148	151	154	157	160	163	166	169	172

Raport anc. 1: 3

Values of C (cm) for L



-35°C to 35°C	100	150	200	250	300	350	400	450	500	550	600	650	700
-35	54	80	107	134	161	187	214	241	268	295	321	348	375
-30	51	77	102	128	153	179	204	230	255	281	306	332	357
-25	48	73	97	121	145	170	194	218	242	266	291	315	339
-20	46	69	92	115	138	161	184	207	230	252	275	298	321
-15	43	65	87	108	130	152	173	195	217	238	260	282	303
-10	41	61	82	102	122	143	163	184	204	224	245	265	286
-5	38	57	77	96	115	134	153	172	191	210	230	249	268
0	36	54	71	89	107	125	143	161	179	196	214	232	250
5	33	50	66	83	99	116	133	149	166	182	199	215	232
10	31	46	61	77	92	107	122	138	153	168	184	199	214
15	28	42	56	70	84	98	112	126	140	154	168	182	196
20	26	38	51	64	77	89	102	115	128	140	153	166	179
25	23	34	46	57	69	80	92	103	115	126	138	149	161
30	20	31	41	51	61	71	82	92	102	112	122	133	143
35	18	27	36	45	54	62	71	80	89	98	107	116	125

REGLAJUL CONTRAGREUTATILOR
BALANCE WEIGHT SETTINGS

Numele fisierului/
CAD file name:
01LC00BDG053

Scara/ Scale:	Part	Rev.
	1 / 1	0

	L			
	350	600	1000	1500
FROM HE 200 TO HE240	101	102	103	104
FROM HE 260 TO HE320	201	202	203	204

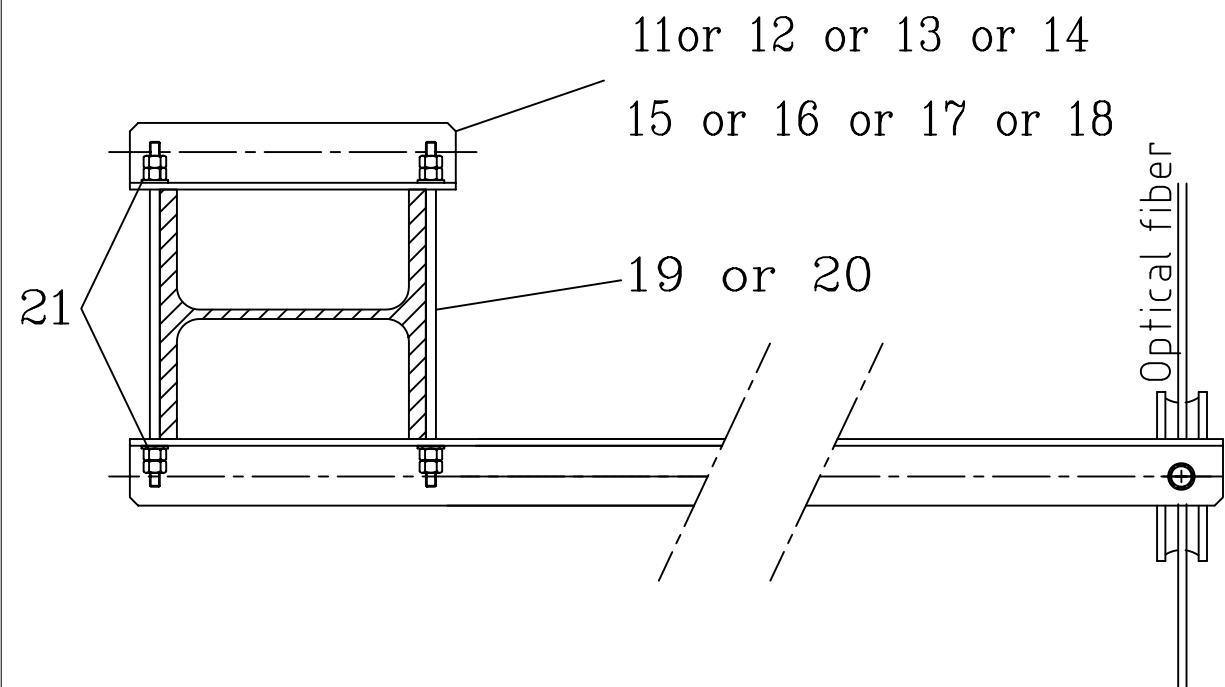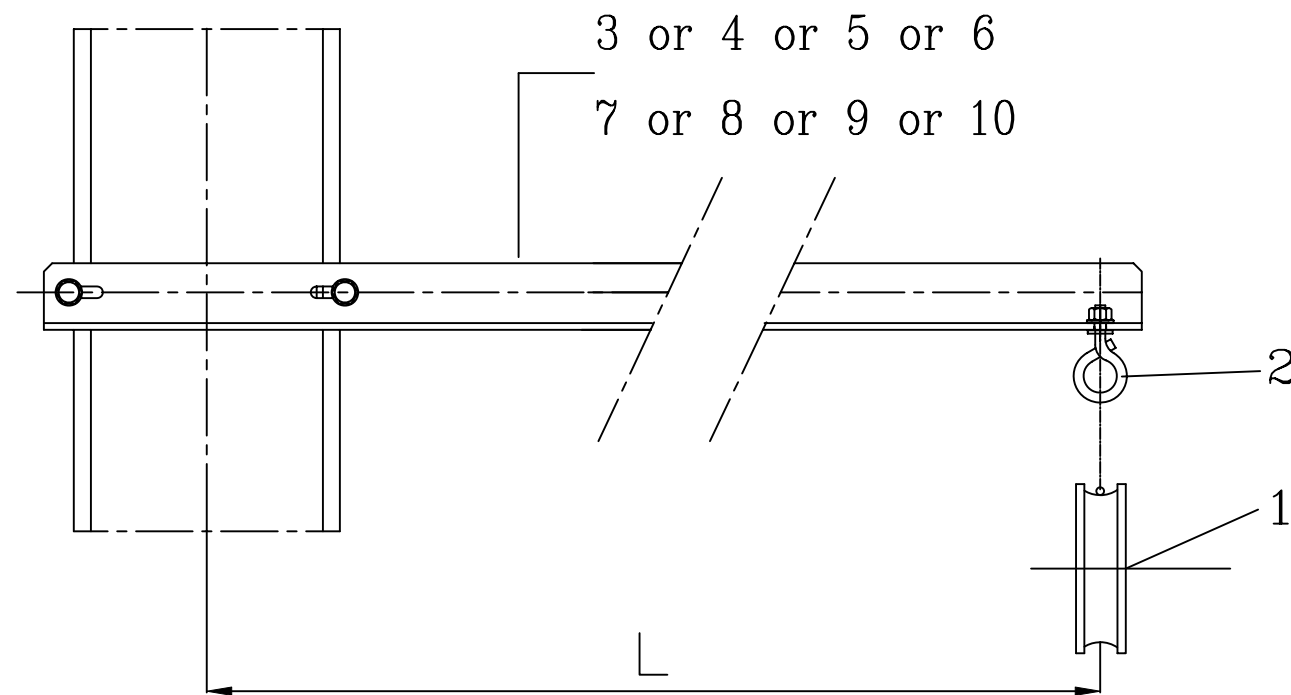



MARK GROUP	QUANTITY	ITEM	DESIGNATION	UNIT MASS kg	REFERENCE DRAWING	MARK
204	4	21	WASHER M12		01LC00BDG142	12A110
203	2	20	THREADED ROD M12-400/100		01LC00BDG141	1211D2
202	2	19	THREADED ROD M12-350/100		01LC00BDG141	1211C2
201	1	18	COUNTERPLATE FOR OPTICAL FIBER	3.85	01LC00BDG087	204
104	1	17	COUNTERPLATE FOR OPTICAL FIBER	1.78	01LC00BDG087	203
103	1	16	COUNTERPLATE FOR OPTICAL FIBER	0.84	01LC00BDG087	202
102	1	15	COUNTERPLATE FOR OPTICAL FIBER	0.84	01LC00BDG087	201
101	1	14	COUNTERPLATE FOR OPTICAL FIBER	3.08	01LC00BDG087	104
	1	13	COUNTERPLATE FOR OPTICAL FIBER	1.43	01LC00BDG087	103
	1	12	COUNTERPLATE FOR OPTICAL FIBER	0.67	01LC00BDG087	102
	1	11	COUNTERPLATE FOR OPTICAL FIBER	0.67	01LC00BDG087	101
	1	10	SUPPORT FOR OPTICAL FIBER L=1500	16.37	01LC00BDG086	204
	1	9	SUPPORT FOR OPTICAL FIBER L=1000	5.36	01LC00BDG086	203
	1	8	SUPPORT FOR OPTICAL FIBER L=600	1.68	01LC00BDG086	202
	1	7	SUPPORT FOR OPTICAL FIBER L=350	1.15	01LC00BDG086	201
	1	6	SUPPORT FOR OPTICAL FIBER L=1500	15.98	01LC00BDG086	104
	1	5	SUPPORT FOR OPTICAL FIBER L=1000	5.18	01LC00BDG086	103
	1	4	SUPPORT FOR OPTICAL FIBER L=600	1.59	01LC00BDG086	102
	1	3	SUPPORT FOR OPTICAL FIBER L=350	1.07	01LC00BDG086	101
	1	2	PULLEY SUPPORT RING (TYPE A)	0.24	ELC/CF0 3-15.0 B	
	1	1	PULLEY ASSEMBLY (TYPE R)		BE-F' 13252	

SUPORT PENTRU FIBRA OPTICA
OPTICAL FIBER BRACKET

Numele fisierului/
CAD file name:
01LC00BDG054

Scala/ Scale:	Part	Rev.
	1 / 1	0

	L		
	410	600	1000
FROM HE 200 TO HE240	111	112	113
FROM HE 260 TO HE320	211	212	213

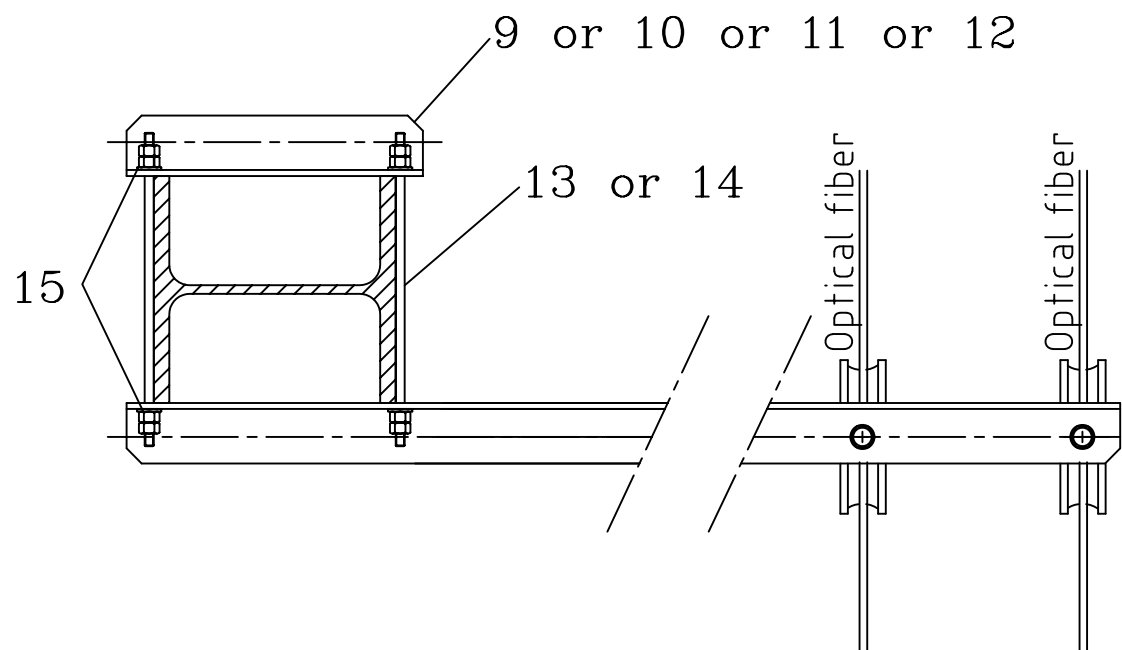
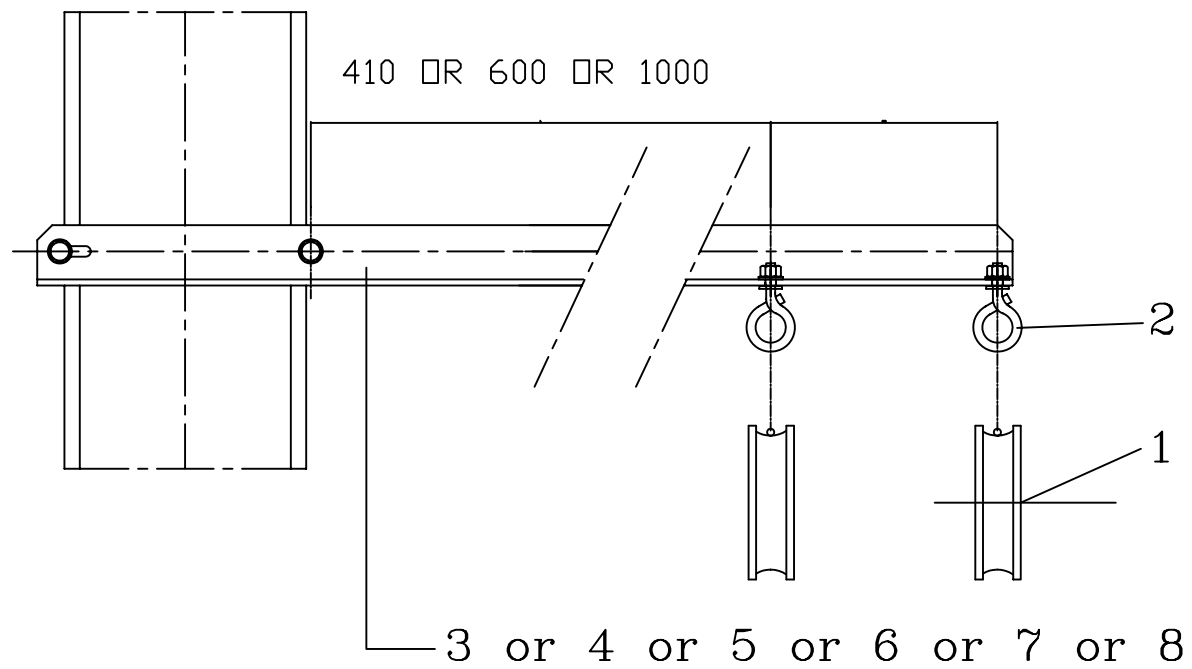


MARK GROUP	QUANTITY	ITEM	DESIGNATION	UNIT MASS	REFERENCE DRAWING	MARK
213	4	15	WASHER M12		01LC00BDG142	12A110
212	4	14	THREADED ROD M12-400/100		01LC00BDG141	1211D2
211	4	13	THREADED ROD M12-350/100		01LC00BDG141	1211C2
113	2	12	COUNTERPLATE FOR TWO OPTICAL FIBERS	0.84	01LC00BDG087	204
112	2	11	COUNTERPLATE FOR TWO OPTICAL FIBERS	0.84	01LC00BDG087	203
111	2	10	COUNTERPLATE FOR TWO OPTICAL FIBERS	0.67	01LC00BDG087	104
	1	9	COUNTERPLATE FOR TWO OPTICAL FIBERS	0.67	01LC00BDG087	103
	1	8	SUPPORT FOR TWO OPTICAL FIBERS L=1000	16.1	01LC00BDG106	213
	1	7	SUPPORT FOR TWO OPTICAL FIBERS L=600	12.24	01LC00BDG106	212
	1	6	SUPPORT FOR TWO OPTICAL FIBERS L=410	5.86	01LC00BDG106	211
	1	5	SUPPORT FOR TWO OPTICAL FIBERS L=1000	15.39	01LC00BDG106	113
	1	4	SUPPORT FOR TWO OPTICAL FIBERS L=600	11.54	01LC00BDG106	112
	1	3	SUPPORT FOR TWO OPTICAL FIBERS L=410	5.46	01LC00BDG106	111
	2	2	PULLEY SUPPORT RING (TYPE A)	0.24	ELC/CF0 3-15.0 B	
	2	1	PULLEY ASSEMBLY (TYPE R)		BE-F' 13252	

SUPORT PENTRU DOUA FIBRE OPTICE
BRACKET FOR TWO OPTICAL FIBRES

Numele fisierului/ CAD file name:	Scara/ Scale:	Part	Rev.
01LC00BDG055		1 / 1	0

FROM HE 200 TO HE240	121
FROM HE 260 TO HE320	221

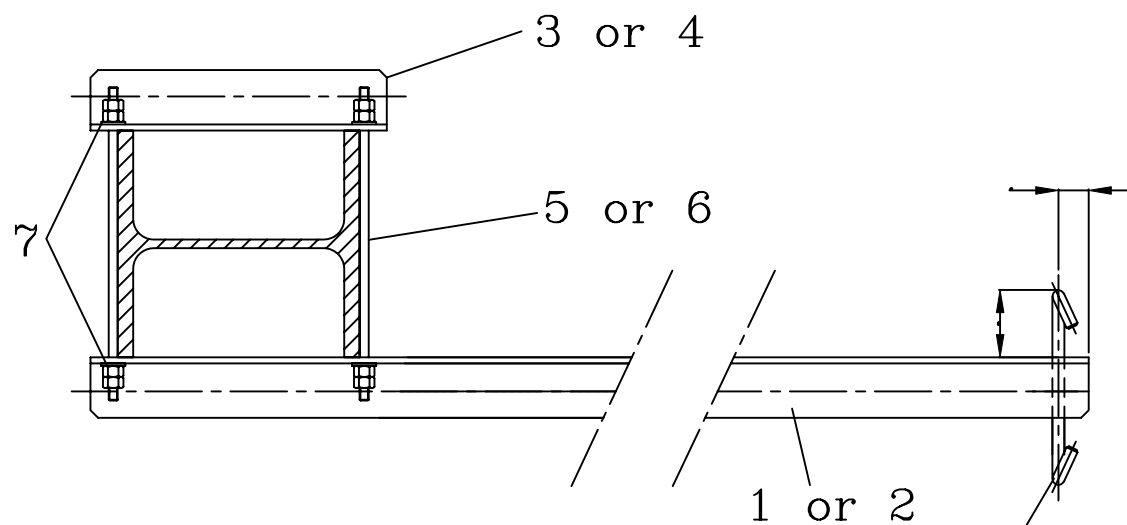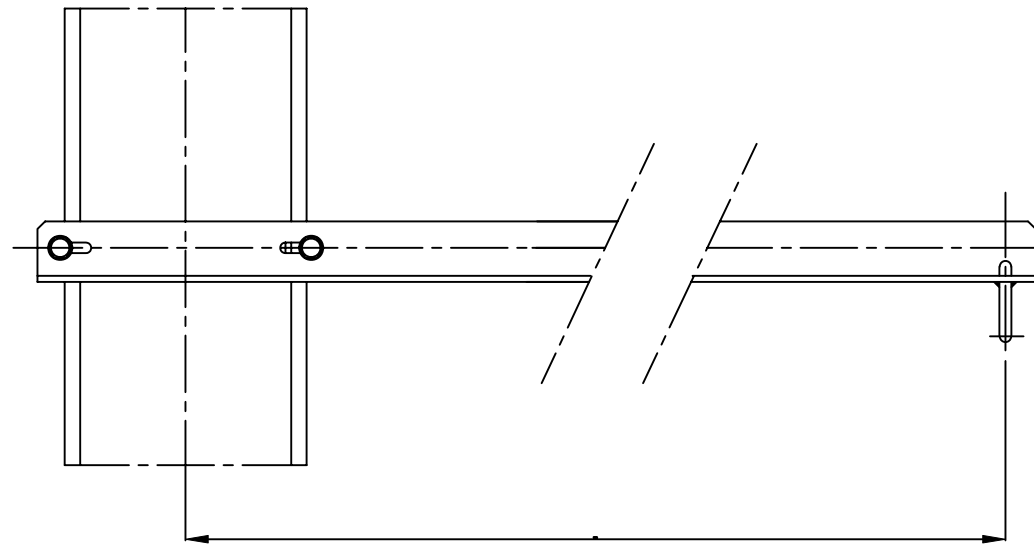

SEE DRAWING: ELC/CF0 2-1.2

MARK GROUP	QUANTITY			DESIGNATION	UNIT MASS	REFERENCE DRAWING	MARK
	221	121	ITEM				
	4	4	7	WASHER M16	0.03	01LC00BDG142	16A110
	2		6	THREADED ROD M16-400/100		01LC00BDG141	1611D2
		2	5	THREADED ROD M16-350/100		01LC00BDG141	1611C2
	1		4	COUNTERPLATE FOR OPTICAL FIBER ANCHORING	3.94	01LC00BDG113	221
	1		3	COUNTERPLATE FOR OPTICAL FIBER ANCHORING	3.17	01LC00BDG113	121
	1		2	SUPPORT FOR OPTICAL FIBER ANCHORING	7.17	01LC00BDG107	221
		1	1	SUPPORT FOR OPTICAL FIBER ANCHORING	6.78	01LC00BDG107	121

SUPORT PENTRU ANCORAREA FIBRAEI OPTICE
OPTICAL FIBER BRACKET ANCHORING

Numele fisierului/
CAD file name:
01LC00BDG056

Scara/
Scale:


Part

Rev.

1 / 1


0

FOR MOUNTING,SEE DRAWING TYPICAL CATENARY EQUIPMENT

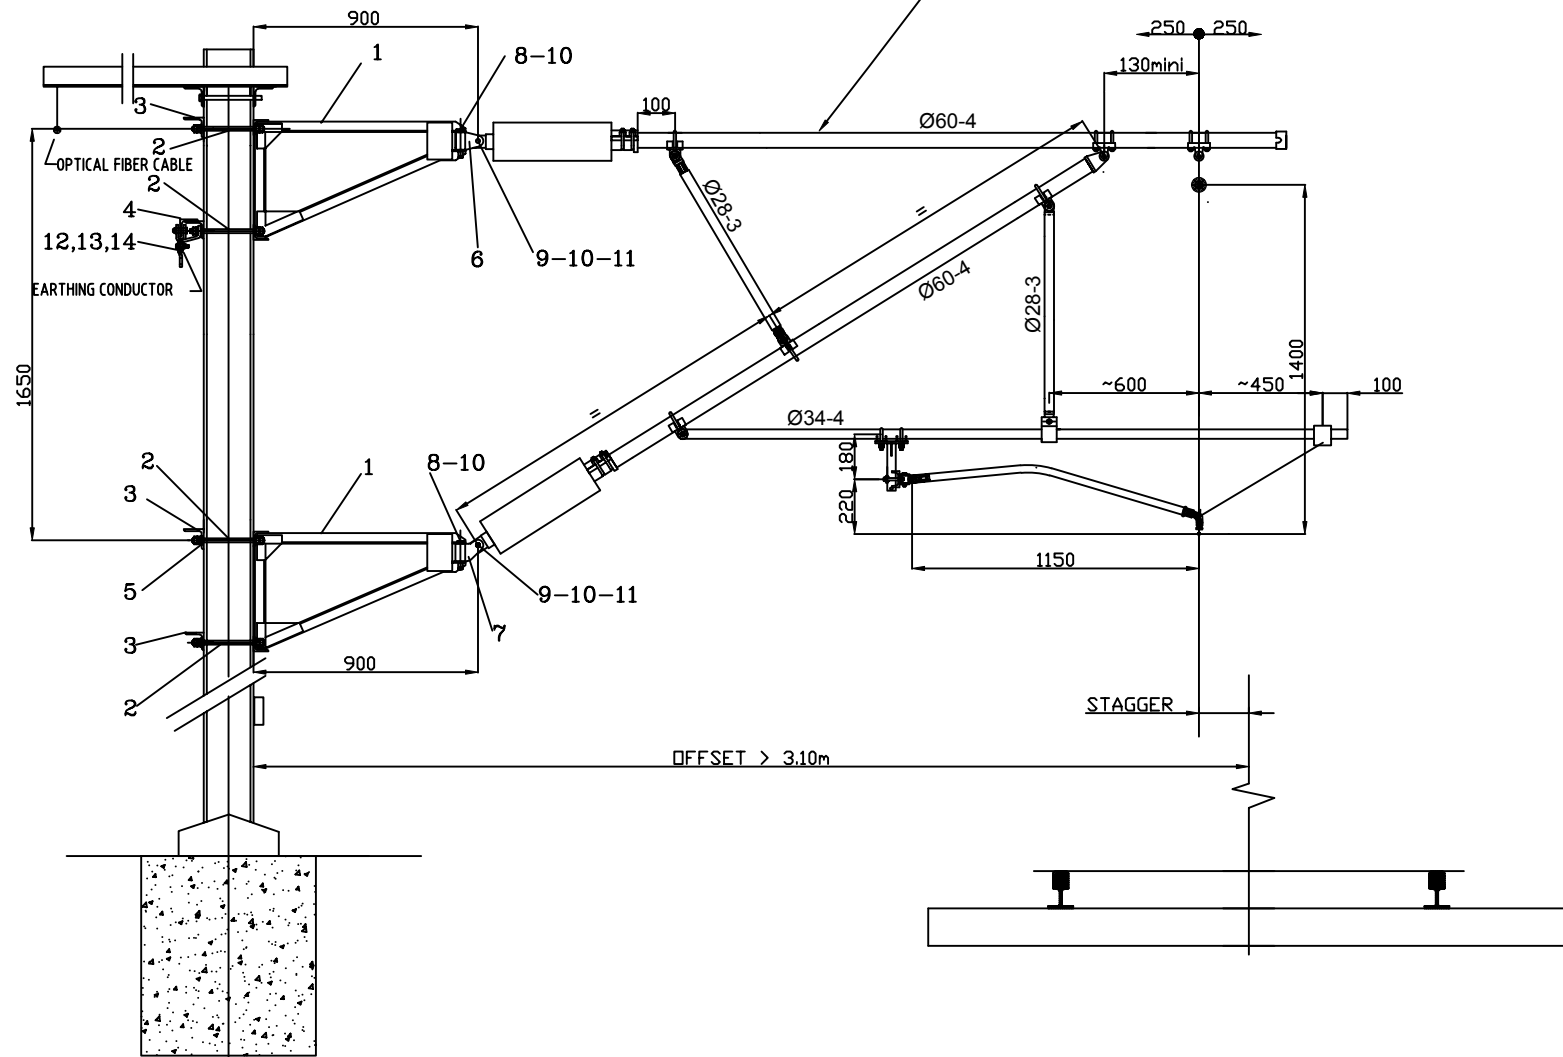

MARK.GROUP	101	102	ITEM	DESIGNATION	REFERENCE DRAWING	MARK
QUANTITY		1	18	COUNTERPLATE WITH EARTHING CABLE	01LC00BDG102	102
		3	17	COUNTERPLATE	01LC00BDG090	102
		8	16	TRHEADED ROD M16 450/100	01LC00BDG141	1611E2
		2	15	FASTENING FOR TOP AND STRUT TUBE L=900	01LC00BDG120	102
		1	14	CLAMP FOR EARTHING CABLE	ELC 2-4.0	
		1	13	CONNECTING ROD L=400	STAS 438/1-89	
		1	12	SUSPENSION TYPE I	ELC 13-1.4.0	
		2	11	WASHER M18	SR EN 7089/4-2002	
		4	10	PIN 4.5-40	SR EN 1234-2001	
		2	9	AXIS. 18-50	SR EN 22341-2001	
		2	8	AXIS. 18-110	SR EN 22341-2001	
		1	7	HINGE STRUT TUBE	ELC 13-9-11 A	
		1	6	HINGE TOP TUBE	ELC 13-9-11 A	
		16	5	WASHER M16	01LC00BDG142	16A110
		1	4	COUNTERPLATE WITH EARTHING CABLE	01LC00BDG102	101
		3	3	COUNTERPLATE	01LC00BDG090	101
	8	2	TRHEADED ROD M16 400/100	01LC00BDG141	1611D2	
	2	1	FASTENING FOR TOP AND STRUT TUBE L=900	01LC00BDG120	101	

FIXARE PENTRU TIRANT SI CONTRAFISA CU GABARITUL STALPULUI>3.1m FASTENING FOR TOP AND STRUT TUBE WITH OFFSET>3.1m	Numele fisierului/ CAD file name:	Scara/ Scale:	Part	Rev.
	01LC00BDG057		1 / 3	0

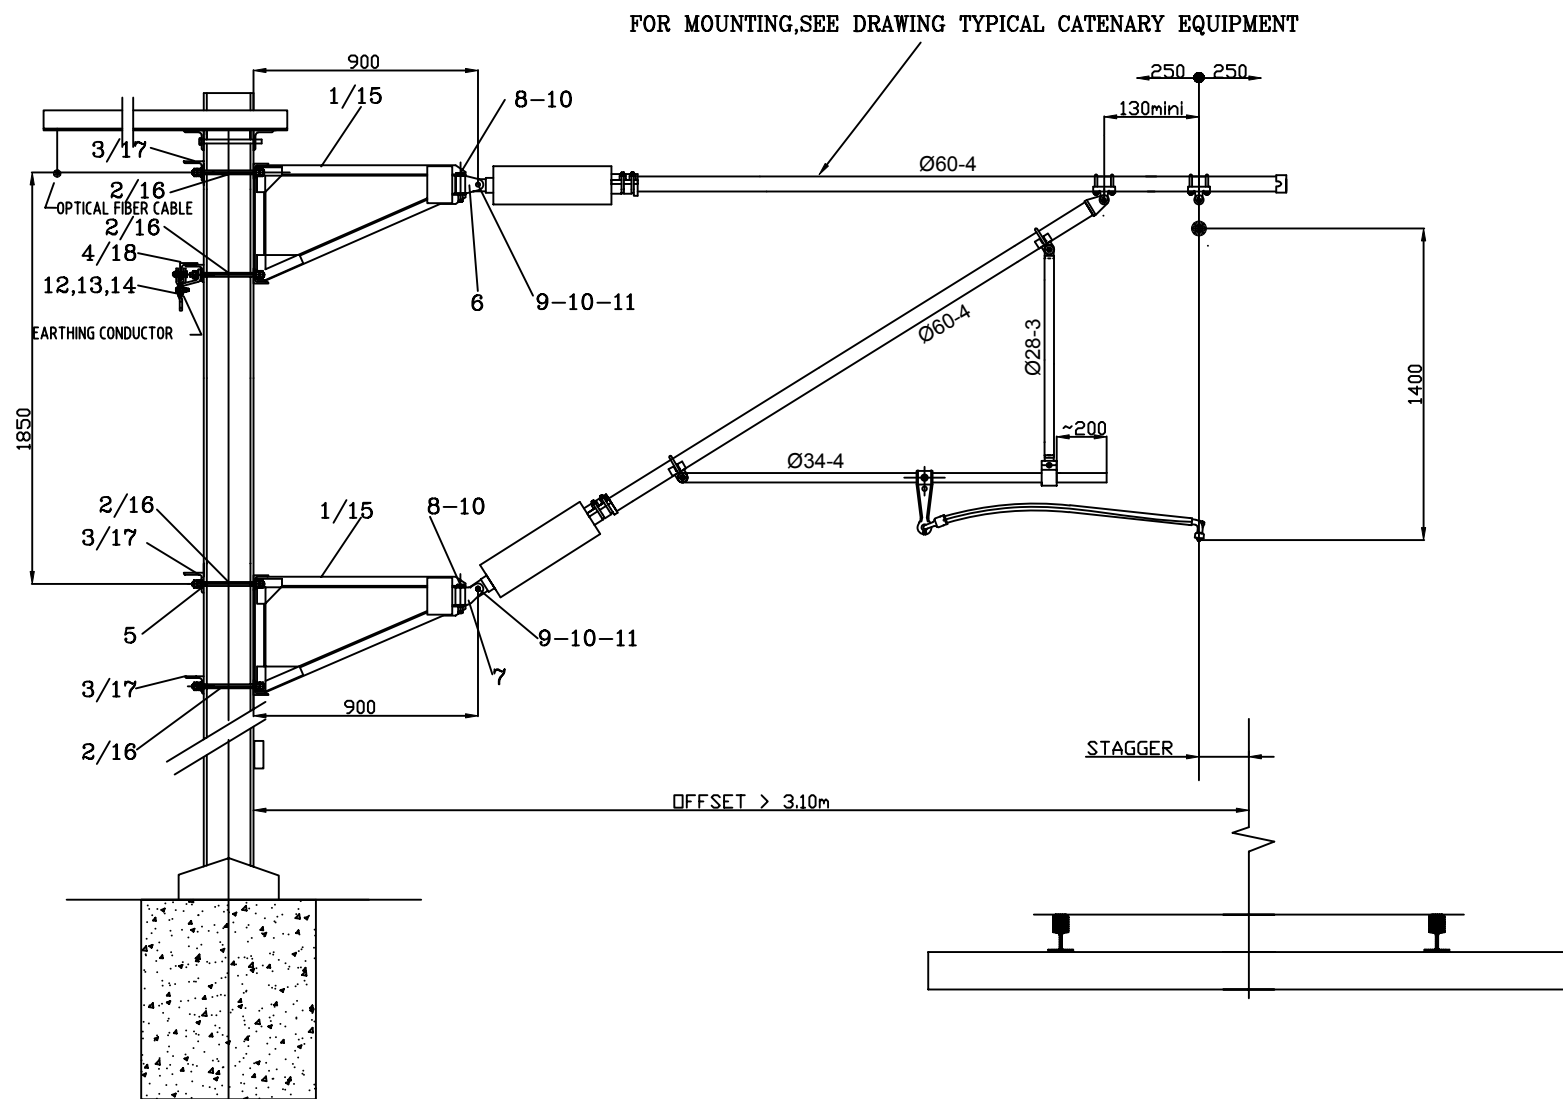


MARK GROUP	QUANTITY	ITEM	DESIGNATION	REFERENCE DRAWING	MARK
	1	18	COUNTERPLATE WITH EARTHING CABLE	01LC00BDG102	102
	3	17	COUNTERPLATE	01LC00BDG090	102
	8	16	TRHEADED ROD M16 450/100	01LC00BDG141	1611E2
	2	15	FASTENING FOR TOP AND STRUT TUBE L=900	01LC00BDG120	102
	1	14	CLAMP FOR EARTHING CABLE	ELC 2-4.0	
	1	13	CONNECTING ROD L=400	STAS 438/1-89	
	1	12	SUSPENSION TYPE I	ELC 13-1.4.0	
	2	11	WASHER M18	SR EN 7089/4-2002	
	4	10	PIN 4.5-40	SR EN 1234-2001	
	2	9	AXIS. 18-50	SR EN 22341-2001	
	2	8	AXIS. 18-110	SR EN 22341-2001	
	1	7	HINGE STRUT TUBE	ELC 13-9-11 A	
	1	6	HINGE TOP TUBE	ELC 13-9-11 A	
	16	5	WASHER M16	01LC00BDG142	16A110
	1	4	COUNTERPLATE WITH EARTHING CABLE	01LC00BDG102	101
	3	3	COUNTERPLATE	01LC00BDG090	101
	8	2	TRHEADED ROD M16 400/100	01LC00BDG141	1611D2
	2	1	FASTENING FOR TOP AND STRUT TUBE L=900	01LC00BDG120	101
	101				
	102				
		ITEM	DESIGNATION	REFERENCE DRAWING	MARK


FIXARE PENTRU TIRANT SI CONTRAFISA CU GABARITUL STALPULUI>3.1m
FASTENING FOR TOP AND STRUT TUBE WITH OFFSET>3.1m

Numele fisierului/ CAD file name:	Scara/ Scale:	Part	Rev.
01LC00BDG057		3 / 3	0

MARK	DESIGNATION
101	FROM HE 200 TO 240
102	FROM HE 260 TO 320

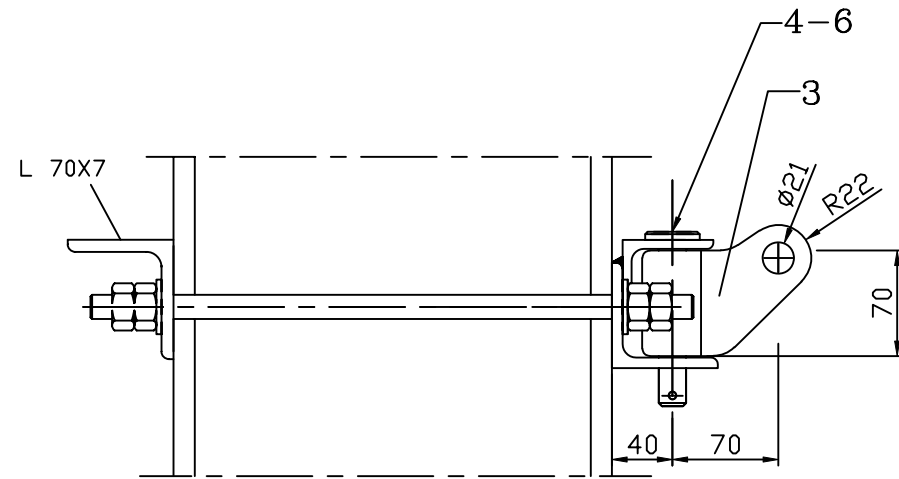


MARK.GROUP	QUANTITY	ITEM	DESIGNATION	UNIT MASS	REFERENCE DRAWING	MARK
102	1	12	COUNTERPLATE		01LC00BDG090	102
101	1	11	HINGE SUPPORT		01LC00BDG088	102
	2	10	THREADED ROD M16- 350/100		01LC00BDG141	1611C2
	2	9	THREADED ROD M16- 450/100		01LC00BDG141	1611E2
	1	8	COUNTERPLATE		01LC00BDG090	101
	1	7	AXIS 20-50		01LC00BDG146	201050
	2	6	PIN. 4,5*40		01LC00BDG145	45A040
	1	5	WASHER M20		01LC00BDG142	20A110
	1	4	AXIS . 18*110		01LC00BDG146	181110
	1	3	HINGE STRUT TUBE	0.78	ELC 13-9-11 A rev. C	...
	4	2	WASHER M16N		01LC00BDG141	16A110
	1	1	HINGE SUPPORT		01LC00BDG088	101

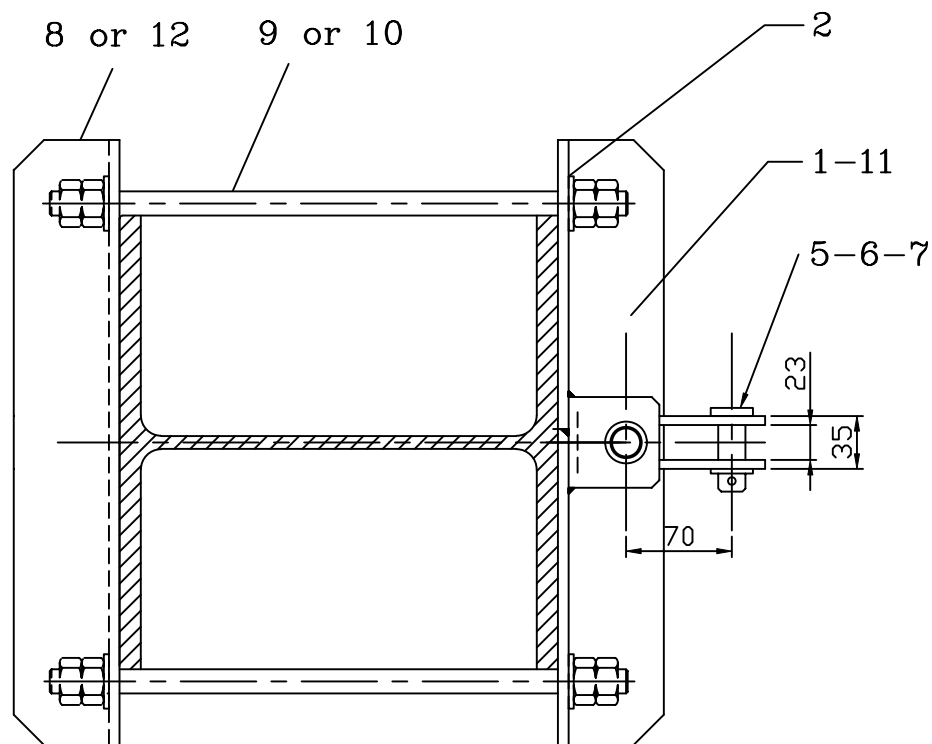


FIXARE PENTRU CONTRAFISA
FASTERNING FOR STRUT TUBE

Numele fisierului/ CAD file name:	Scara/ Scale:	Part	Rev.
01LC00BDG058		1 / 1	0

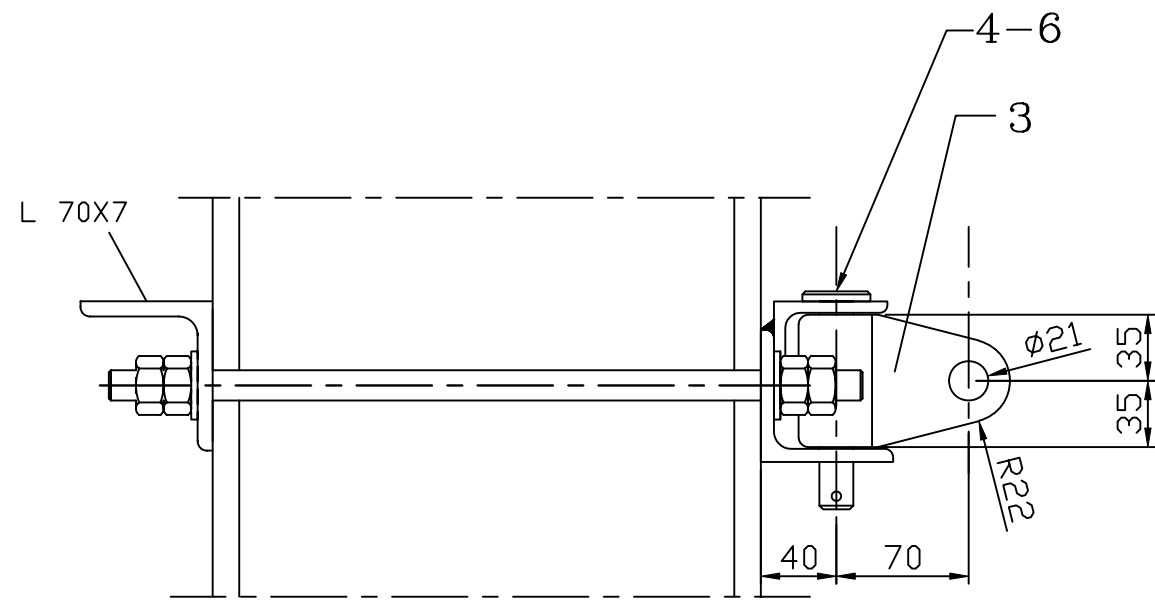


MARK	DESIGNATION
101	FROM HE 200 TO 240
102	FROM HE 260 TO 320

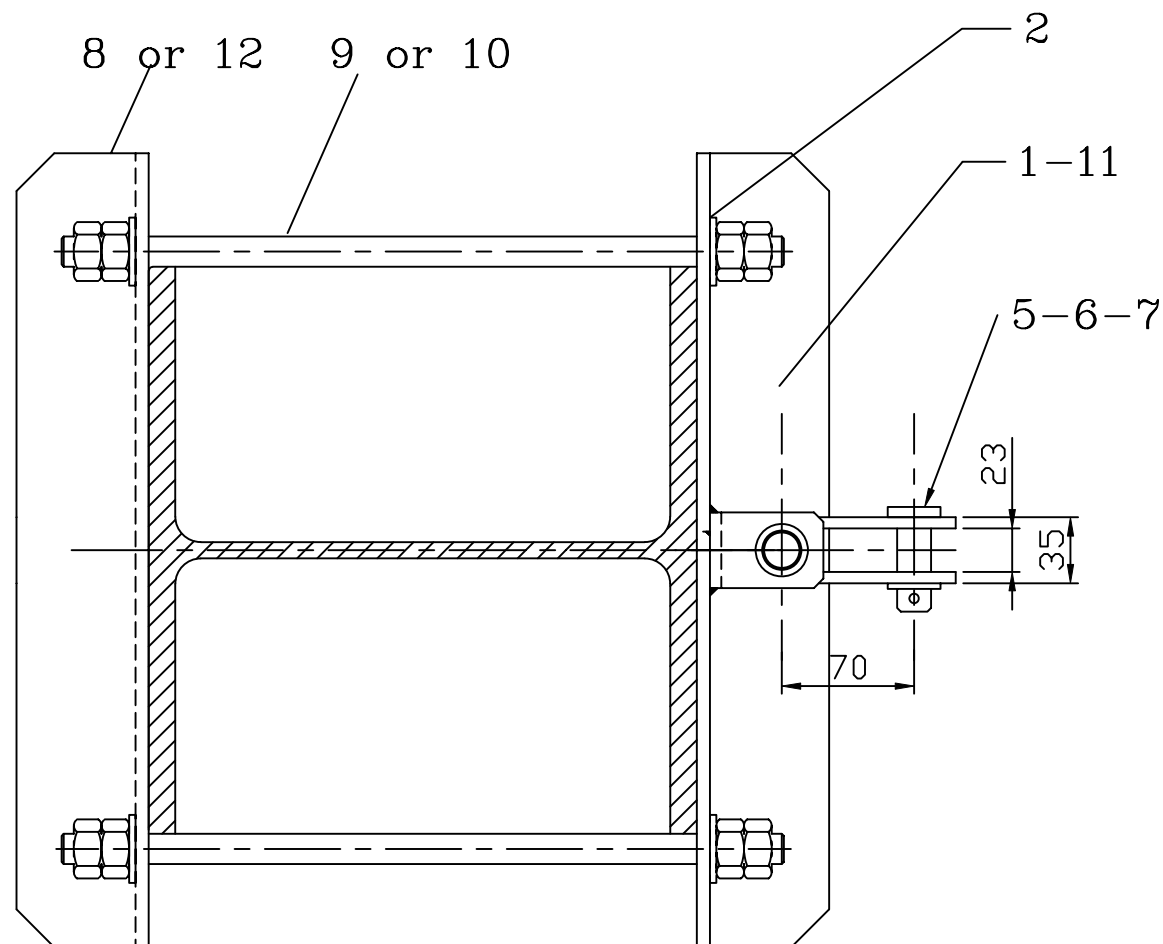


MARK GROUP	QUANTITY	ITEM	DESIGNATION	UNIT MASS	REFERENCE DRAWING	MARK
	1	12	COUNTERPLATE		01LC00BDG090	102
	1	11	HINGE SUPPORT		01LC00BDG088	102
	2	10	THREADED ROD M16- 350/100		01LC00BDG141	1611C2
	2	9	THREADED ROD M16- 450/100		01LC00BDG141	1611E2
	1	8	COUNTERPLATE		01LC00BDG090	101
	1	7	AXIS 20-50		01LC00BDG146	201050
	2	6	PIN. 4,5*40		01LC00BDG145	45A040
	1	5	WASHER M20		01LC00BDG142	20A110
	1	4	AXIS . 18*110		01LC00BDG146	181110
	1	3	HINGE TOP TUBE	0.74	E.L.C 13-9.10 A rev. C	...
	4	2	WASHER M16N		01LC00BDG142	16A110
	1	1	HINGE SUPPORT		01LC00BDG088	101

FIXARE PENTRU TIRANT FASTENING FOR TOP TUBE		Numele fisierului/ CAD file name:	Scara/ Scale:	Part	Rev.
		01LC00BDG059		1 / 1	0

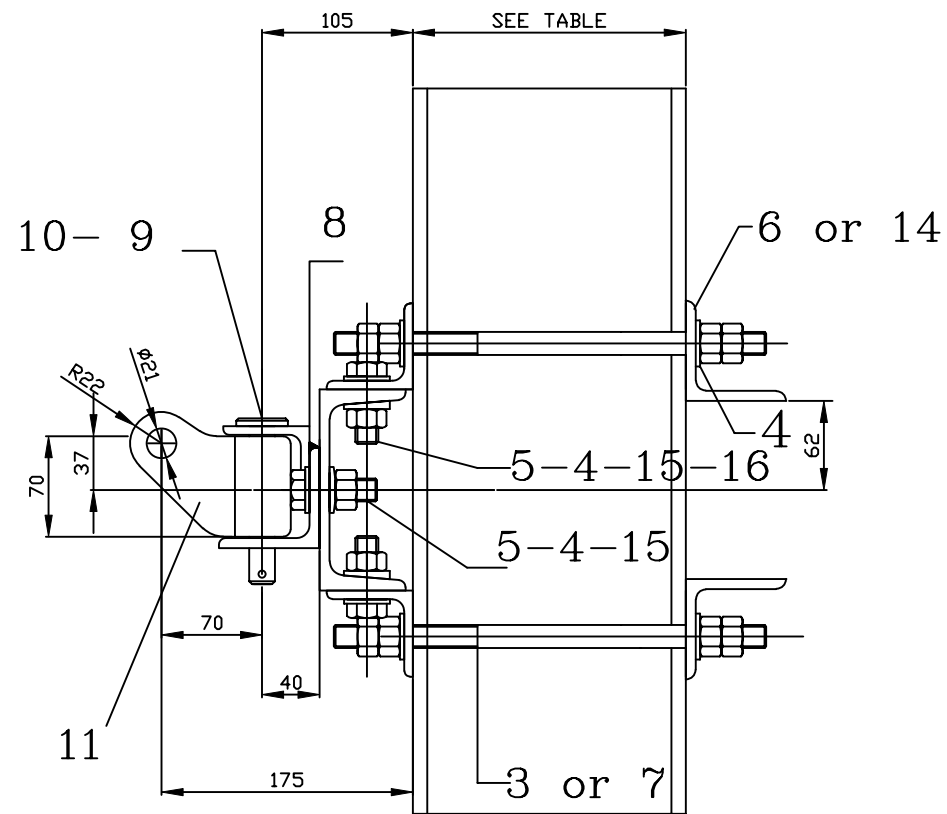



ON H BEAM	ASSEMBLY ALLOCATION	
	2 TOP TUBES SPACING 1.00 m	3 TOP TUBES SPACING 0.50 m
HE 200 TO 240	101	201
H 260 TO 320 (A OR B)	102	202

Note
For cotes a and b see the mounting diagrams.

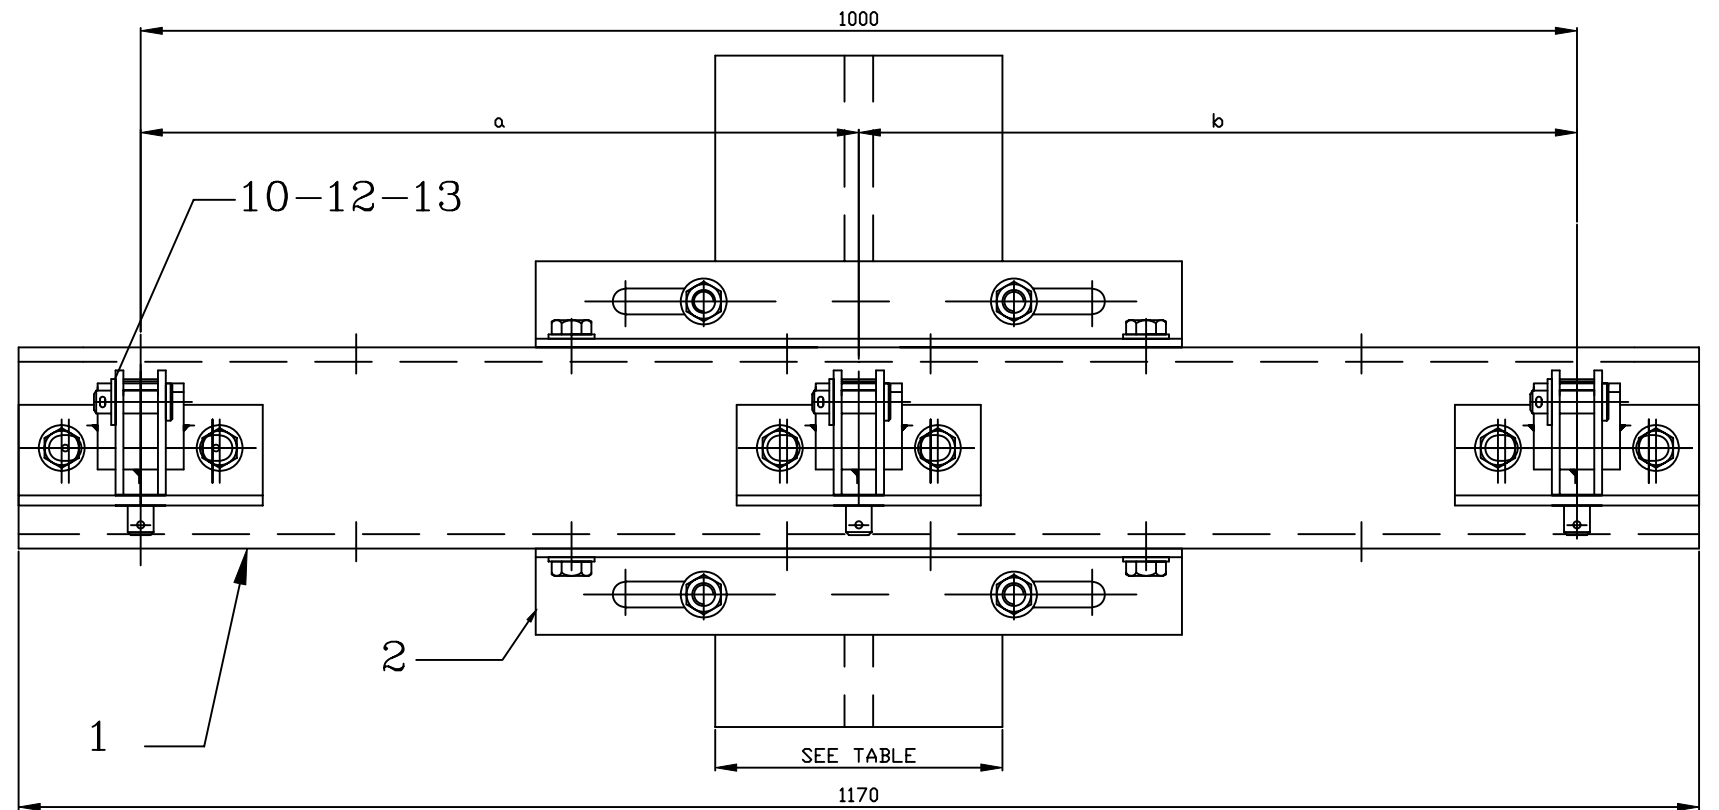

MARK GROUP	QUANTITY	QUANTITY	QUANTITY	QUANTITY	ITEM	DESIGNATION	UNIT MASS	REFERENCE DRAWING	MARK
	4	4	4	4	16	WASHER . TYPE U		01LC00BDG142	16A710
	10	10	8	8	15	WASHER . CS-16-32-2.8		01LC00BDG142	16A310
	2		2		14	COUNTERPLATE		01LC00BDG090	102
	3	3	2	2	13	AXIS 20-50		01LC00BDG146	201050
	3	3	2	2	12	WASHER M20		01LC00BDG142	20A110
	3	3	2	2	11	HINGE STRUT TUBE		E.L.C 13-9-11 A REV C	
	6	6	4	4	10	PIN 4.5*40		01LC00BDG145	45A040
	3	3	2	2	9	AXIS 18-110		01LC00BDG146	181110
	3	3	2	2	8	HINGE SUPPORT		01LC00BDG114	
	4		4		7	THREADED ROD M16-450/100		01LC00BDG141	1611E2
		2		2	6	COUNTERPLATE		01LC00BDG090	101
	10	10	8	8	5	BOLT HM 16-50/50		01LC00BDG114	1612H1
	18	18	16	16	4	WASHER M16N		01LC00BDG142	16A110
		4		4	3	THREADED ROD M16-350/100		01LC00BDG141	1611C2
	2	2	2	2	2	COUNTERPLATE FOR SPREADER		01LC00BDG094	
	1	1	1	1	1	SPREADER		01LC00BDG089	

TRAVERSA DE TRECERE PENTRU 2 SAU 3 CONTRAFISE (distanța 1m) SPREADER ASSEMBLY FOR 2 OR 3 STRUT TUBES (spacing 1m)	Numele fisierului/ CAD file name: 01LC00BDG060	Scara/ Scale:	Part	Rev.
			1 / 1	0

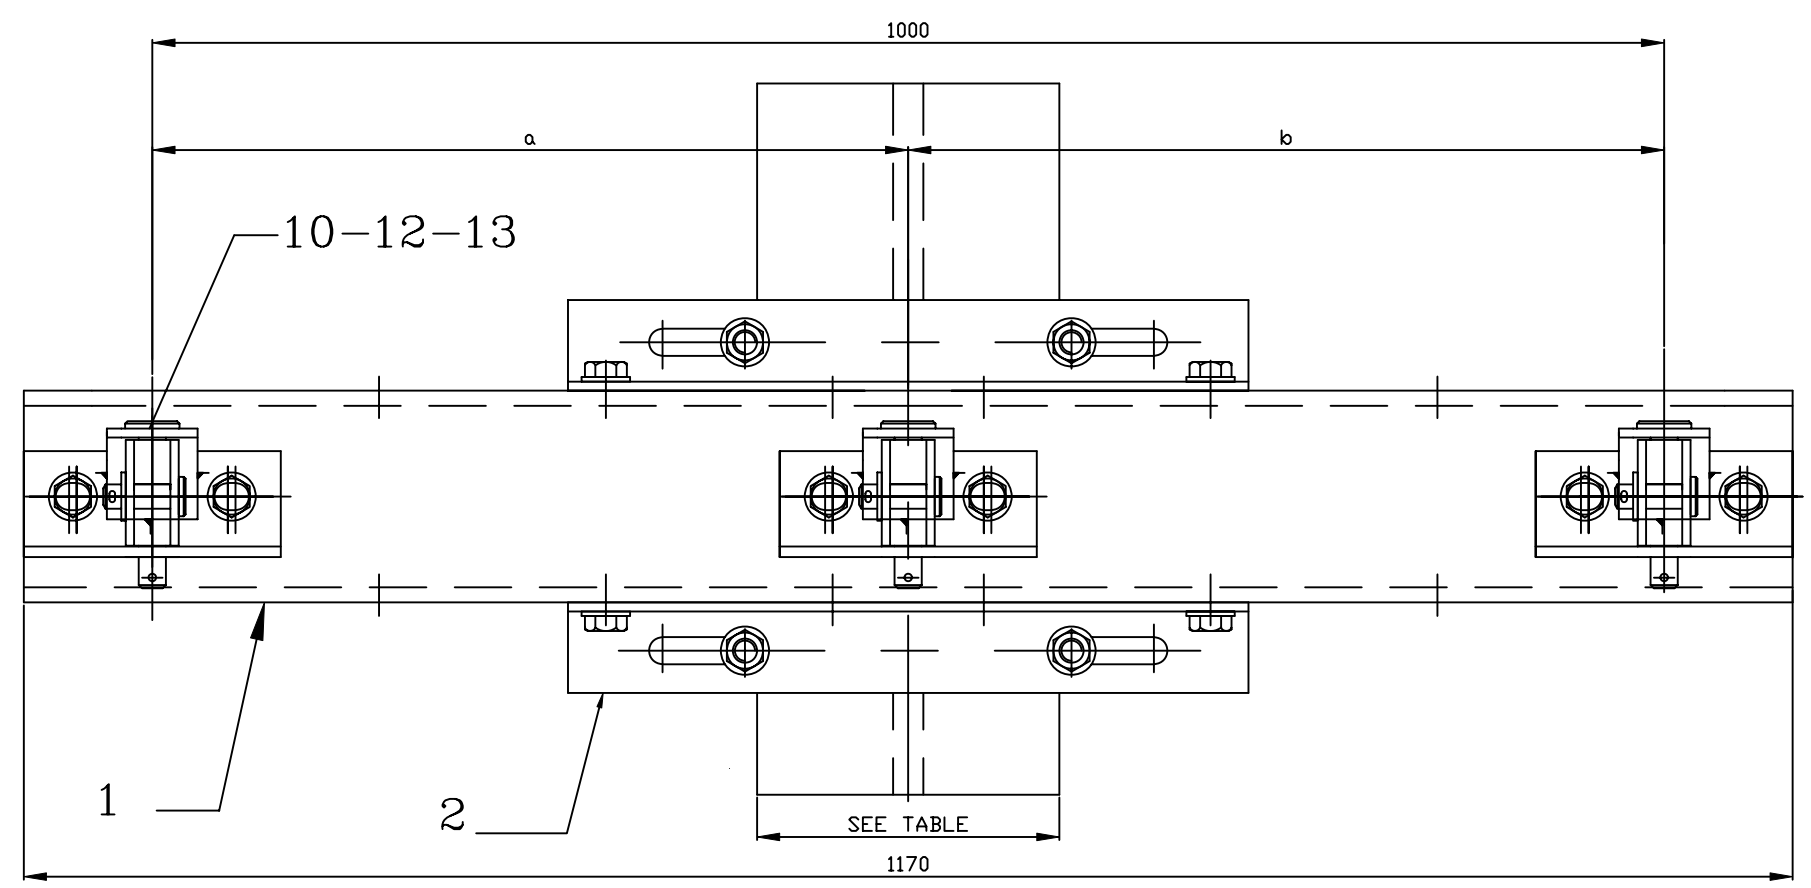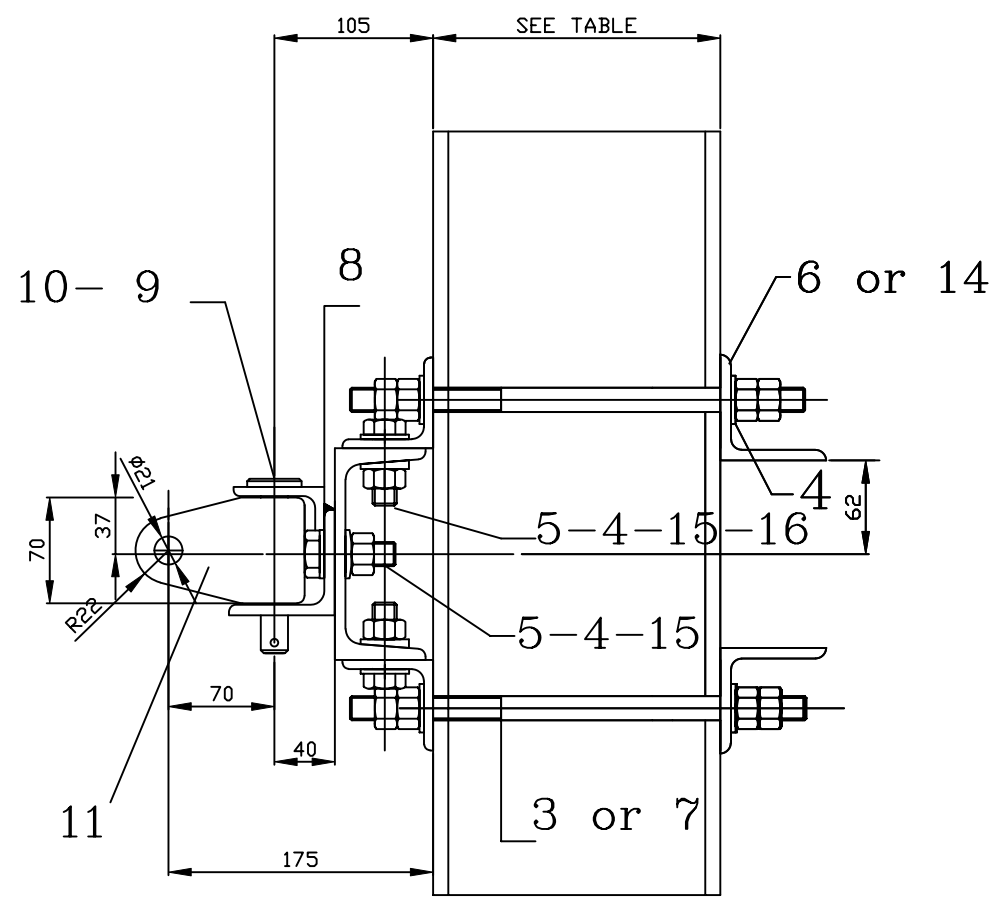


QUANTITY	4	4	4	4	16	WASHER TYPE U		01LC00BDG142	16A710
	10	10	8	8	15	WASHER . CS-16-32-2.8		01LC00BDG142	16A310
	2		2		14	COUNTERPLATE		01LC00BDG090	102
	3	3	2	2	13	AXIS 20-50		01LC00BDG146	201050
	3	3	2	2	12	WASHER M20		01LC00BDG142	20A110
	3	3	2	2	11	HINGE TOP TUBE		E.L.C 13-9-10 A REV C	
	6	6	4	4	10	PIN 4.5*40		01LC00BDG145	45A040
	3	3	2	2	9	AXIS 18-110		01LC00BDG146	181110
	3	3	2	2	8	HINGE SUPPORT		01LC00BDG114	
	4		4		7	THREADED ROD M16-450/100		01LC00BDG141	1611E2
		2		2	6	COUNTERPLATE		01LC00BDG090	101
	10	10	8	8	5	BOLT HM 16-50/50		01LC00BDG144	1612H1
	18	18	16	16	4	WASHER M16N		01LC00BDG142	16A110
		4		4	3	THREADED ROD M16 -350/100		01LC00BDG141	1611C2
2	2	2	2	2	COUNTERPLATE FOR SPREADER		01LC00BDG094		
1	1	1	1	1	SPREADER		01LC00BDG089		
MARK GROUP	202	201	102	101	ITEM	DESIGNATION	UNIT MASS	REFERENCE DRAWING	MARK
							kg		

Note
For cotes a and b see the mounting diagrams.

ON H BEAM	ASSEMBLY ALLOCATION	
	2 TOP TUBES SPACING 1.00 m	3 TOP TUBES SPACING 0.50 m
HE 200 TO 240	101	201
H 260 TO 320 (A OR B)	102	202


TRAVERSA DE TRECERE PENTRU 2 SAU 3 TIRANTI (distanța 1m) SPREADER ASSEMBLY FOR 2 OR 3 TOP TUBES (spacing 1m)	Numele fisierului/ CAD file name:	Scara/ Scale:	Part	Rev.
	01LC00BDG061		1 / 1	0

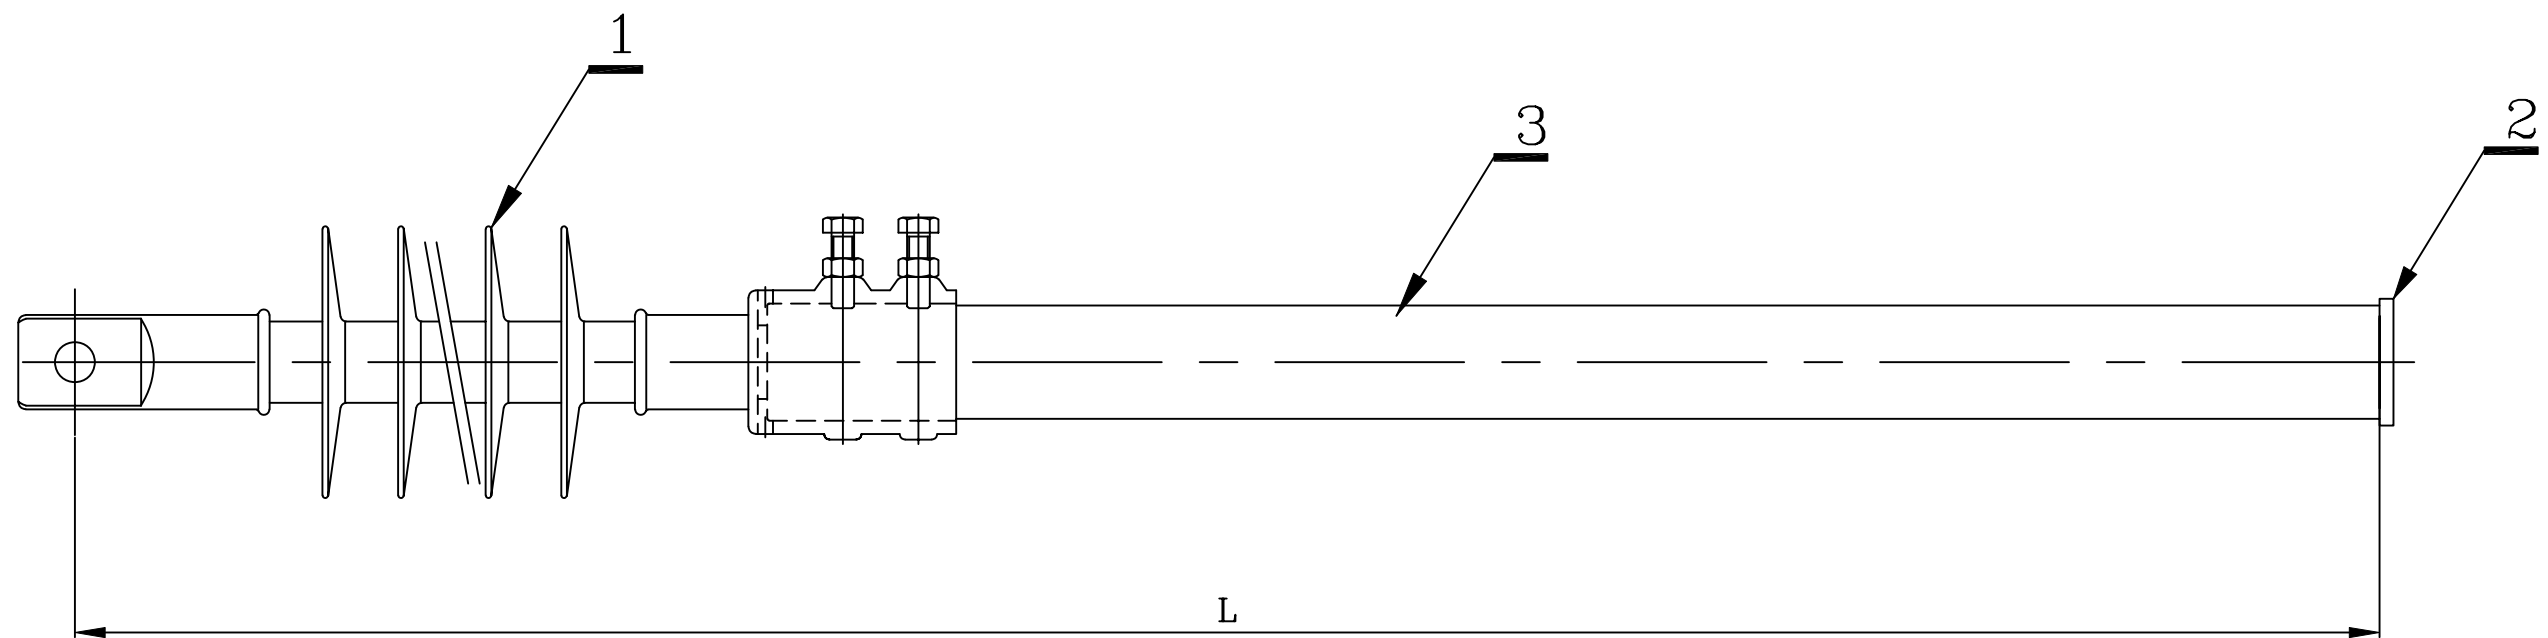

MARK GROUP QUANTITY	1	3	∅60-4 TUBE FOR TOP TUBE (LENGTH "L" SEE TABLE)		01LC00BDG095	
	1	2	END CAP FOR TOP TUBE		ELC 13-1.2.0	
	1	1	COMPOSITE INSULATOR FOR TOP TUBE		01LC00BDG019	
MARK GROUP SEE TABLE	ITEM	DESIGNATION	UNIT MASS kg	REFERENCE DRAWING	MARK	

* THE SCREW AND NUT ARE SUPPLIED WITH INSULATOR

TIRANT IZOLAT ∅ 60 INSULATED FOR TOP TUBE ∅ 60	Numele fisierului/ CAD file name:	Scara/ Scale:	Part	Rev.
	01LC00BDG064		1 / 1	0

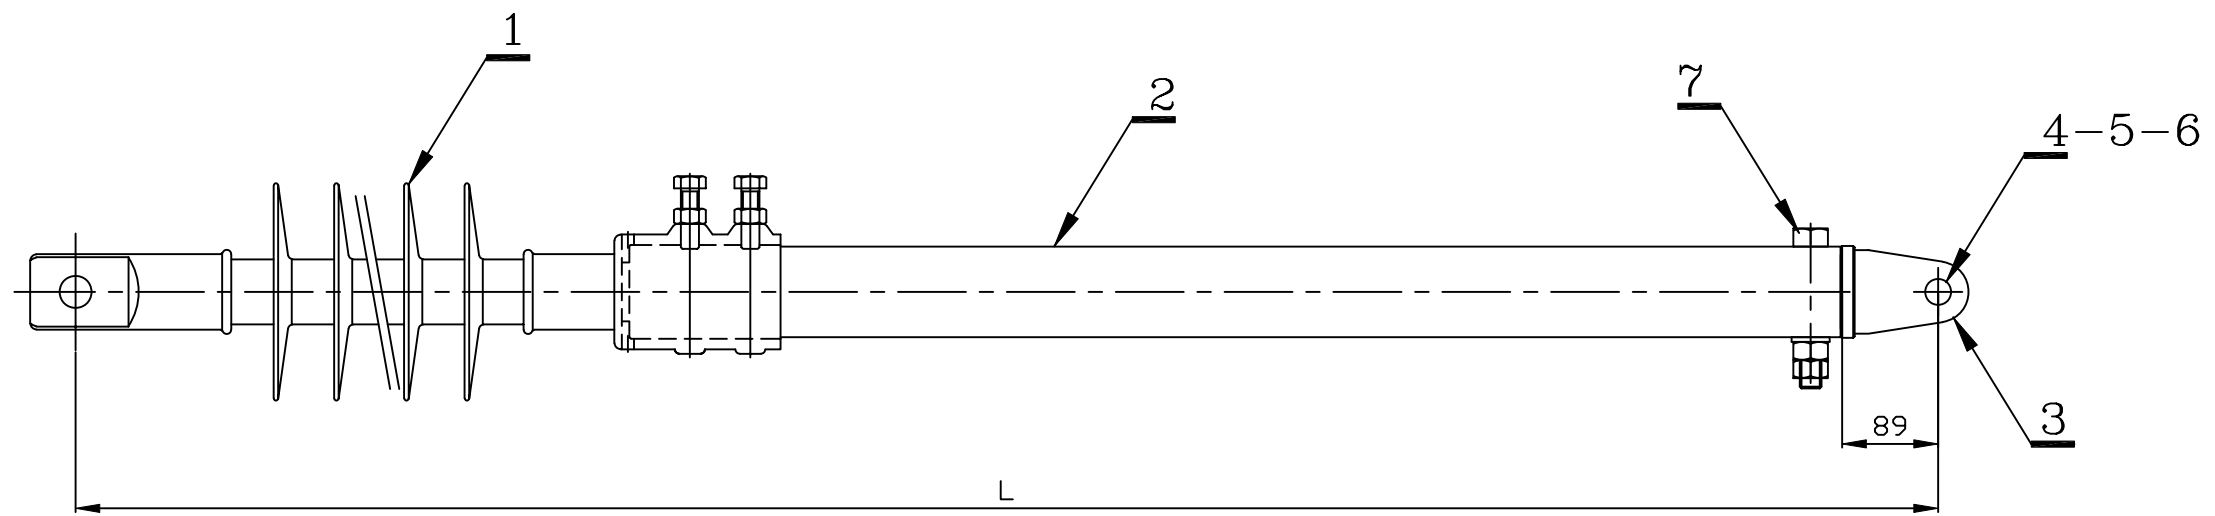

MARK GROUP	SEE TABLE	ITEM	DESIGNATION	UNIT MASS	REFERENCE DRAWING	MARK
QUANTITY	1	7	SCREW M12 x 90-gr 8-8		01LC00BDG144	1243T1
	1	6	PIN 4.5 x 40		01LC00BDG145	45A040
	1	5	WASHER T18		01LC00BDG142	18A110
	1	4	BOLT 18 x 50		01LC00BDG146	181050
	1	3	FASTENING ON TUBE Ø60		ELC 13-14.7.0 B	
	1	2	Ø60-4 TUBE FOR STRUT TUBE (LENGTH "L" SEE TABLE)		01LC00BDG101	
	1	1	COMPOSITE INSULATOR FOR TOP TUBE		01LC00BDG019	
			ASSEMBLY INCLUDING :			


* THE SCREW AND NUT ARE SUPPLIED WITH INSULATOR

CONTRAFISA IZOLATA Ø 60
INSULATED FOR STRUT TUBE Ø 60

Numele fisierului/
CAD file name:
01LC00BDG066

Scara/
Scale:

Part	Rev.
1 / 1	0

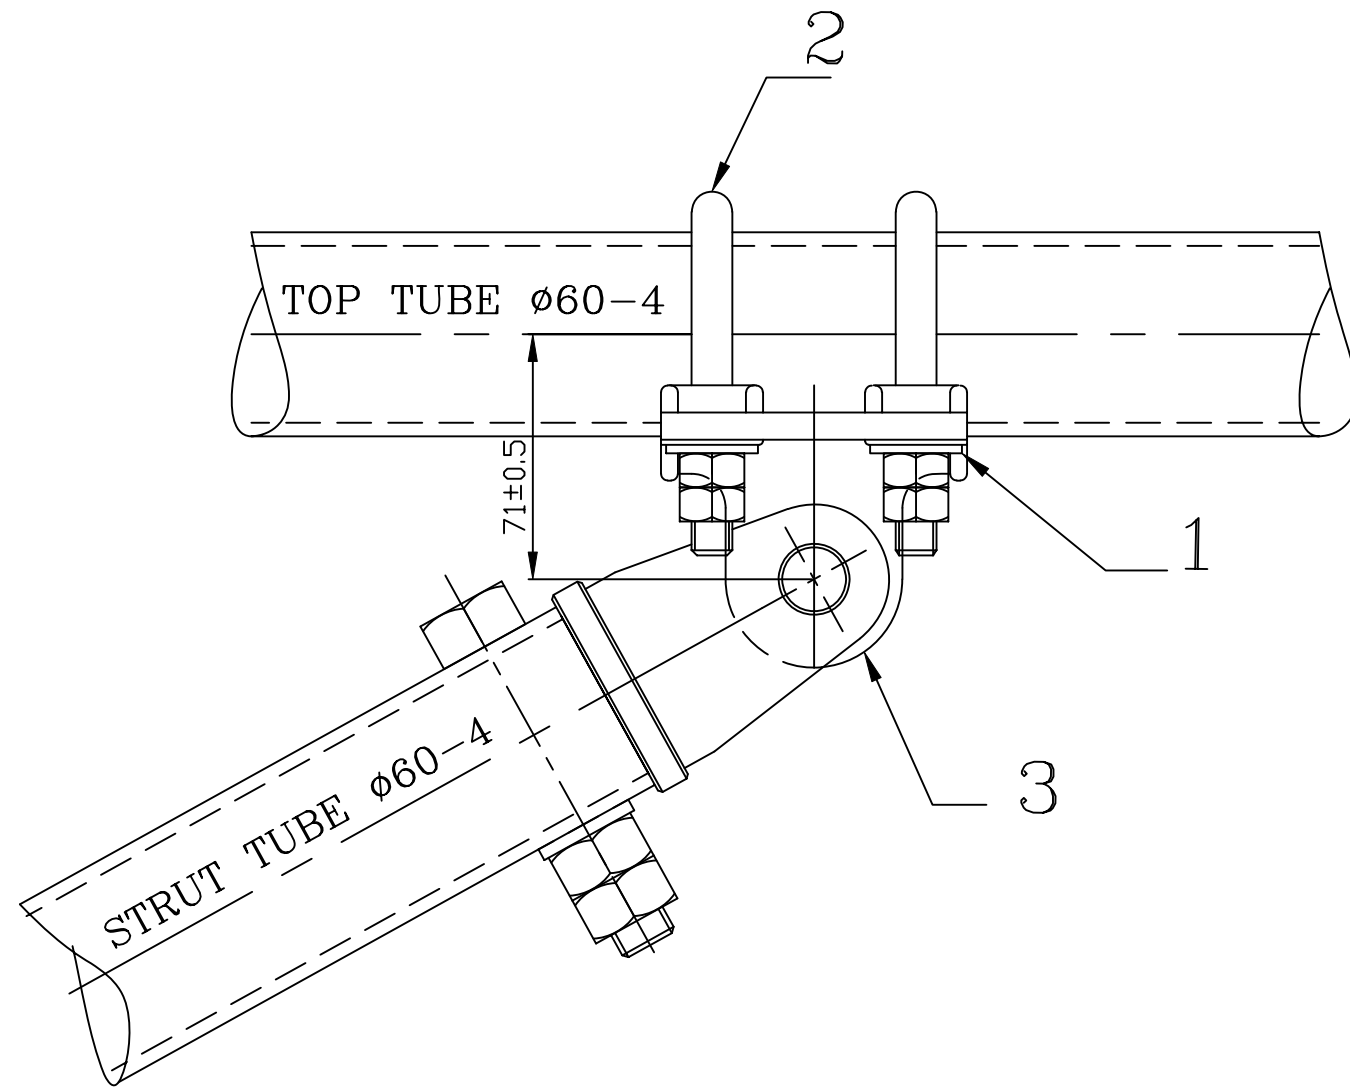


MARK GROUP	QUANTITY	ITEM	DESIGNATION	UNIT MASS	REFERENCE DRAWING	MARK
	1	3	FASTENING BETWEEN TUBES Ø60		ELC 13-13.1.B	
	2	2	U BOLT M 12		01LC00BDG143	122171
	4	1	WASHER M 12		01LC00BDG142	12B110
****				kg		

FIXARE PENTRU TIRANT FASTENING FOR TOP TUBE	Numele fisierului/ CAD file name:	Scara/ Scale:	Part	Rev.
	01LC00BDG069		1 / 1	0


ASSEMBLY WITHOUT MID POINT ANCHOR

101

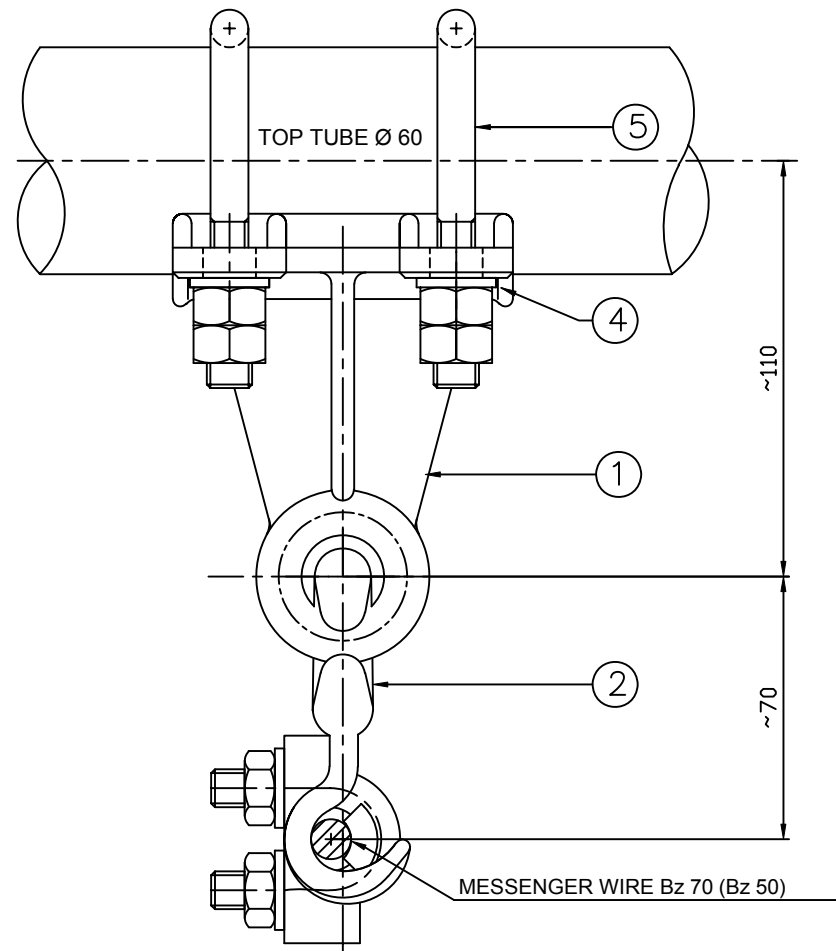

ASSEMBLY WITH MID POINT ANCHOR

102



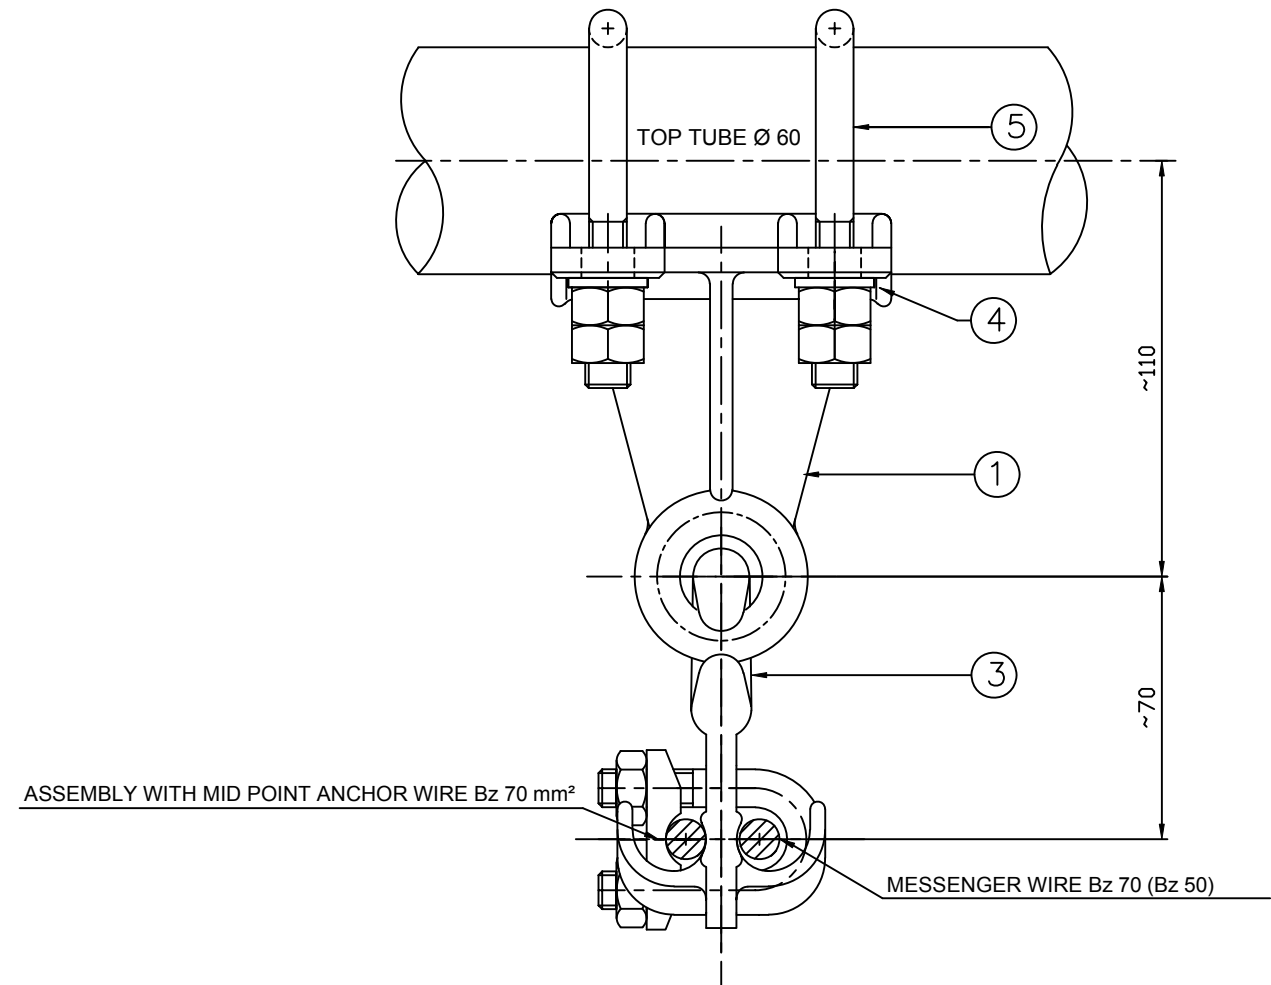


QUANTITY	2	2	5	U BOLT M12-80 (90/45) gr.4.6 WITH 2 NUTS		01LC00BDG143	122171
	4	4	4	WASHER M12 gr.6		SR EN ISO 4034-2002	
	1		3	HOOK WITH SWIWEL		ELC 13-1.4.0.B	
		1	2	HOOK WITH SWIWEL		ELC 13-1.4.0.A	
	1	1	1	FASTENING FOR HOOK	0.95	ELC 13-1.3.1.A	
MARK GROUP	102	101	ITEM	DESIGNATION	UNIT MASS	REFERENCE DRAWING	MARK
					kg		

SUPORT PENTRU 1 SAU 2 CABLURI
PURTATOARE
SUSPENSION FOR 1 OR 2 MESSENGERS

Numele fisierului/
CAD file name:
01LC00BDG070




Scara/ Scale:	Part	Rev.
	1 / 1	0

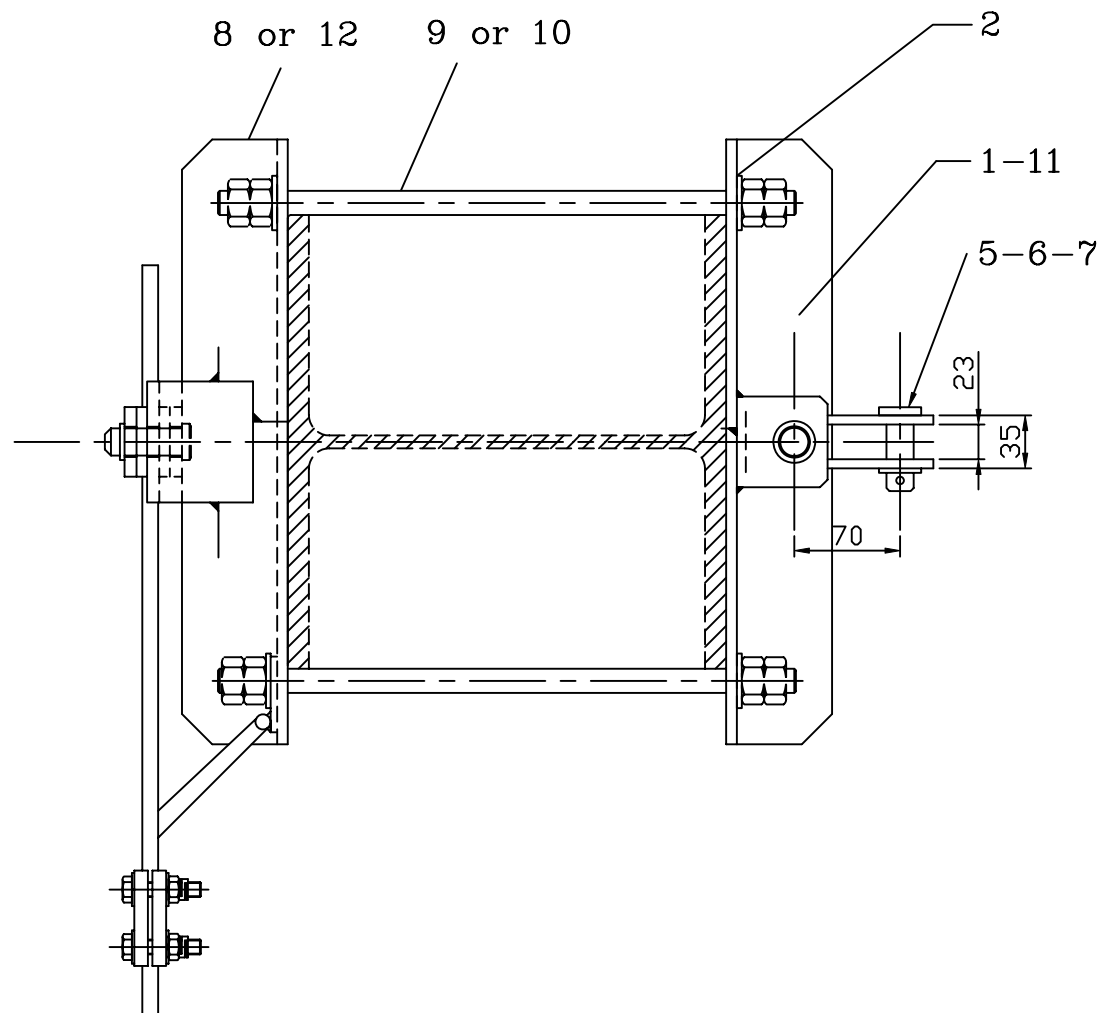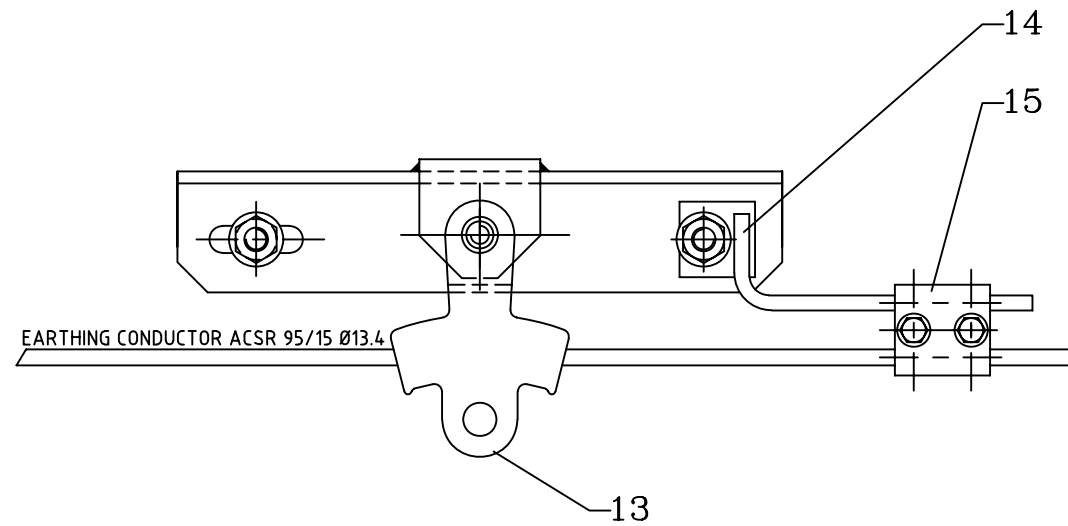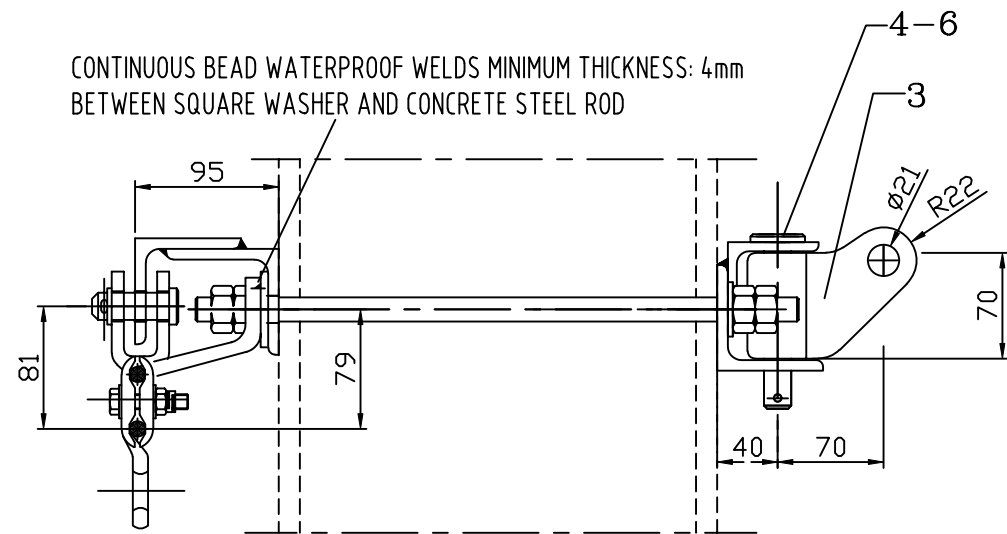

MARK. GROUP	QUANTITY	ITEM	DESIGNATION	UNIT MASS	REFERENCE DRAWING	MARK
	1	15	CLAMP	0.59	ELC 2-4.0	
	1	14	EARTHING CONNECTION		01LC00BDG260	101
	1	13	EARTHING CONDUCTOR SUSPENSION TYPE I	1.30	ELC 13-1.4.0	
	1	12	COUNTERPLATE WITH EARTHING CONDUCTOR		01LC00BDG102	102
	1	11	HINGE SUPPORT		01LC00BDG088	102
	2	10	THREADED ROD M16- 350/100		01LC00BDG141	1611C2
	2	9	THREADED ROD M16- 450/100		01LC00BDG141	1611E2
	1	8	COUNTERPLATE WITH EARTHING CONDUCTOR		01LC00BDG102	101
	1	7	AXIS 20-50		01LC00BDG146	201050
	2	6	PIN. 4,5*40		01LC00BDG145	45A040
	1	5	WASHER M20		01LC00BDG142	20A110
	1	4	AXIS 18-110		01LC00BDG146	181110
	1	3	HINGE STRUT TUBE	0.78	E.L.C 13-9-11 A rev.C	...
	4	2	WASHER M16N		01LC00BDG142	161110
	1	1	HINGE SUPPORT		01LC00BDG088	101
	102					
	101					
		ITEM	DESIGNATION	UNIT MASS	REFERENCE DRAWING	MARK
				kg		

CRAPODINA CU SUSTINEREA CABLULUI COLECTOR PENTRU TIRANT FASTENING FOR STRUT TUBE WITH EARTHING CONDUCTOR	Numele fisierului/ CAD file name:	Scara/ Scale:	Part	Rev.
	01LC00BDG071		1 / 1	0

CONTINUOUS BEAD WATERPROOF WELDS MINIMUM THICKNESS: 4mm
BETWEEN SQUARE WASHER AND CONCRETE ROD

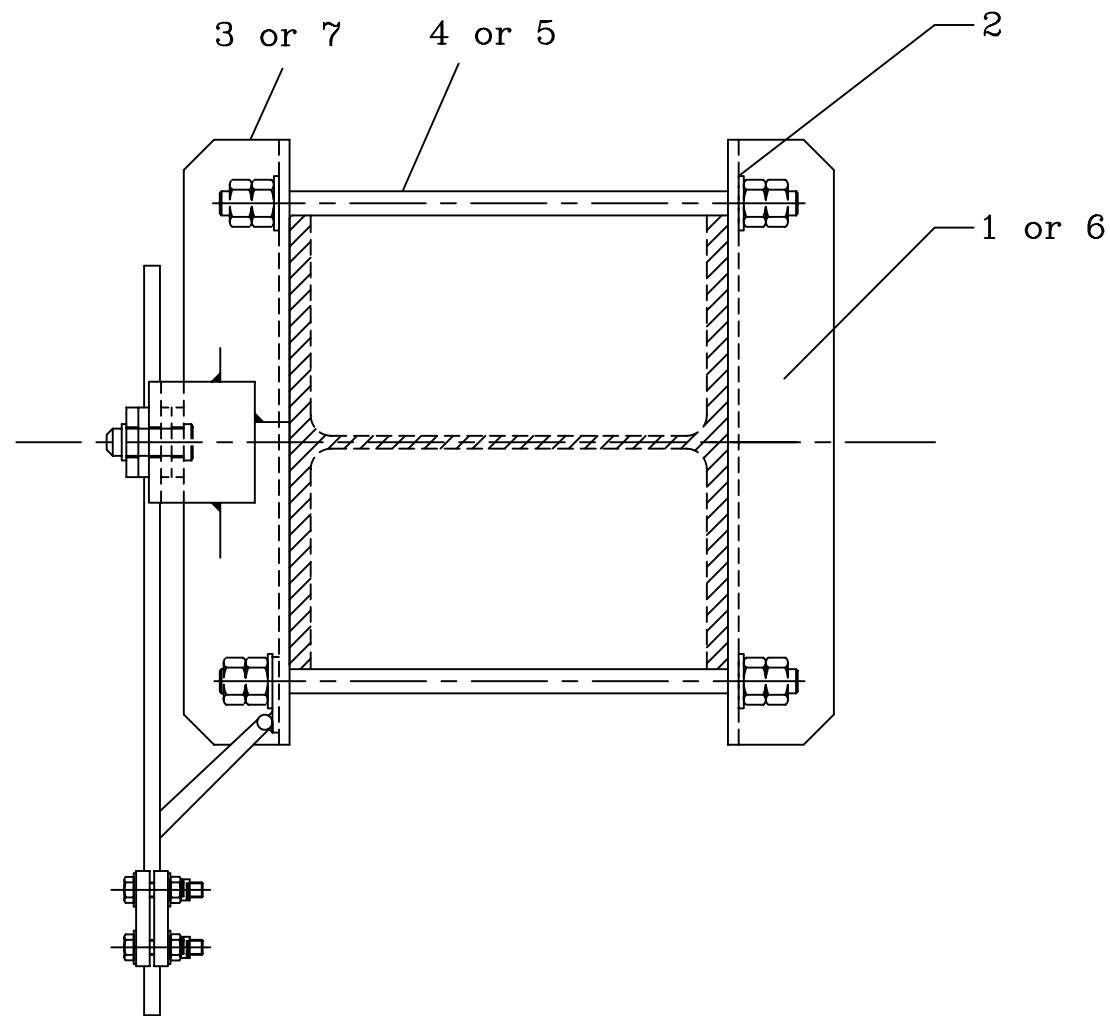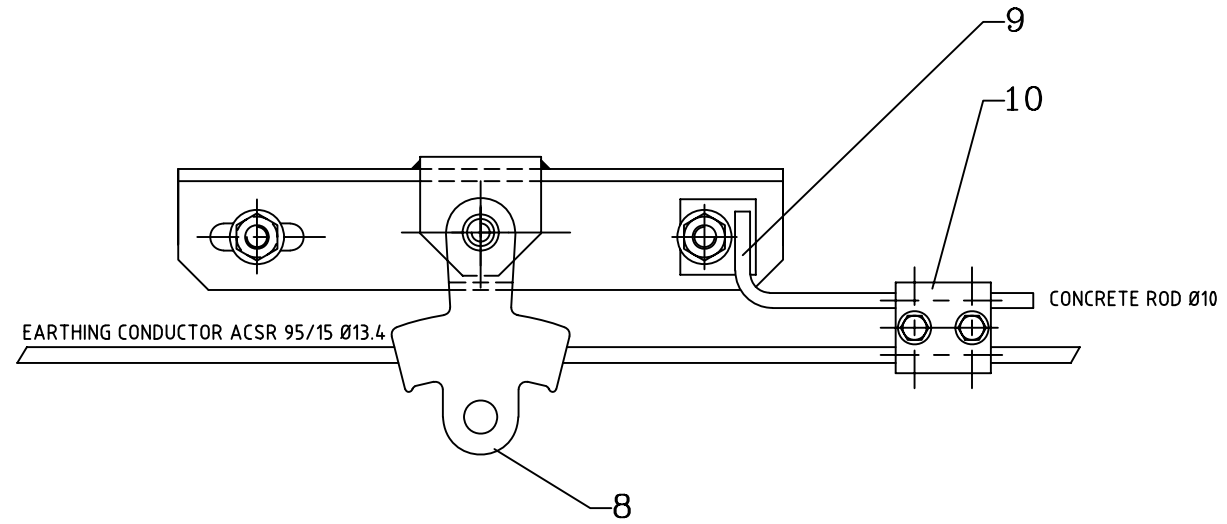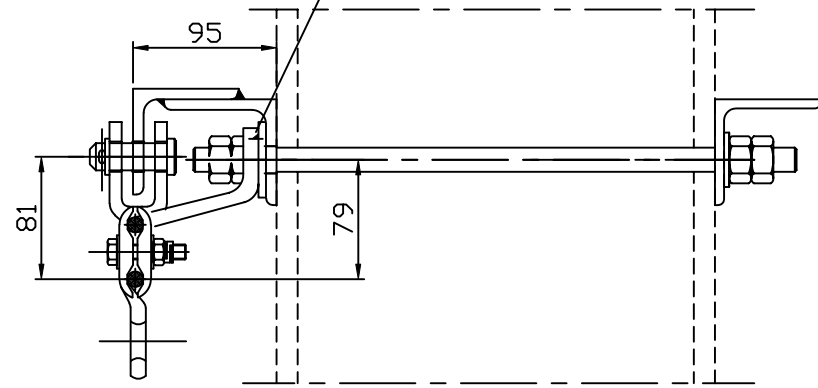


MARK. GROUP	QUANTITY	ITEM	DESIGNATION	UNIT MASS	REFERENCE DRAWING	MARK
102	1	10	CLAMP	0.59	ELC 2-4.0	
101	1	9	EARTHING CONNECTION		01LC00BDG260	101
	1	8	EARTHING CONDUCTOR SUSPENSION TYPE I	1.30	ELC 13-1.4.0	
	1	7	COUNTERPLATE WITH EARTHING CONDUCTOR		01LC00BDG102	102
	1	6	COUNTERPLATE		01LC00BDG090	102
	2	5	THREADED ROD M16- 350/100		01LC00BDG141	1611C2
	2	4	THREADED ROD M16- 450/100		01LC00BDG141	1611E2
	1	3	COUNTERPLATE WITH EARTHING CONDUCTOR		01LC00BDG102	101
	4	2	WASHER M16N		01LC00BDG142	161110
	1	1	COUNTERPLATE		01LC00BDG090	101

FIXARE PENTRU CABLUL COLECTOR
EARTHING CONDUCTOR FASTENING

Numele fisierului/
CAD file name:
01LC00BDG072


Scara/
Scale:

Part
1 / 1
Rev.
0

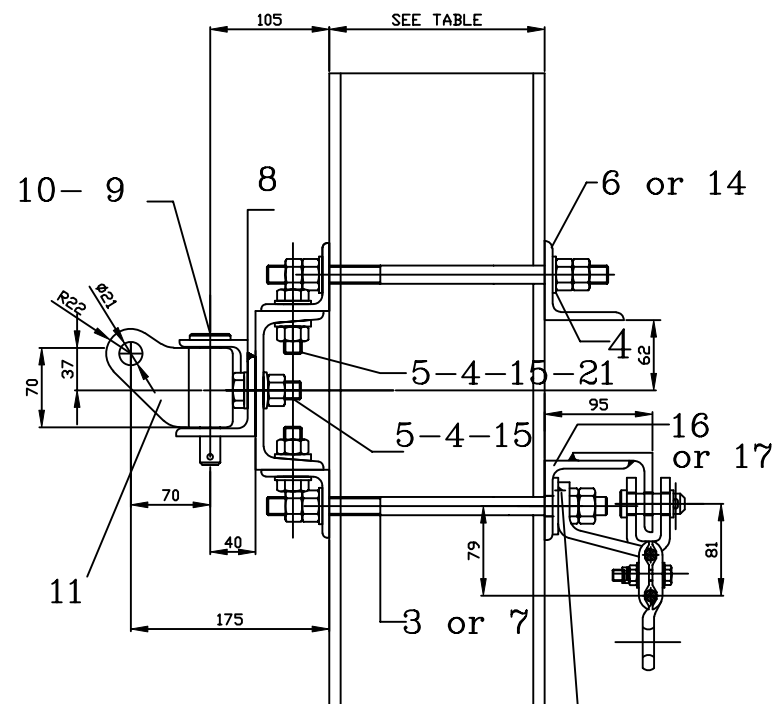

ON H BEAM	ASSEMBLY ALLOCATION	
	2 TOP TUBES SPACING 1.00 m	3 TOP TUBES SPACING 0.50 m
HE 200 TO 240	101	201
H 260 TO 320 (A OR B)	102	202


CONTINUOUS BEAD WATERPROOF WELDS MINIMUM THICKNESS: 4mm
BETWEEN SQUARE WASHER AND CONCRETE STEEL ROD

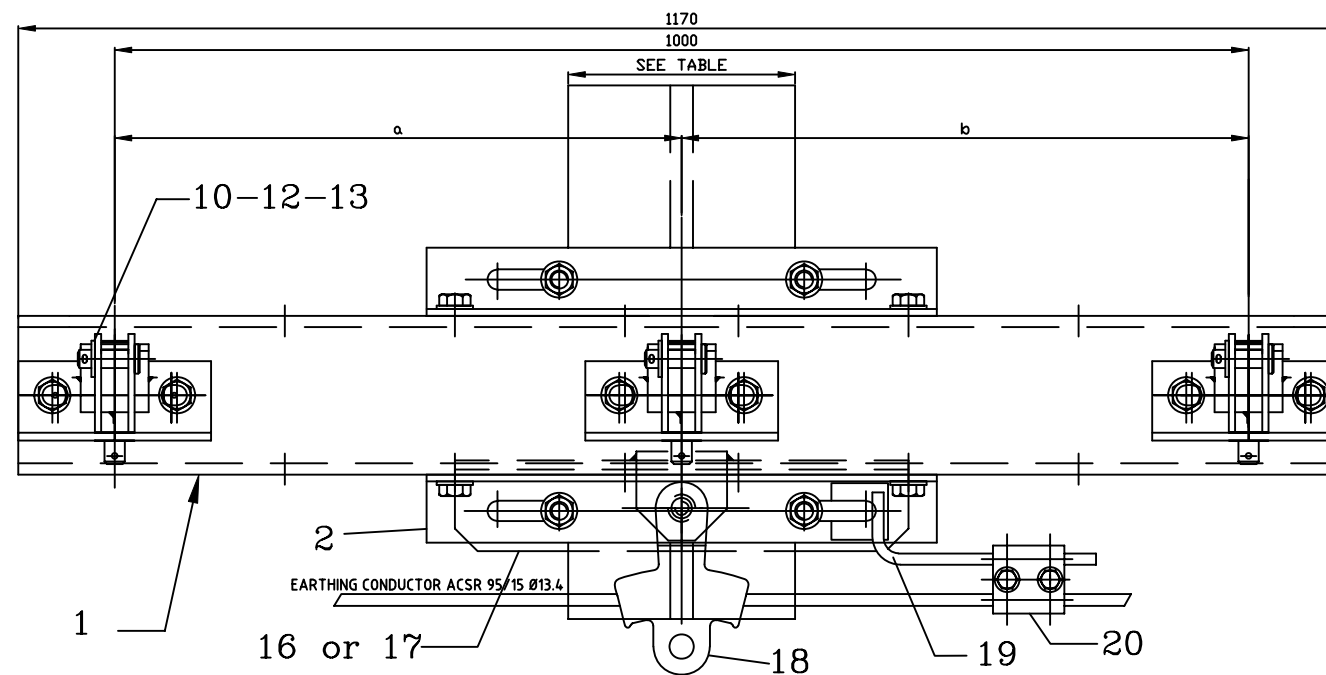


Note
For cotes a and b see the mounting diagrams.

MARK GROUP	202	201	102	101	ITEM	DESIGNATION	UNIT MASS	REFERENCE DRAWING	MARK
					21	WASHER TYPE U		01LC00BDG142	16A710
					20	CLAMP	0.59	ELC 2-4.0	
					19	EARTHING CONNECTION	0.25	01LC00BDG260	101
					18	EARTHING CONDUCTOR SUSPENSION TYPE I	1.30	ELC 13-14.0	
					17	COUNTERPLATE WITH EARTHING CONDUCTOR		01LC00BDG102	102
					16	COUNTERPLATE WITH EARTHING CONDUCTOR		01LC00BDG102	101
					15	WASHER . CS-16-32-2.8		01LC00BDG142	16A310
					14	COUNTERPLATE		01LC00BDG090	102
					13	AXIS 20-50		01LC00BDG146	201050
					12	WASHER M20		01LC00BDG142	20A110
					11	HINGE STRUT TUBE		E.L.C 13-9.11 A REV C	
					10	PIN 4.5*40		01LC00BDG145	45A040
					9	AXIS 18-110		01LC00BDG146	181110
					8	HINGE SUPPORT		01LC00BDG114	
					7	THREADED ROD M16-450/100		01LC00BDG141	1611E2
					6	COUNTERPLATE		01LC00BDG090	101
					5	BOLT HM 16-50/50		01LC00BDG144	1612H1
					4	WASHER M16N		01LC00BDG142	16A110
					3	THREADED ROD M16 -350/100		01LC00BDG141	1611C2
					2	COUNTERPLATE FOR SPREADER		01LC00BDG094	
					1	SPREADER		01LC00BDG089	

TRAVERSA CU SUSTINEREA CABLULUI COLECTOR PENTRU 2 SAU 3 CONTRAFISE (distanța 1m) SPREADER ASSEMBLY FOR 2 OR 3 STRUT TUBES WITH EARTHING CONDUCTOR (spacing 1m)	Numele fisierului/ CAD file name:	Scara/ Scale:	Part	Rev.
	01LC00BDG078		1 / 1	0


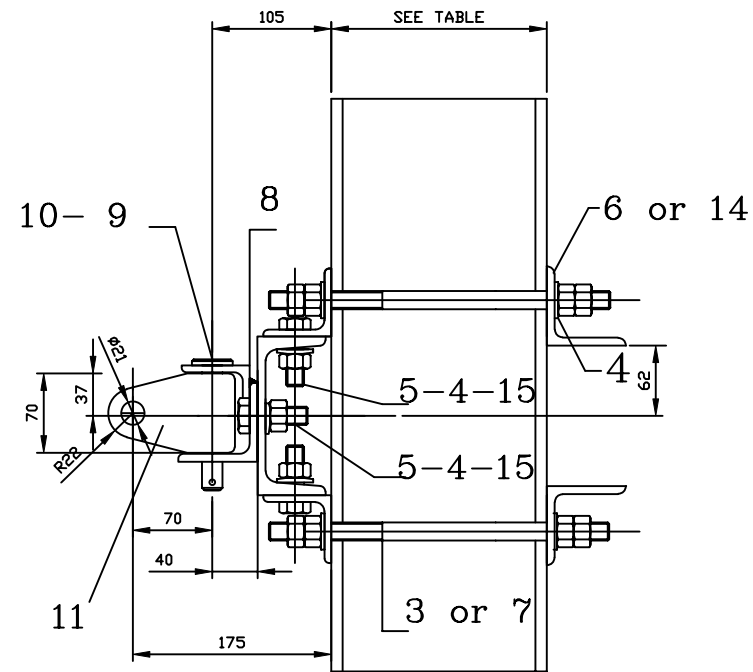


ON H BEAM	ASSEMBLY ALLOCATION	
	2 TOP TUBES SPACING 1.60 m	3 TOP TUBES SPACING 0.80 m
HE 200 TO 240	111	211
H 260 TO 320 (A OR B)	112	212

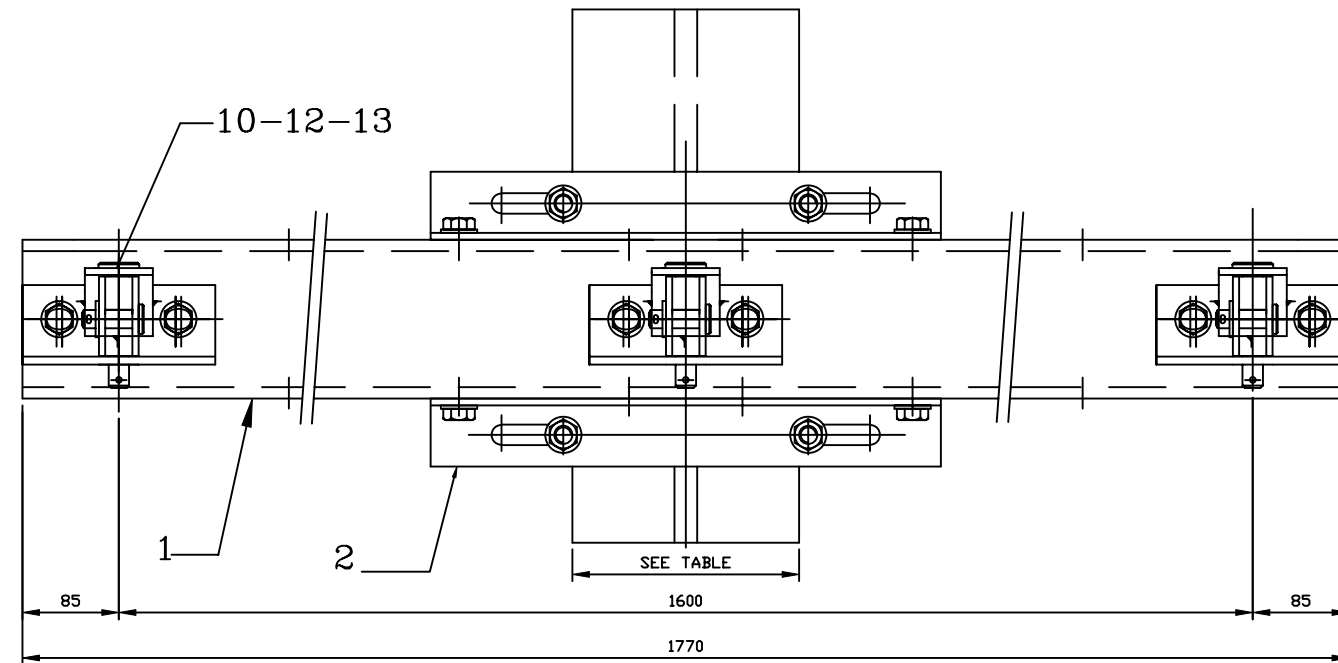

MARK GROUP	QUANTITY	ITEM	DESIGNATION	UNIT MASS	REFERENCE DRAWING	MARK		
							10	10
212	10	10	8	8	15	WASHER	01LC00BDG142	16A710
211	2				14	COUNTERPLATE	01LC00BDG090	102
112	3	3	2	2	13	AXIS 20-50	01LC00BDG146	201050
111	3	3	2	2	12	WASHER M20	01LC00BDG142	20A110
	3	3	2	2	11	HINGE TOP TUBE	ELC 13-9.10 A REV C	
	6	6	4	4	10	PIN 4.5*40	01LC00BDG145	45A040
	3	3	2	2	9	AXIS 18-110	01LC00BDG146	181110
	3	3	2	2	8	HINGE SUPPORT	01LC00BDG114	
	4		4		7	THREADED ROD M16-450/100	01LC00BDG141	1611E2
		2		2	6	COUNTERPLATE	01LC00BDG090	101
	10	10	8	8	5	BOLT HM 16-50/50	01LC00BDG144	1612H1
	18	18	16	16	4	WASHER M16N	01LC00BDG142	161110
		4		4	3	THREADED ROD M16 -350/100	01LC00BDG141	1611C2
	2	2	2	2	2	COUNTERPLATE FOR SPREADER	01LC00BDG094	
	1	1	1	1	1	SPREADER (1.60m)	01LC00BDG115	


TRAVERSA CU SUSTINEREA CABLULUI COLECTOR PENTRU 2 SAU 3 TIRANTI (distanța 1.60m) SPREADER ASSEMBLY FOR 2 OR 3 TOP TUBES WITH EARTHING CONDUCTOR (spacing 1.60m)	Numele fisierului/ CAD file name:	Scara/ Scale:	Part	Rev.
	01LC00BDG079		1 / 1	0

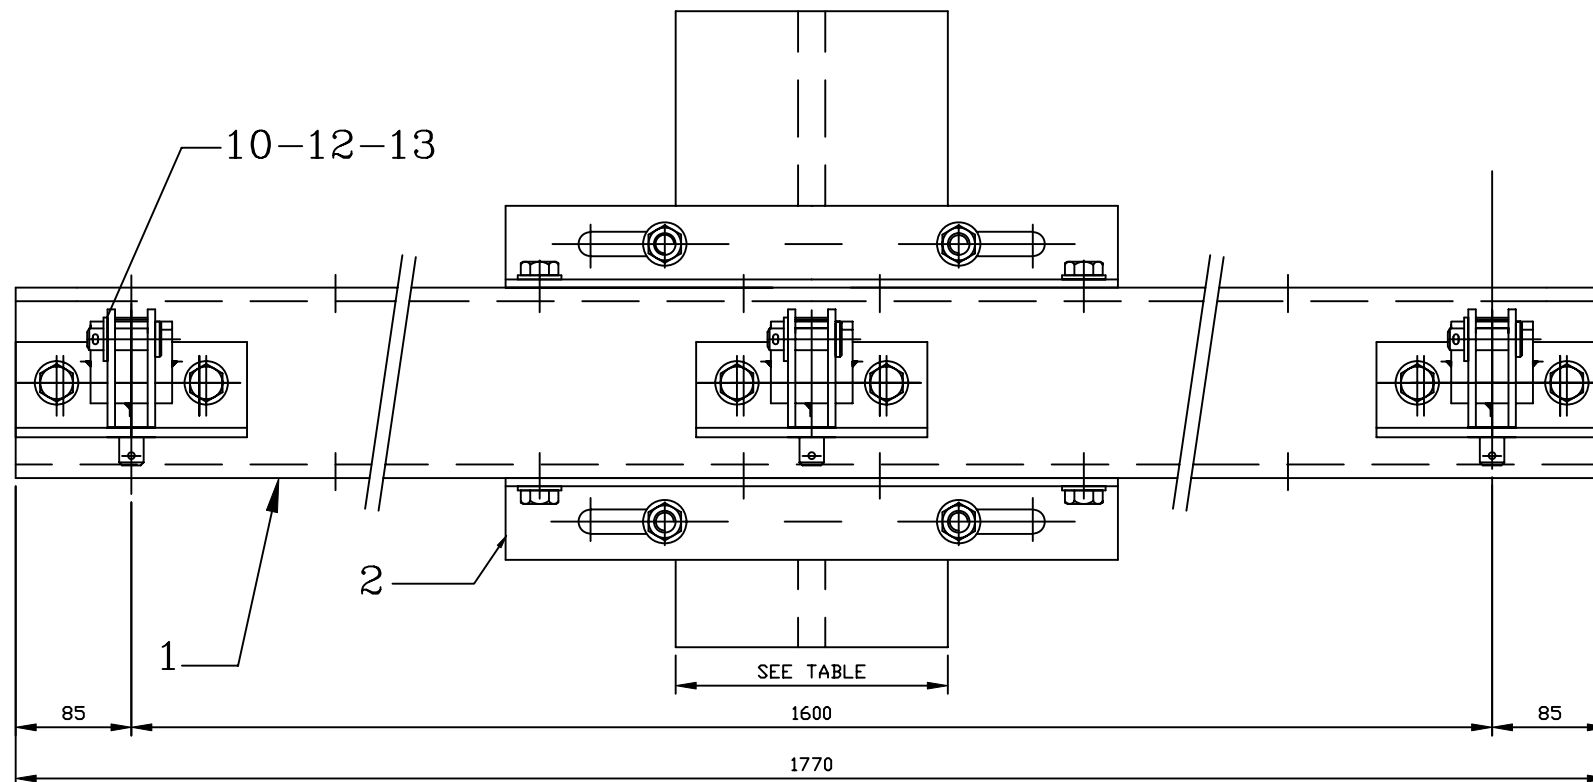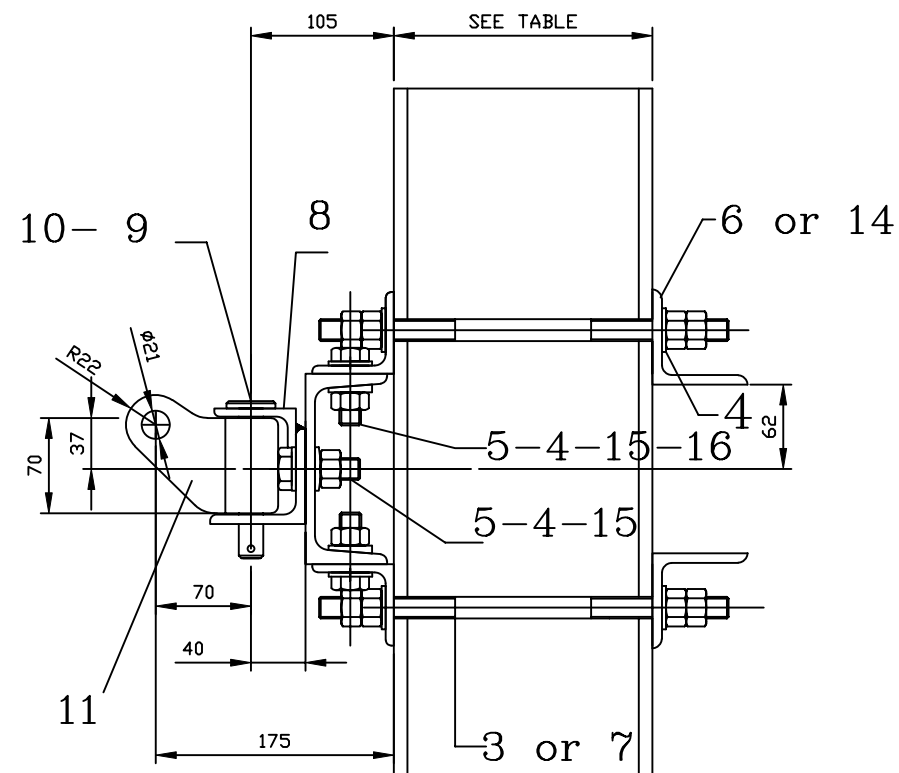

ON H BEAM	ASSEMBLY ALLOCATION	
	2 TOP TUBES SPACING 1.60 m	3 TOP TUBES SPACING 0.80 m
HE 200 TO 240	111	211
H 260 TO 320 (A OR B)	112	212

MARK GROUP	212	211	112	111	ITEM	DESIGNATION	UNIT MASS	REFERENCE DRAWING	MARK
QUANTITY	4	4	4	4	16	WASHER . TYPE U		01LC00BDG142	16A710
	10	10	8	8	15	WASHER . CS-16-32-2.8		01LC00BDG142	16A310
	2		2		14	COUNTERPLATE		01LC00BDG090	102
	3	3	2	2	13	AXIS 20-50		01LC00BDG146	201050
	3	3	2	2	12	WASHER M20		01LC00BDG142	20A110
	3	3	2	2	11	HINGE STRUT TUBE		E.L.C 13-9.11 A REV C	
	6	6	4	4	10	PIN 4.5*40		01LC00BDG145	45A040
	3	3	2	2	9	AXIS 18-110		01LC00BDG146	181110
	3	3	2	2	8	HINGE SUPPORT		01LC00BDG114	
	4		4		7	THREADED ROD M16-450/100		01LC00BDG141	1611E2
		2		2	6	COUNTERPLATE		01LC00BDG090	101
	10	10	8	8	5	BOLT HM 16-50/50		01LC00BDG144	1612H1
	18	18	16	16	4	WASHER M16N		01LC00BDG142	16A110
		4		4	3	THREADED ROD M16-350/100		01LC00BDG141	1611C2
	2	2	2	2	2	COUNTERPLATE FOR SPREADER		01LC00BDG094	
1	1	1	1	1	SPREADER (1.60m)		01LC00BDG115		



TRAVERSA PENTRU 2 SAU 3 CONTRAFISE (distanța 1.60m) SPREADER ASSEMBLY FOR 2 OR 3 STRUT TUBES (spacing 1.60m)		Numele fisierului/ CAD file name: 01LC00BDG080	Scara/ Scale:	Part 1 / 1	Rev. 0
---	--	---	------------------	----------------------	------------------

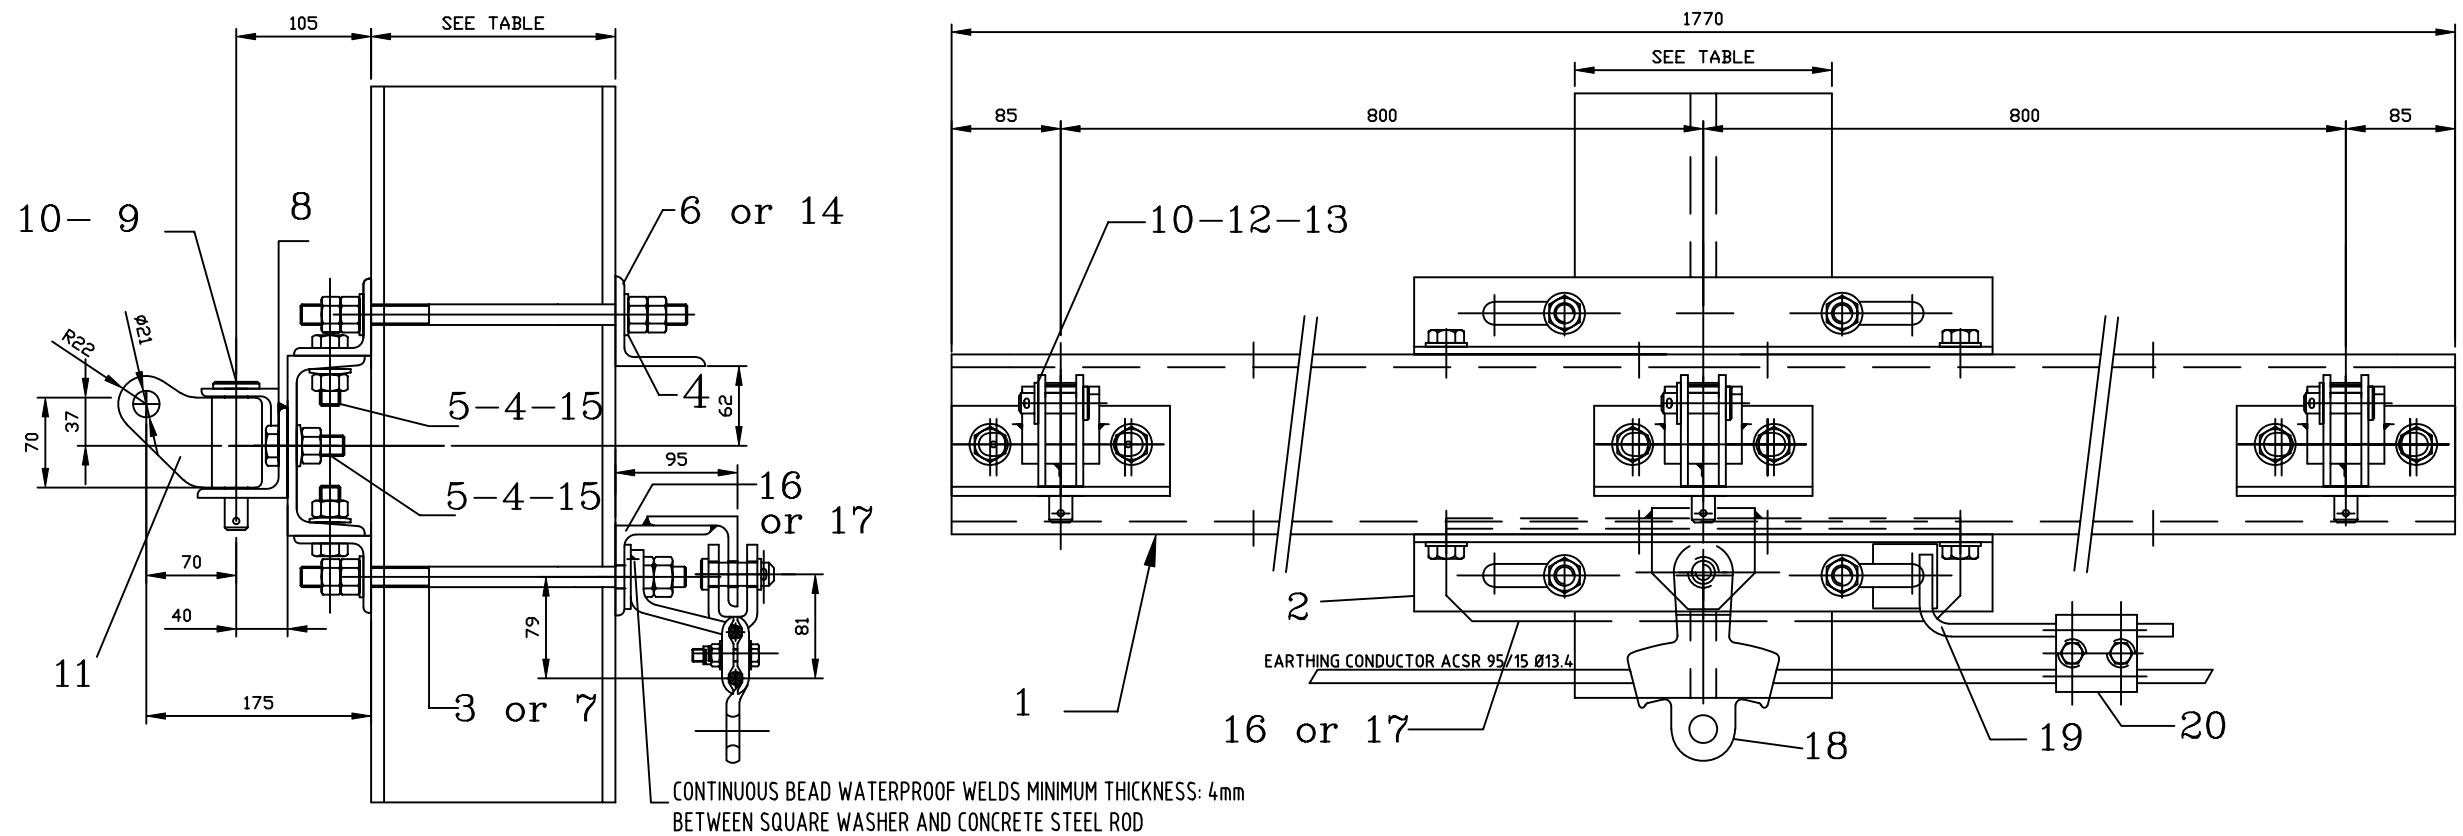

MARK GROUP	QUANTITY				ITEM	DESIGNATION	UNIT MASS	REFERENCE DRAWING	MARK
	212	211	112	111					
	1	1	1	1	20	CLAMP	0.59	ELC 2-4.0	
	1	1	1	1	19	EARTHING CONNECTION		01LC00BDG260	101
	1	1	1	1	18	EARTHING CONDUCTOR SUSPENSION TYPE I	1.30	ELC 13-1.4.0	
	1		1		17	COUNTERPLATE WITH EARTHING CONDUCTOR		01LC00BDG102	102
		1		1	16	COUNTERPLATE WITH EARTHING CONDUCTOR		01LC00BDG102	101
	10	10	8	8	15	WASHER . CS-16-32-2.8		01LC00BDG142	16A310
	1		1		14	COUNTERPLATE		01LC00BDG090	102
	3	3	2	2	13	AXIS 20-50		01LC00BDG146	201050
	3	3	2	2	12	WASHER M20		01LC00BDG142	20A110
	3	3	2	2	11	HINGE STRUT TUBE		ELC 13-9.11 A REV C	
	6	6	4	4	10	PIN 4.5*40		01LC00BDG145	45A040
	3	3	2	2	9	AXIS 18-110		01LC00BDG146	181110
	3	3	2	2	8	HINGE SUPPORT		01LC00BDG114	
	4		4		7	THREADED ROD M16-450/100		01LC00BDG141	1611E2
		1		1	6	COUNTERPLATE		01LC00BDG090	101
	10	10	8	8	5	BOLT HM 16-50/50		01LC00BDG144	1612H1
	18	18	16	16	4	WASHER M16N		01LC00BDG142	16A110
		4		4	3	THREADED ROD M16 -350/100		01LC00BDG141	1611C2
	2	2	2	2	2	COUNTERPLATE FOR SPREADER		01LC00BDG094	
	1	1	1	1	1	SPREADER < 1.60 m >		01LC00BDG115	
MARK GROUP	212	211	112	111	ITEM	DESIGNATION	UNIT MASS	REFERENCE DRAWING	MARK
							kg		

ON H BEAM	ASSEMBLY ALLOCATION	
	2 TOP TUBES SPACING 1.60 m	3 TOP TUBES SPACING 0.80 m
HE 200 TO 240	111	211
H 260 TO 320 (A OR B)	112	212



TRAVERSA CU SUSTINEREA CABLULUI COLECTOR PENTRU 2 SAU 3 CONTRAFSE (distanța 1.60m) SPREADER ASSEMBLY FOR 2 OR 3 STRUT TUBES WITH EARTHING CONDUCTOR (spacing 1.60m)	Numele fisierului/ CAD file name:	Scara/ Scale:	Part	Rev.
	01LC00BDG081		1 / 1	0

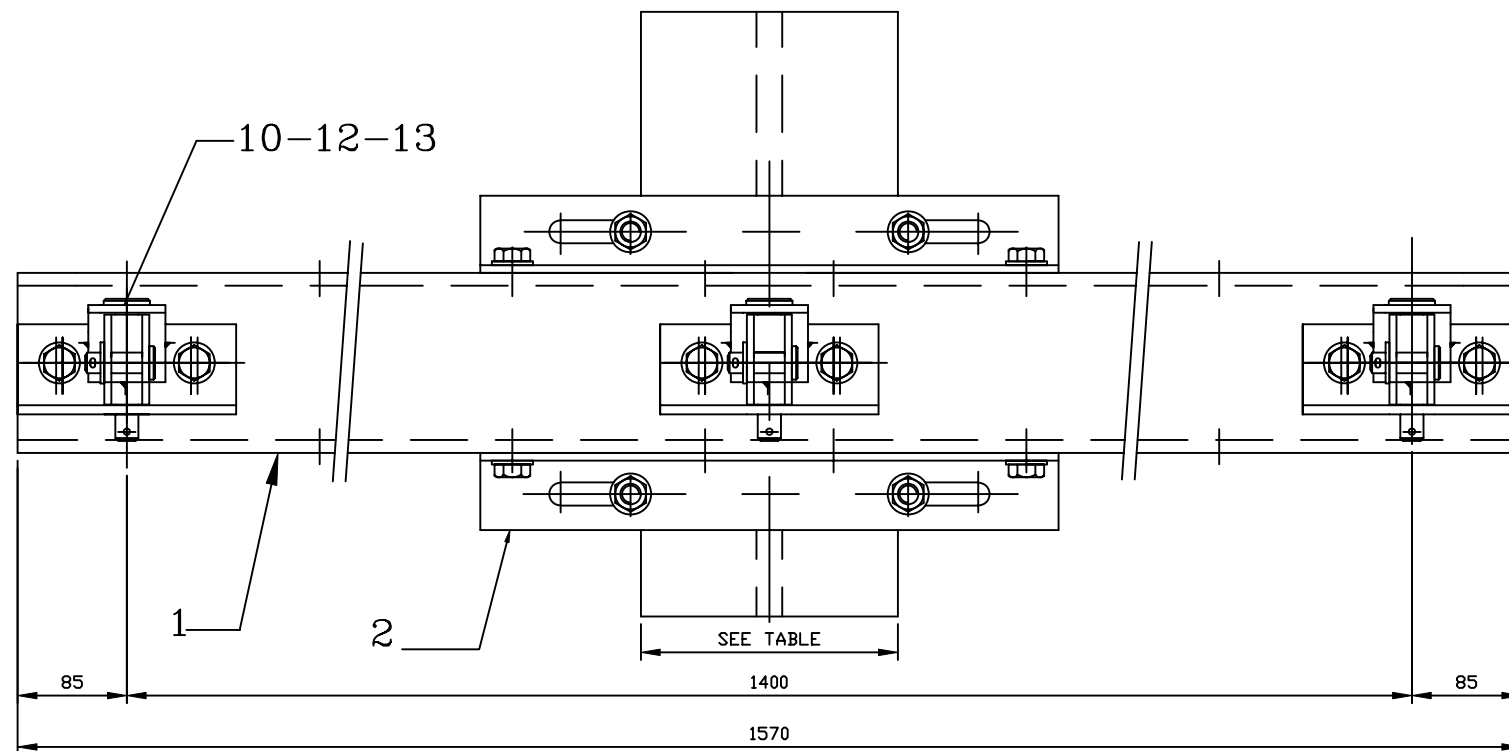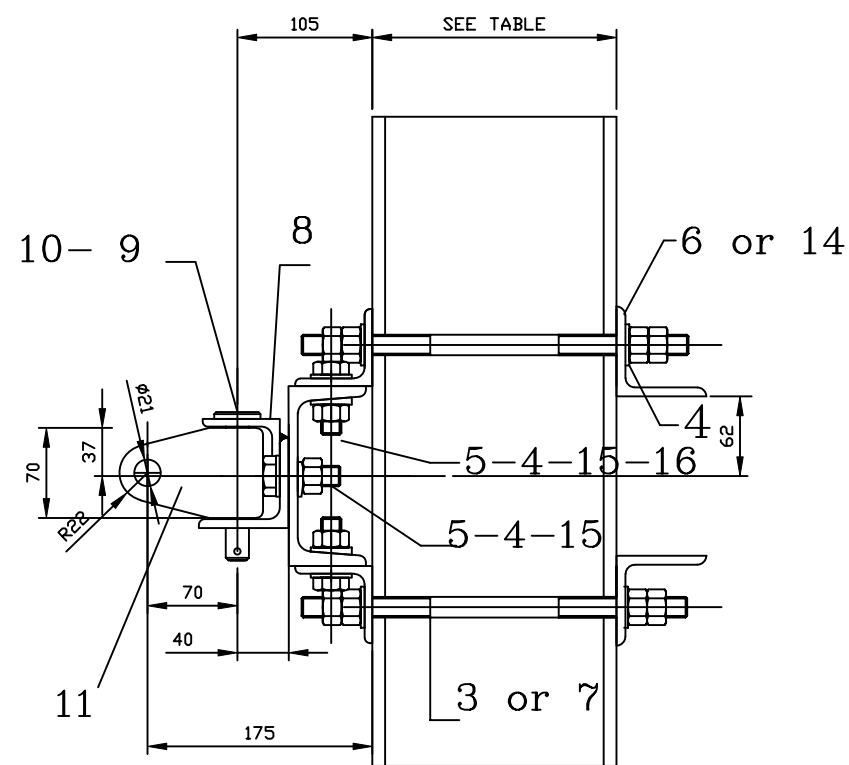

MARK GROUP	222	221	122	121	ITEM	DESIGNATION	UNIT MASS	REFERENCE DRAWING	MARK
	4	4	4	4	16	WASHER . TYPE U		01LC00BDG142	16A710
	10	10	8	8	15	WASHER . CS-16-32-2.8		01LC00BDG142	16A310
	2		2		14	COUNTERPLATE		01LC00BDG090	102
	3	3	2	2	13	AXIS 20-50		01LC00BDG146	201050
	3	3	2	2	12	WASHER M20		01LC00BDG142	20A110
	3	3	2	2	11	HINGE TOP TUBE		ELC 13-9.10 A REV C	
	6	6	4	4	10	PIN 4.5*40		01LC00BDG145	45A040
	3	3	2	2	9	AXIS 18-110		01LC00BDG146	181110
	3	3	2	2	8	HINGE SUPPORT		01LC00BDG114	
	4		4		7	THREADED ROD M16-450/100		01LC00BDG141	1611E2
		2		2	6	COUNTERPLATE		01LC00BDG090	101
	10	10	8	8	5	BOLT HM 16-50/50		01LC00BDG144	1612H1
	18	18	16	16	4	WASHER M16N		01LC00BDG142	16A110
		4		4	3	THREADED ROD M16 -350/100		01LC00BDG141	1611C2
	2	2	2	2	2	COUNTERPLATE FOR SPREADER		01LC00BDG094	
	1	1	1	1	1	SPREADER (1.40m)		01LC00BDG115	

ON H BEAM	ASSEMBLY ALLOCATION	
	2 TOP TUBES SPACING 1.40 m	3 TOP TUBES SPACING 0.70 m
HE 200 TO 240	121	221
H 260 TO 320 (A OR B)	122	222

TRAVERSA PENTRU 2 SAU 3 TIRANTI (distanța 1.40m) SPREADER ASSEMBLY FOR 2 OR 3 TOP TUBES (spacing 1.40m)	Numele fisierului/ CAD file name:	Scara/ Scale:	Part	Rev.
	01LC00BDG082		1 / 1	0

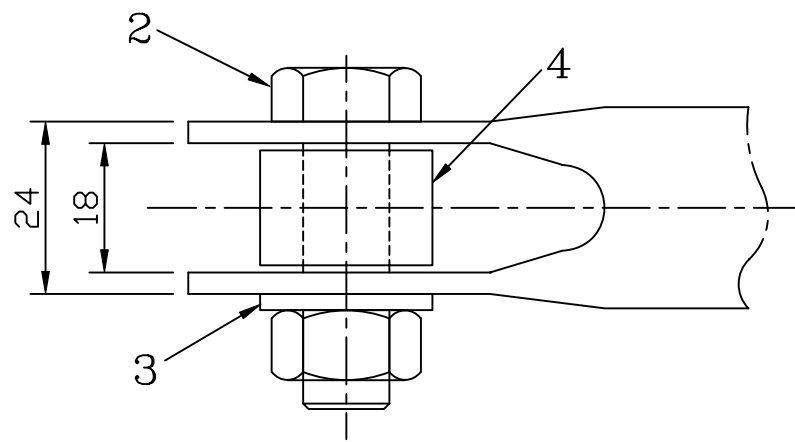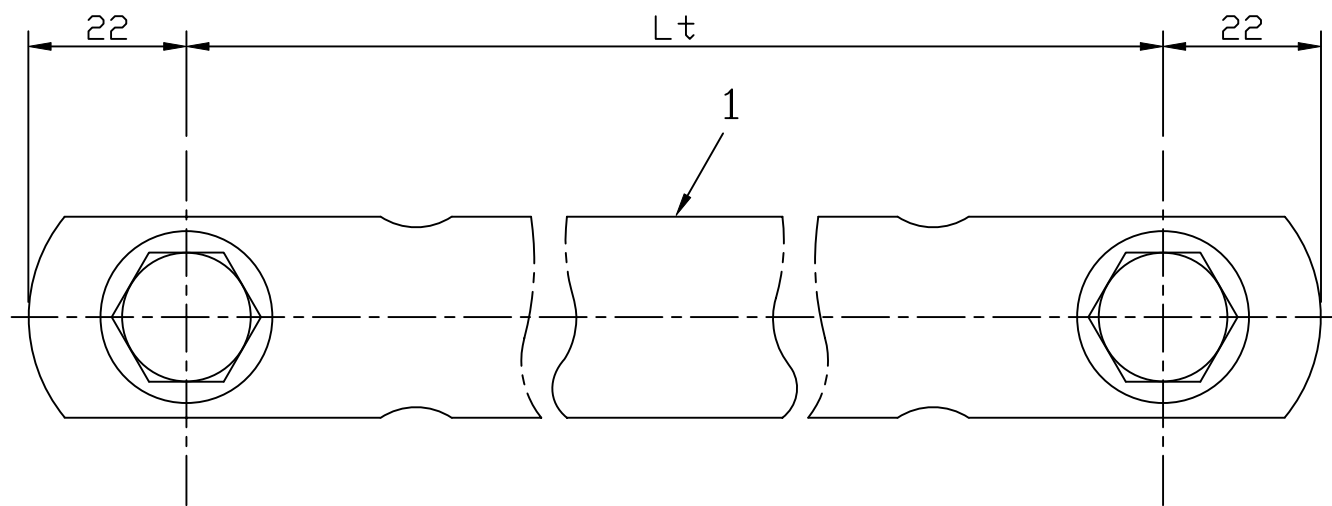

2	4	WEDGE		ELC 32-9.11.6B	
2	3	WASHER SC 12		01LC00BDG142	12B310
2	2	BOLT M12x40/22 STAINLESS STEEL		01LC00BDG144	1222F4
1	1	TUBE 28-3		01LC00BDG116	
QUANTITY	ITEM	DESIGNATION	UNIT MASS	REFERENCE DRAWING	MARK
			kg		

BARA DE RIGIDIZARE
AUXILIARY STRUT TUBE

Numele fisierului/
CAD file name:
01LC00BDG083


Scara/
Scale:

Part

Rev.

1 / 1

0

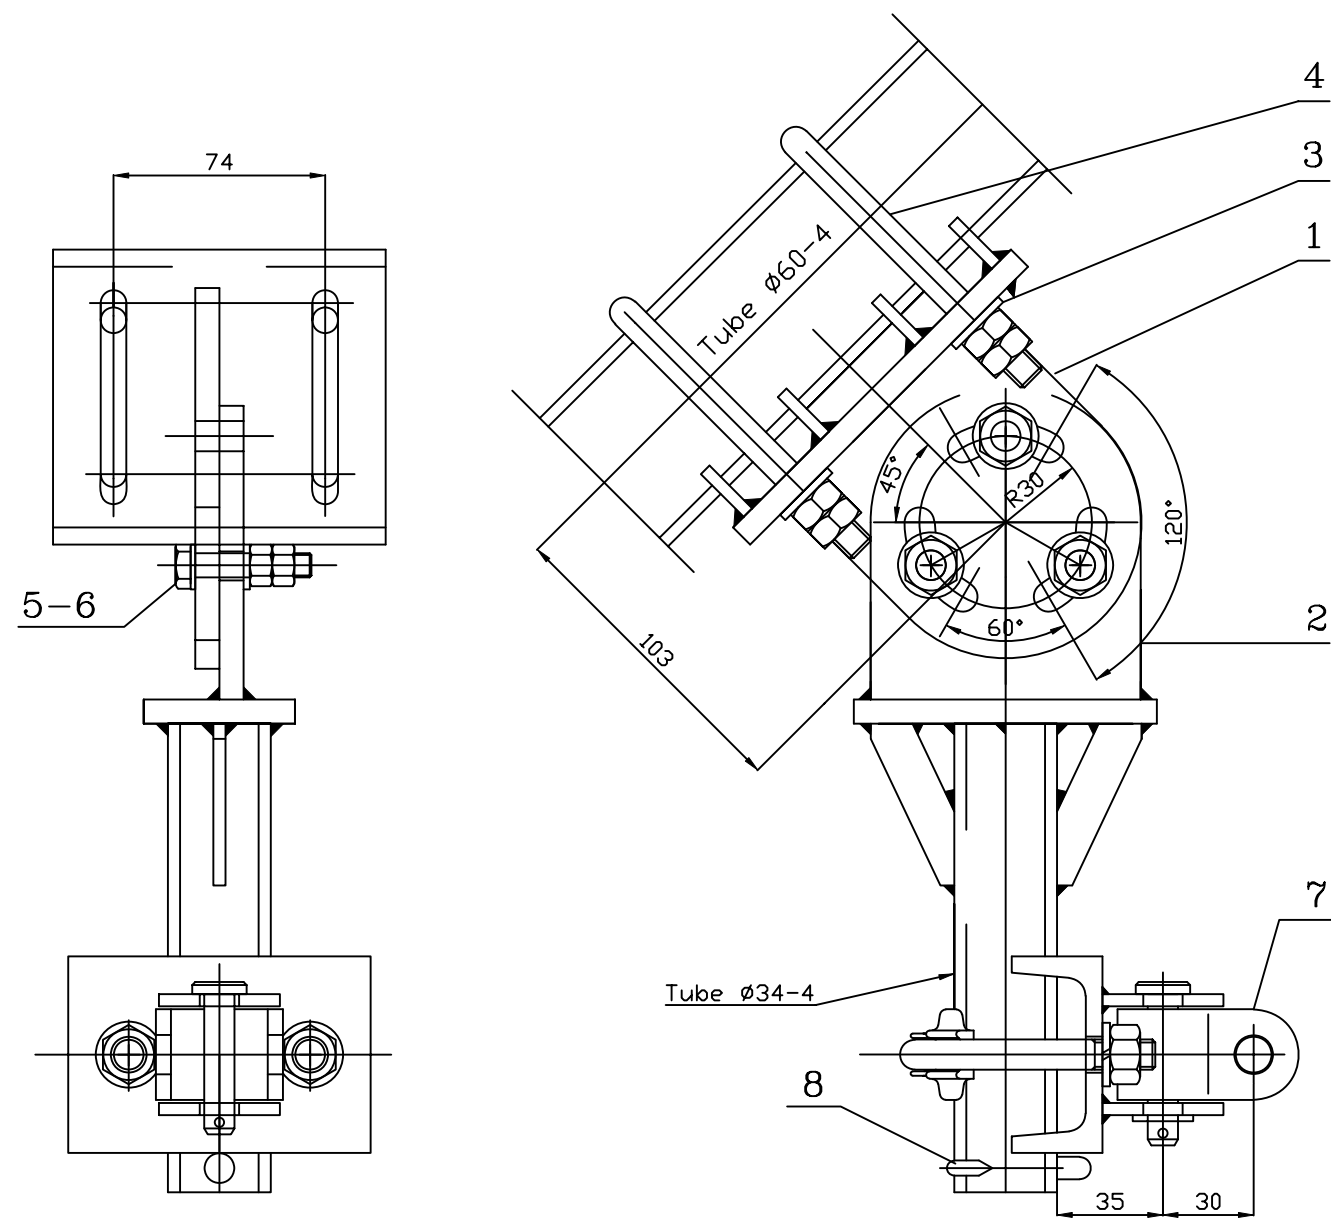

MARK GROUP	ITEM	DESIGNATION	REFERENCE DRAWING	MARK	
QUANTITY	1	8	PIN V8-63	01LC00BDG145	08A063
	1	7	HINGY STEADY ARM FASTENING	01LC00BDG074	
	6	6	WASHER M8N	01LC00BDG142	08B110
	3	5	BOLT HM8-40/28	01LC00BDG144	0823F3
	2	4	U-BOLT 10-74<110/35> WITHOUT CAP	01LC00BDG143	102141
	4	3	WASHER W10	01LC00BDG142	10B510
	1	2	ROTATING STAND OFF BRACKET	01LC00BDG117	
	1	1	ROTATING HALF FLANGE	01LC00BDG118	


ANSAMBLU DE FIXARE ROTATIV
ROTATING FASTENING ASSEMBLY

Numele fisierului/
CAD file name:
01LC00BDG084

Scara/
Scale:

Part
1 / 2

Rev.
0

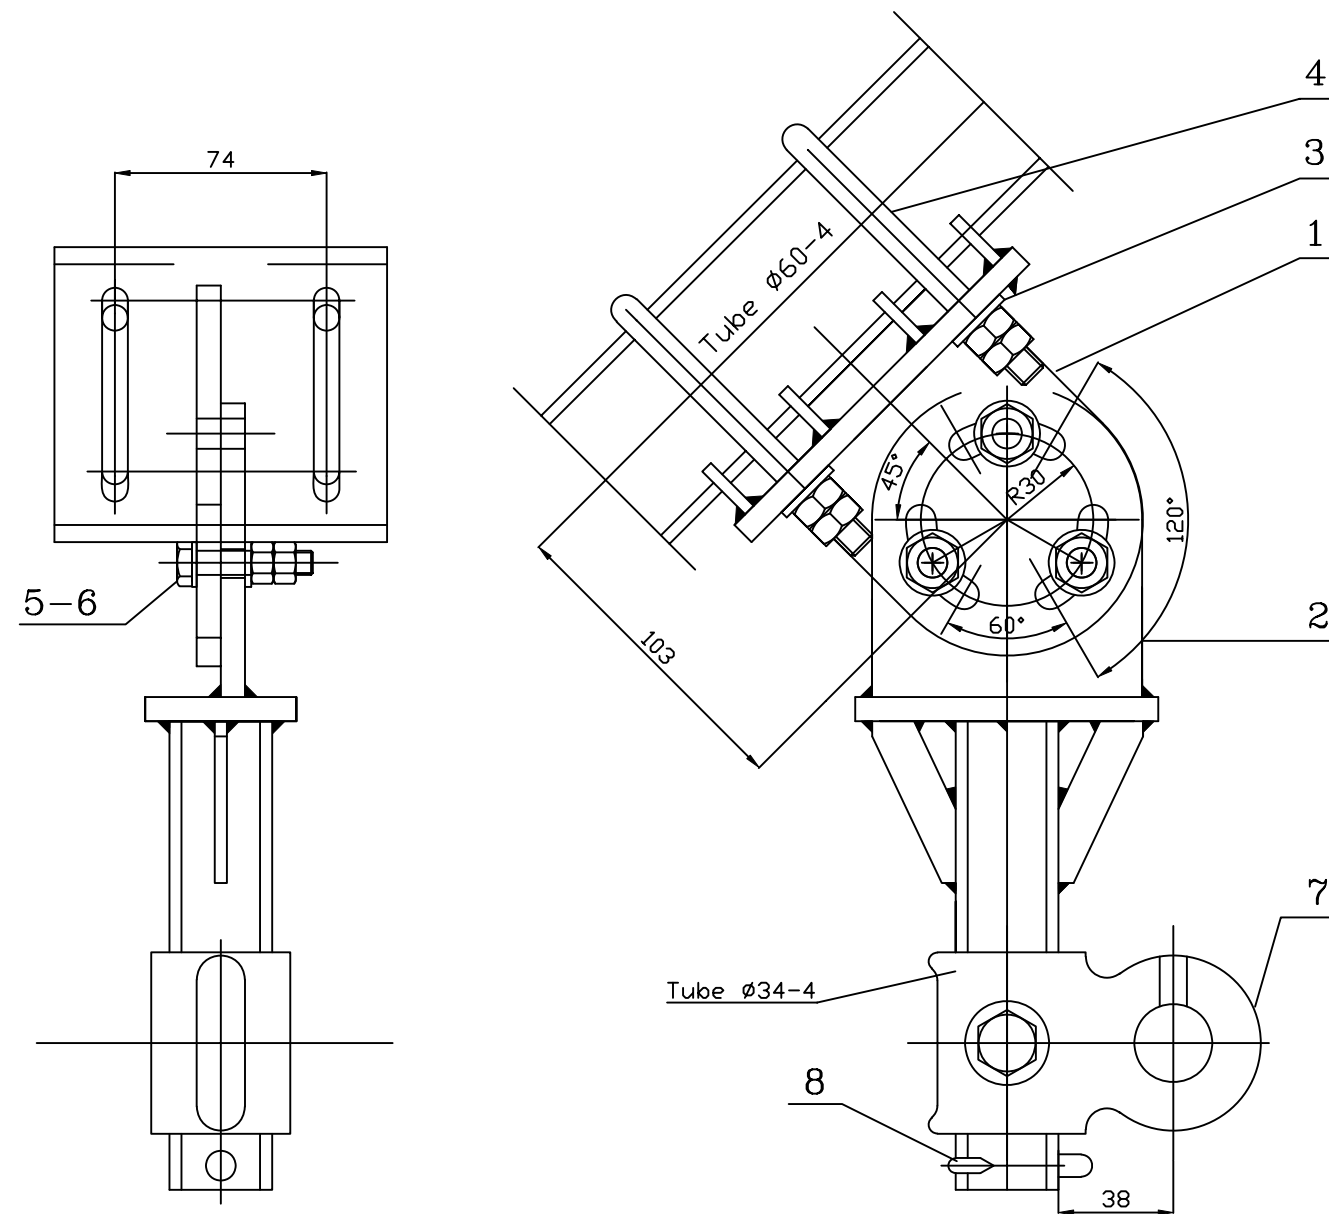

MARK GROUP	ITEM	DESIGNATION	REFERENCE DRAWING	MARK
1	8	PIN V8-63	01LC00BDG145	08A063
1	7	HINGY STEADY ARM FASTENING	ELC 26-4.7.0	
6	6	WASHER M8N	01LC00BDG142	08B110
3	5	BOLT HM8-40/28	01LC00BDG144	0823F3
2	4	U-BOLT 10-74(110/35) WITHOUT CAP	01LC00BDG143	102141
4	3	WASHER W10	01LC00BDG142	10B510
1	2	ROTATING STAND OFF BRACKET	01LC00BDG117	
1	1	ROTATING HALF FLANGE	01LC00BDG118	

ANSAMBLU DE FIXARE ROTATIV
ROTATING FASTENING ASSEMBLY

Numele fisierului/
CAD file name:
01LC00BDG084



Scara/
Scale:

Part
2 / 2

Rev.
0

FROM HE 260 TO HE 320

FROM HE 200 TO HE 240

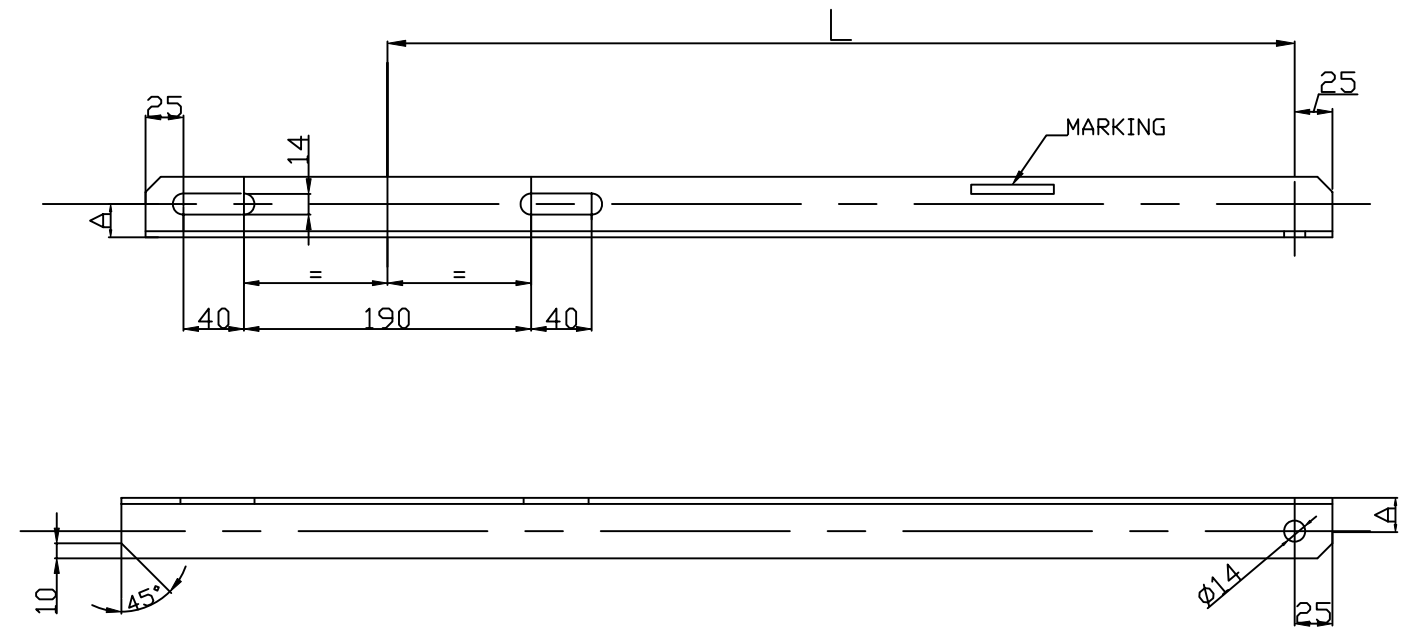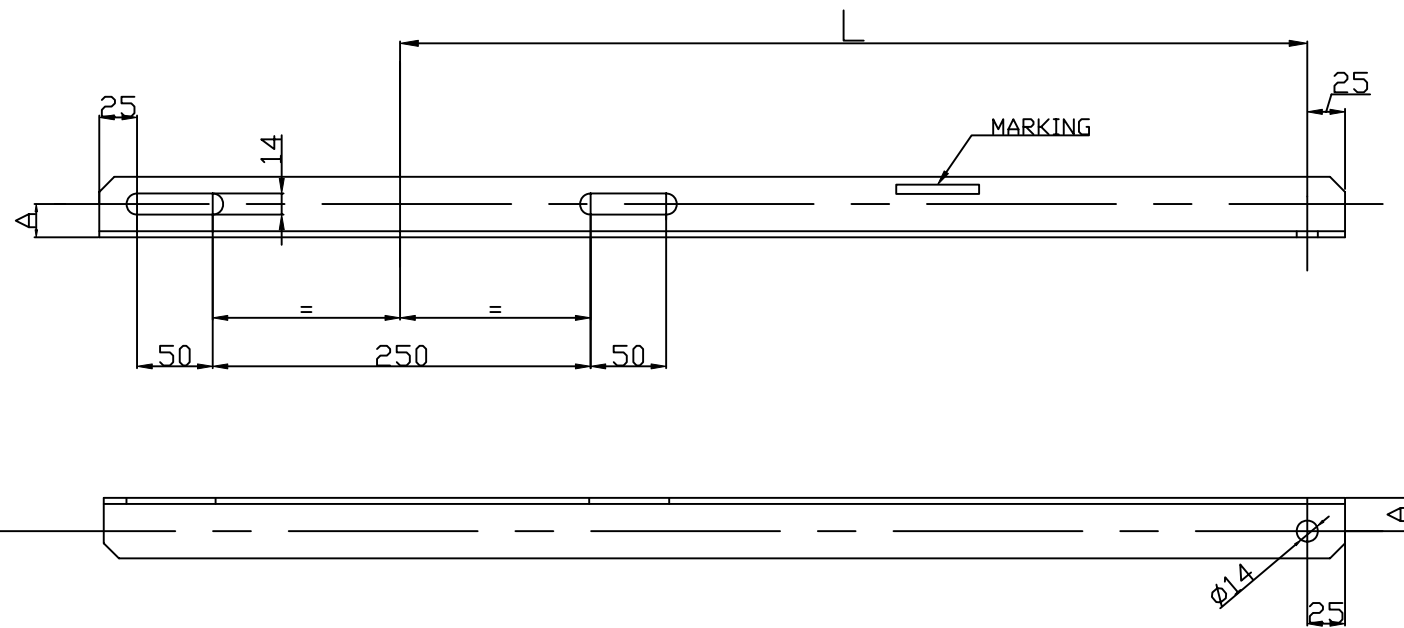


MARK	DESIGNATION	A mm	L mm	UNIT MARK kg
201	L 40 X40 X 4	22	350	1.15
202	L 40 X40 X 4	22	600	1.68
203	L 60 X 60 X 6	35	1000	5.36
204	L 80 X 80 X 8	45	1500	16.37

MARK	DESIGNATION	A mm	L mm	UNIT MARK kg
101	L 40 X40 X 4	22	350	1.07
102	L 40 X40 X 4	22	600	1.59
103	L 60 X 60 X 6	35	1000	5.18
104	L 80 X 80 X 8	45	1500	15.98

Note: 1. Material: S235JR
 2. After welding and drilling will be hot galvanized AT/OL/Zn600-STAS 7221-90.


SUPPORT PENTRU FIBRA OPTICA SUPPORT FOR OPTICAL FIBER	Numele fisierului/ CAD file name:	Scara/ Scale:	Part	Rev.
	01LC00BDG086		1 / 1	0

FROM HE 260 TO HE 320

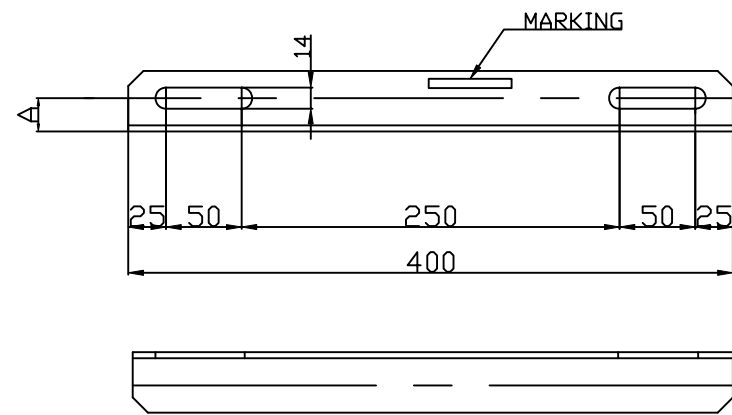

MARK	DESIGNATION	A mm	UNIT MARK kg
201 -202	L 40 X40 X 4	22	0.84
203	L 60 X 60 X 6	35	1.78
204	L 80 X 80 X 8	45	3.85

FROM HE 200 TO HE 240

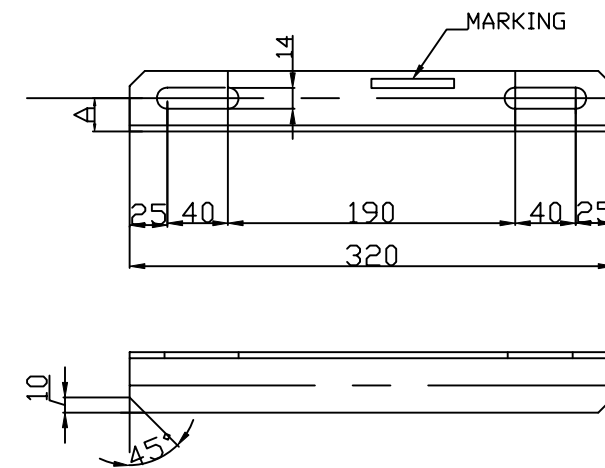


MARK	DESIGNATION	A mm	UNIT MARK kg
101 -102	L 40 X40 X 4	22	0.67
103	L 60 X 60 X 6	35	1.43
104	L 80 X 80 X 8	45	3.08


Note:
 1. Material: S235JR
 2. After welding and drilling will be hot galvanized AT/OL/Zn600-STAS 7221-90.

CONTRASUPORT PENTRU FIBRA OPTICA COUNTERPLATE FOR OPTICAL FIBER	Numele fisierului/ CAD file name:	Scara/ Scale:	Part	Rev.
	01LC00BDG087		1 / 1	0

FROM HE 260 TO 320

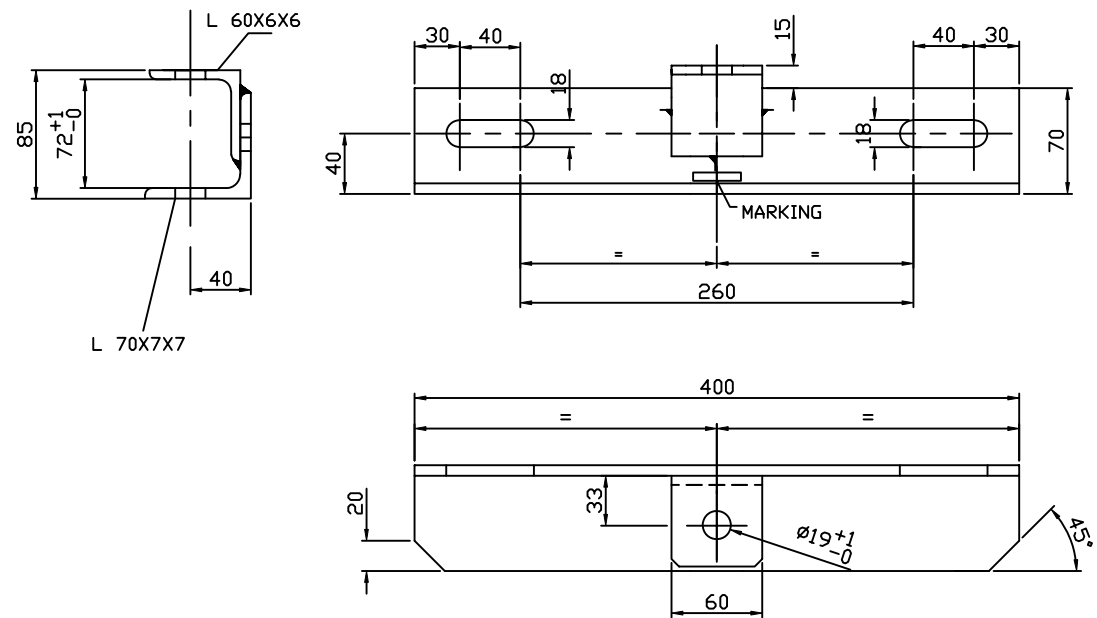

FROM HE 200 TO 240

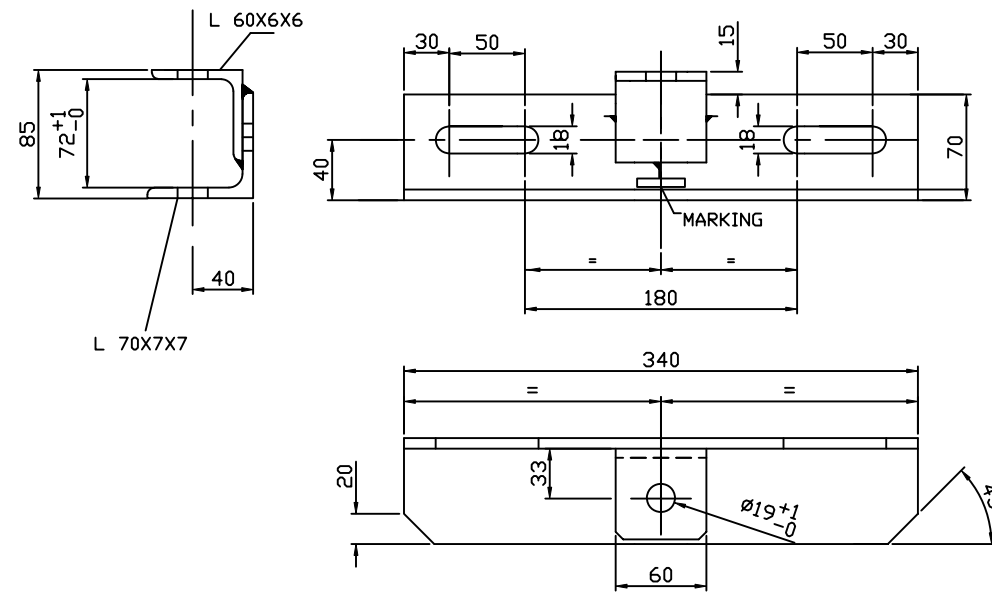

MARK	DESIGNATION
101	FROM HE 200 TO 240
102	FROM HE 260 TO 320

NOTES:

- CONTINUOUS BEAD WATERPROOF WELDS MINIMUM THICKNESS: 3mm
- After welding and drilling will be hot galvanized AT/OL/Zn600-STAS 7221-90.

03LC00BDG088	102	HINGE SUPPORT	S235JR	2.95
03LC00BDG088	101	HINGE SUPPORT	S235JR	2.50
DRAWING NUMBER	MARK	DESIGNATION	MATERIAL TECHNICAL SPECIFICATION	UNIT MASS kg



SUPORT PENTRU BALAMA
HINGE SUPPORT

Numele fisierului/
CAD file name:
01LC00BDG088

Scara/
Scale:

Part
1 / 1



Rev.
0

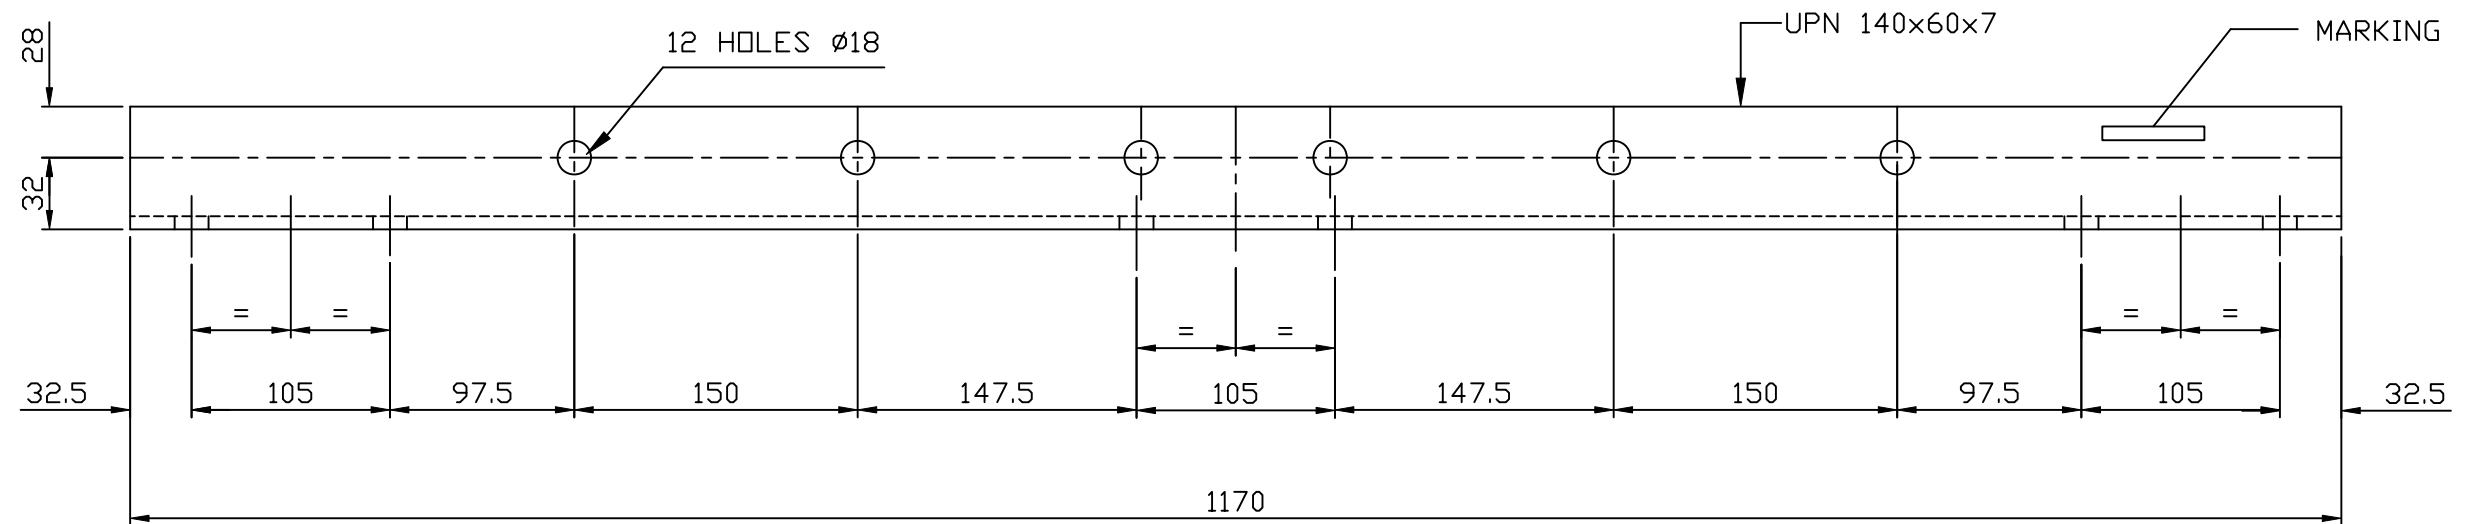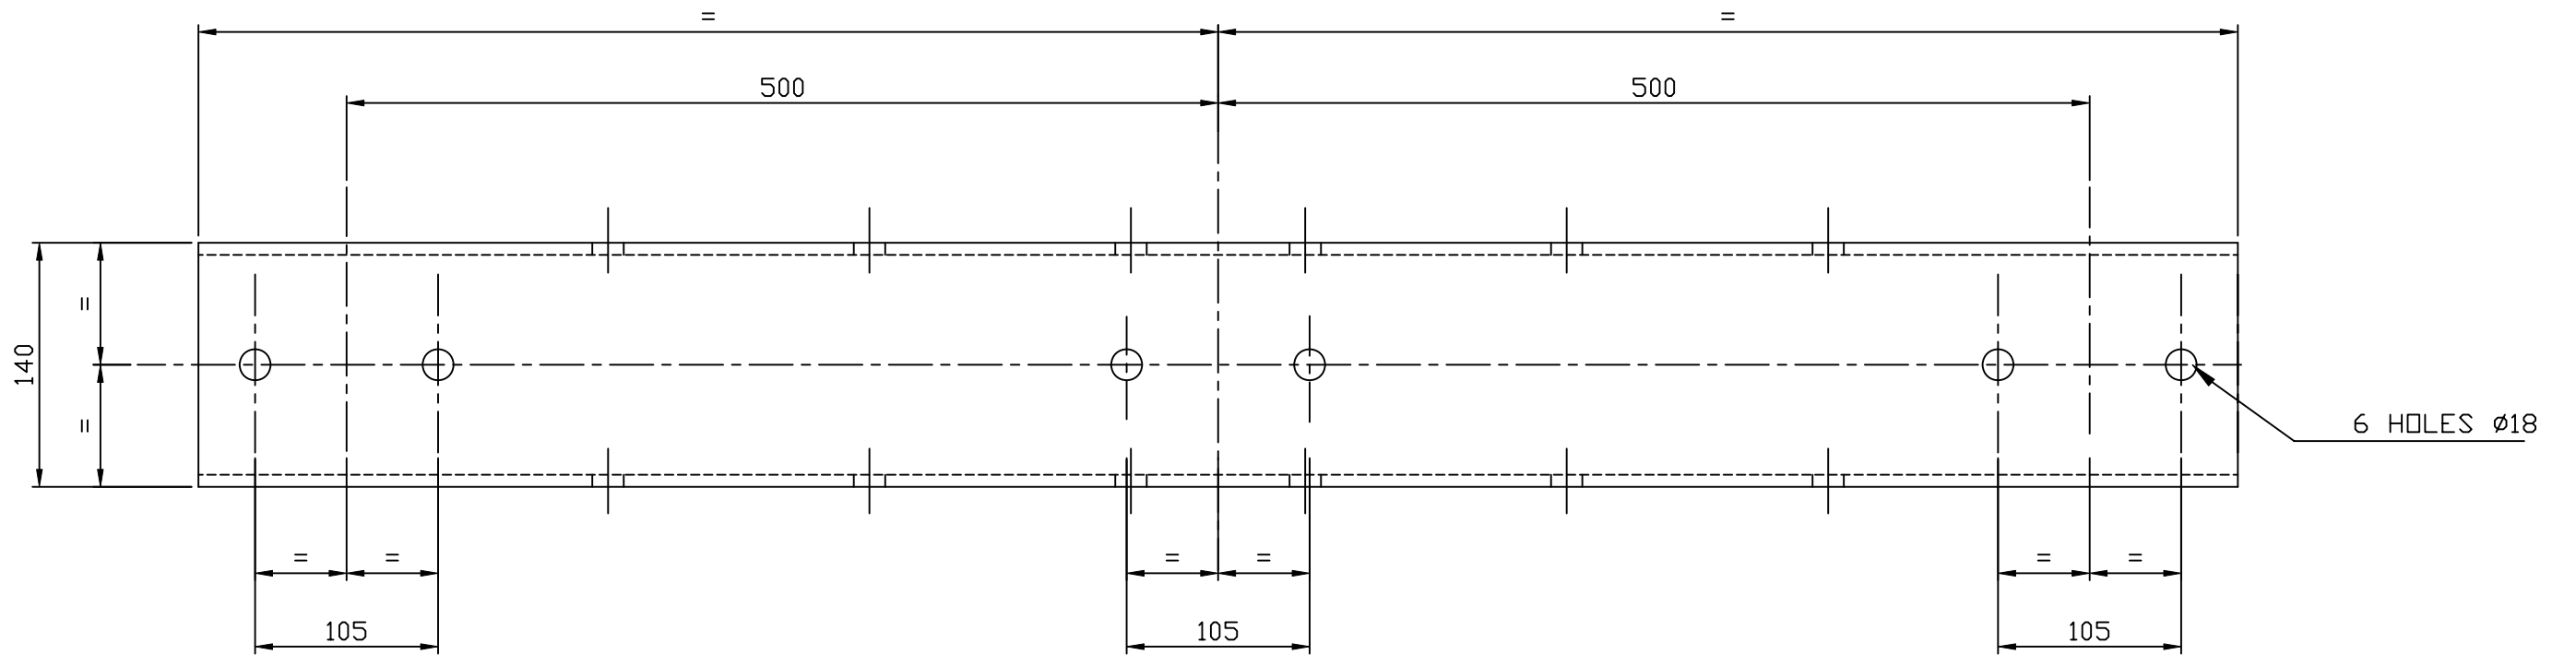

01LC00BDG089	SPREADER (Spacing 1m)	S235JR	21.44
DRAWING NUMBER	MARK	DESIGNATION	MATERIAL TECHNICAL SPECIFICATION	UNIT MASS kg

Note:
After welding and drilling will be
hot galvanized AT/OL/Zn600-STAS 7221-90.

TRAVERSA (distanța 1m) SPREADER (spacing 1m)	Numele fisierului/ CAD file name:	Scara/ Scale:	Part	Rev.
	01LC00BDG089		1 / 1	0

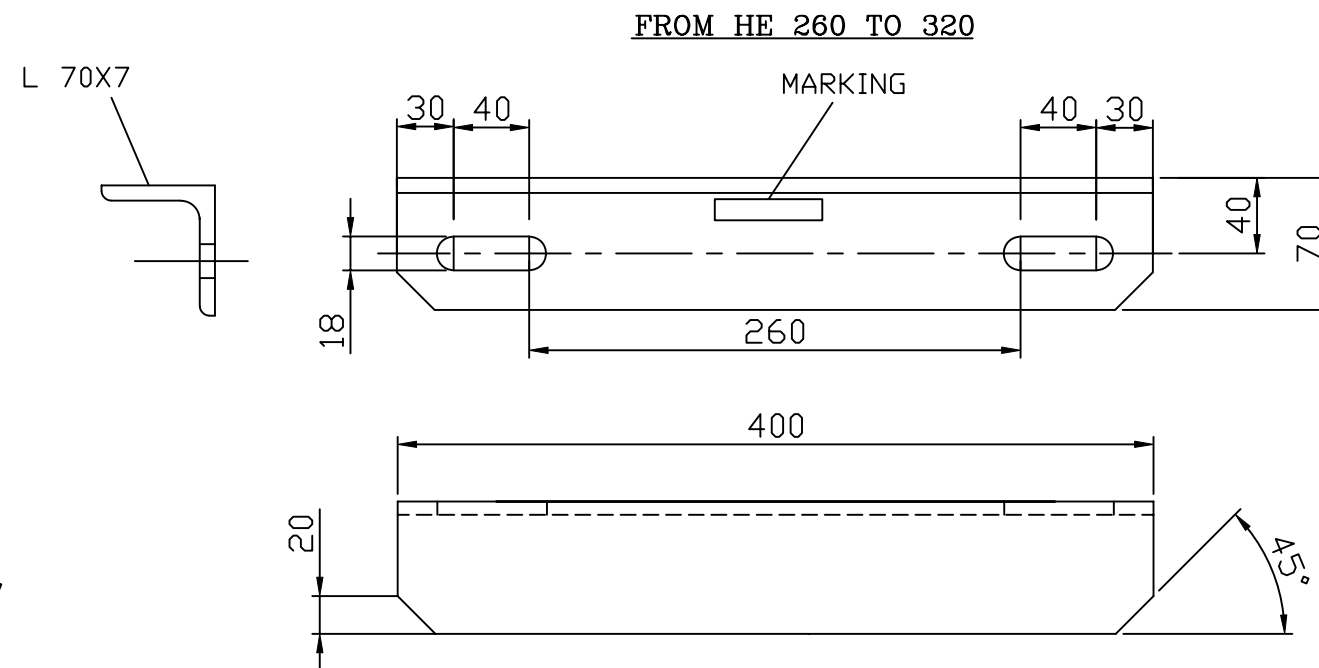
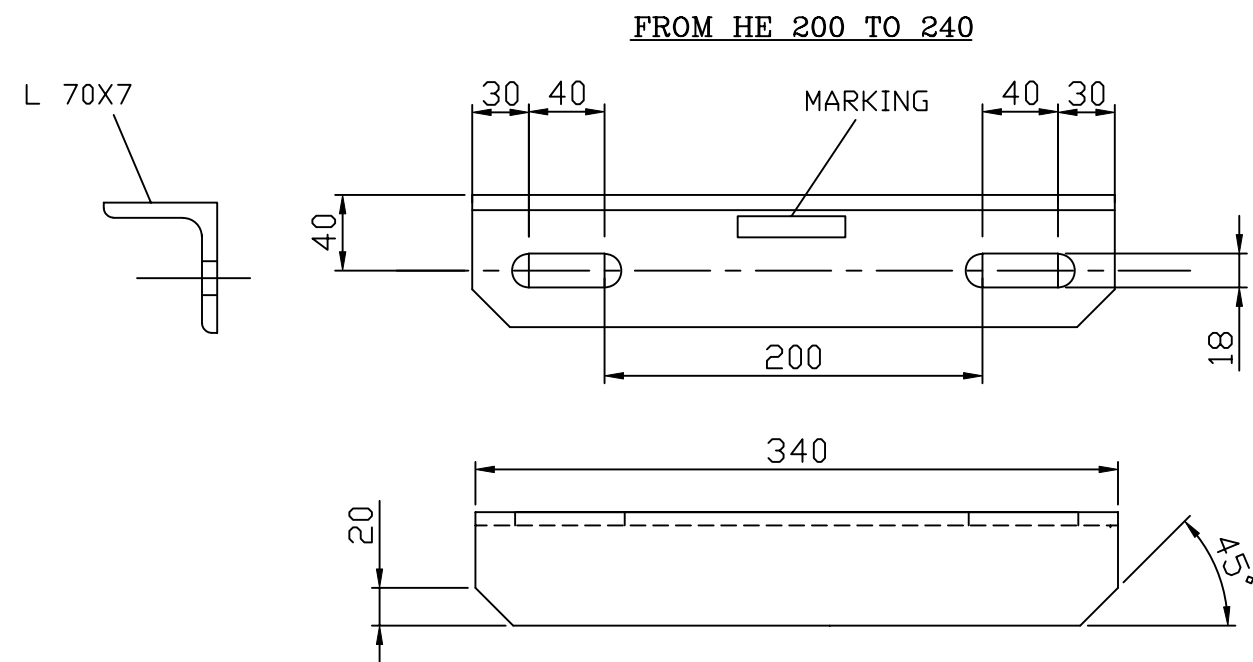


MARK	DESIGNATION
101	FROM HE 200 TO 240
102	FROM HE 260 TO 320

After welding and drilling will
be hot galvanized AT/OL/Zn600-STAS 7221-90.

01LC00BDG090	102	COUNTERPLATE (L 70*70*7)	S235JR	3.36
01LC00BDG090	101	COUNTERPLATE (L 70*70*7)	S235JR	2.86
DRAWING NUMBER	MARK	DESIGNATION	MATERIAL TECHNICAL SPECIFICATION	UNIT MASS kg

CONTRASUPORT PENTRU TIRANT SI CONTRAFISA COUNTRPLATE FOR TOP AND STRUT TUBE	Numele fisierului/ CAD file name:	Scara/ Scale:	Part	Rev.
	01LC00BDG090		1 / 1	0

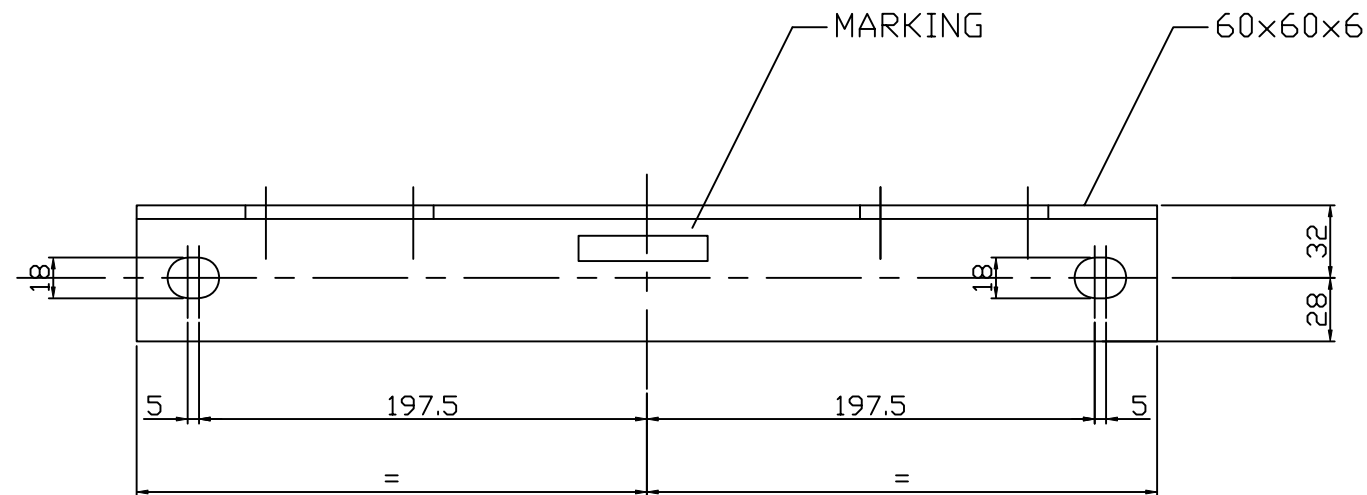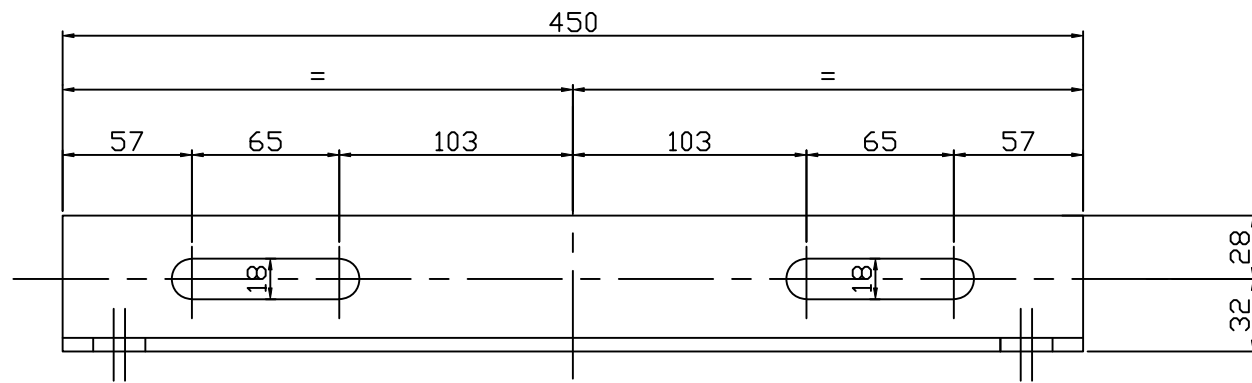


After welding and drilling will be hot galvanized AT/OL/Zn600-STAS 7221-90.

01LC00BDG094	...	COUNTERPLATE (L 60*60*6)	S235JR	2.3
DRAWING NUMBER	MARK	DESIGNATION	MATERIAL TECHNICAL SPECIFICATION	UNIT MASS kg

Contrasuport for spreader (pentru HE200 la HE320)
Counterplate for spreader (for HE200 to HE320)


Numele fisierului/ CAD file name:	Scara/ Scale:	Part	Rev.
01LC00BDG094	1 / 1	0	

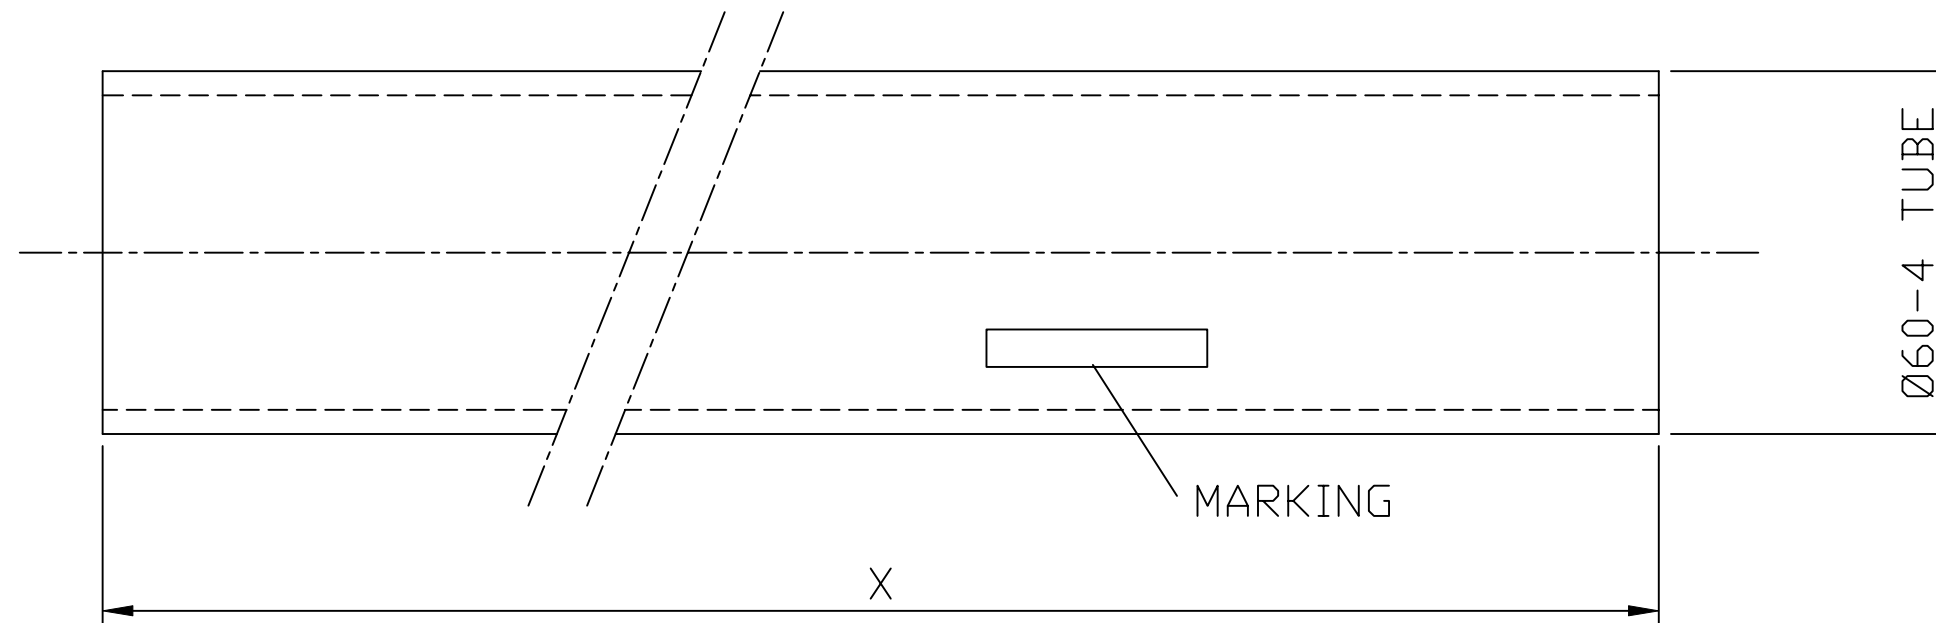

After welding and drilling will be hot galvanized AT/OL/Zn600-STAS 7221-90.


01LC00BDG095		$\varnothing 60-4$ TUBE FOR TOP TUBE	S355JOH	5.50 kg/m
DRAWING NUMBER	MARK	DESIGNATION	MATERIAL TECHNICAL SPECIFICATION	UNIT MASS kg

TEAVA $\varnothing 60-4$ PENTRU TIRANT $\varnothing 60-4$ TUBE FOR TOP TUBE	Numele fisierului/ CAD file name:	Scara/ Scale:	Part	Rev.
	01LC00BDG095		1 / 1	0

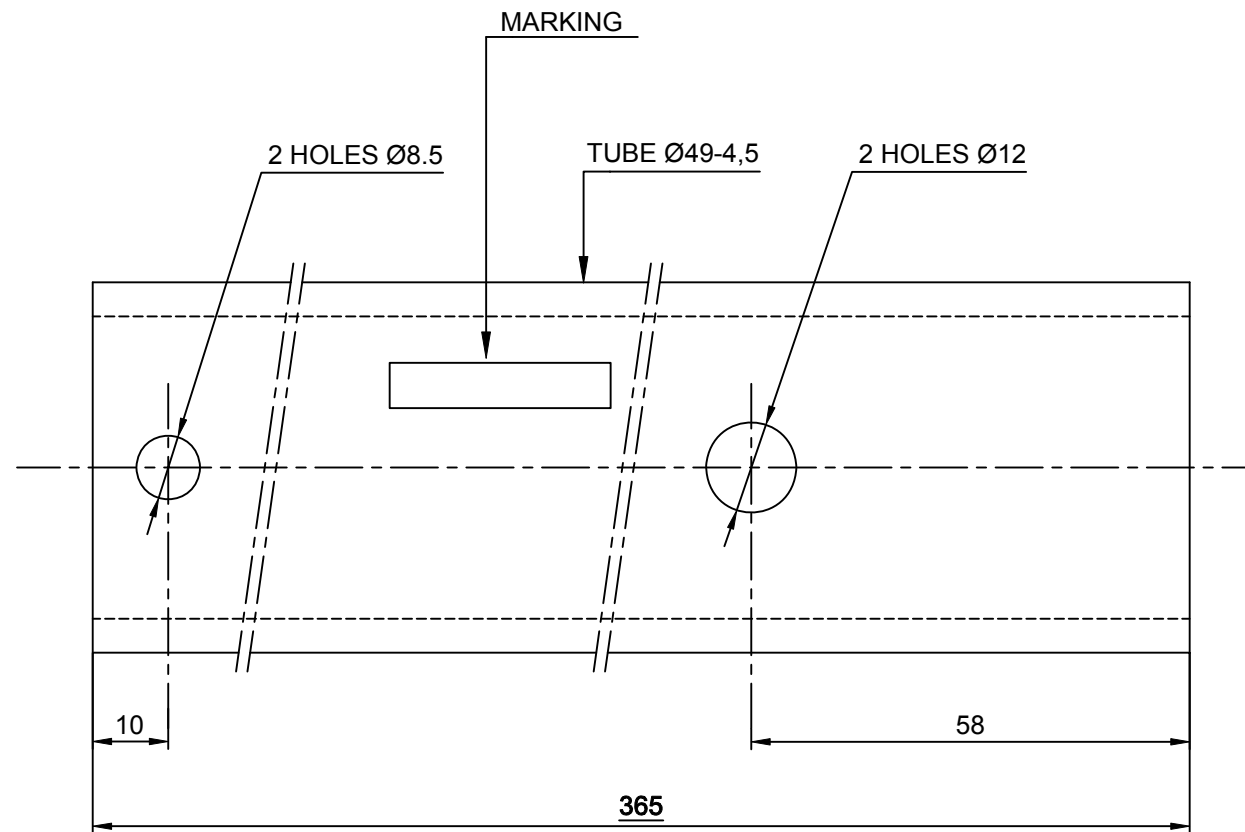

01LC00BDG100	---	Ø49-4.5 TUBE FOR STEADY ARM FASTENING	S355JDH	1.85
DRAWING NUMBER	MARK	DESIGNATION	MATERIAL TECHNICAL SPECIFICATION	UNIT MASS kg

TEAVA Ø49-4.5 PENTRU FIXARE FIXATOR Ø49-4.5 TUBE FOR STEADY ARM FASTENING	Numele fisierului/ CAD file name:	Scara/ Scale:	Part	Rev.
	01LC00BDG100		1 / 1	0

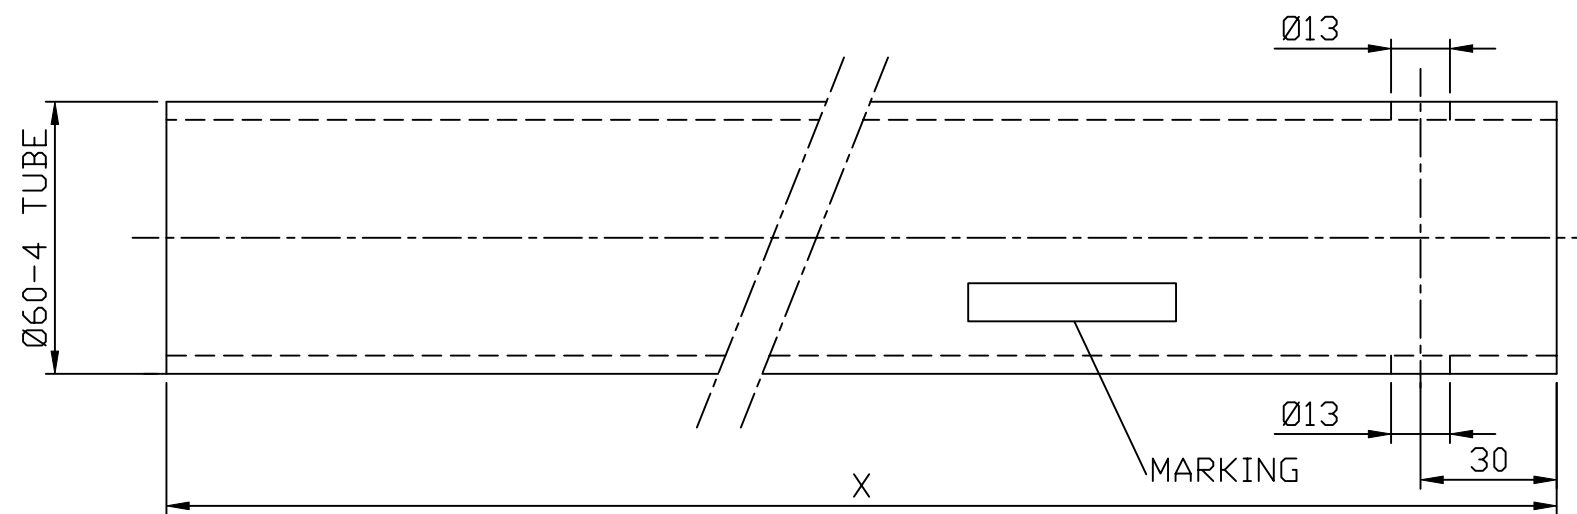

After welding and drilling will be hot galvanized AT/OL/Zn600-STAS 7221-90.

01LC00BDG101		$\varnothing 60-4$ TUBE FOR STRUT TUBE	S355JDH	5.50 kg/m
DRAWING NUMBER	MARK	DESIGNATION	MATERIAL TECHNICAL SPECIFICATION	UNIT MASS kg


TEAVA $\varnothing 60-4$ PENTRU CONTRAFISA
 $\varnothing 60-4$ TUBE FOR STRUT TUBE

Numele fisierului/
CAD file name:
01LC00BDG101




Scara/
Scale:

Part	Rev.
1 / 1	0

MARK 102
FROM HE 260 TO 320

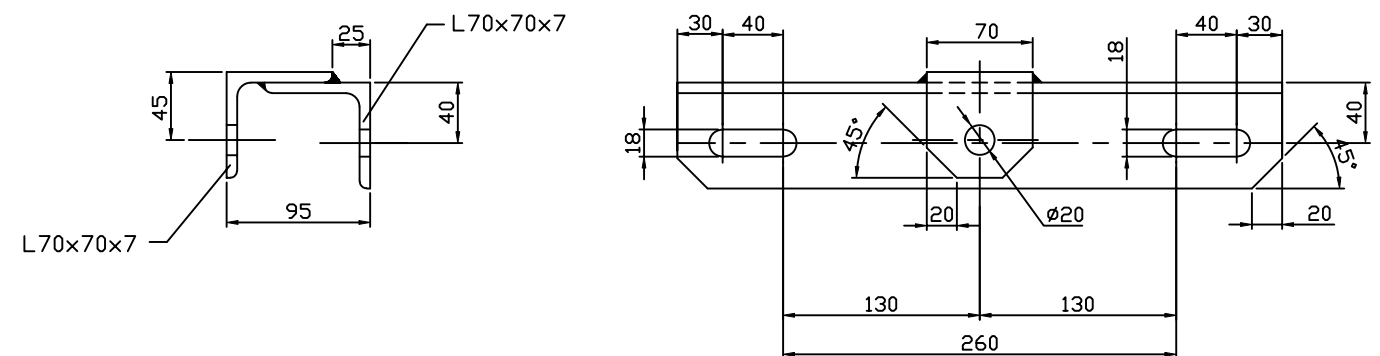

MARK 101
FROM HE 200 TO 240

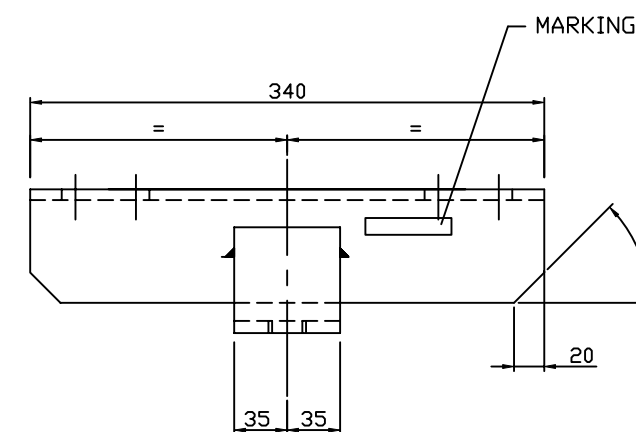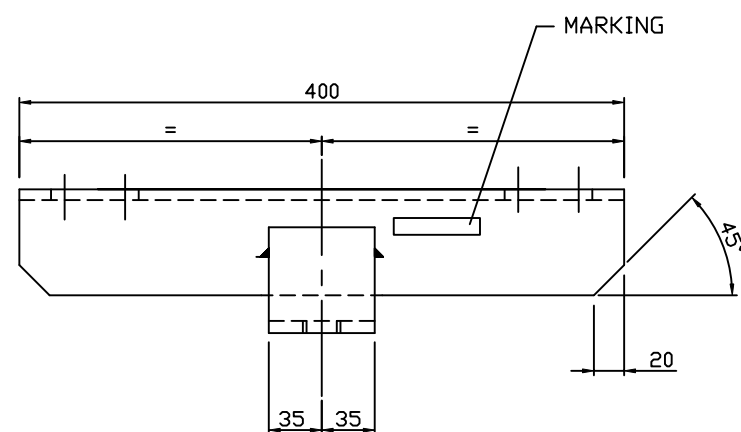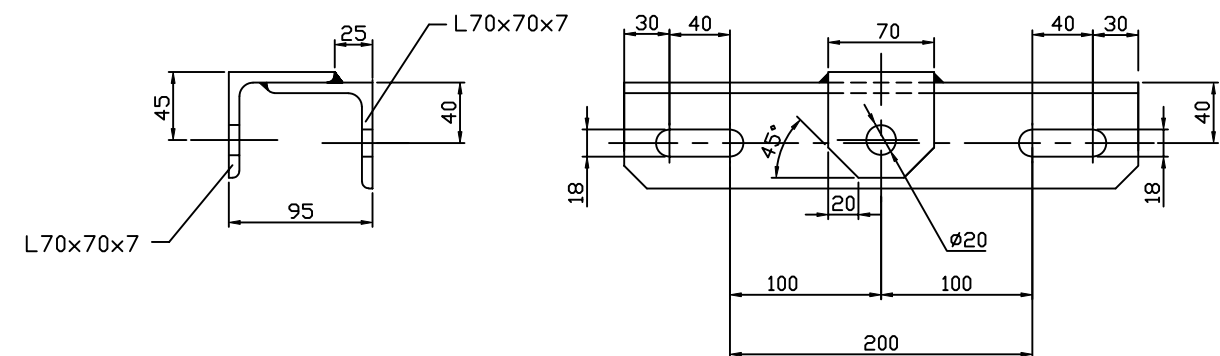

NOTES:



1. CONTINUOUS BEAD WATERPROOF WELDS MINIMUM THICKNESS: 5mm
2. After welding and drilling will be hot galvanized AT/OL/Zn600-STAS 7221-90.

01LC00BDG102	102	COUNTERPLATE FOR STRUT TUBE	S235JR	3.5
01LC00BDG102	101	COUNTERPLATE FOR STRUT TUBE	S235JR	3.1
DRAWING NUMBER	MARK	DESIGNATION	MATERIAL TECHNICAL SPECIFICATION	UNIT MASS kg

CONTRASUPORT CU FIXAREA CABLULUI COLECTOR COUNTERPLATE WITH EARTHING CONDUCTOR	Numele fisierului/ CAD file name:	Scara/ Scale:	Part	Rev.
	01LC00BDG102		1 / 1	0

FROM HE 260 TO HE 320

FROM HE 200 TO HE 240

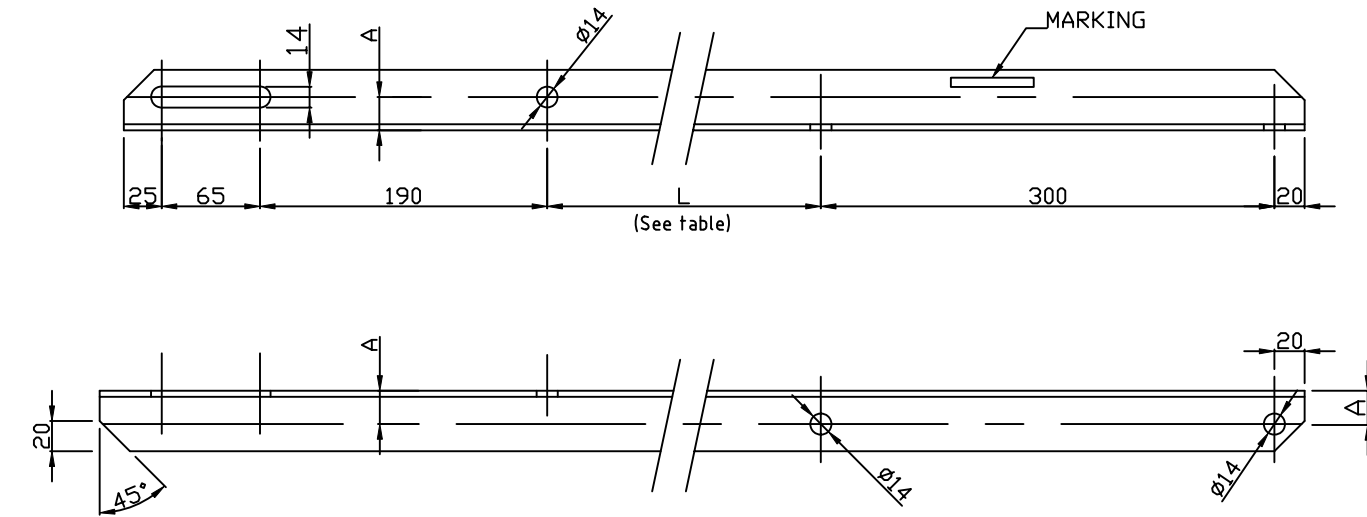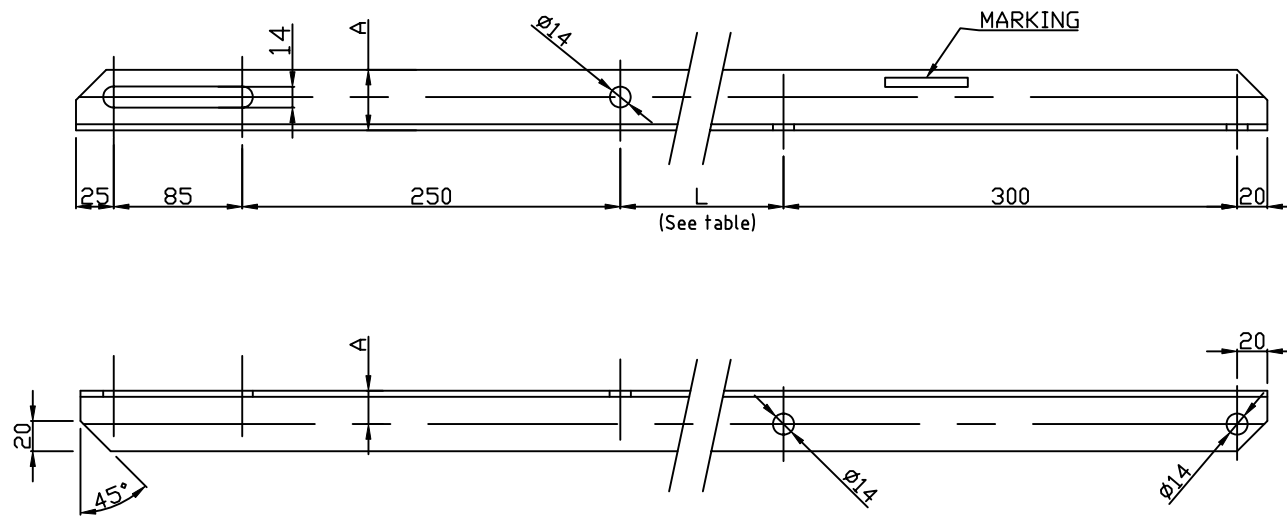

MARK	DESIGNATION	A mm	L mm	UNIT MARK kg
211	L 60X60X6	35	410	5.86
212	L 80X80X8	45	600	12.24
213	L 80X80X8	45	1000	16.1


MARK	DESIGNATION	A mm	L mm	UNIT MARK kg
111	L 60X60X6	35	410	5.46
112	L 80X80X8	45	600	11.54
113	L 80X80X8	45	1000	15.39

Note: 1. Material : S235JR
 2. After welding and drilling will be hot galvanized
 AT/OL/Zn600-STAS 7221-90.

SUPPORT PENTRU DOUA FIBRE OPTICE SUPPORT FOR TWO OPTICAL FIBERS	Numele fisierului/ CAD file name:	Scara/ Scale:	Part	Rev.
	01LC00BDG106		1 / 1	0


FROM HEA or HEB 260 TO 320

221

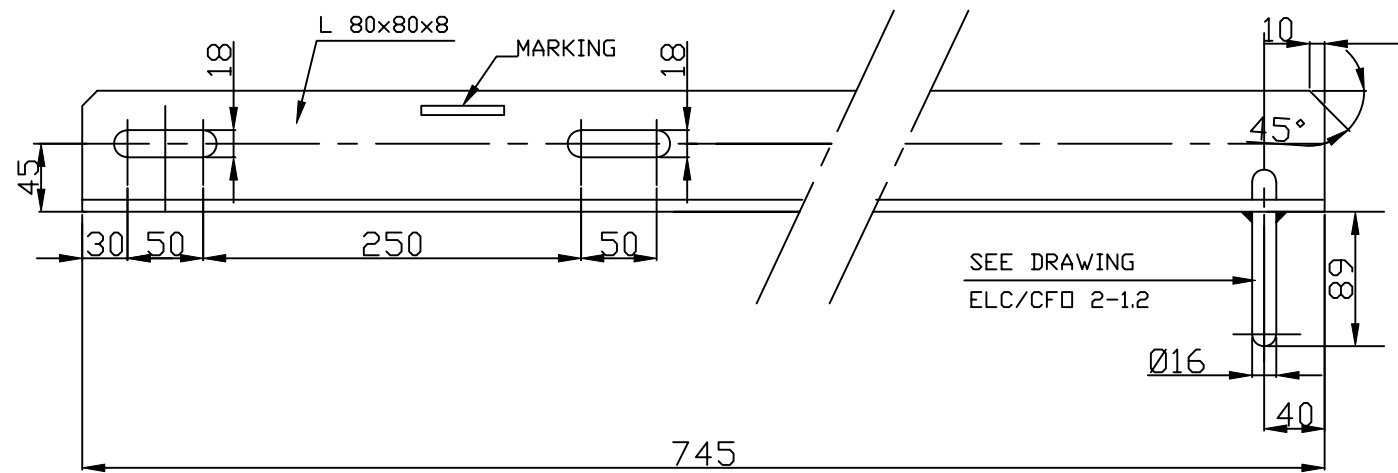

FROM HEA or HEB 200 TO 240

121

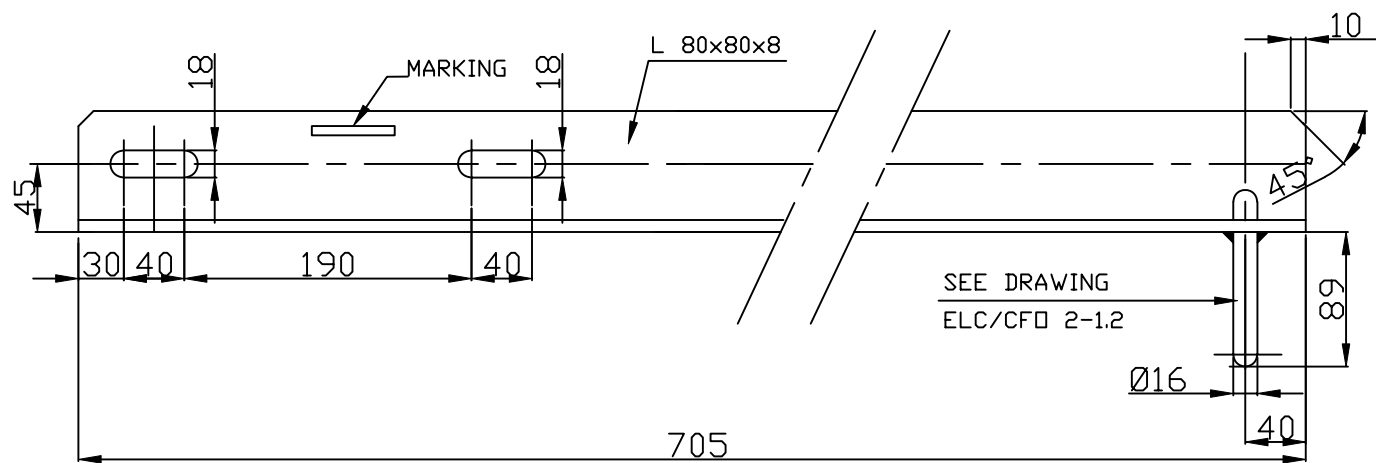

NOTE:


1. CONTINUOUS BEAD WATERPROOF WELDS MINIMUM THICKNESS: 8mm
2. After welding and drilling will be hot galvanized AT/OL/Zn600-STAS 7221-90.

01LC00BDG107	221	SUPPORT FOR OPTICAL FIBER ANCHORING	S235JR	7.17
01LC00BDG107	121	SUPPORT FOR OPTICAL FIBER ANCHORING	S235JR	6.78
DRAWING NUMBER	MARK	DESIGNATION	MATERIAL TECHNICAL SPECIFICATION	UNIT MASS kg

SUPPORT PENTRU ANCORAREA FIBREI OPTICE SUPPORT FOR OPTICAL FIBER ANCHORING	Numele fisierului/ CAD file name:	Scara/ Scale:	Part	Rev.
	01LC00BDG107		1 / 1	0

FROM HEA or HEB 260 TO 320

221

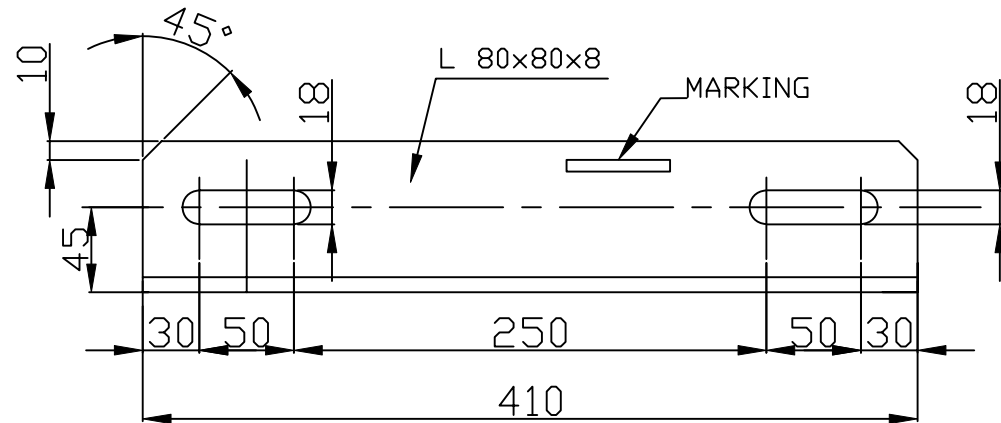


After welding and drilling will be hot galvanized AT/OL/Zn600-STAS 7221-90.



01LC00BDG113	221	COUNTERPLATE FOR OPTICAL FIBER ANCHORING	S235JR	3.94
01LC00BDG113	121	COUNTERPLATE FOR OPTICAL FIBER ANCHORING	S235JR	3.17
DRAWING NUMBER	MARK	DESIGNATION	MATERIAL TECHNICAL SPECIFICATION	UNIT MASS kg

FROM HEA or HEB 200 TO 240

121

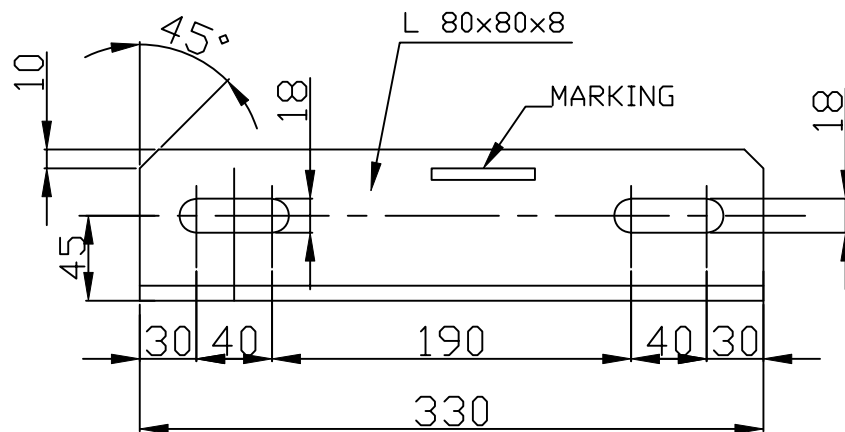

CONTRASUPT PENTRU ANCORAREA FIBREI OPTICE COUNTERPLATE FOR OPTICAL FIBER ANCHORING	Numele fisierului/ CAD file name:	Scara/ Scale:	Part	Rev.
	01LC00BDG113		1 / 1	0

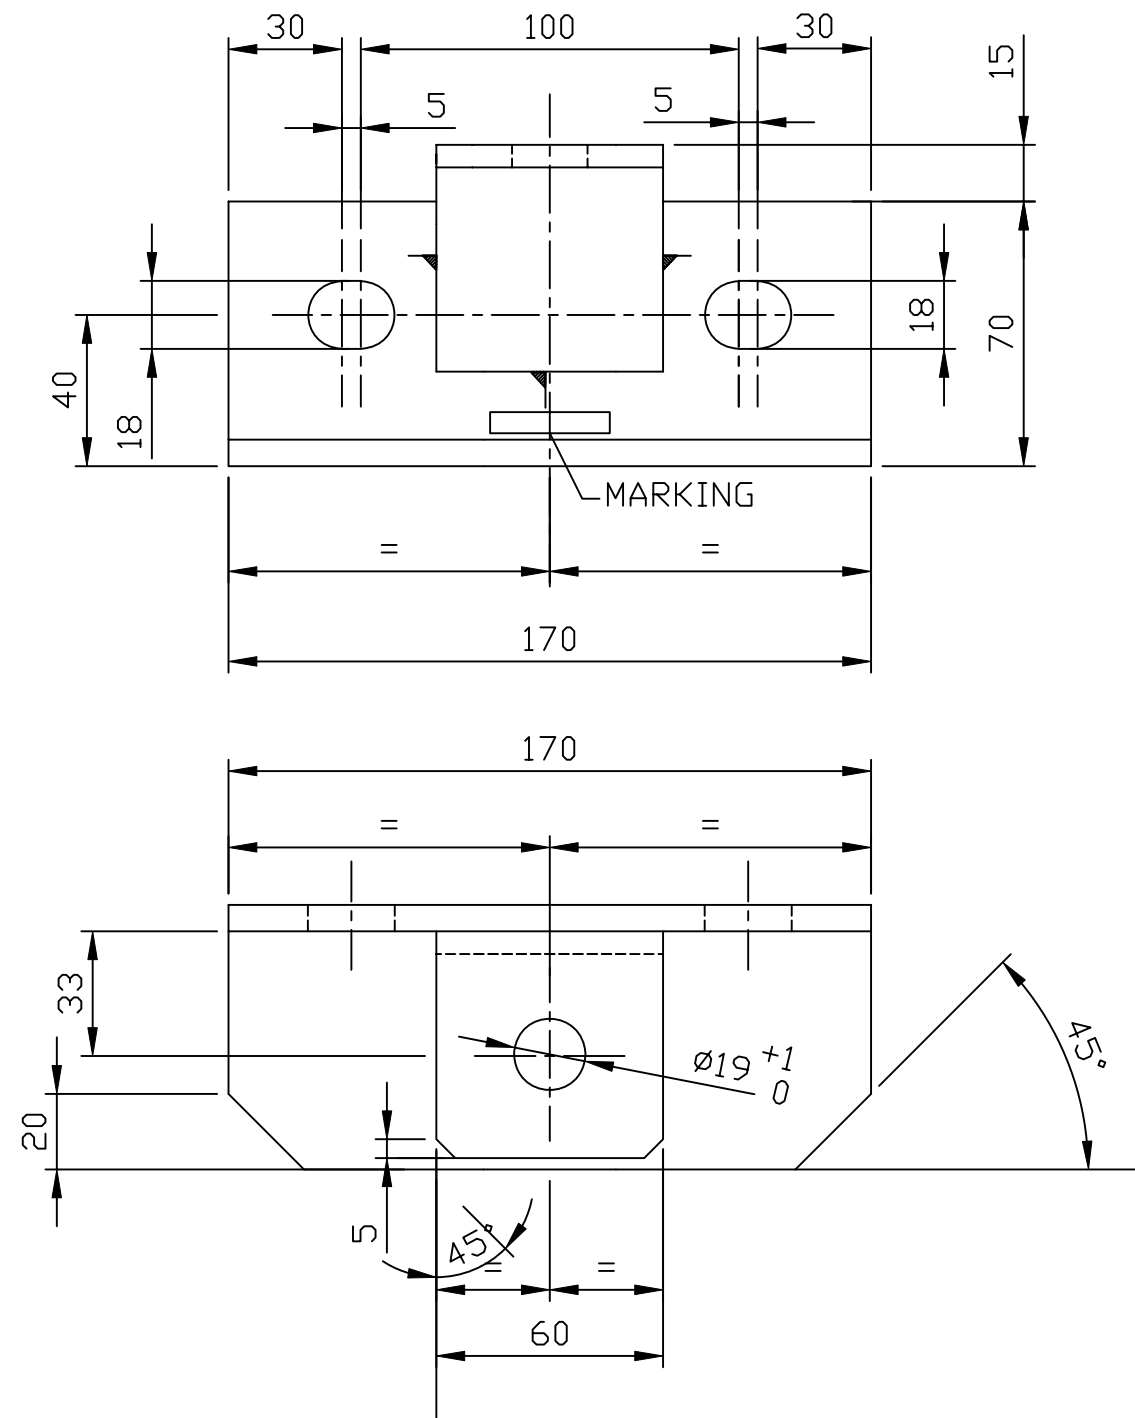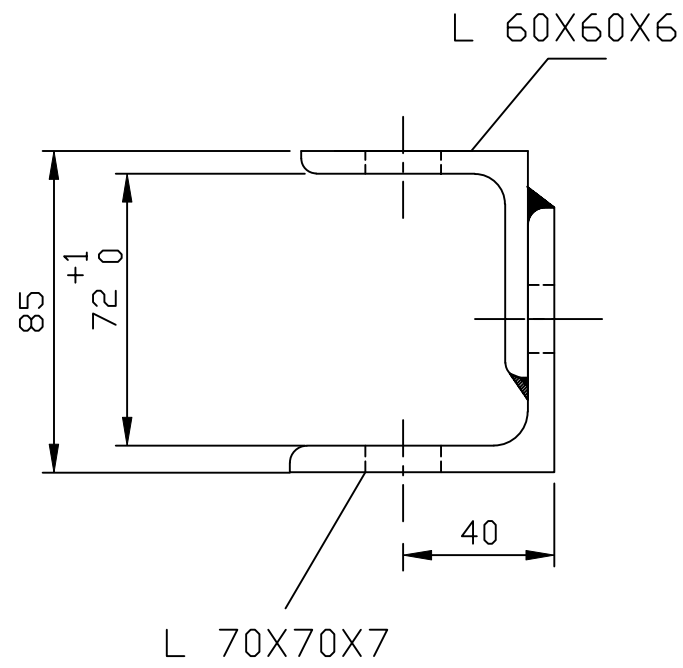


NOTE:

1. CONTINUOUS BEAD WATERPROOF WELDS MINIMUM THICKNESS: 3mm
2. After welding and drilling will be hot galvanized AT/OL/Zn600-STAS 7221-90.

01LC00BDG114		HINGE SUPPORT FOR 2 OR 3 TUBES	S235JR	1.57
DRAWING NUMBER	MARK	DESIGNATION	MATERIAL TECHNICAL SPECIFICATION	UNIT MASS kg


SUPPORT BALAMA PENTRU 2 SAU 3 CONSOLE HINGE SUPPORT FOR 2 OR 3 TUBES	Numele fisierului/ CAD file name:	Scara/ Scale:	Part	Rev.
	01LC00BDG114		1 / 1	0

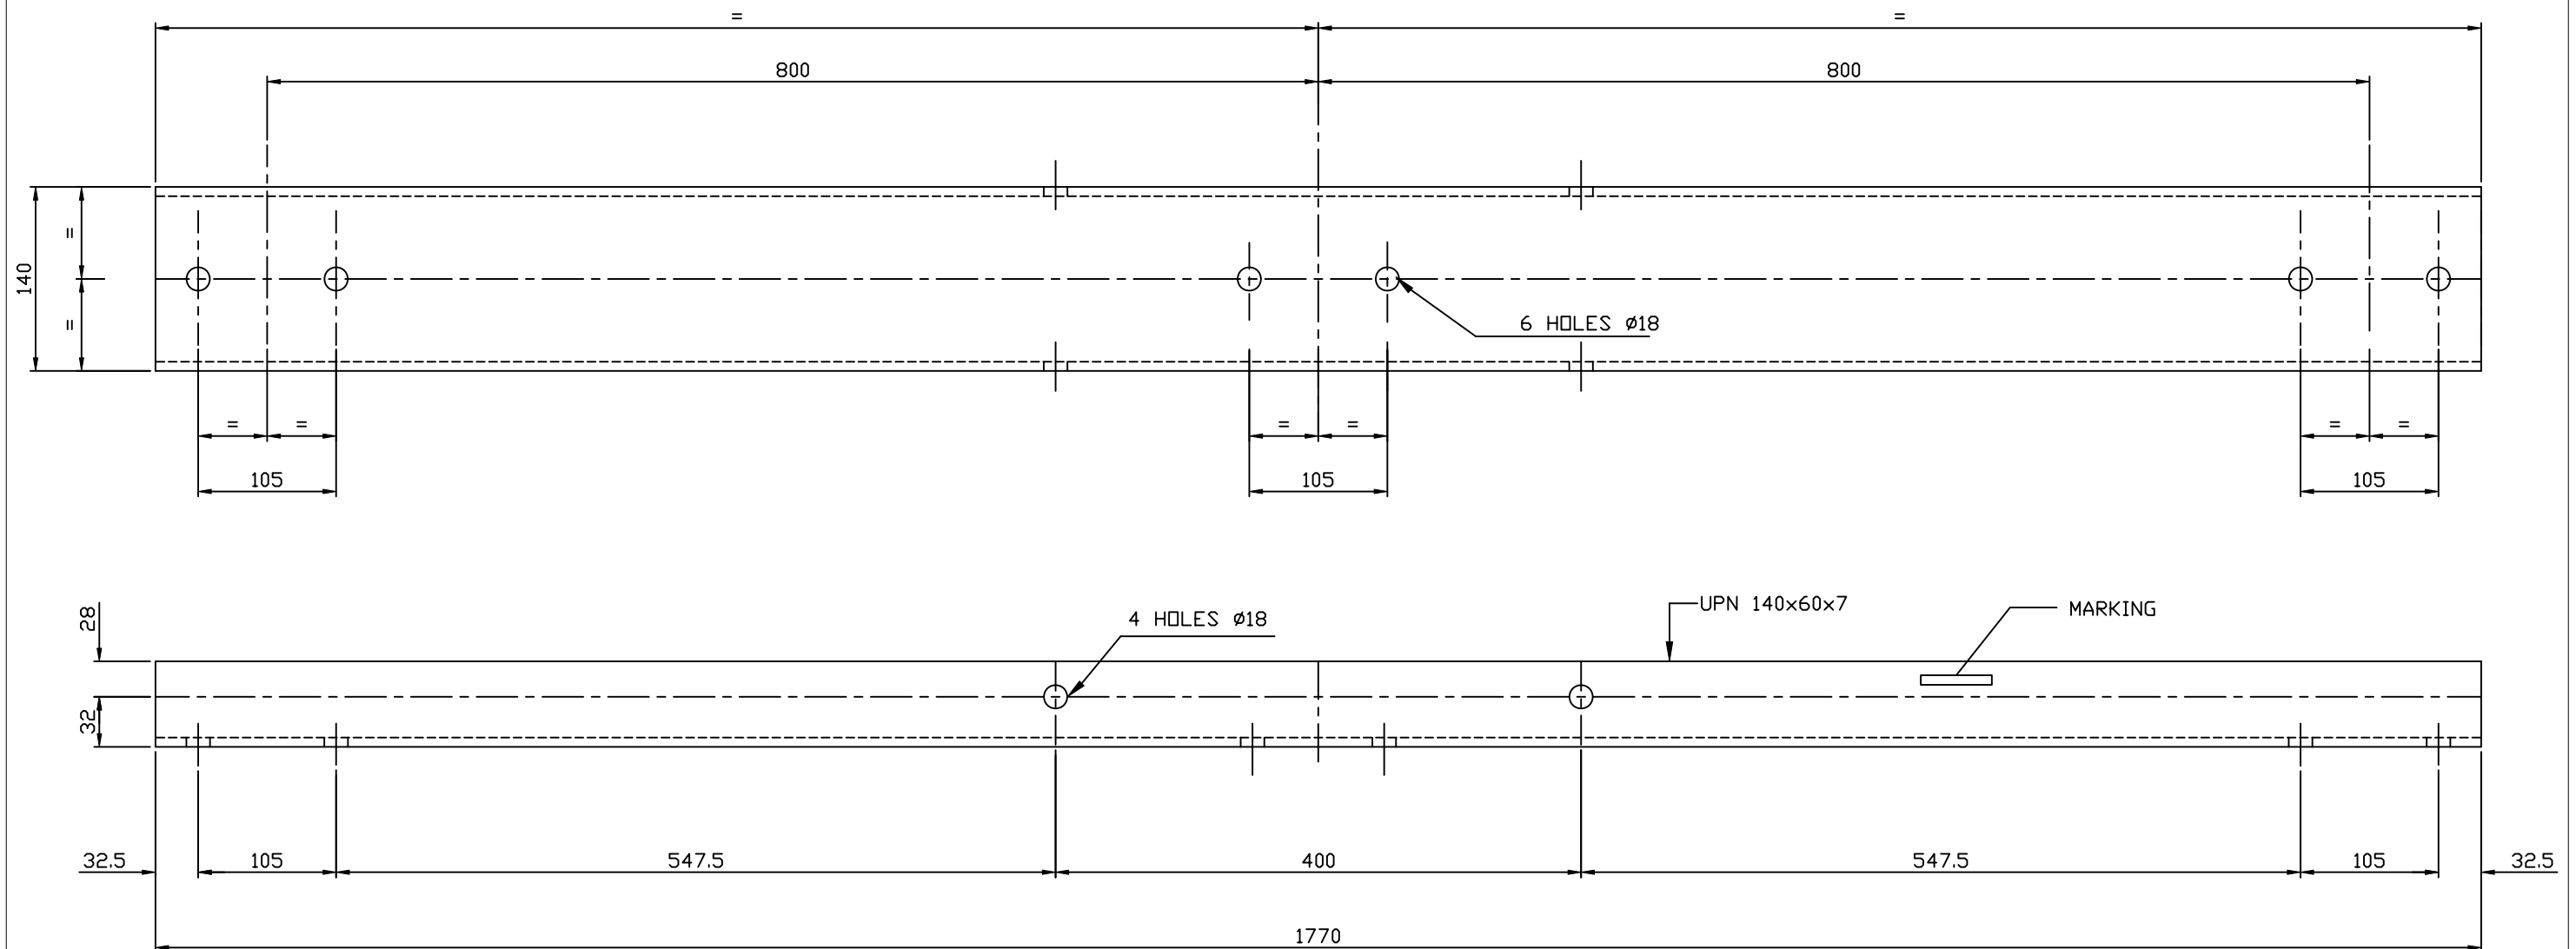


After welding and drilling will be hot galvanized AT/OL/Zn600-STAS 7221-90.

01LC00BDG115	SPREADER (spacing 1.60m)	S235JR	25.6
DRAWING NUMBER	MARK	DESIGNATION	MATERIAL TECHNICAL SPECIFICATION	UNIT MASS kg

TRAVESRA (distanța 1.60m) SPREADER (spacing 1.60m)	Numele fisierului/ CAD file name:	Scara/ Scale:	Part	Rev.
	01LC00BDG115		1 / 1	0

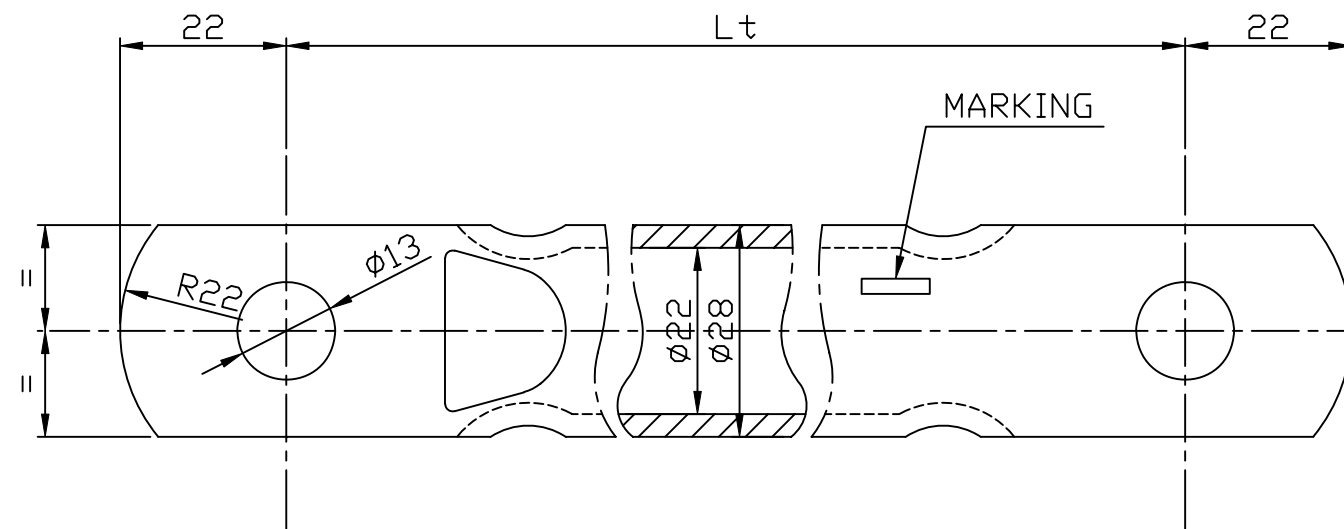


ORIGINAL EXECUTION BEFORE REALISATION

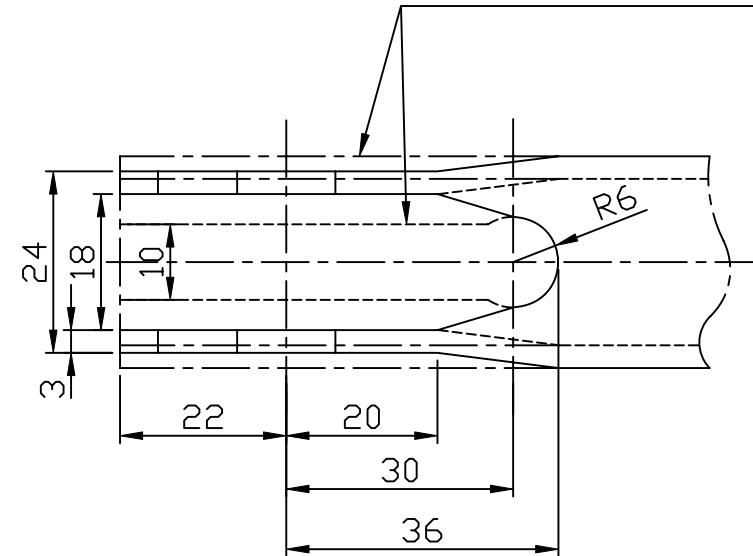

01LC00BDG116	-	TUBE 28-3	03LC00BDG022 REF.63&72	1,85 kg/m
DRAWING NUMBER	MARK	DESIGNATION	MATERIAL TECHNICAL SPECIFICATION	UNIT MASS kg

TEAVA $\phi 28-3$
TUBE $\phi 28-3$

Numele fisierului/ CAD file name:	Scara/ Scale:	Part	Rev.
01LC00BDG116		1 / 1	0

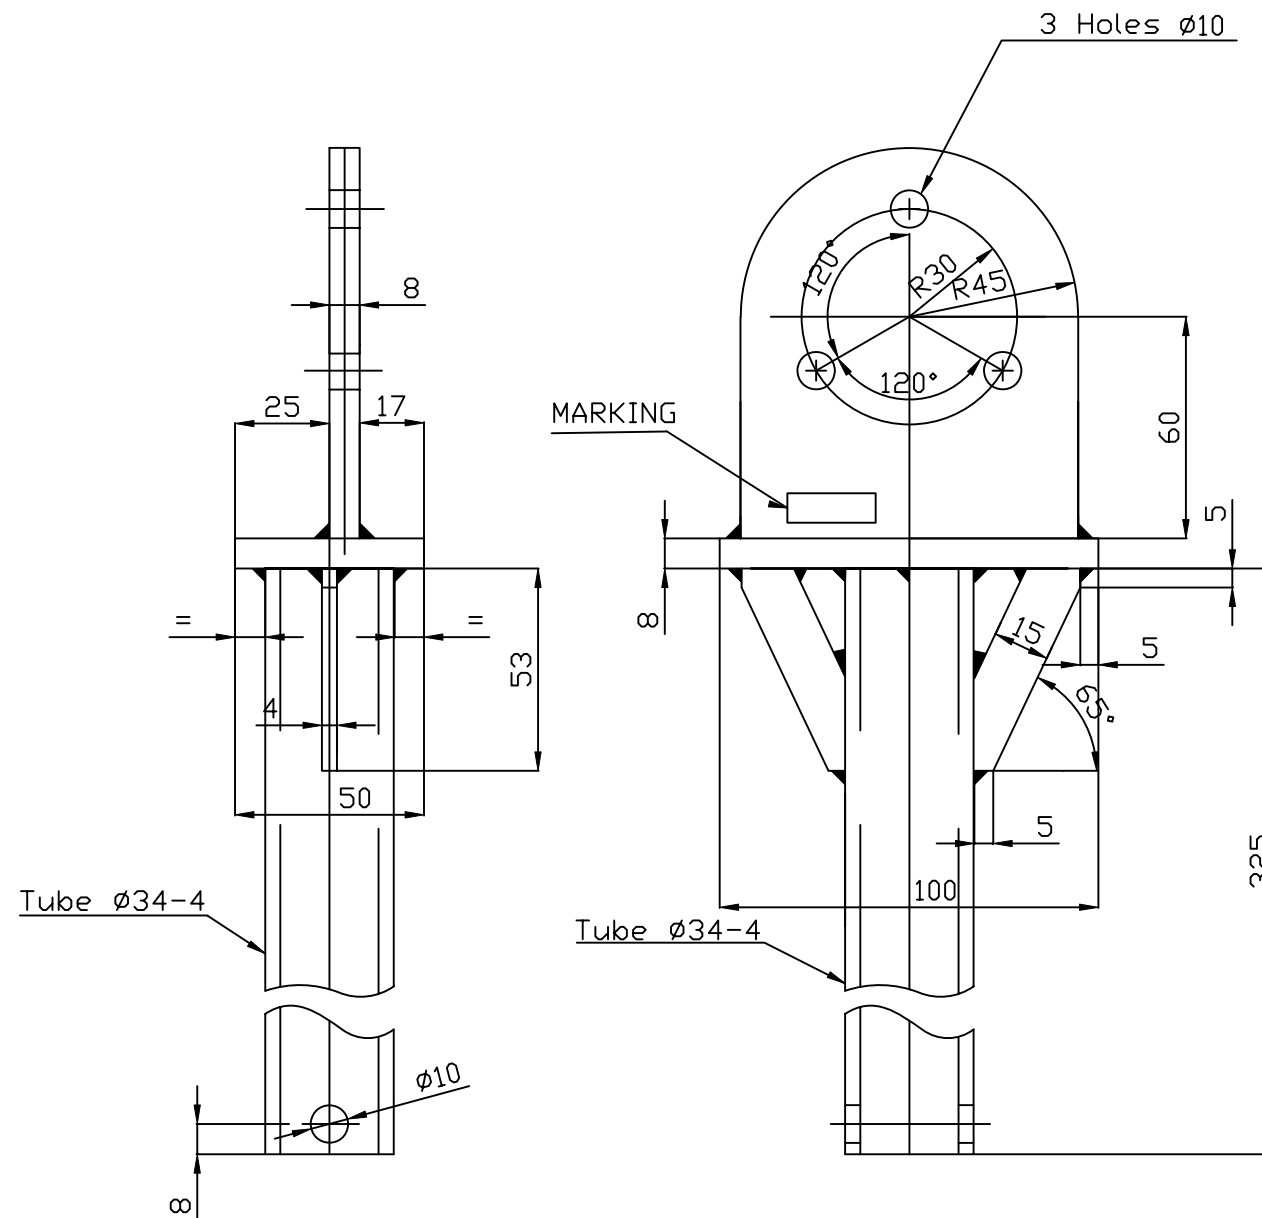


NOTE:

Continuous bead waterproof welds minimum thickness: 3mm and 5mm
 After welding and drilling will be hot galvanized AT/OL/Zn600-STAS 7221-90.

01LC00BDG117		ROTATING STAND OFF BRACKET	S235JR	2.9
DRAWING NUMBER	MARK	DESIGNATION	MATERIAL TECHNICAL SPECIFICATION	UNIT MASS kg

SUPPORT ROTATIV ROTATING STAND OFF BRACKET	Numele fisierului/ CAD file name:	Scara/ Scale:	Part	Rev.
	01LC00BDG117		1 / 1	0


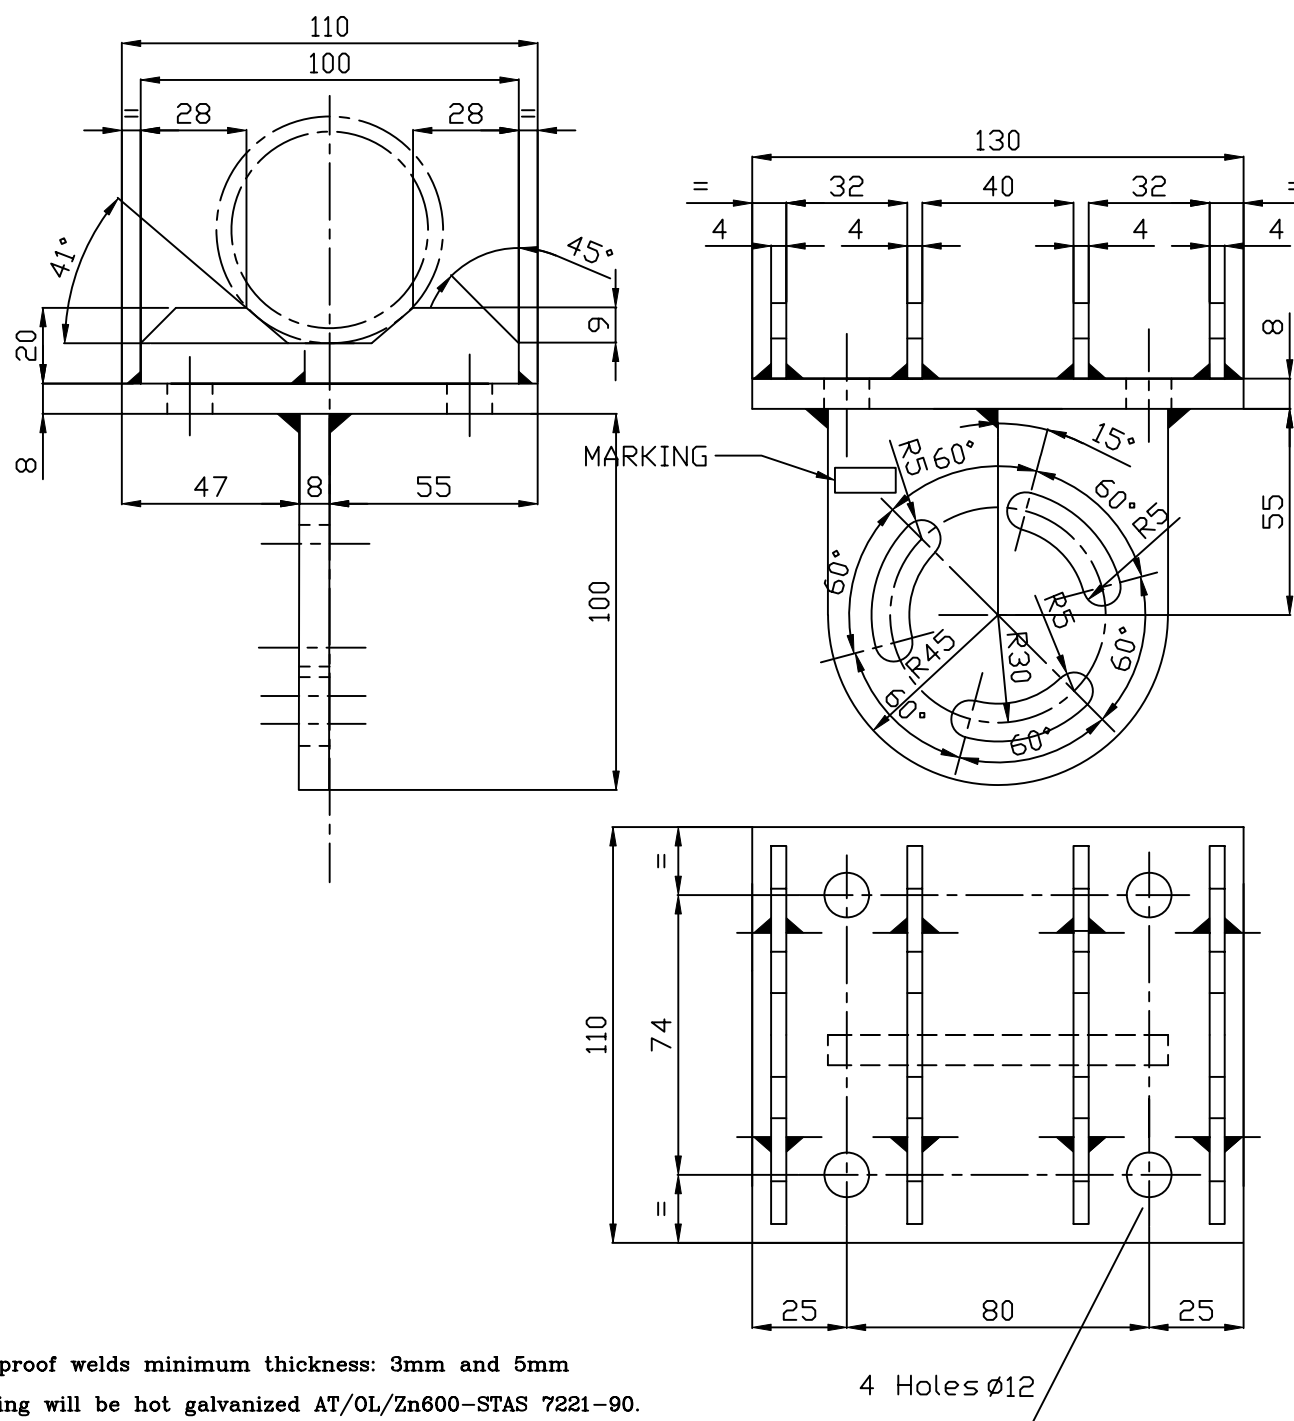


NOTE:

Continuous bead waterproof welds minimum thickness: 3mm and 5mm
 After welding and drilling will be hot galvanized AT/OL/Zn600-STAS 7221-90.

01LC00BDG118		ROTATING HALF FLANGE FOR TUBE $\phi 60-4$	S235JR	1.75
DRAWING NUMBER	MARK	DESIGNATION	MATERIAL TECHNICAL SPECIFICATION	UNIT MASS kg

FLANSA ROTATIVA PENTRU TEAVA $\phi 60-4$ ROTATING HALF FLANGE FOR TUBE $\phi 60-4$	Numele fisierului/ CAD file name:	Scara/ Scale:	Part	Rev.
	01LC00BDG118		1 / 1	0

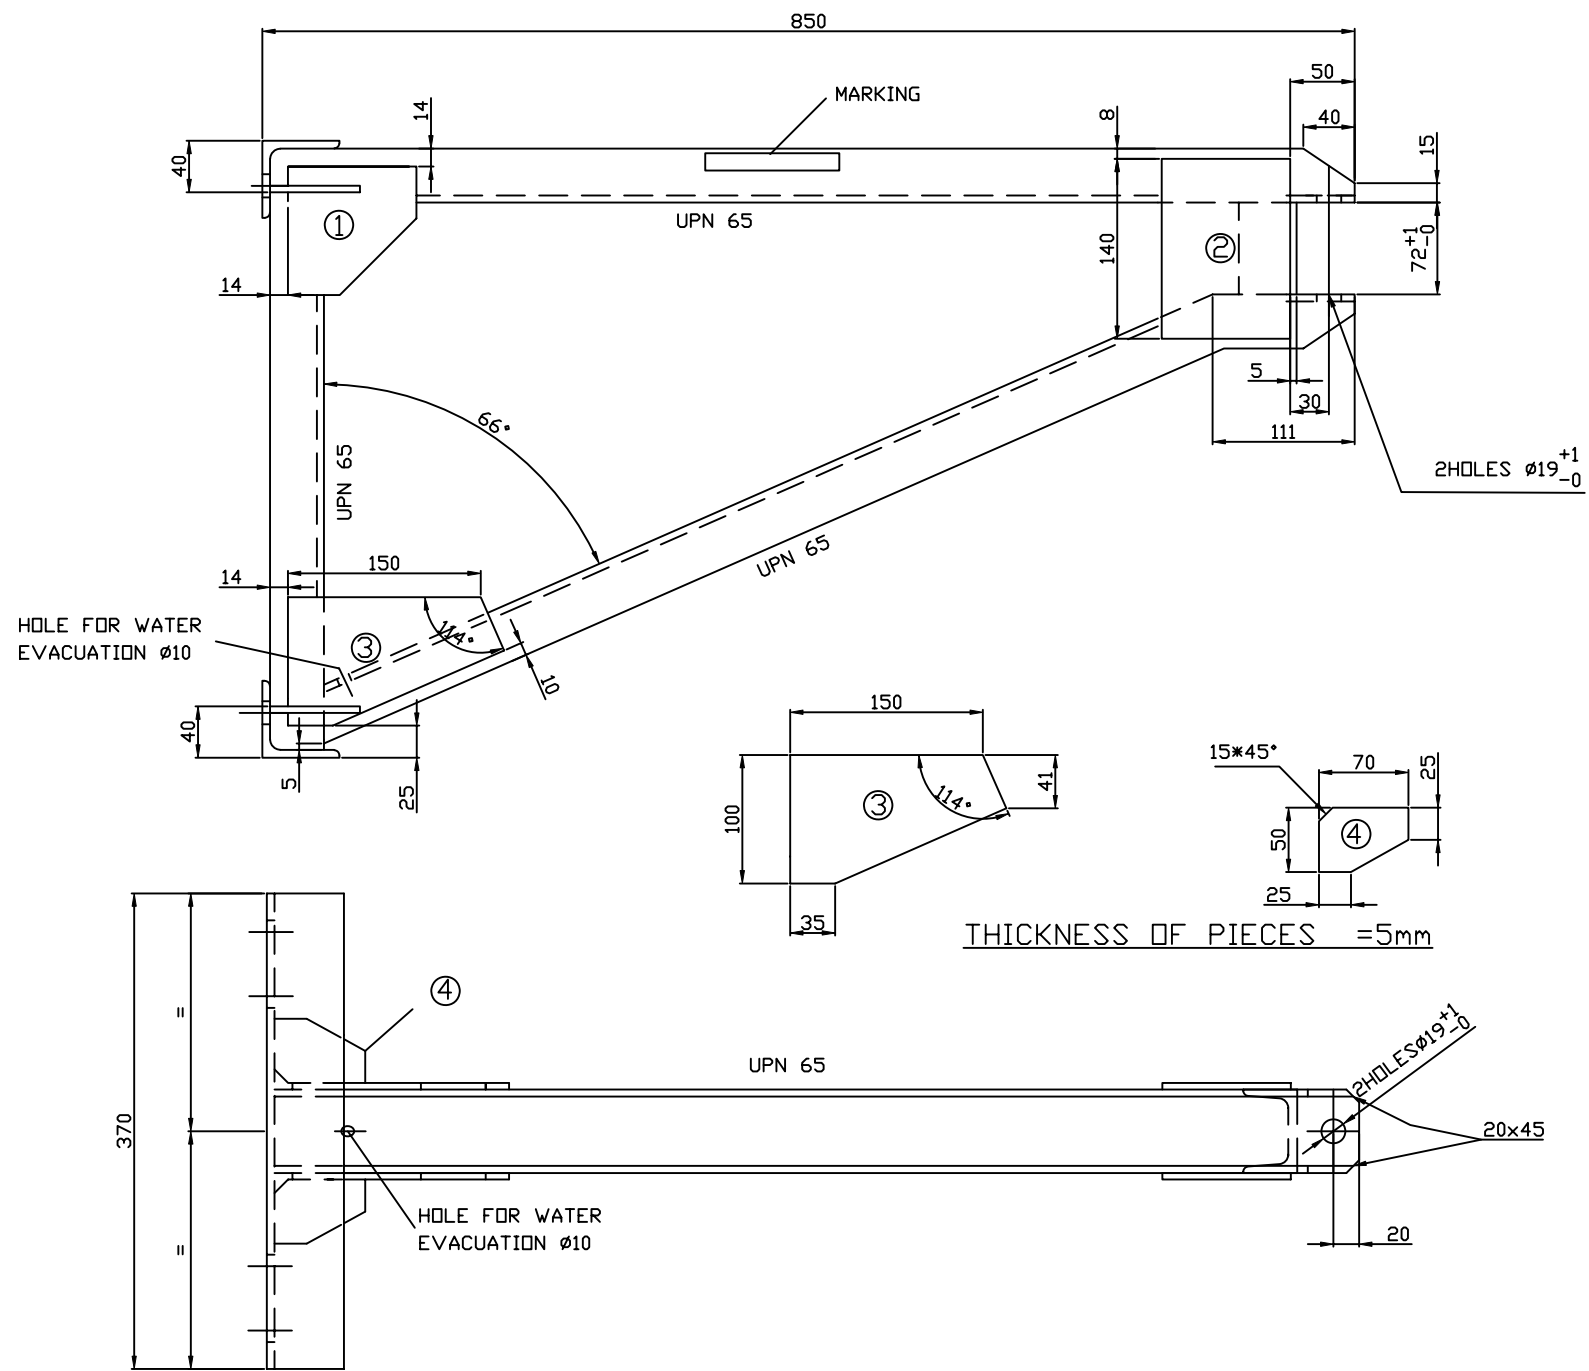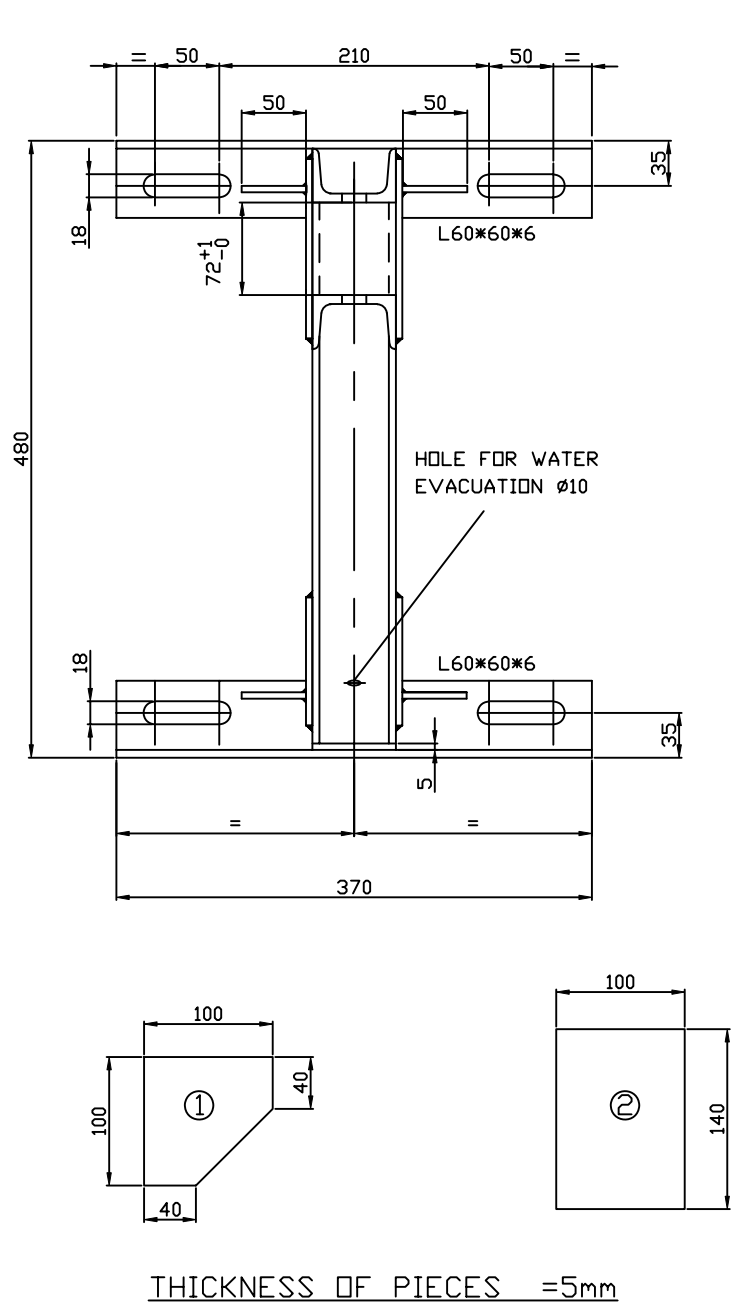


NOTE:

1. CONTINUOUS BEAD WATERPROOF WELDS MINIMUM THICKNESS: 3.5mm
2. After welding and drilling will be hot galvanized AT/OL/Zn600-STAS 7221-90.



01LC00BDG120	***	FASTENING FOR TOP AND STRUT TUBE WITH OFFSET > 3.10m	S235JR	25.2
DRAWING NUMBER	MARK	DESIGNATION	MATERIAL TECHNICAL SPECIFICATION	UNIT MASS kg

FIXARE L=900 PENTRU TIRANT SI CONTRAFISA FASTENING FOR TOP AND STRUT TUBE L=900	Numele fisierului/ CAD file name:	Scara/ Scale:	Part	Rev.
	01LC00BDG120		1 / 1	0

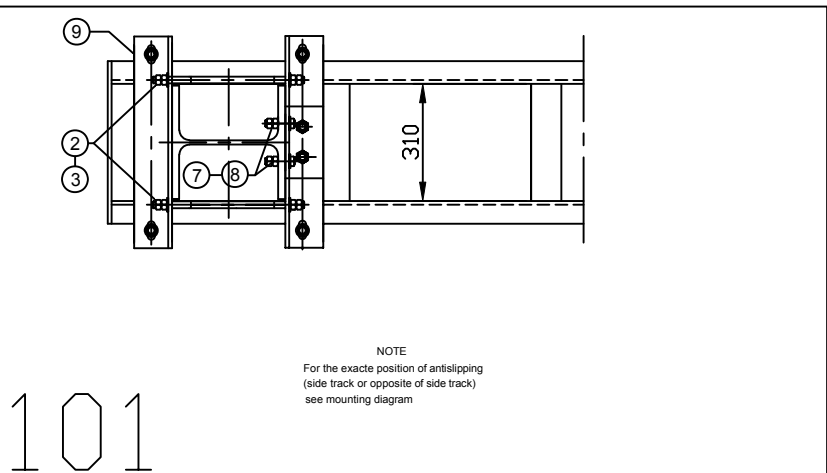



NOTE
For the exact position of antislipping
(side track or opposite of side track)
see mounting diagram

101

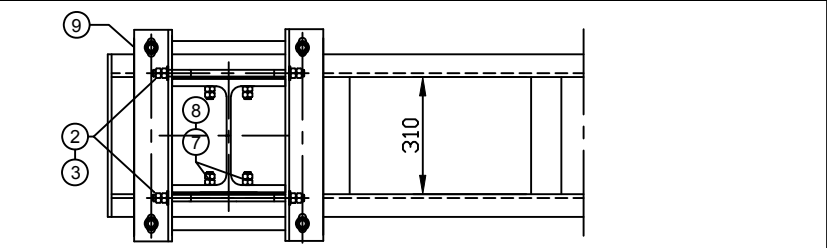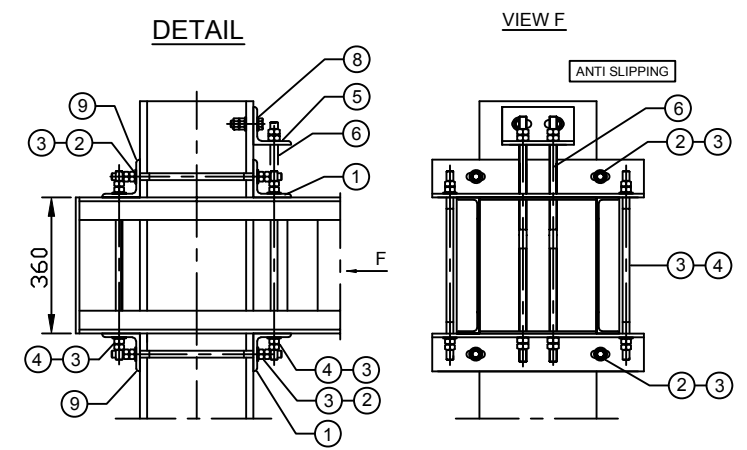

NOTE
For the exact position of antislipping
(side track or opposite of side track)
see mounting diagram


102

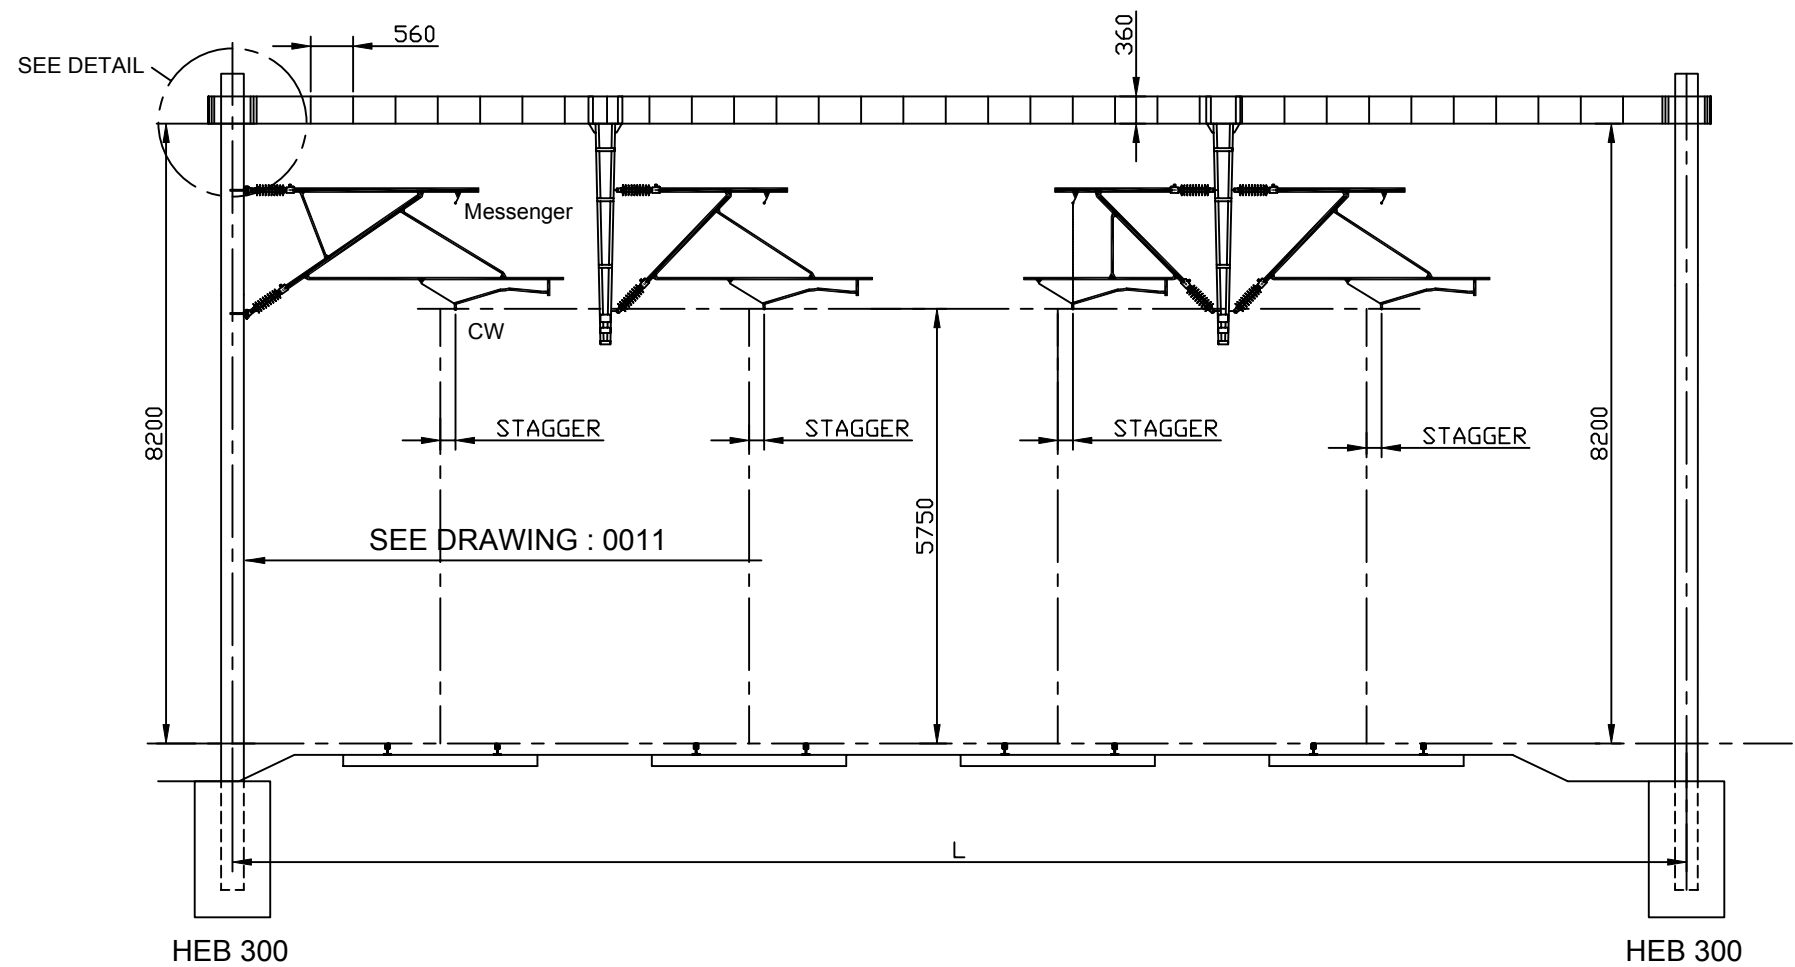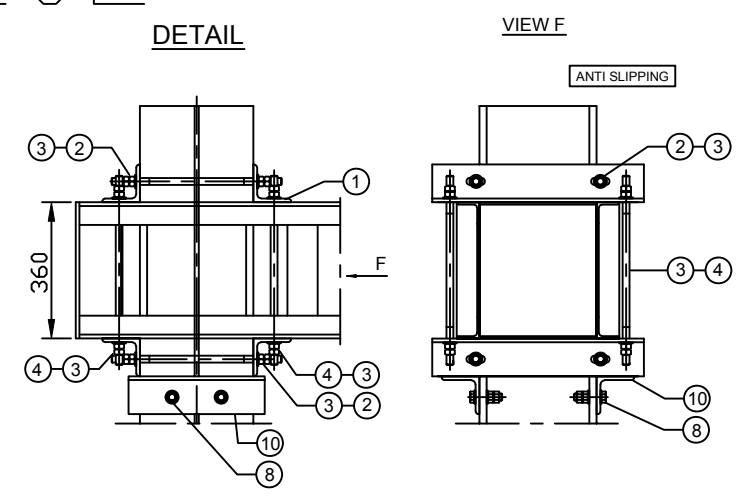


QUANTITY	2	-	10	COUNTERPLATE		01LC00BDG122	104
	-	2	9	COUNTERPLATE		01LC00BDG122	103
	4	2	8	WASHER M20N		01LC00BDG142	20A110
	4	2	7	BOLT HM 20x75/46		01LC00BDG144	2013N2
	-	2	6	THREADED ROD 20x750/300		01LC00BDG141	2011L7
	-	1	5	COUNTERPLATE		01LC00BDG122	102
	4	4	4	THREADED ROD 20x500/100		01LC00BDG141	2011F2
	16	16	3	WASHER M20N		01LC00BDG142	20A110
	4	4	2	THREADED ROD 20x450/100		01LC00BDG141	2011E2
4	2	1	COUNTERPLATE		01LC00BDG122	101	
MARK GROUP	102	101	ITEM	DESIGNATION	UNIT MASS kg	REFERENCE DRAWING	MARK

ANSAMBLU TRAVERSA RIGIDA PE STALP ASSEMBLIES GANTRY BEAM ON MAST	Numele fisierului/ CAD file name:	Scara/ Scale:	Part	Rev.
	01LC00BDG121		1 / 1	0





101

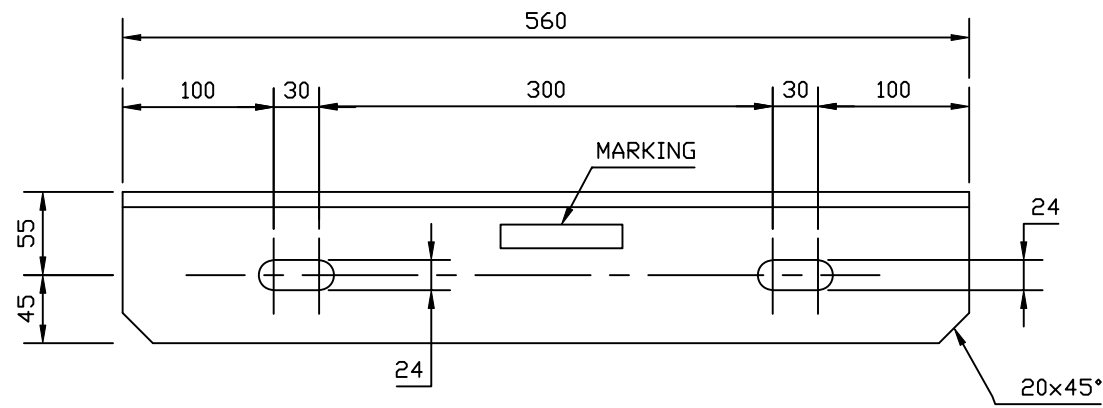



102

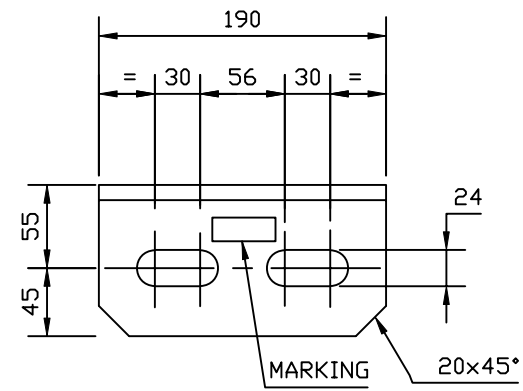

103

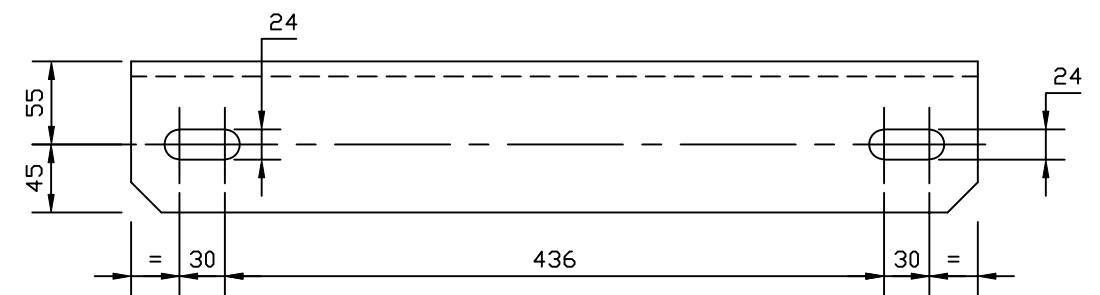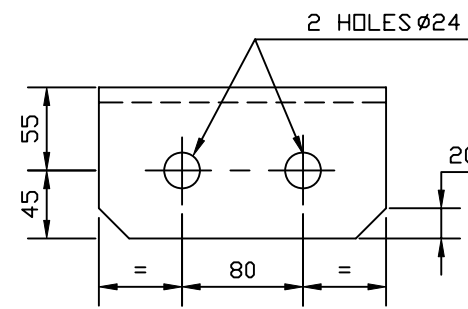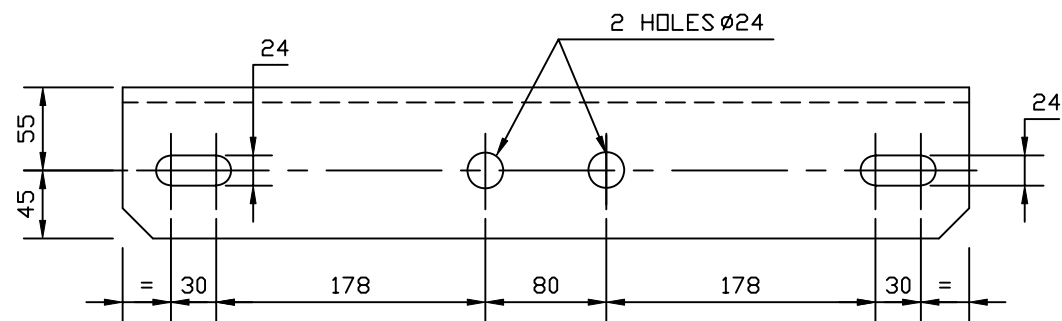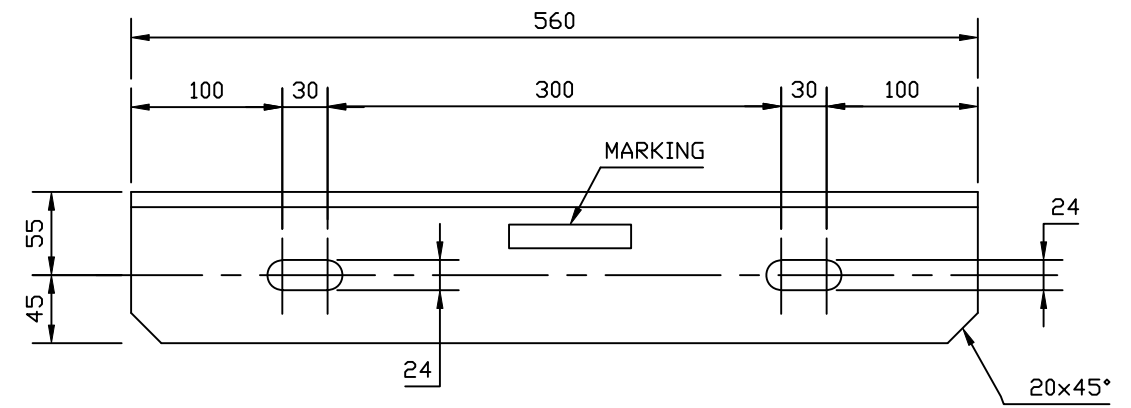




104

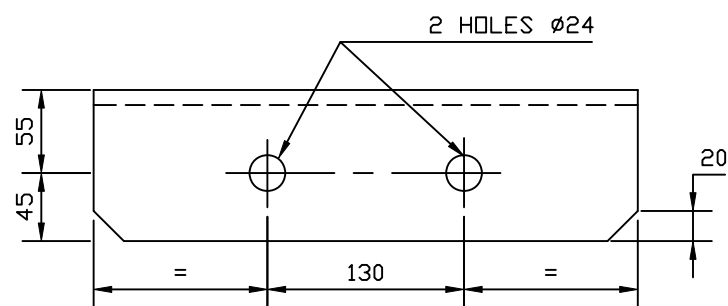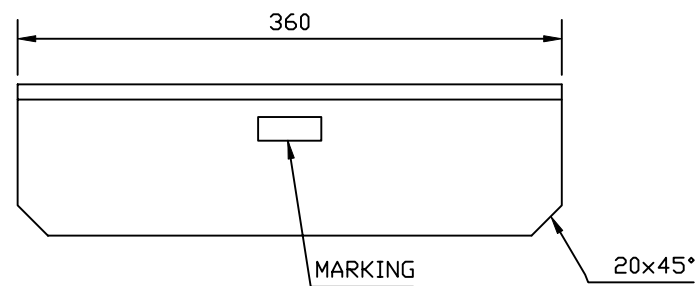

01LC00BDG122	104	COUNTERPLATE (L 100*100*10)	S235JR	5.40
01LC00BDG122	103	COUNTERPLATE (L 100*100*10)	S235JR	8.40
01LC00BDG122	102	COUNTERPLATE (L 100*100*10)	S235JR	2.43
01LC00BDG122	101	COUNTERPLATE (L 100*100*10)	S235JR	8.40
DRAWING NUMBER	MARK	DESIGNATION	MATERIAL TECHNICAL SPECIFICATION	UNIT MASS kg

CONTRASUPORT PENTRU TRAVERSA RIGIDA
COUNTERPLATE FOR GANTRY BEAM

Numele fisierului/ CAD file name:	Scara/ Scale:	Part	Rev.
01LC00BDG122		1 / 1	0

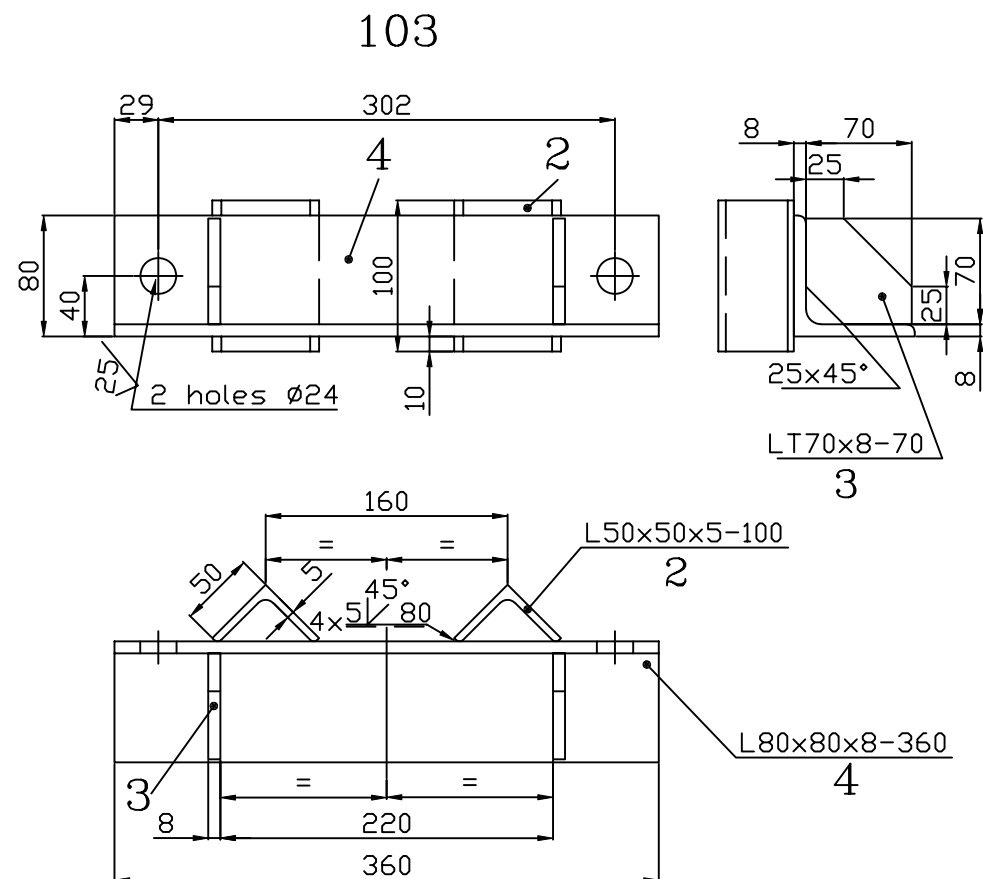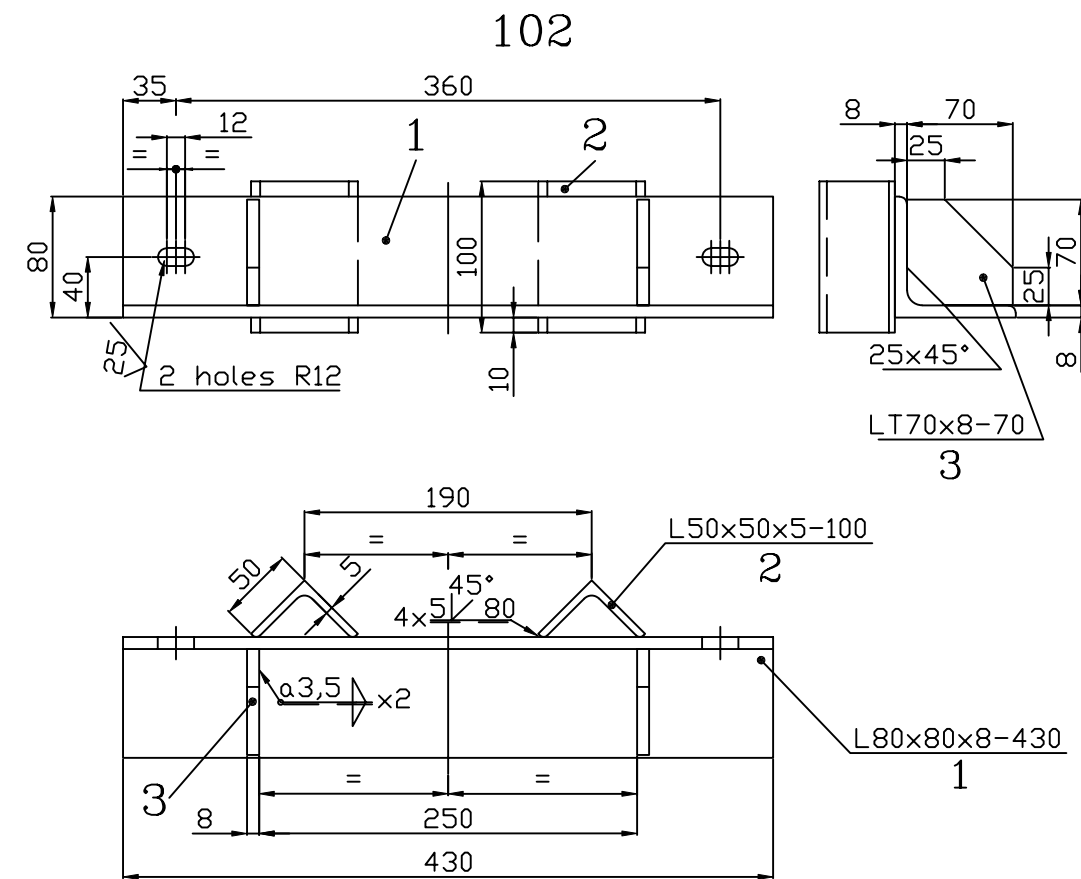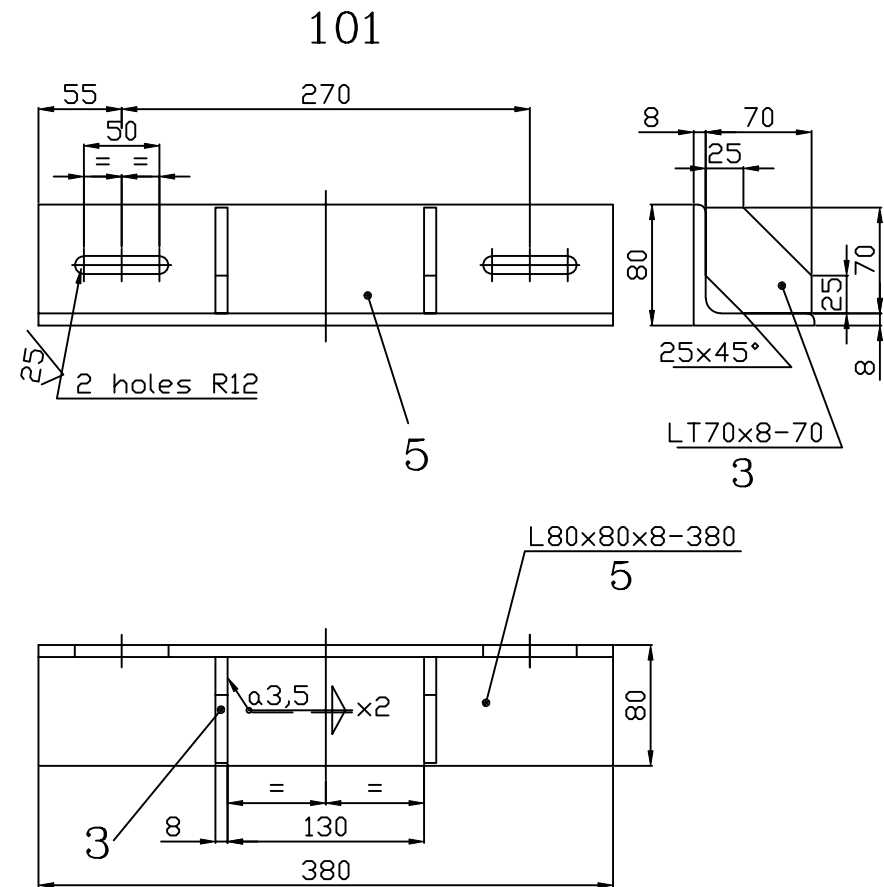


MARK GROUP	QUANTITY	ITEM	DESIGNATION	UNIT MASS	MATERIAL TECHNICAL SPECIFICATION	
SMT 273 SECP6 MU 10-5/8,2, HEB	1	5	CADRE		S275JR	
	1	4	CADRE		S275JR	
	2	2	3	RIB		S235JR
	2	2	2	SPACER		S235JR
	1	1	1	CADRE		S275JR

NOTE:

- 1.The weldings will be made continuous, tight for hot galvanize.
- 2.After welding and drilling will be hot galvanized AT/OL/Zn600-STAS 7221-90.

CONTRASUPORT COUNTERPLATE	Numele fisierului/ CAD file name:	Scara/ Scale:	Part	Rev.
	01LC00BDG129		1 / 1	0

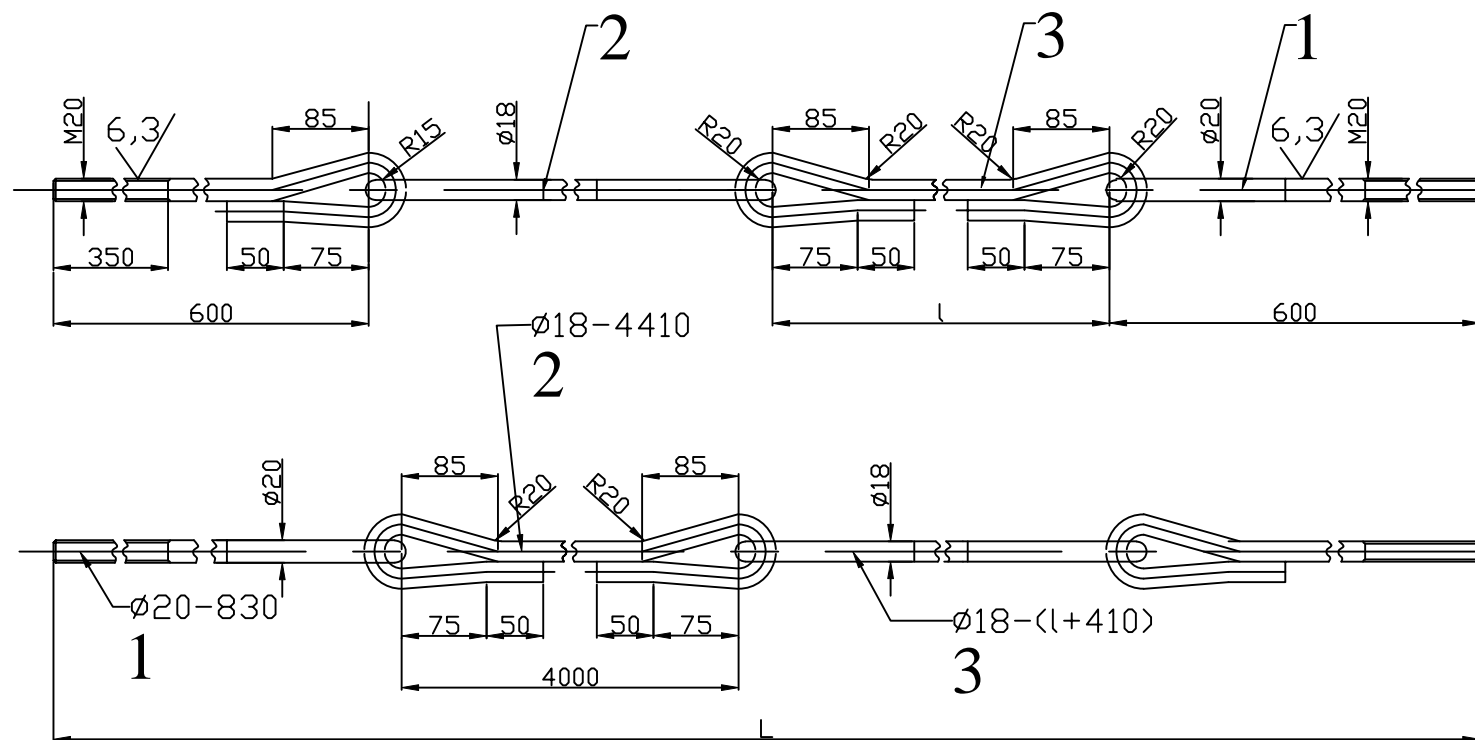

NOTE:

1. Will be hot galvanized AT/OL/Zn600, except the threads AT/OL/Zn310 -STAS 7221-90, witch will be run in.
2. After the hot galvanize, the parts without zinc will be retouch with paint with min 95% zinc, in two layers.
3. For standard situation, when the distance between NS and ground is 900mm, will be use marks I6 and II6 with cassette 05 LC 00BDG-156 mounted in the middle of regulation plate ELC 49-17. In particular situation, when the distance is different than 900mm or the anchors are installed at different distances than in the mounting diagrams, will be measure the necessary lenght.
4. xAt variants II9 and II10, item 3 disappeare and item 2 will have a length of 4200mm for the first case and 3800mm for the other.

101 LEVEL ANCHOR	Mark	L	l	102 SPECIAL AMCHOR	Mark	L	l
	101	10800	5500		201	7800	2500
	102	10500	5200		202	7500	2200
	103	10200	4900		203	7200	1900
	104	9900	4600		204	6900	1600
	105	9600	4300		205	6600	1300
	106	9300	4000		206	6300	1000
	107	9000	3700		207	6000	700
	108	8700	3400		208	5700	400
	109	8400	3100		209	5400	*
110	8100	3800	210	5100	*		

3	INTERMEDIARY ROD II	1	S235JR
2	INTERMEDIARY ROD I	1	S235JR
1	THREADED ROD	2	S235JR
ITEM	DESIGNATION	UNIT	MATERIAL TECHNICAL SPECIFICATION

TENSOR ANCORARE
ANCHOR TIE ROD

Numele fisierului/
CAD file name:
01LC00BDG130

Scara/
Scale:

Part


Rev.

1 / 1


0

FROM HEA or HEB 200 TO 240

MARK 101



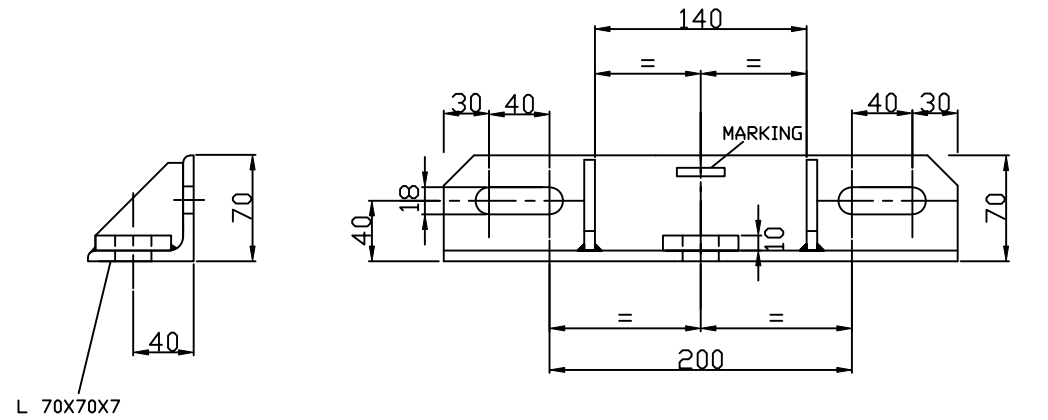


GUSSET

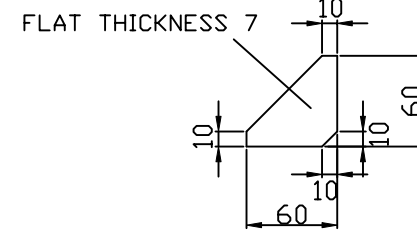

FROM HEA or HEB 260 TO 320

MARK 102

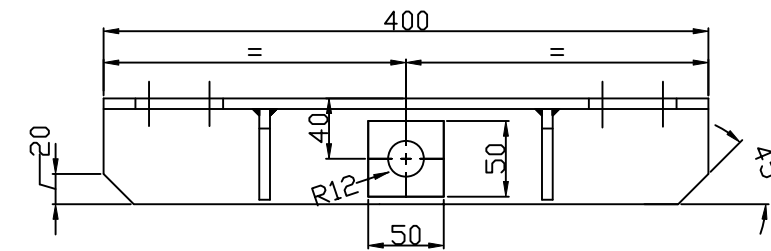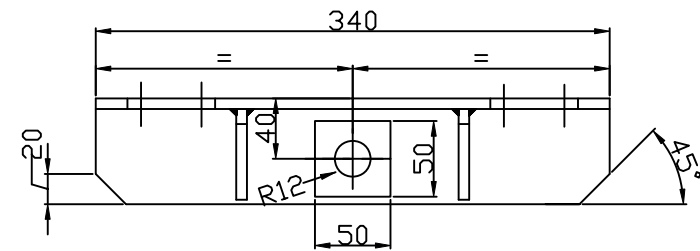
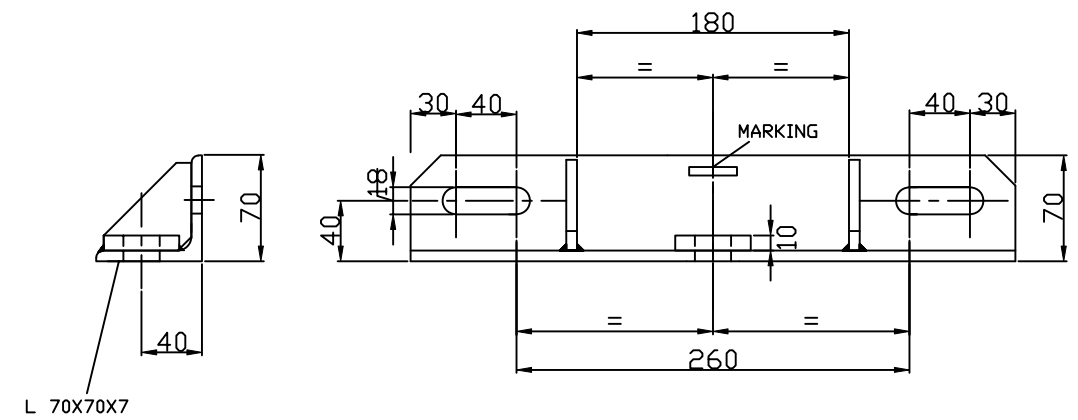


01LC00BDG131	102	ANGLE FOR EARTHING ANCHORING	S235JR	3.1
01LC00BDG131	101	ANGLE FOR EARTHING ANCHORING	S235JR	2.8
DRAWING NUMBER	MARK	DESIGNATION	MATERIAL TECHNICAL SPECIFICATION	UNIT MASS kg

NOTE:



- 1.CONTINUOUS BEAD WATERPROOF WELDS MINIMUM THICKNESS: 3mm
- 2.After welding and drilling will be hot galvanised AT/OL/Zn 600 – STAS 7221-90

CONTRASUPORT PENTRU CABLUL COLECTOR ANGLE FOR EARTHING ANCHORING	Numele fisierului/ CAD file name:	Scara/ Scale:	Part	Rev.
	01LC00BDG131		1 / 1	0

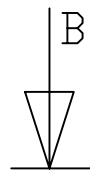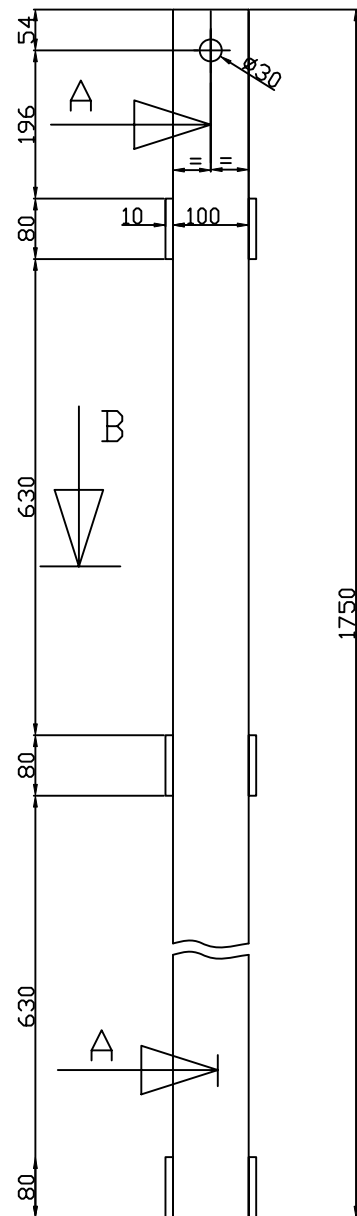

A - A

B - B

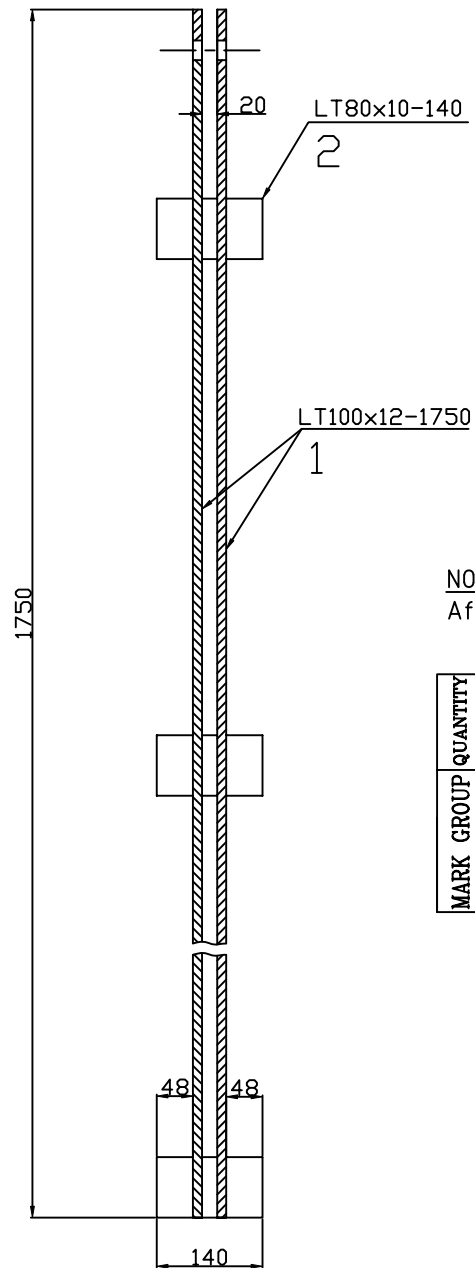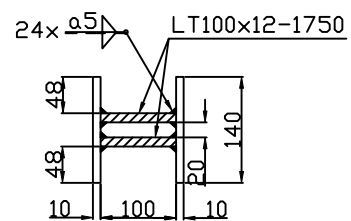

NOTE:

After welding and drilling will be hot galvanized AT/OL/Zn600-STAS 7221-90.

MARK GROUP	QUANTITY	ITEM	DESIGNATION	UNIT MASS	MATERIAL TECHNICAL SPECIFICATION
	6	2	PLATE		S235JR
	2	1	LONGERON		S235JR

TRAVERSA PENTRU ANCORA LA NIVEL
LEVEL ANCHOR BEAM




Numele fisierului/
CAD file name:
01LC00BDG132

Scara/
Scale:

Part Rev.
1 / 1 0


FROM HEA or HEB 200 TO 240

MARK 101

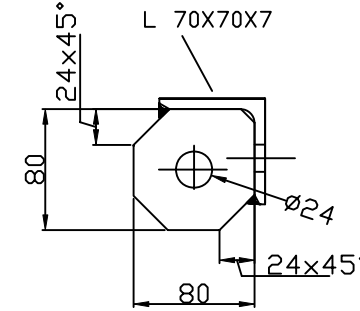
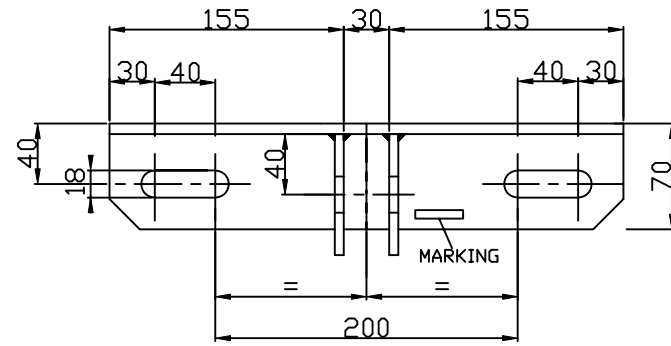
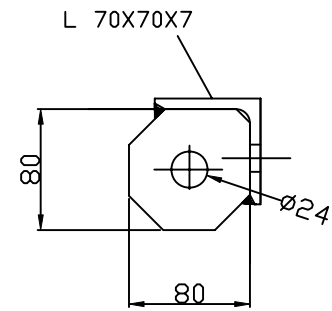


FROM HEA or HEB 260 TO 320

MARK 102

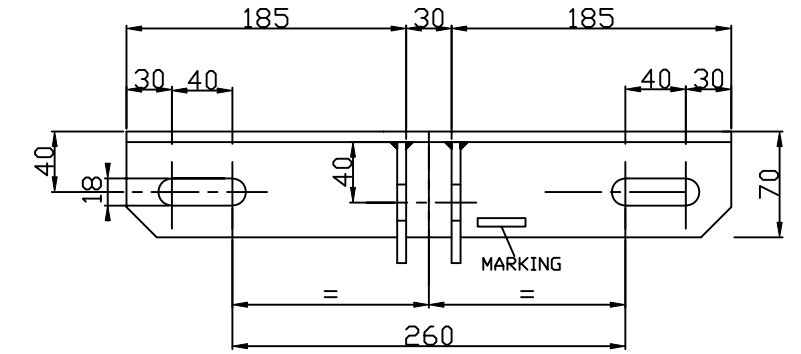

GUSSET

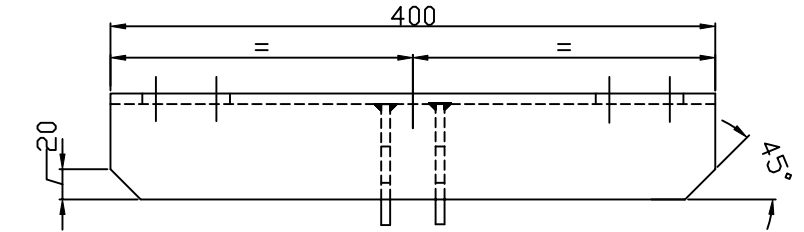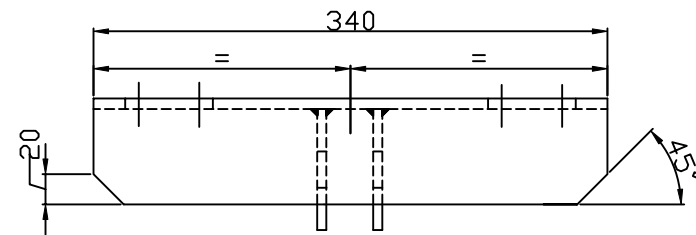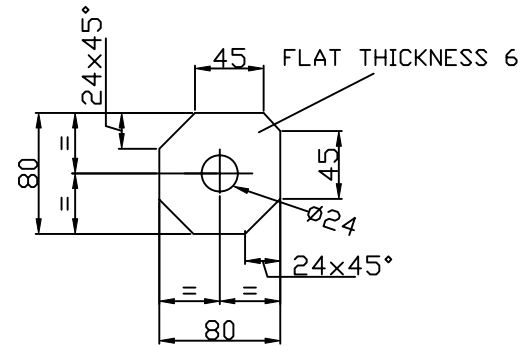

NOTE:


1. CONTINUOUS BEAD WATERPROOF WELDS MINIMUM THICKNESS: 3mm
2. After welding and drilling will be hot galvanised AT/OL/Zn600-STAS 7221-90

01LC00BDG133	102	COUNTERPLATE FOR EARTHING ANCHORING	S235JR	3.2
01LC00BDG133	101	COUNTERPLATE FOR EARTHING ANCHORING	S235JR	2.8
DRAWING NUMBER	MARK	DESIGNATION	MATERIAL TECHNICAL SPECIFICATION	UNIT MASS kg

CONTRASUPORT PENTRU CABLU CULECTOR
COUNTERPLATE FOR EARTHING ANCHORING

Numele fisierului/ CAD file name:	Scara/ Scale:	Part	Rev.
01LC00BDG133		1 / 1	0


FOR MOUNTING, SEE DRAWING TYPICAL CATENARY EQUIPMENT

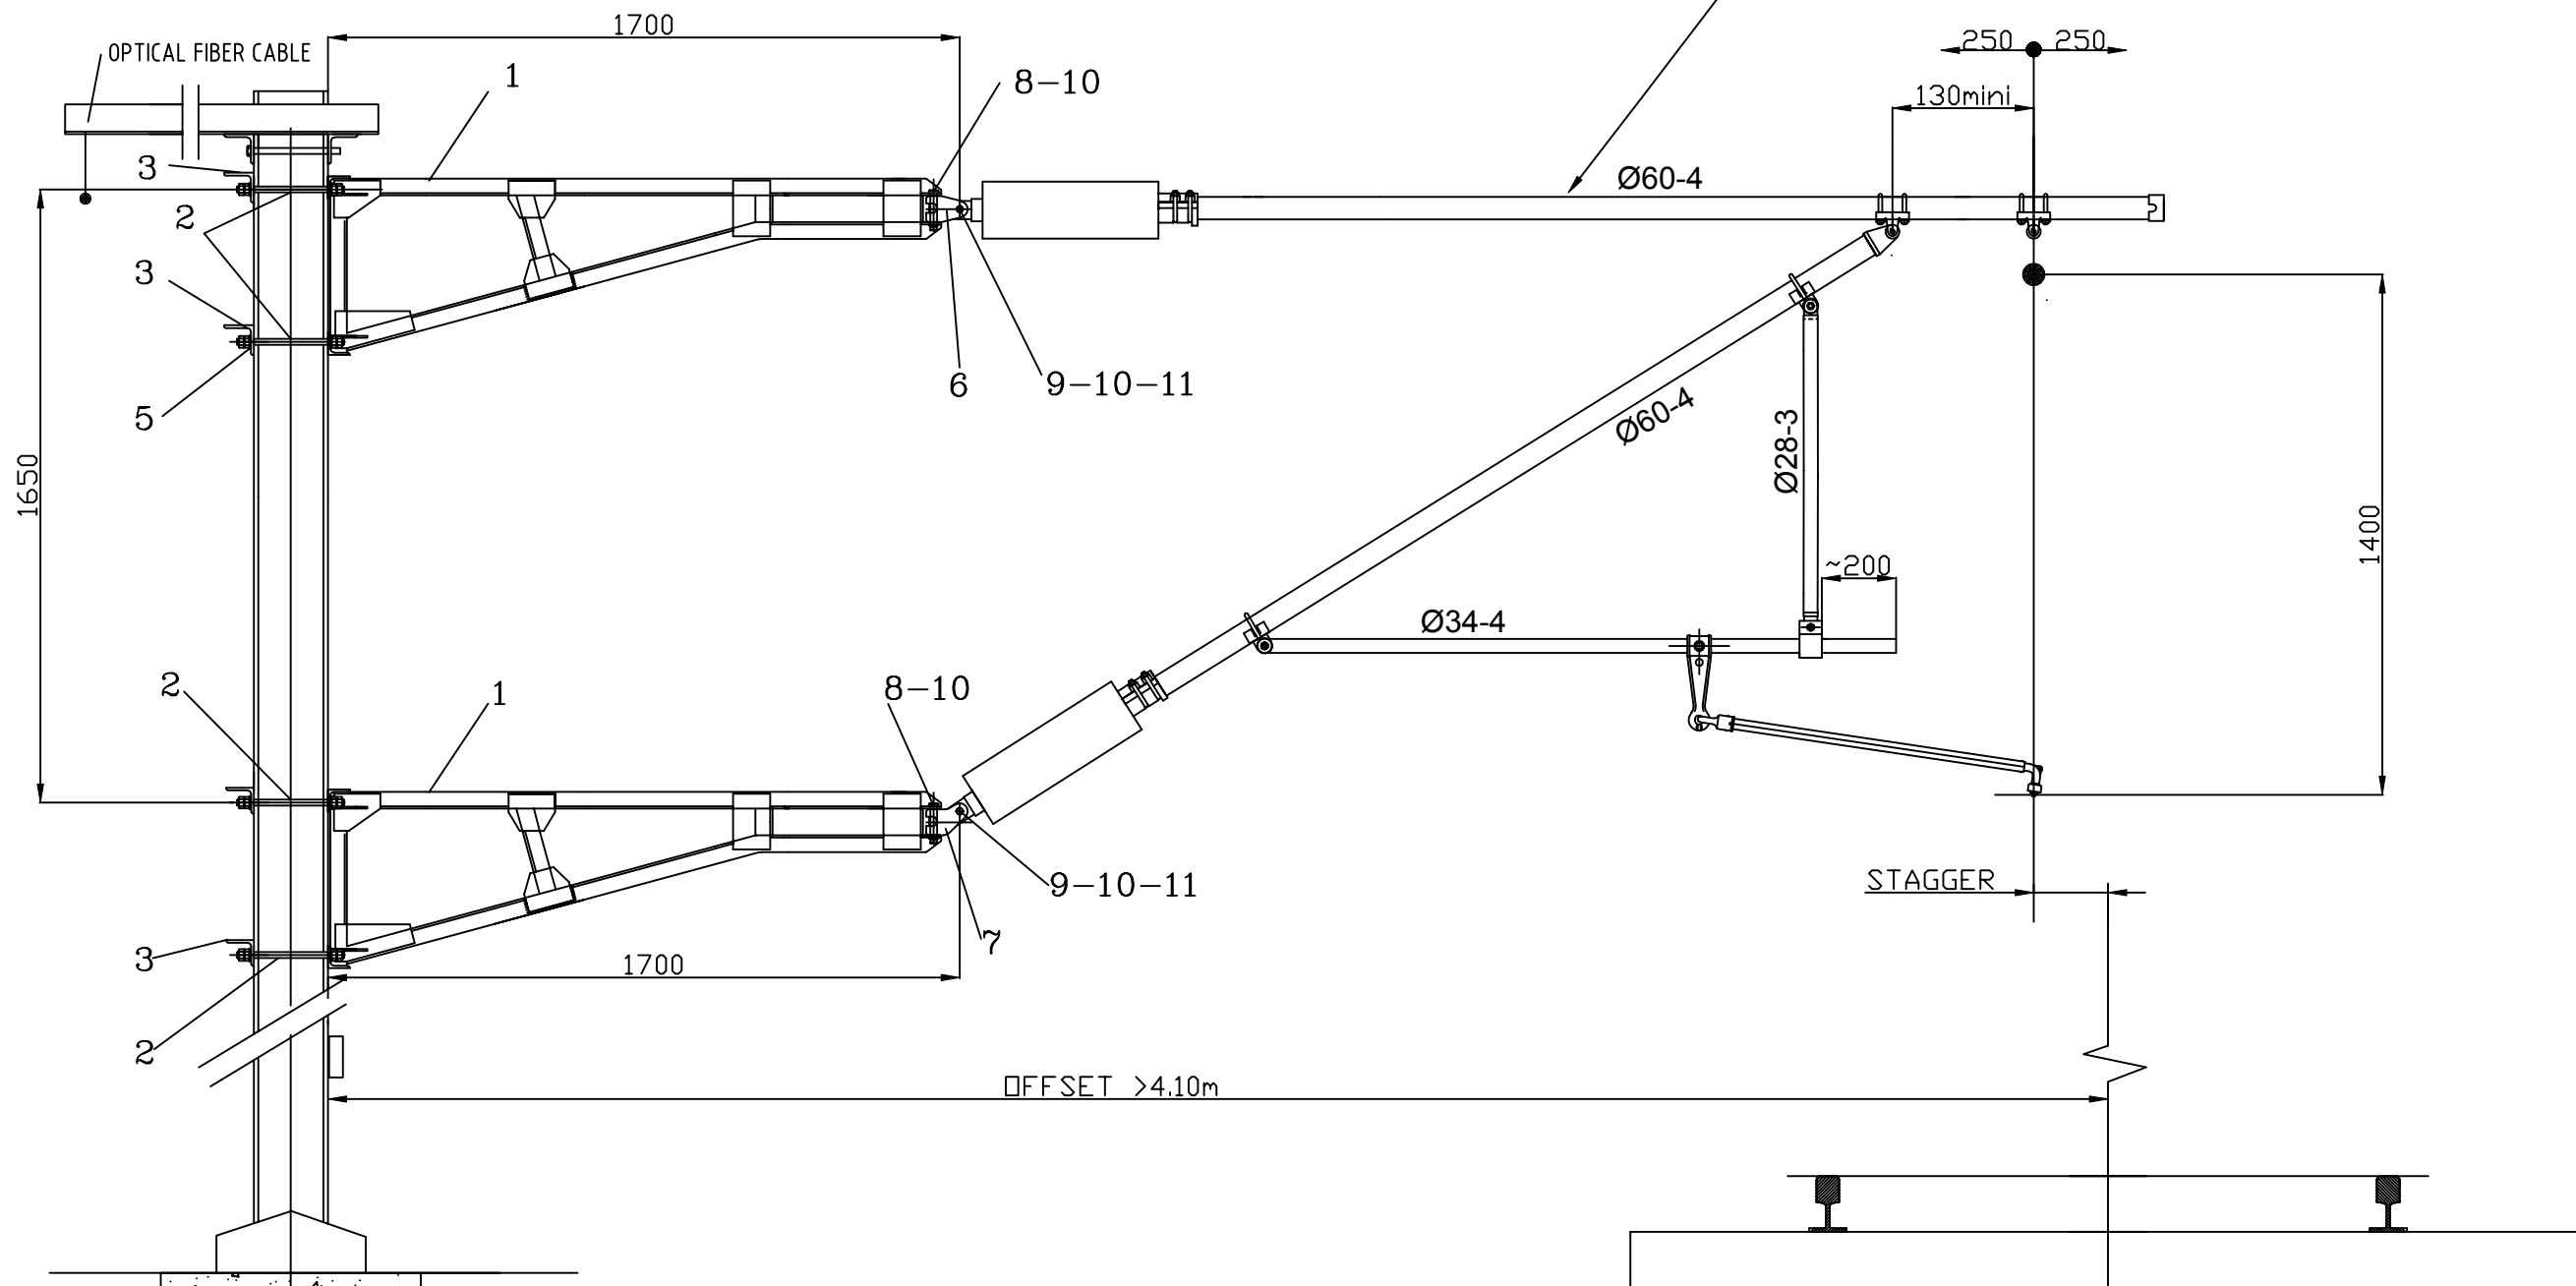

MARK	ITEM	DESIGNATION	REFERENCE DRAWING		
	2	11	WASHER M18	01LC00BDG142	18A110
	4	10	PIN 4.5-40	01LC00BDG145	45A040
	2	9	AXIS. 18-50	01LC00BDG146	181050
	2	8	AXIS. 18-110	01LC00BDG146	181110
	1	7	HINGE STRUT TUBE	ELC 13-9.11 A rev c	
	1	6	HINGE TOP TUBE	ELC 13-9.10 A rev c	
	16	5	WASHER M16	01LC00BDG142	16A110
	4	3	COUNTERPLATE	01LC00BDG090	101
	8	2	TRHEADED ROD M16 400/100	01LC00BDG141	1611D2
	2	1	FASTENING FOR TOP AND STRUT TUBE L=1700	ELC 22-4.0C	
MARK	101	ITEM	DESIGNATION	REFERENCE DRAWING	



FIXARE TIRANT SI CONTRAFISA PENTRU GABRIT>4.10M FASTENING FOR TOP TUBE AND STRUT TUBE WITH OFFSET>4.10M		Numele fisierului/ CAD file name: 01LC00BDG134	Scara/ Scale:	Part 1 / 2	Rev. 0
--	--	---	------------------	---------------	-----------

FOR MOUNTING, SEE DRAWING TYPICAL CATENARY EQUIPMENT

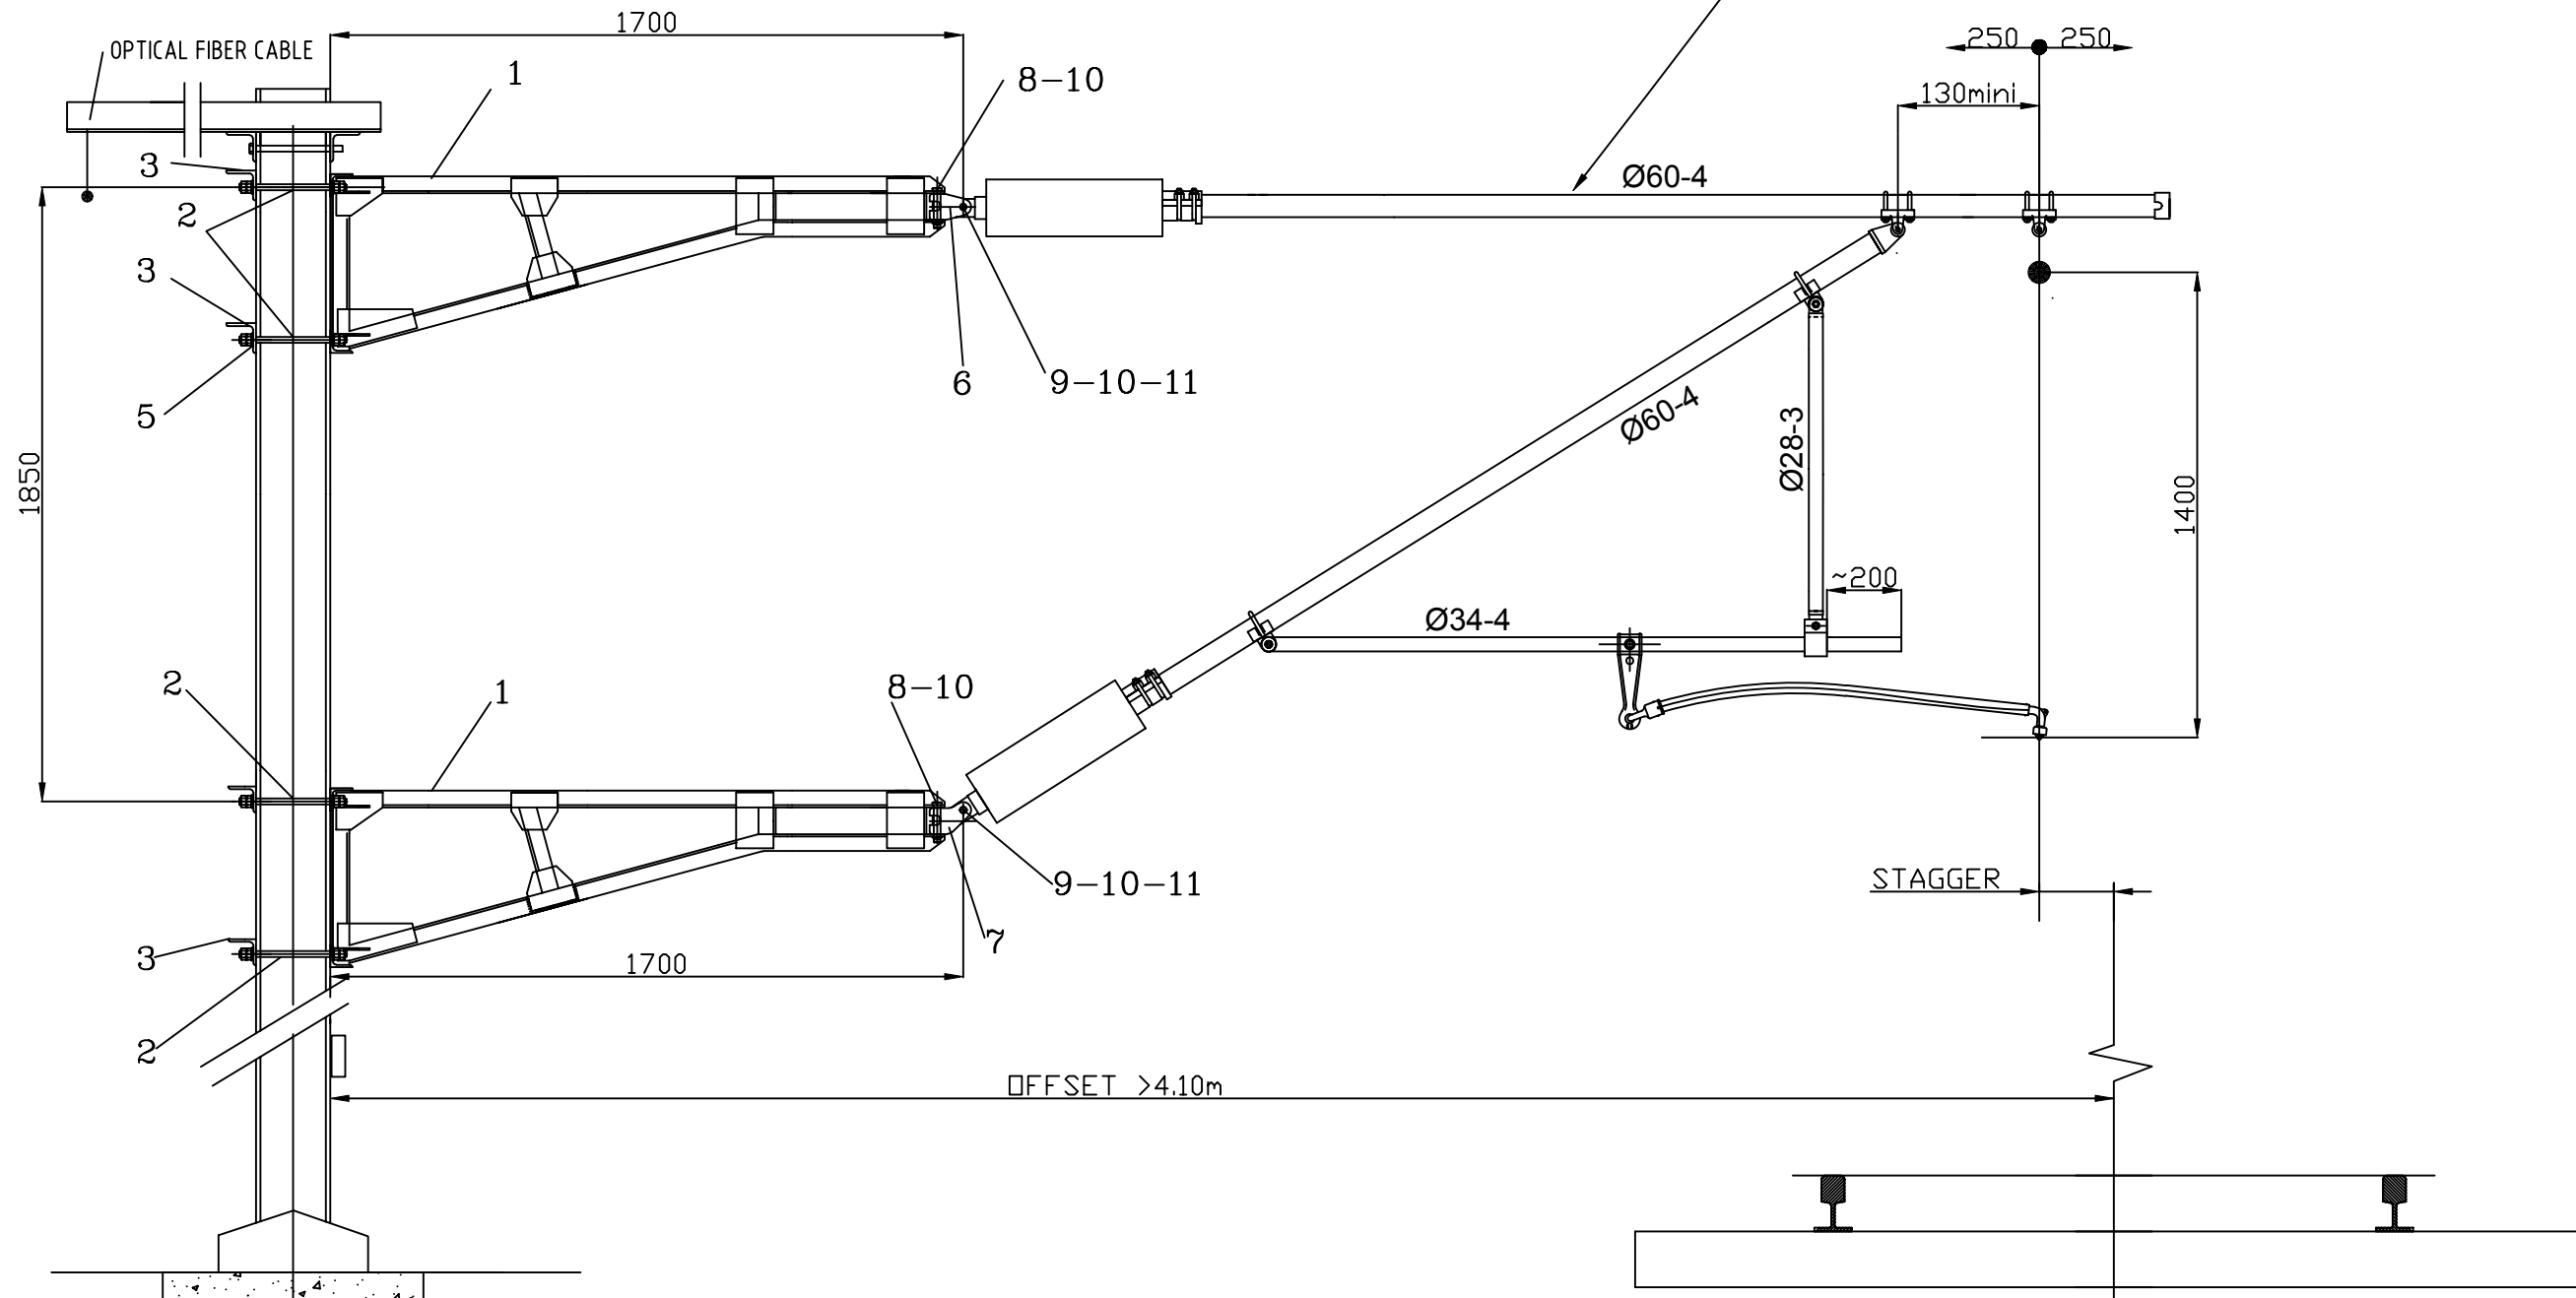


MARK	ITEM	DESIGNATION	REFERENCE DRAWING
2	11	WASHER M18	01LC00BDG142 18A110
4	10	PIN 4.5-40	01LC00BDG145 45A040
2	9	AXIS. 18-50	01LC00BDG146 181050
2	8	AXIS. 18-110	01LC00BDG146 181110
1	7	HINGE STRUT TUBE	ELC 13-9.11 A rev c
1	6	HINGE TOP TUBE	ELC 13-9.10 A rev c
16	5	WASHER M16	01LC00BDG142 16A110
4	3	COUNTERPLATE	01LC00BDG090 101
8	2	TRHEADED ROD M16 400/100	01LC00BDG141 1611D2
2	1	FASTENING FOR TOP AND STRUT TUBE L=1700	ELC 22-4.0C
101	ITEM	DESIGNATION	REFERENCE DRAWING

FIXARE TIRANT SI CONTRAFISA PENTRU GABRIT>4.10M FASTENING FOR TOP TUBE AND STRUT TUBE WITH OFFSET>4.10M	Numele fisierului/ CAD file name:	Scara/ Scale:	Part	Rev.
	01LC00BDG134		2 / 2	0

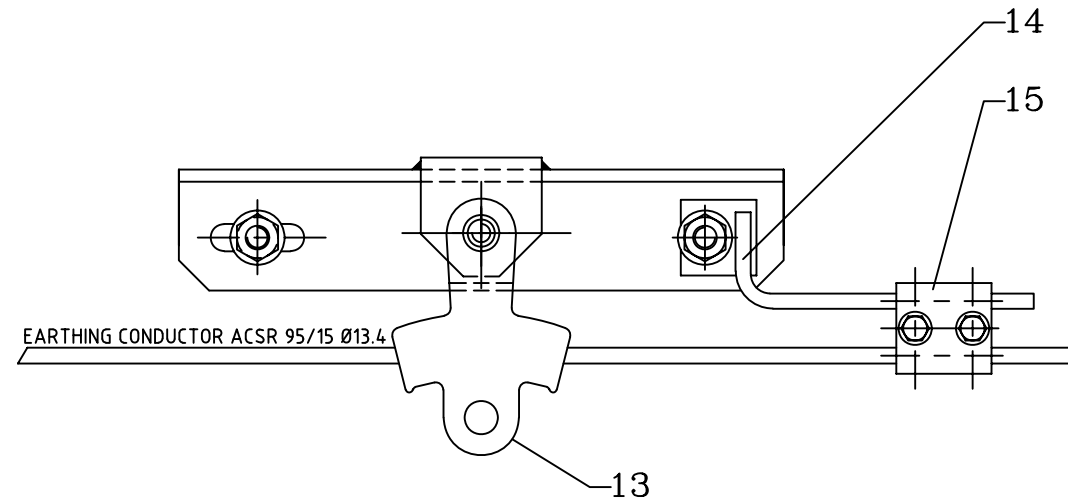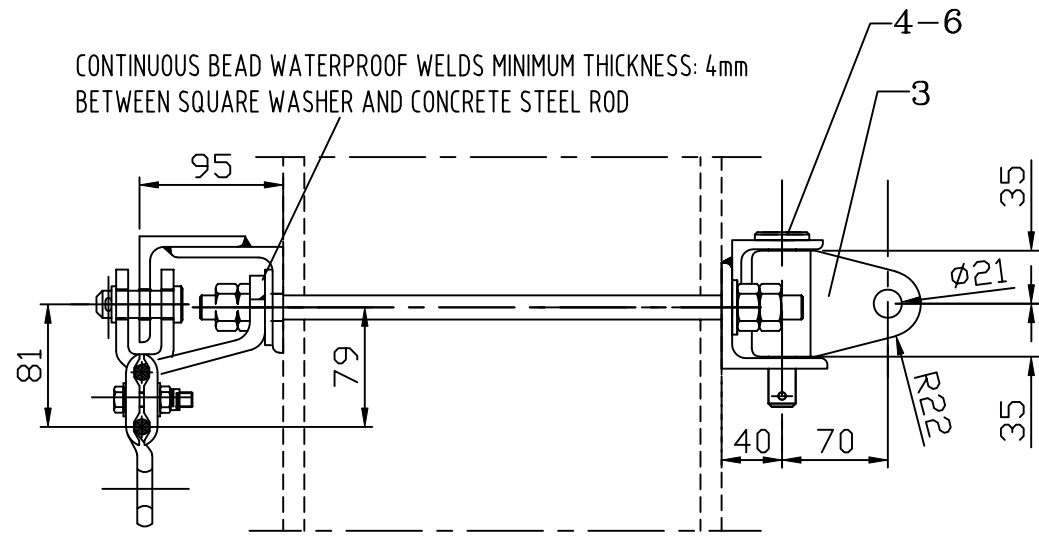



MARK	DESIGNATION
101	FROM HE 200 TO 240
102	FROM HE 260 TO 320

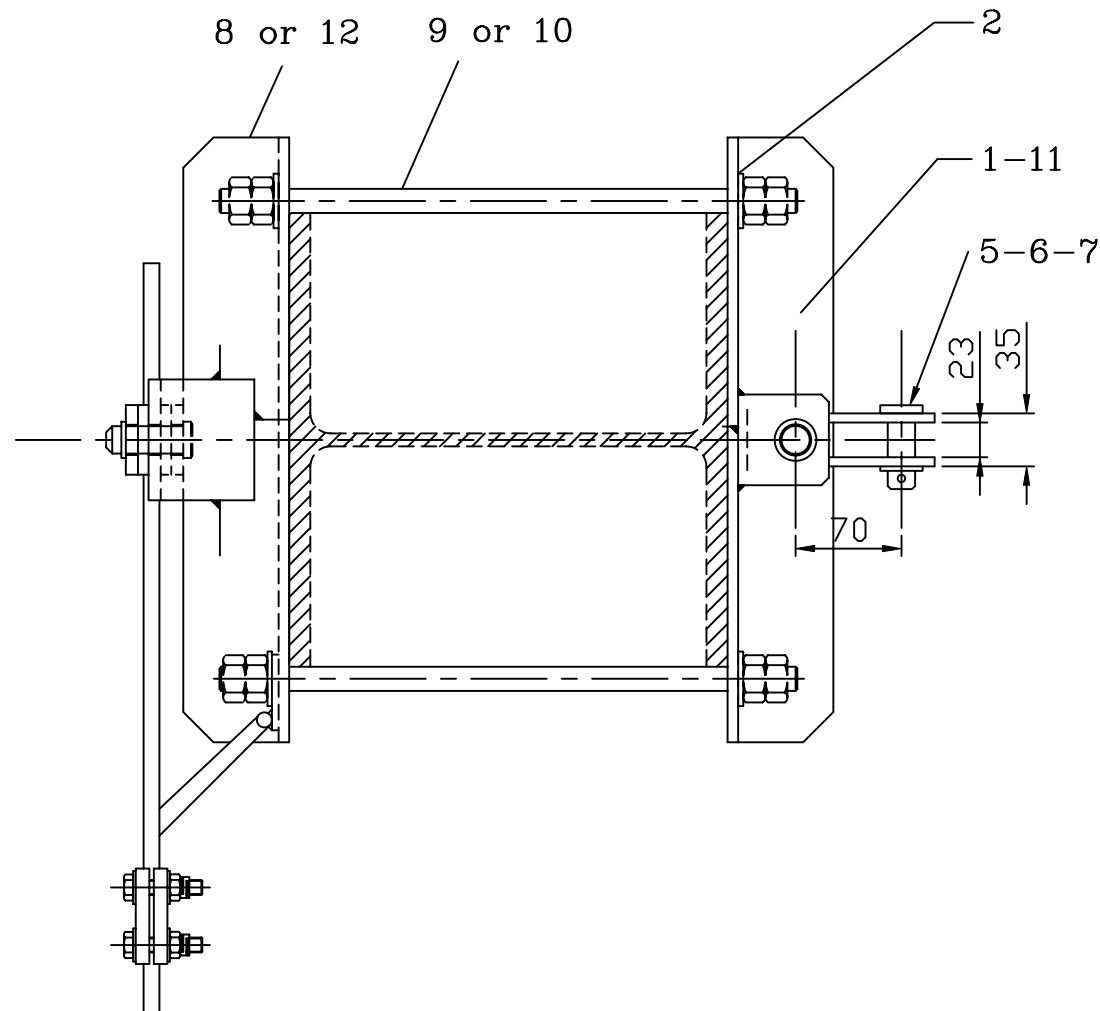

MARK. GROUP	QUANTITY	ITEM	DESIGNATION	UNIT MASS	REFERENCE DRAWING	MARK
	1	15	CLAMP	0.59	ELC 2-4.0	
	1	14	EARTHING CONNECTION	0.25	01LC00BDG260	101
	1	13	EARTHING CONDUCTOR SUSPESION TYPE I	1.30	ELC 13-1.4.0	
	1	12	COUNTERPLATE WITH EARTHING CONDUCTOR		01LC00BDG102	102
	1	11	HINGE SUPPORT		01LC00BDG088	102
	2	10	THREADED ROD M16- 350/100		01LC00BDG141	1611C2
	2	9	THREADED ROD M16- 450/100		01LC00BDG141	1611E2
	1	8	COUNTERPLATE WITH EARTHING CONDUCTOR		01LC00BDG102	101
	1	7	AXIS 20-50		01LC00BDG146	201050
	2	6	PIN. 4,5*40		01LC00BDG145	45A040
	1	5	WASHER M20		01LC00BDG142	20A110
	1	4	AXIS . 18*110		01LC00BDG146	181110
	1	3	HINGE TOP TUBE	0.78	E.L.C 13-9.10 A rev.c	...
	4	2	WASHER M16N		01LC00BDG142	161110
	1	1	HINGE SUPPORT		01LC00BDG088	101
	102					
	101					
		ITEM	DESIGNATION	UNIT MASS	REFERENCE DRAWING	MARK
				kg		

CRAPODINA PENTRU TIRANT CU SUTINEREA CABLULUI COLECTOR
FASTENING FOR TOP TUBE WITH EARTHING CONDUCTOR

Numele fisierului/ CAD file name:	Scara/ Scale:	Part	Rev.
01LC00BDG135		1 / 1	0

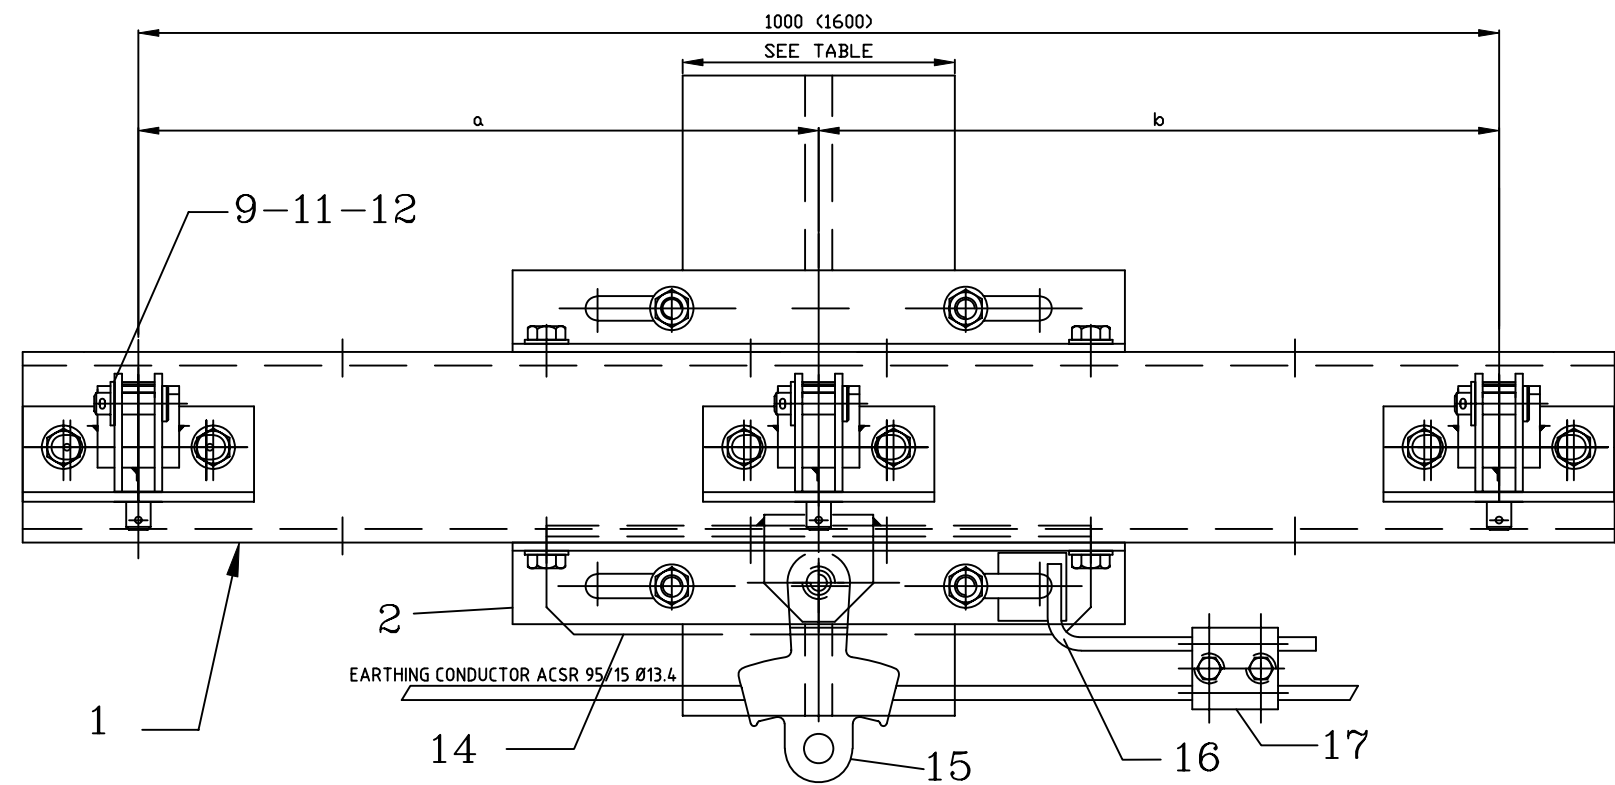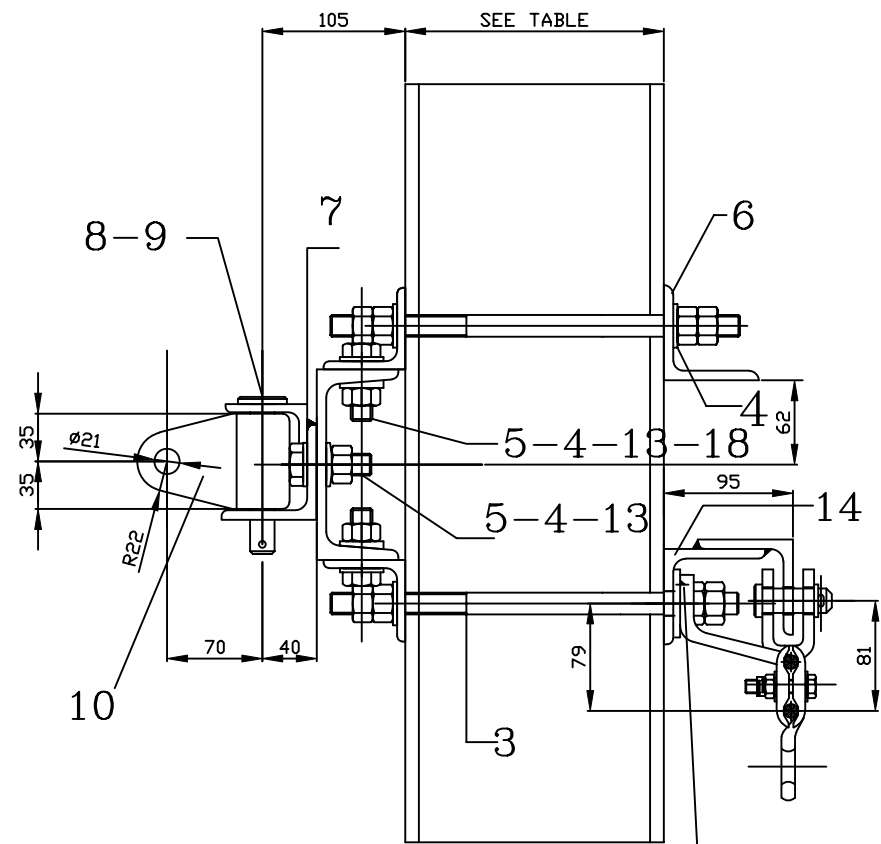


Note

For cotes a and b see the mounting diagrams.

MARK	211	201	111	101	ITEM	DESIGNATION	UNIT MASS kg	REFERENCE DRAWING	MARK
	4	4	4	4	18	WASHER TYPE U		01LC00BDG142	16A710
	1	1	1	1	17	CLAMP	0.59	ELC 2-4.0	
	1	1	1	1	16	EARTHING CONNECTION	0.25	01LC00BDG260	101
	1	1	1	1	15	EARTHING CONDUCTOR SUSPESION TYPE I	1.30	ELC 13-1.4.0	
	1	1	1	1	14	COUNTERPLATE WITH EARTHING CONDUCTOR		01LC00BDG102	101
	10	10	8	8	13	WASHER . CS-16-32-2.8		01LC00BDG142	16A310
	3	3	2	2	12	AXIS 20-50		01LC00BDG146	201050
	3	3	2	2	11	WASHER M20		01LC00BDG142	20A110
	3	3	2	2	10	HINGE TOP TUBE		E.L.C 13-9.10A REV C	
	6	6	4	4	9	PIN 4.5*40		01LC00BDG145	45A040
	3	3	2	2	8	AXIS 18-110		01LC00BDG146	181110
	3	3	2	2	7	HINGE SUPPORT		01LC00BDG114	
	1	1	1	1	6	COUNTERPLATE		01LC00BDG090	101
	10	10	8	8	5	BOLT HM 16-50/50		01LC00BDG144	1612H1
	18	18	16	16	4	WASHER M16N		01LC00BDG142	16A110
	4	4	4	4	3	THREADED ROD M16 -350/100		01LC00BDG141	1611C2
	2	2	2	2	2	COUNTERPLATE FOR SPREADER		01LC00BDG094	
	1		1		1	SPREADER (1.60m)		01LC00BDG115	
		1		1	1	SPREADER (1.00m)		01LC00BDG089	

DN H BEAM	ASSEMBLY ALLOCATION			
	2 TOP TUBES SPACING 1.00 m	3 TOP TUBES SPACING 0.50 m	2 TOP TUBES SPACING 1.60 m	3 TOP TUBES SPACING 0.80 m
HE 200 TO 240	101	201	111	211

TRAVERSA PENTRU 2 SAU 3 TIRANTI CU SUTINEREA CABLULUI COLECTOR SPREADER ASSEMBLY FOR 2 OR 3 TOP TUBES WITH EARTHING CONDUCTOR	Numele fisierului/ CAD file name:	Scara/ Scale:	Part	Rev.
	01LC00BDG136		1 / 1	0

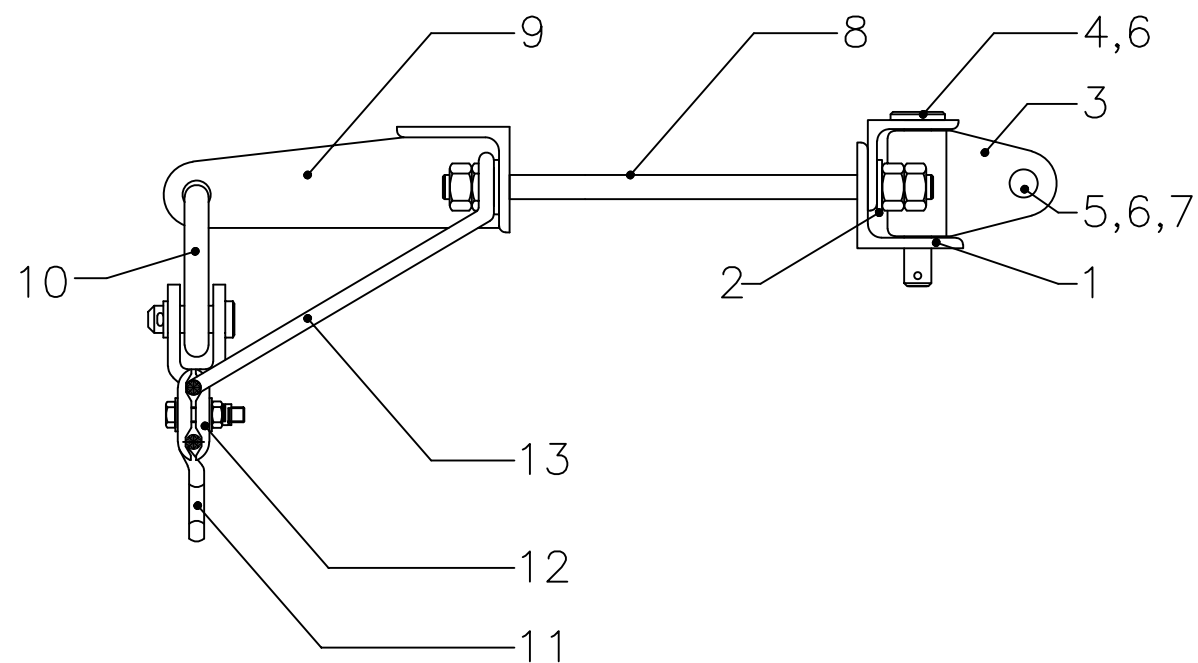

13	EARTHING CONNECTION L=400	1	01LC00BDG260	101
12	CLAMP	1	ELC 2-4.0	
11	EARTHING CONDUCTOR SUSPENSION TYPE I	1	ELC 13-1.4.0	
10	RING	1	ELC 13-1.3.2.0	
9	SPECIAL COUNTERPLATE	1	01LC00BDG261	
8	THREADED ROD M16- 350/100	2	01LC00BDG141	1611C2
7	AXIS 20-50	1	01LC00BDG146	201050
6	PIN. 4,5*40	2	01LC00BDG145	45A040
5	WASHER M20	1	01LC00BDG142	20A110
4	AXIS . 18*110	1	01LC00BDG146	181110
3	HINGE TOP TUBE	1	ELC 13-9.10 A rev. C	
2	WASHER M16N	4	01LC00BDG142	16A110
1	HINGE SUPPORT	1	01LC00BDG088	101
ITEM	DESIGNATION	QUANTITY	REFERENCE DRAWING	MARK

CRAPODINA PENTRU TIRANT CU FIXAREA CABLULUI COLECTOR
FASTENING FOR TOP TUBE WITH EARTHING CONDUCTOR


Numele fisierului/
CAD file name:
01LC00BDG137

Scara/
Scale:

Part
1 / 1


Rev.
0

QUANTITY	1	1	1	1	19	Earthing connection L=400	01LC00BDG260	101
	1	1	1	1	18	CLAMP	ELC 2-4.0	
	1	1	1	1	17	EARTHING CONDUCTOR SUSPENSION TYPE I	ELC 13-1.4.0	
	1	1	1	1	16	RING	ELC 13-1.3.2.0	
	1	1	1	1	15	SPECIAL COUNTERPLATE	01LC00BDG261	
	4	4	4	4	14	WASHER TYPE U	01LC00BDG142	16A710
	10	10	8	8	13	WASHER . CS-16-32-2.8	01LC00BDG142	16A310
	3	3	2	2	12	AXIS 20-50	01LC00BDG146	201050
	3	3	2	2	11	WASHER M20	01LC00BDG142	20A110
	3	3	2	2	10	HINGE TOP TUBE	ELC 13-9.10 A REV C	
	6	6	4	4	9	PIN 4.5*40	01LC00BDG145	45A040
	3	3	2	2	8	AXIS 18-110	01LC00BDG146	181110
	3	3	2	2	7	HINGE SUPPORT	01LC00BDG114	
	1	1	1	1	6	COUNTERPLATE	01LC00BDG090	101
	10	10	8	8	5	BOLT HM 16-50/50	01LC00BDG144	1612H1
	18	18	16	16	4	WASHER M16N	01LC00BDG142	16A110
	4	4	4	4	3	THREADED ROD M16 -350/100	01LC00BDG141	1611C2
	2	2	2	2	2	COUNTERPLATE FOR SPREADER	01LC00BDG094	
	1		1		1	SPREADER (1.60m)	01LC00BDG115	
		1		1		SPREADER	01LC00BDG089	
MARK GROUP	211	201	111	101	ITEM	DESIGNATION	REFERENCE DRAWING	MARK

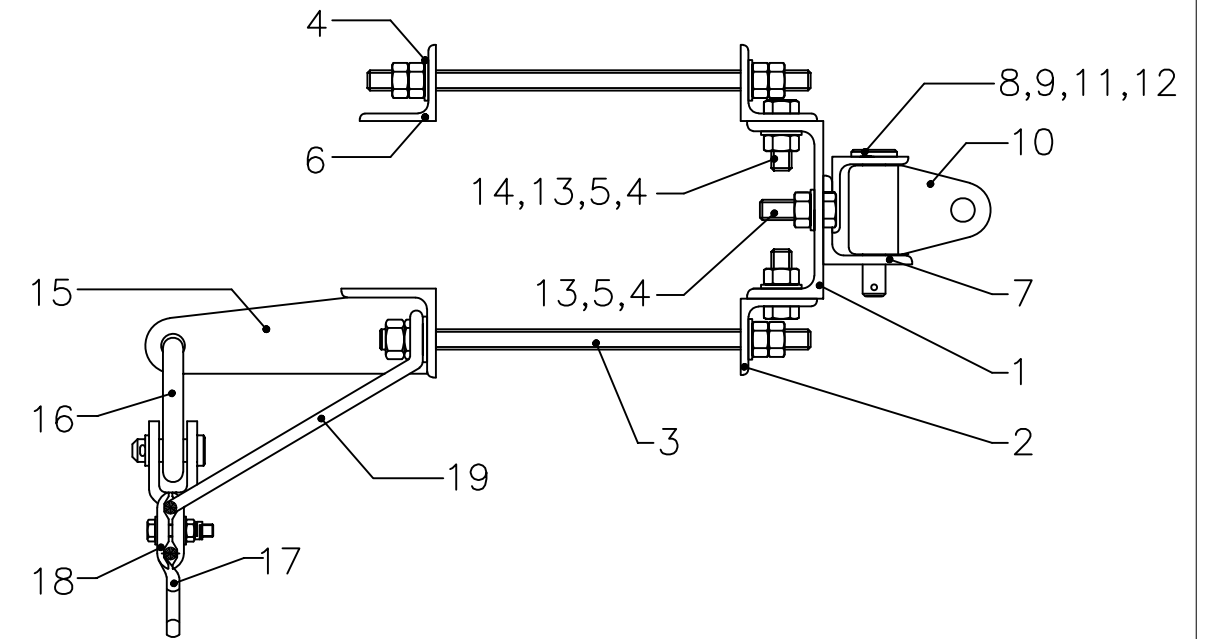

ON H BEAM	ASSEMBLY ALLOCATION			
	2 TOP TUBES SPACING 1.00 m	3 TOP TUBES SPACING 0.50 m	2 TOP TUBES SPACING 1.60 m	3 TOP TUBES SPACING 0.80 m
HE 200 TO 240	101	201	111	211

TRAVERSA PENTRU 2 SAU 3 TIRANTI CU FIXAREA CABLULUI PURTATOR SPREADER ASSEMBLY FOR 2 OR 3 TOP TUBES WITH EARTHING CONDUCTOR	Numele fisierului/ CAD file name:	Scara/ Scale:	Part	Rev.
	01LC00BDG138		1 / 1	0

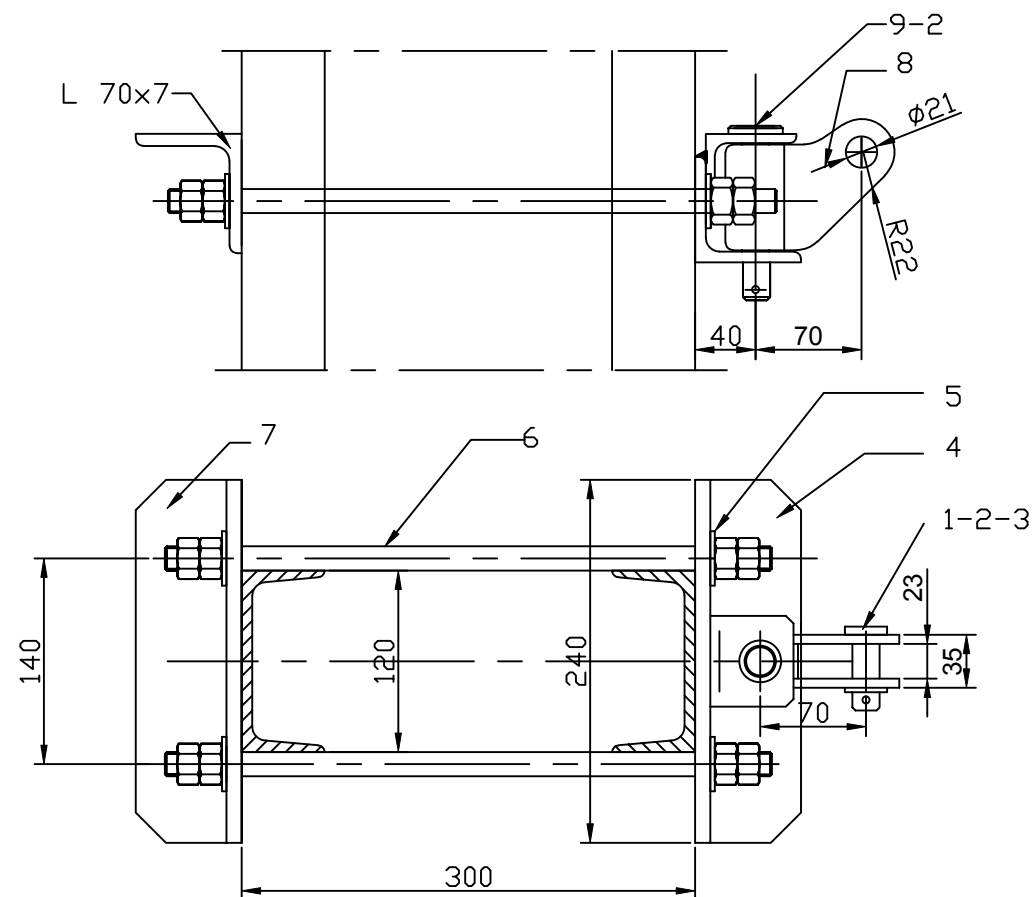

1	9	AXIS 18*110		01LC00BDG146	181110
1	8	HINGE STRUT TUBE		ELC 13-9.10 A rev C	
1	7	COUNTERPLATE		LC 4662-7	
2	6	THREADED ROD M16- 450/100		01LC00BDG141	1611E2
4	5	WASHER M16N		01LC00BDG142	16A110
1	4	HINGE SUPPORT		LC 4662-4	
1	3	AXIS 20-50		01LC00BDG142	201050
1	2	PIN. 4,5*40		01LC00BDG142	45A040
1	1	WASHER M20		01LC00BDG142	20A110
QUANTITY	ITEM	DESIGNATION	UNIT MASS	REFERENCE DRAWING	MARK
			kg		


CARPODINA PENTRU CONTRAFISA PENTRU STALP MU
(300X120)
FASTENING FOR STRUT TUBE FOR MU (300X120)

Numele fisierului/
CAD file name:
01LC00BDG139

Scara/
Scale:

Part
1 / 1

Rev.
0

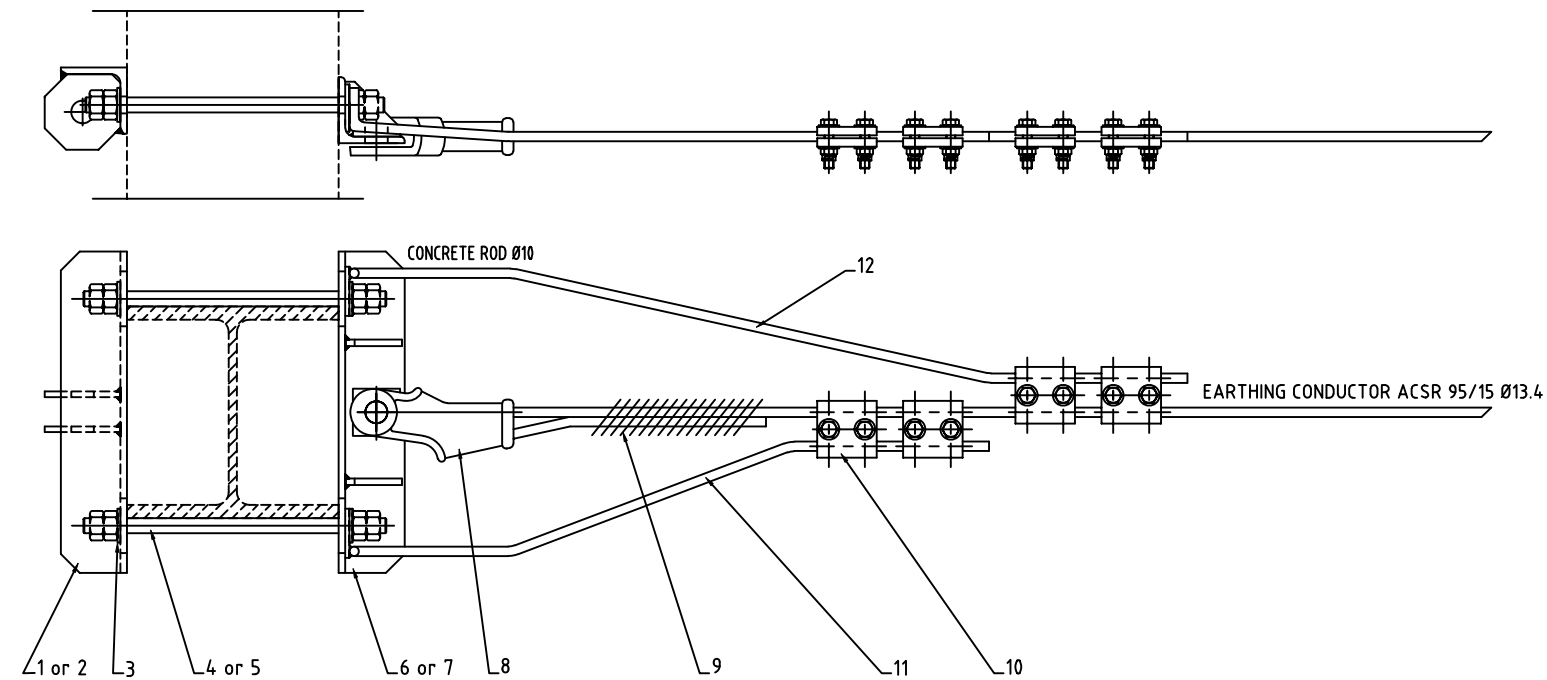

FROM HEA or HEB 200 TO 240 : MARK GROUP 101
 FROM HEA or HEB 260 TO 320 : MARK GROUP 102

QUANTITY	1	1	12	EARTHING CONNECTION L=900	01LC00BDG260	103
	1	1	11	EARTHING CONNECTION L=700	01LC00BDG260	102
	4	4	10	CLAMP	ELC 2-4.0	
	1	1	9	IRON	STAS 434-73	
	1	1	8	CLAMP	ELC 9-29-0	
	2		7	ANGLE FOR EARTHING ANCHORING	01LC00BDG131	102
		2	6	ANGLE FOR EARTHING ANCHORING	01LC00BDG131	101
	2		5	THREADED ROD M16 - 450/100	01LC00BDG141	1611E2
		2	4	THREADED ROD M16 - 350/100	01LC00BDG141	1611C2
	4	4	3	WASHER M16	01LC00BDG142	16A110
	1		2	COUNTERPLATE FOR EARTHING ANCHORING	01LC00BDG133	102
		1	1	COUNTERPLATE FOR EARTHING ANCHORING	01LC00BDG133	101
MARK GROUP	102	101	ITEM	DESIGNATION	REFERENCE DRAWING	MARK

FIXARE PENTRU ANCORAREA CABLULUI COLECTOR PENTRU STALP HEA SAU HEB 200 LA 240
 FASTENING FOR ANCHORING OF EARTH CONDUCTOR FOR MAST HEA OR HEB 200 TO 240

Numele fisierului/
 CAD file name:
01LC00BDG140

Scara/
 Scale:

Part
 1 / 1
 Rev.
 0

NOTES AND DIGITS EXPLANATIONS

THE NUMBER OF DIGITS FOR NUMBERING THE THREADED RODS IS 6

THE EXPLANATION OF EACH DIGIT IS AS FOLLOWS :

NUMBER OF NUTS	
1	4 NUTS
2	6 NUTS

NOMINAL DIAMETER (mm)

1 6 1 1 G 2

MATERIAL	
1	GALVA. STEEL STANDARD GRADE
2	STAINLESS STEEL
3	GALVA. STEEL GRADE 6.8
4	GALVA. STEEL GRADE 8.8
5	GALVA. STEEL GRADE 10.9

LENGTH L (mm)	
A	250
B	300
C	350
D	400
E	450
F	500
G	550
H	600
J	650
K	700
L	750
M	800
N	850
P	900
R	950
T	1000

THREAD LENGTH (X) mm	
1	ALL THE LENGTH
2	100
3	125
4	150
5	175
6	200
7	300

NOTES :

1) THREADED ROD ASSEMBLY INCLUDE DIFFERENT PARTS AS FOLLOWS :

IF 4TH. DIGIT OF ALLOCATION IS N°1 :

- 1 THREAD ROD
- 4 NUTS

2) DIMENSIONAL SPECIFICATIONS :

2.1) THREADED ROD

DIMENSIONAL SPECIFICATIONS OF THREADED RODS HAVE BEEN ESTABLISHED FROM THE FOLLOWING STANDARDS :

* NF E 25-136

2.2) NUTS

DIMENSIONAL SPECIFICATIONS OF NUTS HAVE BEEN ESTABLISHED FROM THE FOLLOWING STANDARDS :

* NF EN ISO 4032 OR NF EN ISO 4034

3) MECHANICAL SPECIFICATIONS :

THE NORMAL GRADE (3RD DIGIT OF ALLOCATION IS N°1) IS GRADE 5.6 MINIMUM .

3.1) GENERAL REMARKS FOR STEEL

THREADED ROD WITH $\varnothing \leq 12$ mm MUST BE IN STAINLESS STEEL .

THREADED ROD WITH $\varnothing \geq 14$ mm IS GENERALLY GALVANIZED STEEL .

3.2) STAINLESS STEEL

MECHANICAL SPECIFICATIONS HAVE BEEN ESTABLISHED FROM THE FOLLOWING STANDARDS :

* NF EN 10088-3 (GRADE A2-70 OR A4-70)

3.3) STEEL

MECHANICAL SPECIFICATIONS HAVE BEEN ESTABLISHED FROM THE FOLLOWING STANDARDS :

* NF A 35-053 OR NF EN 10025

4) PROTECTION

FOR STEEL :


HOT DIP GALVANIZING HAS BEEN ESTABLISHED FROM THE FOLLOWING STANDARDS :

* NF EN ISO 1461

5) THREADING

INTERNAL THREADS SHALL BE TAPPED OVER SIZE AFTER GALVANIZING BY A DIAMETRICAL AMOUNT SUFFICIENT TO PERMIT ASSEMBLY OF A COMPONENT WITH EXTERNAL THREADING TO STANDARD : * ISO 965-2 AND GALVANIZED TO THE ABOVE STANDARDS .


THREADS SHALL BE PROTECTED WITH GREASE AFTER TAPPING .

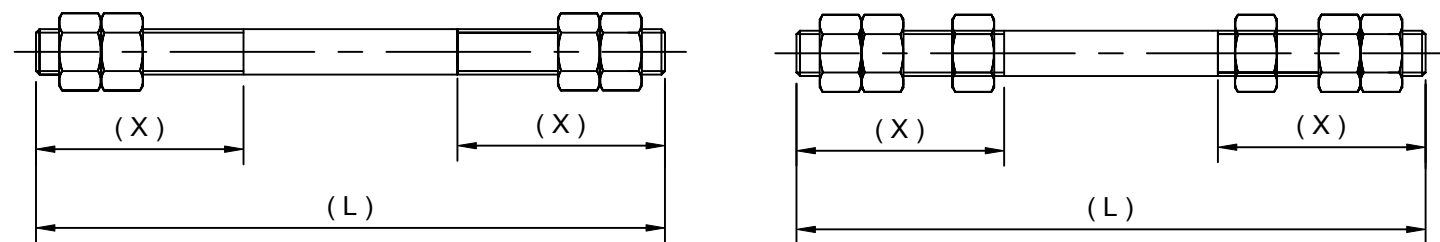

PREZON THREADED ROD	Numele fisierului/ CAD file name:	Scara/ Scale:	Part	Rev.
	01LC00BDG141		1 / 1	0

NOTES AND DIGITS EXPLANATIONS

THE NUMBER OF DIGITS FOR NUMBERING THE WASHERS IS 6
THE EXPLANATION OF EACH DIGIT IS AS FOLLOWS :

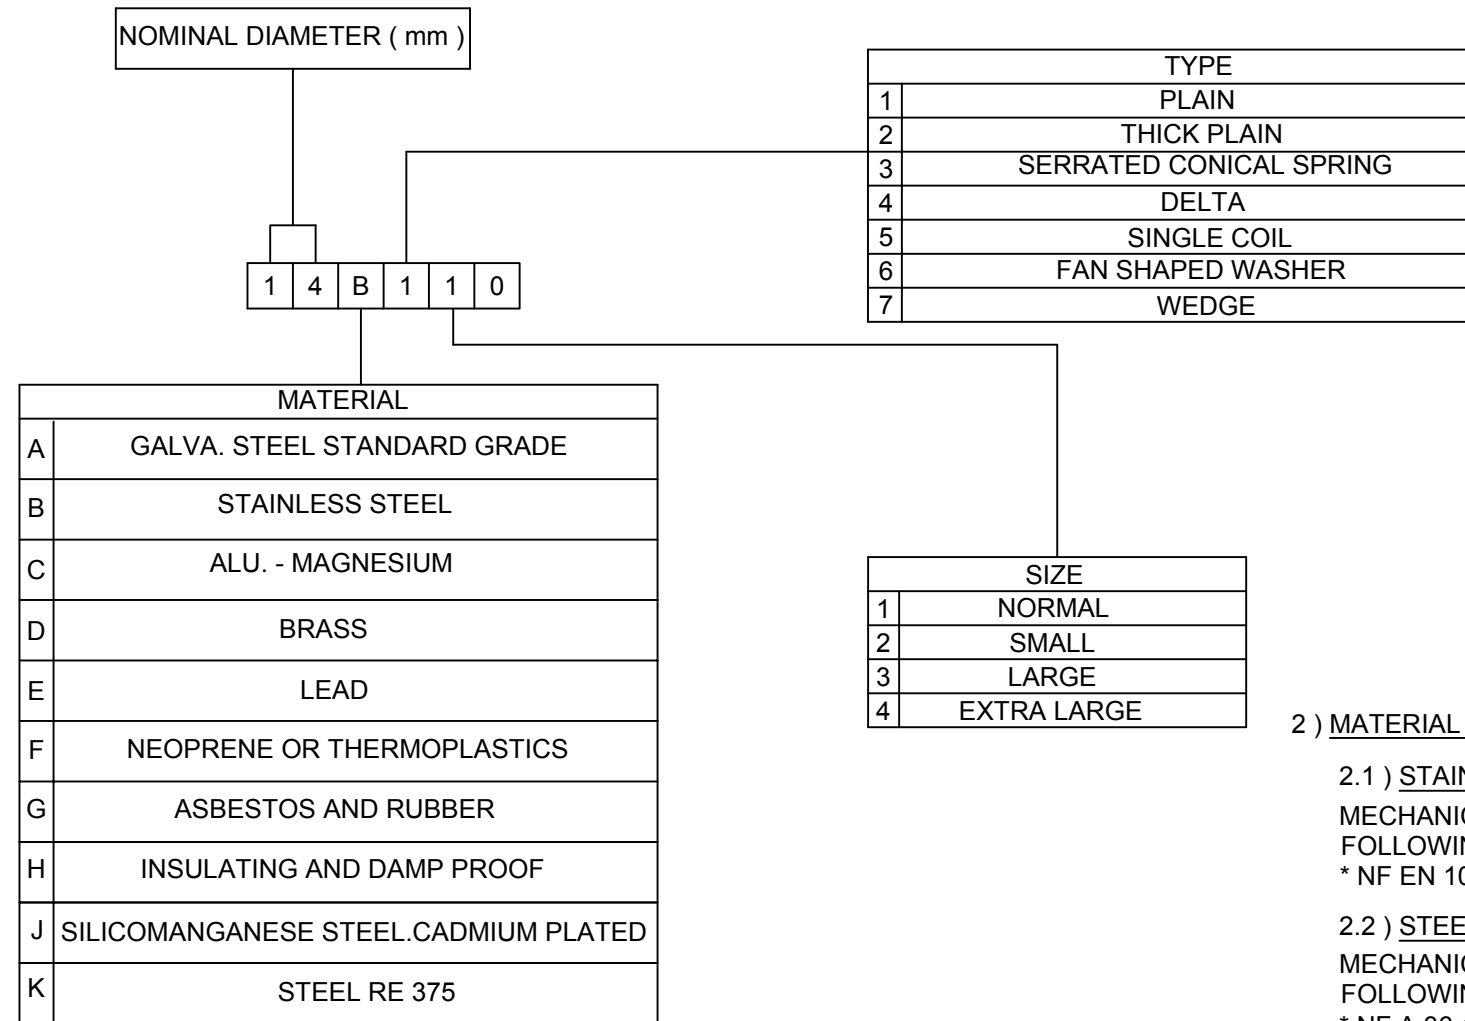

NOTES :

1) DIMENSIONAL SPECIFICATIONS :

1.1) PLAIN WASHER (NORMAL WASHER, SMALL WASHER, LARGE WASHER, EXTRA LARGE WASHER)
DIMENSIONAL SPECIFICATION HAVE BEEN ESTABLISHED FROM THE FOLLOWING STANDARDS :

* NF EN ISO 7091 OR NF EN ISO 7089

1.2) THICK PLAIN WASHER

DIMENSIONAL SPECIFICATIONS HAVE BEEN ESTABLISHED FROM THE FOLLOWING STANDARDS :

* NF E 25-518

1.3) SINGLE COIL SPRING SQUARE (WITHOUT LIP)

DIMENSIONAL SPECIFICATIONS HAVE BEEN ESTABLISHED FROM THE FOLLOWING STANDARDS :

* NF E 25-515

1.4) SERRATED CONICAL SPRING WASHER

DIMENSIONAL SPECIFICATIONS HAVE BEEN ESTABLISHED FROM THE FOLLOWING STANDARDS :

* NF E 25-511

1.5) FAN SHAPED WASHER

DIMENSIONAL SPECIFICATIONS HAVE BEEN ESTABLISHED FROM THE FOLLOWING STANDARDS :

* NF E 27-624

1.6) WEDGE

DIMENSIONAL SPECIFICATIONS HAVE BEEN ESTABLISHED FROM THE FOLLOWING STANDARDS :

* NF E 27-681

2) MATERIAL SPECIFICATIONS :

2.1) STAINLESS STEEL

MECHANICAL SPECIFICATIONS HAVE BEEN ESTABLISHED FOLLOWING STANDARDS :

* NF EN 10088-3 (GRADE A2 OR A4)

2.2) STEEL

MECHANICAL SPECIFICATIONS HAVE BEEN ESTABLISHED FOLLOWING STANDARDS :

* NF A 36-102

2.3) STEEL : RE 375

MECHANICAL SPECIFICATIONS HAVE BEEN ESTABLISHED FOLLOWING STANDARDS :

* NF EN 10089

3) PROTECTION :


FOR STEEL :

HOT DIP GALVANIZING HAS BEEN ESTABLISHED FROM THE FOLLOWING STANDARDS :

* NF EN ISO 1461

LEGEND OF WASHERS TYPE :


TYPE 1 : PLAIN TYPE 2 : THICK PLAIN TYPE 3 : SERRATED CONICAL SPRING

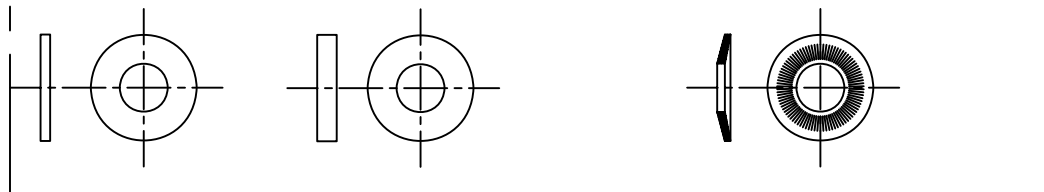

TYPE 4 : DELTA TYPE 5 : SINGLE COIL TYPE 6 : FAN SHAPED WASHER




TYPE 7 : WEDGE

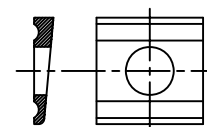

SAIBA
WASHER

Numele fisierului/ CAD file name:	Scara/ Scale:	Part	Rev.
01LC00BDG142		1 / 1	0

NUMBERING SYSTEM FOR U BOLT

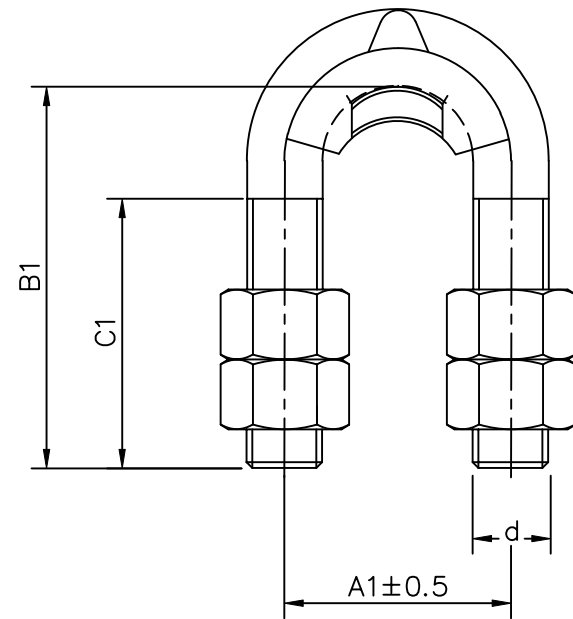

NOTES :

1) DIMENSIONAL SPECIFICATIONS :

1.1) U BOLT

DIMENSIONAL SPECIFICATIONS HAVE BEEN ESTABLISHED FROM THE FOLLOWING STANDARDS :
 THE BENDING OF U-BOLT OF DIAMETER >14 MM, WILL BE MANUFACTURED HOT BEND .
 * NF E 25-136

1.2) NUTS

DIMENSIONAL SPECIFICATIONS HAVE BEEN ESTABLISHED FROM THE FOLLOWING STANDARDS :
 * NF EN ISO 4032 OR NF EN ISO 4034

2) MECHANICAL SPECIFICATIONS :

THE NORMAL GRADE N° 1 , A , C , E , G OR J (4 TH. DIGIT) IS 5.6 MINIMUM .

2.1) GENERAL REMARKS FOR STEEL

U BOLTS WITH $\varnothing \leq 12$ MM MUST BE IN STAINLESS STEEL .
 U BOLTS WITH $\varnothing \geq 14$ MM ARE GENERALLY IN GALVANIZED STEEL .

2.2) STAINLESS STEEL

MECHANICAL SPECIFICATIONS HAVE BEEN ESTABLISHED FROM THE FOLLOWING STANDARDS :
 * NF EN 10088-3 (GRADE A2-70 OR A4-70)

2.3) STEEL

MECHANICAL SPECIFICATIONS HAVE BEEN ESTABLISHED FROM THE FOLLOWING STANDARDS :
 * NF EN 10083-2 (GRADE AF37 C12)

3) PROTECTION

FOR STEEL :
 HOT DIP GALVANIZING HAS BEEN ESTABLISHED FROM THE FOLLOWING STANDARDS :
 * NF EN ISO 1461

4) THREADING

INTERNAL THREADS SHALL BE TAPPED OVER SIZE AFTER GALVANIZING BY
 A DIAMETRICAL AMOUNT SUFFICIENT TO PERMIT ASSEMBLY OF A COMPONENT
 WITH EXTERNAL THREADING TO STANDARD : * ISO 965-2 AND GALVANIZED TO THE
 ABOVE STANDARDS
 THREADS SHALL BE PROTECTED WITH GREASE AFTER TAPPING .

5) CAP SPECIFICATION

THE CAP WILL BE DELIVERED MOUNTED ON THE U BOLT .

TABLE A

REF. :

1	2	2	4	N	1
---	---	---	---	---	---

NOMINAL DIAMETER d (mm)

TABLE C			
CAP/MATERIAL			
1	WITHOUT CAP/STAINLESS STEEL		
2	WITH CAP/STAINLESS STEEL		
3	WITHOUT CAP/GALVA.STEEL GRADE 4.8		
4	WITH CAP/GALVA.STEEL GRADE 4.8		
5	WITHOUT CAP/GALVA.STEEL GRADE 8.8		
6	WITH CAP/GALVA.STEEL GRADE 8.8		
7	WITHOUT CAP/GALVA.STEEL GRADE 10.9		
8	WITH CAP/GALVA.STEEL GRADE 10.9		

TABLE B			
NUMBER OF NUT			
0	NO NUT		
1	2 FULL NUTS		
2	4 FULL NUTS		
3	6 FULL NUTS		
4	8 FULL NUTS		
5	2 SLOTTED SELF-LOCKING NUTS		


TABLE D				
	DIMENSION			
	A1	B1	C1	
A	20	35	28	1
	20	50	43	2
B	26	45	30	1
	26	60	40	2
C	27	38.5	25	1
	27	58.5	35	2
D	28	55	25	0
E	30	55	40	0
F	33	60	35	1
	33	105	80	2
G	35	45	25	0
H	36	55	36	1
	36	60	35	2
J	39	60	35	0
K	40	90	35	1
	40	45	20	2
	40	55	35	3
	40	110	70	4
	40	75	55	5
	40	110	50	6
L	42	55	25	1
	42	58	30	2
	42	105	50	3
M	44	110	45	0
	44	80	30	1
	A1	B1	C1	

TABLE E				
	DIMENSION			
	A1	B1	C1	
N	45	50	30	1
	45	50	25	2
P	47	53	30	0
	50	60	25	1
R	50	65	30	2
	50	75	30	3
T	55	60	35	0
U	57	63	30	0
V	58	60	20	0
W	61	65	30	1
	61	75	30	2
	61	80	35	3
X	62	74	30	1
	62	90	25	2
	62	170	30	3
Y	65	80	50	0
1	68	73	30	1
	68	80	30	2
2	69	70	20	0
3	70	75	30	0
	74	85	35	0
4	74	110	35	1
	95	109	32	1
5	95	130	45	2
	60	75	20	1
6	60	80	30	2
	80	90	45	1
	A1	B1	C1	

BOLT TIP U U-BOLT	Numele fisierului/ CAD file name:	Scara/ Scale:	Part	Rev.
	01LC00BDG143		1 / 1	0

NOTES AND DIGITS EXPLANATIONS


THE NUMBER OF DIGITS FOR NUMBERING THE BOLTS IS 6
THE EXPLANATION OF EACH DIGIT IS AS FOLLOWS :

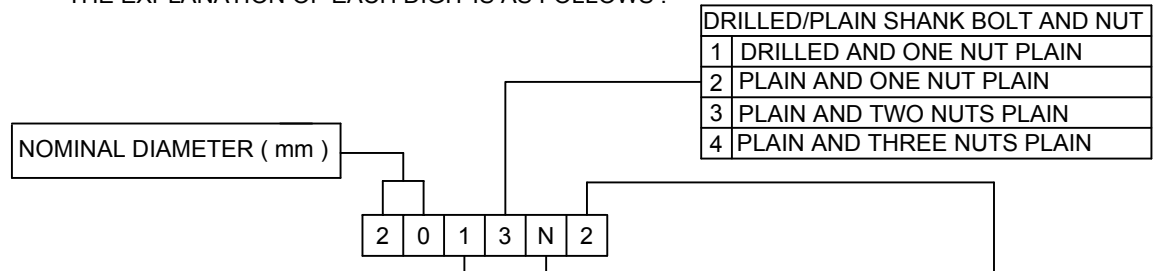

MATERIAL	
1	GALVA. STEEL STANDARD GRADE
2	STAINLESS STEEL
3	GALVA. STEEL GRADE 6.8
4	GALVA. STEEL GRADE 8.8
5	GALVA. STEEL GRADE 10.9

LENGTH L (mm)	
A	16
B	20
C	25
D	30
E	35
F	40
G	45
H	50
J	55
K	60
L	65
M	70
N	75
P	80
R	85
T	90
U	100
V	110
W	115
X	120
Y	125
Z	130
1	135
2	140
3	150
4	160
5	170
6	180
7	200
8	220

SCREW THREAD LENGTH (X) mm	
1	ALL THE LENGTH
2	2 x DIAMETER + 6 mm
3	2 x DIAMETER + 12 mm
4	22
5	25
6	26
7	32
8	34
9	35
A	37
B	39
C	42
D	44
E	45
F	60
G	80
H	100

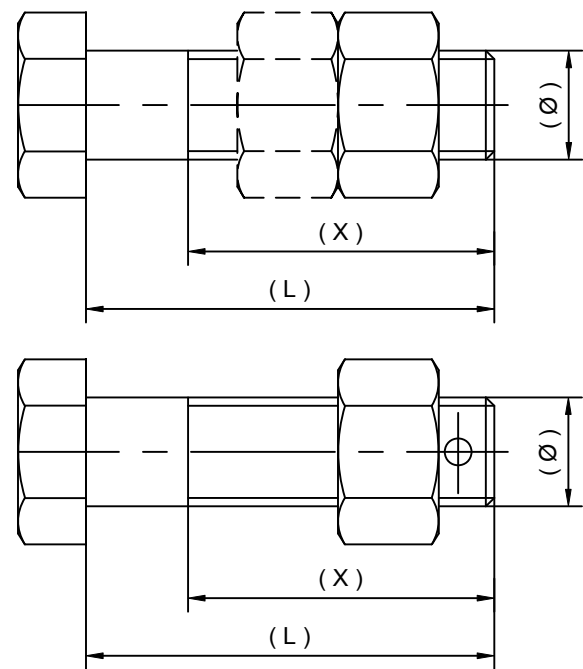


NOTES :

- 1) BOLT ASSEMBLY INCLUDES DIFFERENT PARTS AS FOLLOWS:
 - IF 4TH DIGIT OF ALLOCATION IS N°1 OR N°2:
 - 1 BOLT
 - 1 FULL NUT
 - IF 4TH DIGIT OF ALLOCATION IS N°3:
 - 1 BOLT
 - 2 FULL NUTS
 - IF 4TH DIGIT OF ALLOCATION IS N°4:
 - 1 BOLT
 - 3 FULL NUTS
- 2) DIMENSIONAL SPECIFICATIONS
 - 2.1) BOLTS
DIMENSIONAL SPECIFICATIONS HAVE BEEN ESTABLISHED FROM THE FOLLOWING STANDARDS : * NF E 27-711
 - 2.2) SCREWS
DIMENSIONAL SPECIFICATIONS HAVE BEEN ESTABLISHED FROM THE FOLLOWING STANDARDS :
* NF EN ISO 4014 , NF EN ISO 4016 , NF EN ISO 4017 OR NF EN ISO 4018
 - 2.3) FULL NUTS
DIMENSIONAL SPECIFICATIONS HAVE BEEN ESTABLISHED FROM THE FOLLOWING STANDARDS :
* NF EN ISO 4032 OR NF EN ISO 4034
- 3) MECHANICAL SPECIFICATIONS
THE NORMAL GRADE N° 1 (3 RD. DIGIT.) IS 5.6 MINIMUM .
 - 3.1) GENERAL REMARKS FOR STEEL
BOLTS WITH Ø < 12 MM MUST BE IN STAINLESS STEEL
BOLTS WITH Ø > 14 MM ARE GENERALLY IN GALVANIZED STEEL
 - 3.2) STAINLESS STEEL
MECHANICAL SPECIFICATIONS HAVE BEEN ESTABLISHED FROM THE FOLLOWING STANDARD :
* NF EN 10088-3 (GRADE A2-70 OR A4-70)
 - 3.3) STEEL
MECHANICAL SPECIFICATIONS HAVE BEEN ESTABLISHED FROM THE FOLLOWING STANDARD :
* NF A 35-053 OR NF EN 10025
- 4) DRILLING (HOLE)
DRILLINGS HAVE BEEN ESTABLISHED FROM THE FOLLOWING STANDARD : * NF E 27-488
- 5) PROTECTION
FOR STEEL :
HOT DIP GALVANIZED HAS BEEN ESTABLISHED FROM THE FOLLOWING STANDARDS : * NF EN ISO 1461
- 6) THREADING
INTERNAL THREADS SHALL BE TAPPED OVER SIZE AFTER GALVANIZING BY A DIAMETRICAL AMOUNT SUFFICIENT TO PERMIT ASSEMBLY ON A COMPONENT WITH EXTERNAL THREADING TO STANDARD : * ISO 965-2 AND GALVANIZED TO THE ABOVE STANDARDS.
THE THREADS SHALL BE PROTECTED WITH GREASE AFTER TAPPING .
- 7) SCREWING UP
IN CASES WHERE A TORQUE IS SPECIFIED , BOLTS WILL BE SECURED MANUALLY USING STANDARD EQUIPEMENT.
WHEN USING SPRING OR CUPPED WASHERS , THESE WILL HAVE TO BE FLATTENED TO ENSURE CORRECT TORQUE .

BOLT BOLT	Numele fisierului/ CAD file name:	Scara/ Scale:	Part	Rev.
	01LC00BDG144		1 / 1	0

NOTES AND DIGITS EXPLANATIONS

THE NUMBER OF DIGITS FOR NUMBERING THE SPLIT PIN AND RIVET IS 6
THE EXPLANATION OF EACH DIGIT IS AS FOLLOWS :

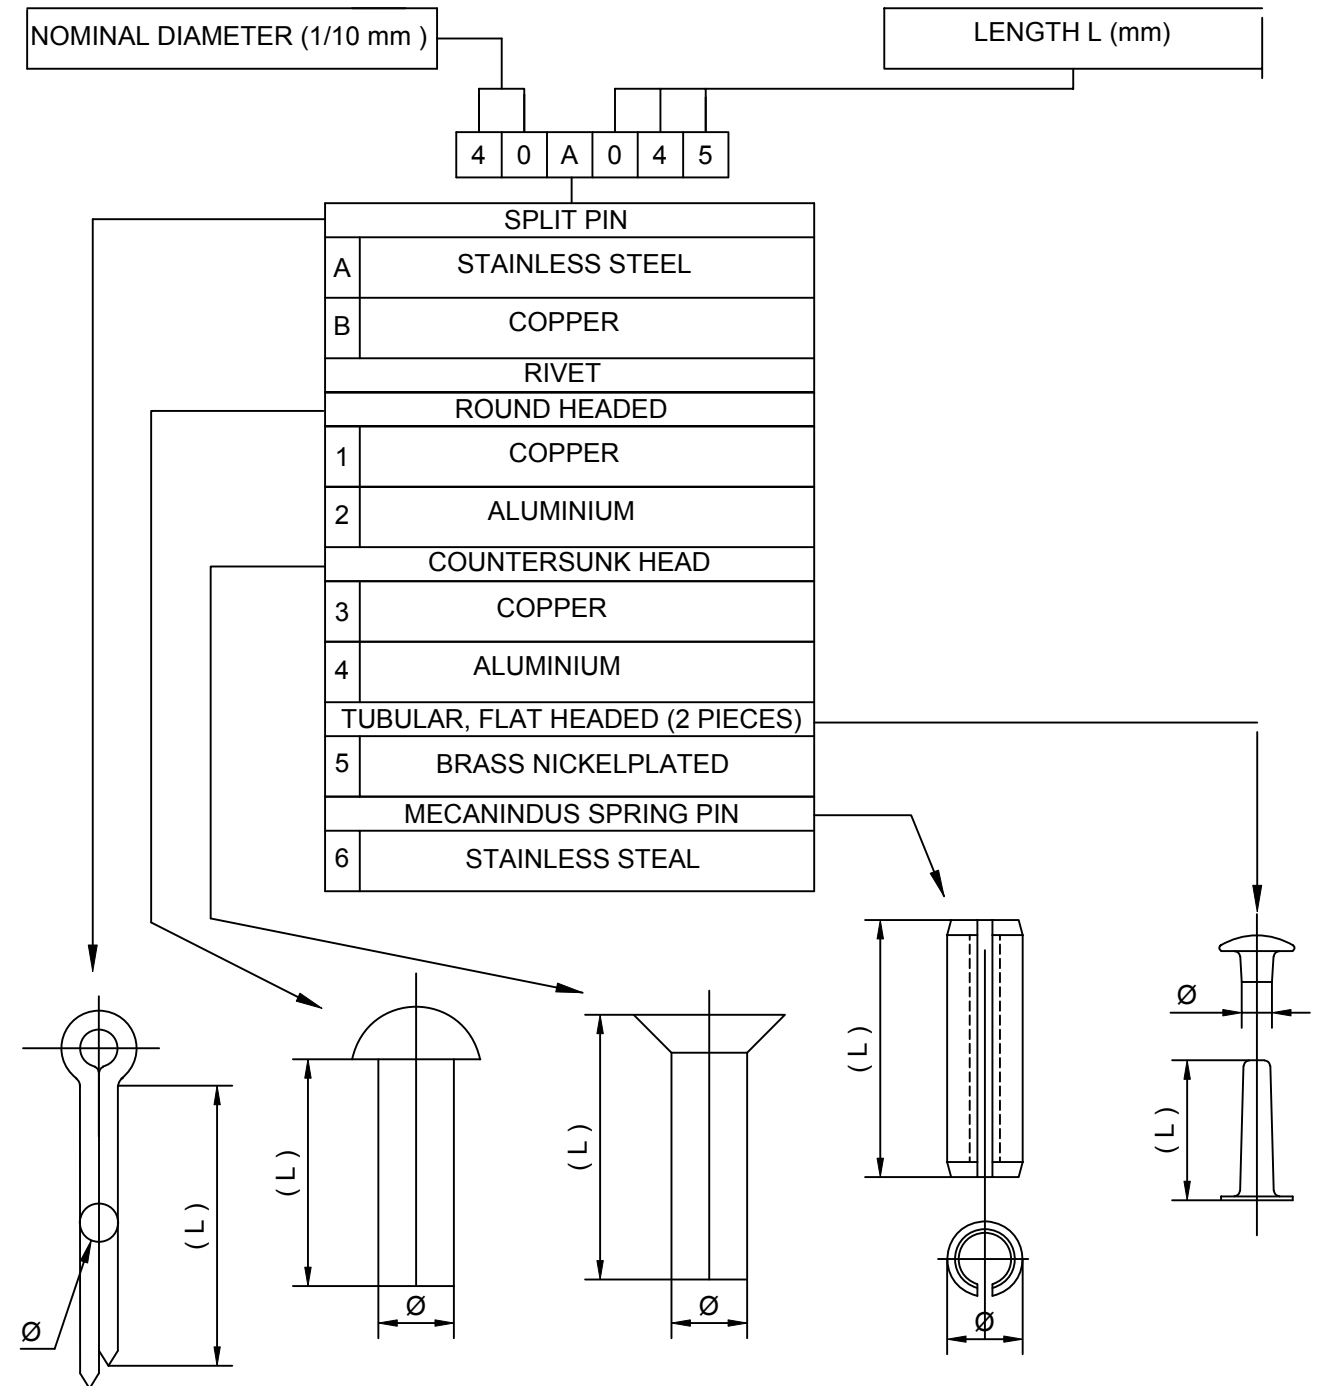

NOTES :

1) DIMENSIONAL SPECIFICATIONS :

1.1) SPLIT PINS

DIMENSIONAL SPECIFICATIONS HAVE BEEN ESTABLISHED FROM THE FOLLOWING STANDARDS :

* NF EN ISO 1234

1.2) RIVETS

DIMENSIONAL SPECIFICATIONS HAVE BEEN ESTABLISHED FROM THE FOLLOWING STANDARDS :

ROUND HEADED

* NF E 27-153

* NF E 27-155

COUNTERSUNK HEAD

* NF E 27-154

* NF E 27-155

TUBULAR , FLAT HEADED (2 COMPONENTS)

* NF R 93-506

2) MECHANICAL SPECIFICATIONS :

2.1) STAINLESS STEEL

MECHANICAL SPECIFICATIONS HAVE BEEN ESTABLISHED FROM THE FOLLOWING STANDARDS :

* NF EN 10088-3 (GRADE A2-70 OR A4-70)

2.2) COPPER

MECHANICAL SPECIFICATIONS HAVE BEEN ESTABLISHED FROM THE FOLLOWING STANDARDS :

* NF A 54-118-1

2.3) ALUMINIUM

MECHANICAL SPECIFICATIONS HAVE BEEN ESTABLISHED FROM THE FOLLOWING STANDARDS :

* NF EN 1301 (GRADE 1050 A)

2.4) BRASS NICKELPLATED :

MECHANICAL SPECIFICATIONS HAVE BEEN ESTABLISHED FROM THE FOLLOWING STANDARDS :

* NF EN 12163 (GRADE CU ZN 36)

SPLINT SPLIT PIN	Numele fisierului/ CAD file name:	Scara/ Scale:	Part	Rev.
	01LC00BDG145		1 / 1	0

NUMBERING SYSTEM FOR AXIS



TABLE A

REF. :

1	0	2	0	6	0
---	---	---	---	---	---

NOMINAL DIAMETER d (mm)

LENGTH L (mm)

TABLE B

MATERIAL	
1	GALVA.STEEL STANDARD GRADE Fe 430B
2	STAINLESS STEEL
3	GALVA.STEEL GRADE Fe 360B
4	GALVA.STEEL GRADE Fe 510C

NOTES :

1) DIMENSIONAL SPECIFICATIONS :

DIMENSIONAL SPECIFICATIONS OF SNAP HEAD PINS HAVE BEEN ESTABLISHED FROM THE FOLLOWING STANDARDS :
* NF EN 21341

2) MECHANICAL SPECIFICATIONS :

2.1) GENERAL REMARKS FOR STEEL

SNAP HEAD PIN WITH $\varnothing < 12$ mm MUST BE IN STAINLESS STEEL .
SNAP HEAD PIN WITH $\varnothing > 14$ mm ARE GENERALLY IN GALVANIZED STEEL .

2.2) STAINLESS STEEL

MECHANICAL SPECIFICATIONS HAVE BEEN ESTABLISHED FROM THE FOLLOWING STANDARDS :
* NF EN 10088-3 (GRADE A2-70 OR A4-70)

2.3) STEEL

MECHANICAL SPECIFICATIONS HAVE BEEN ESTABLISHED FROM THE FOLLOWING STANDARDS :
* NF EN 10083-2 (GRADE AF37 C12)


3) DRILLING (HOLE) :

DRILLING HAS BEEN ESTABLISHED FROM THE FOLLOWING STANDARD :
* NF E 27-488


4) PROTECTION :

FOR STEEL
HOT DIP GALVANIZING HAS BEEN ESTABLISHED FROM THE FOLLOWING STANDARDS : * NF EN ISO 1461

AX AXIS	Numele fisierului/ CAD file name:	Scara/ Scale:	Part	Rev.
	01LC00BDG146		1 / 1	0

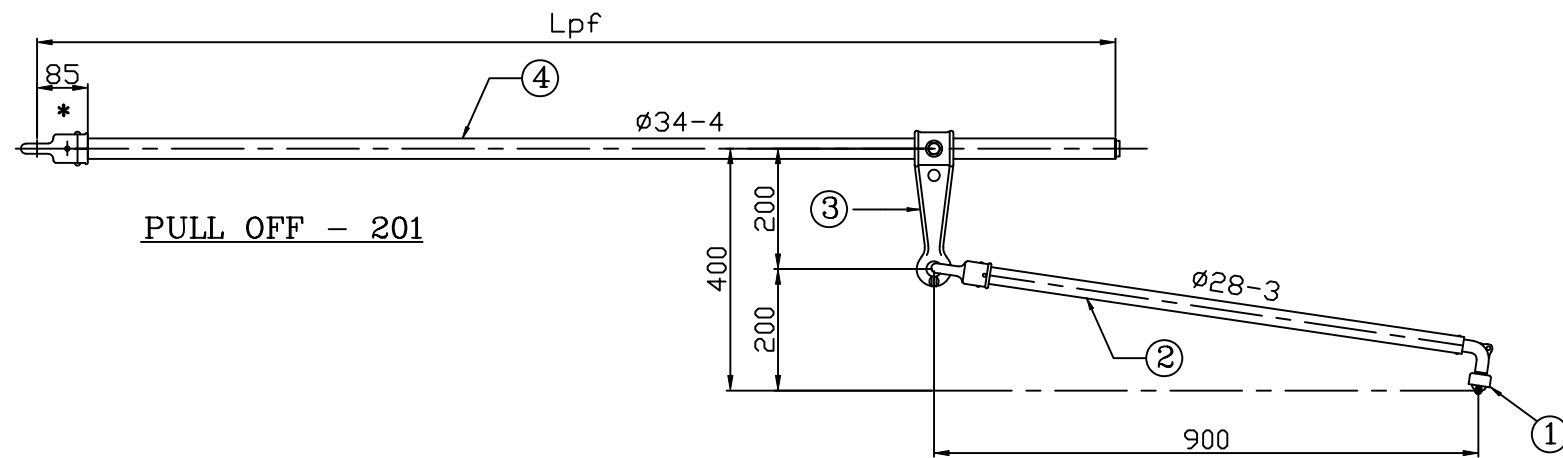

PULL OFF - 201

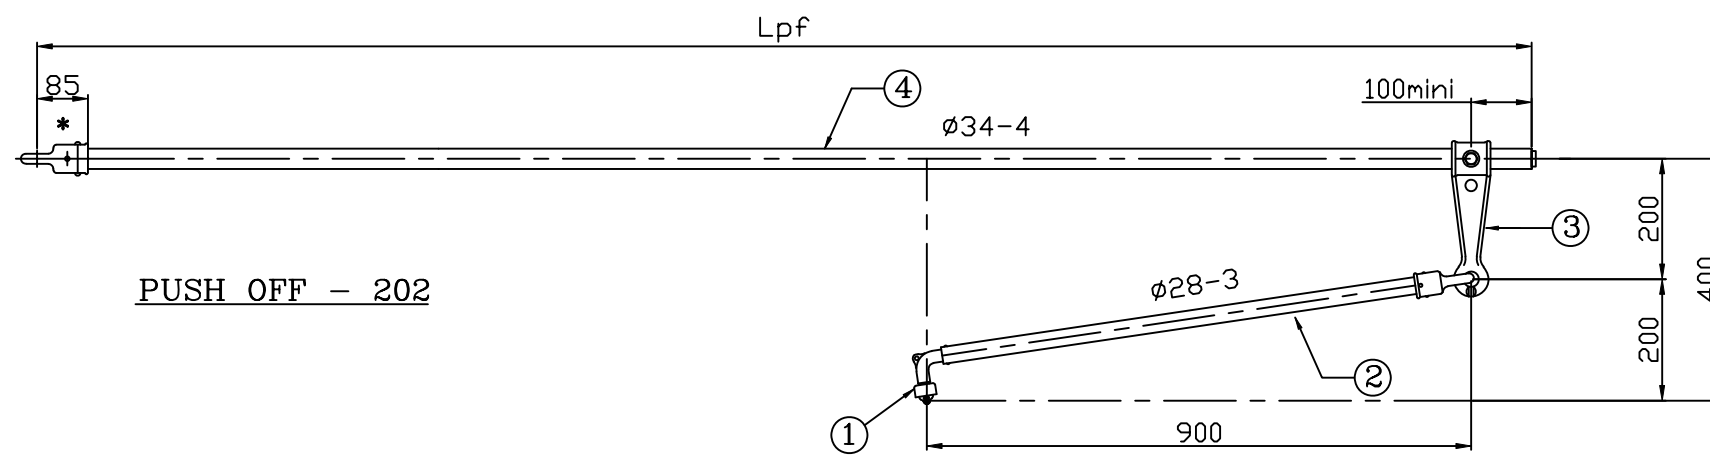

PUSH OFF - 202

MARK GROUP	QUANTITY	1	4	∅34-4 TUBE FOR STEADY ARM	ELC 13-15.0B	
		1	3	STAND OFF ASSEMBLY FOR STEADY ARM	ELC 27-4.8.0	
		1	2	0.9m STEADY ARM FOR STRAIGHT LINE	ELC 32-9.0A	
		1	1	ASSEMBLY CLAMP GROOVED CONTACT WIRE	ELC 32-9.5.5.0B	
MARK GROUP	SEE TABLE	ITEM	DESIGNATION		REFERENCE DRAWING	MARK

PORTFIXATOR ∅ 34-4 CU FIXATOR 0.9m PENTRU LINIE DREAPTA
∅ 34-4 REGISTRATION ARM WITH 0.9m STEADY ARM FOR STRAIGHT LINE

Numele fisierului/
CAD file name:
01LC00BDG150


Scara/
Scale:

Part


Rev.

1 / 1

0

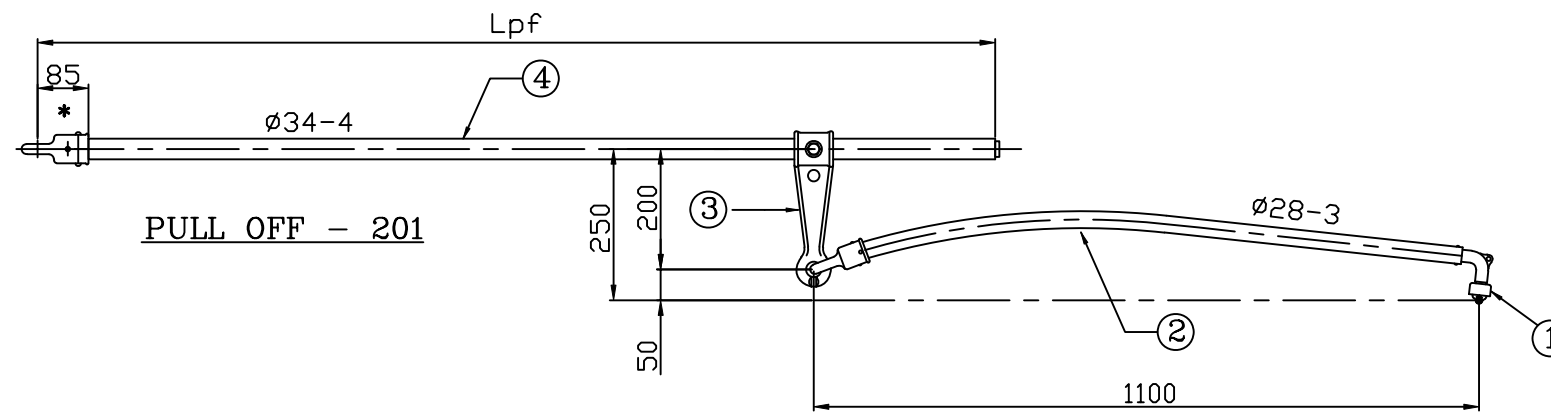

PULL OFF - 201

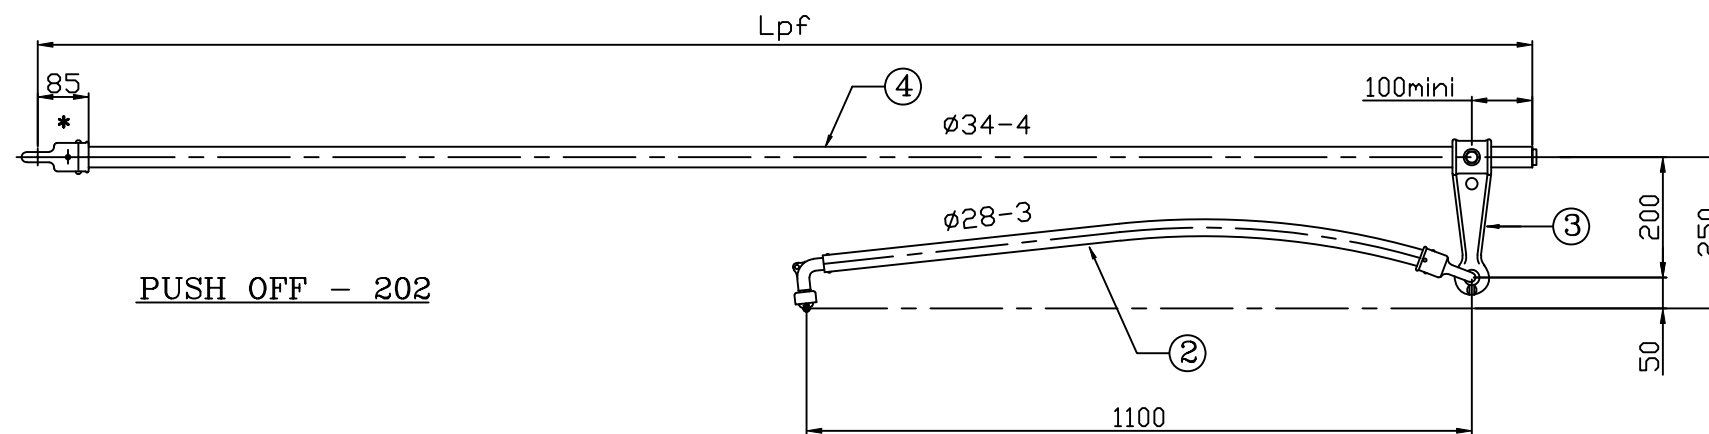

PUSH OFF - 202

MARK GROUP	SEE TABLE	ITEM	DESIGNATION	REFERENCE DRAWING	MARK
	1	4	Ø34-4 TUBE FOR STEADY ARM	ELC 13-15.0B	
	1	3	STAND OFF ASSEMBLY FOR STEADY ARM	ELC 27-4.8.0	
	1	2	1.1m STEADY ARM FOR CURVE	ELC 32-10.0A	
	1	1	ASSEMBLY CLAMP GROOVED CONTACT WIRE	ELC 32-9.5.5.0B	



PORTFIXATOR Ø 34-4 CU FIXATOR 1.1m PENTRU LINIE CURBA
 Ø 34-4 REGISTRATION ARM WITH 1.1m STEADY ARM FOR CURVE

Numele fisierului/
 CAD file name:
01LC00BDG151

Scara/
 Scale:

Part
 1 / 1

Rev.
 0

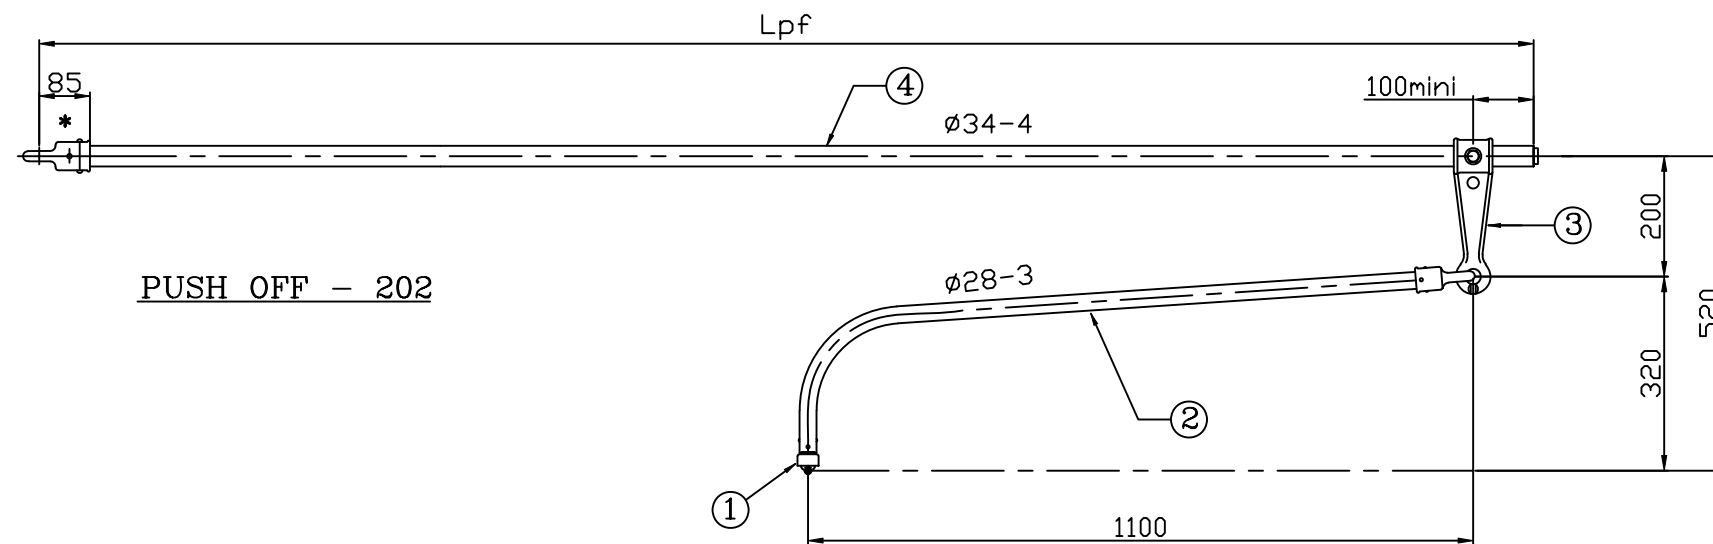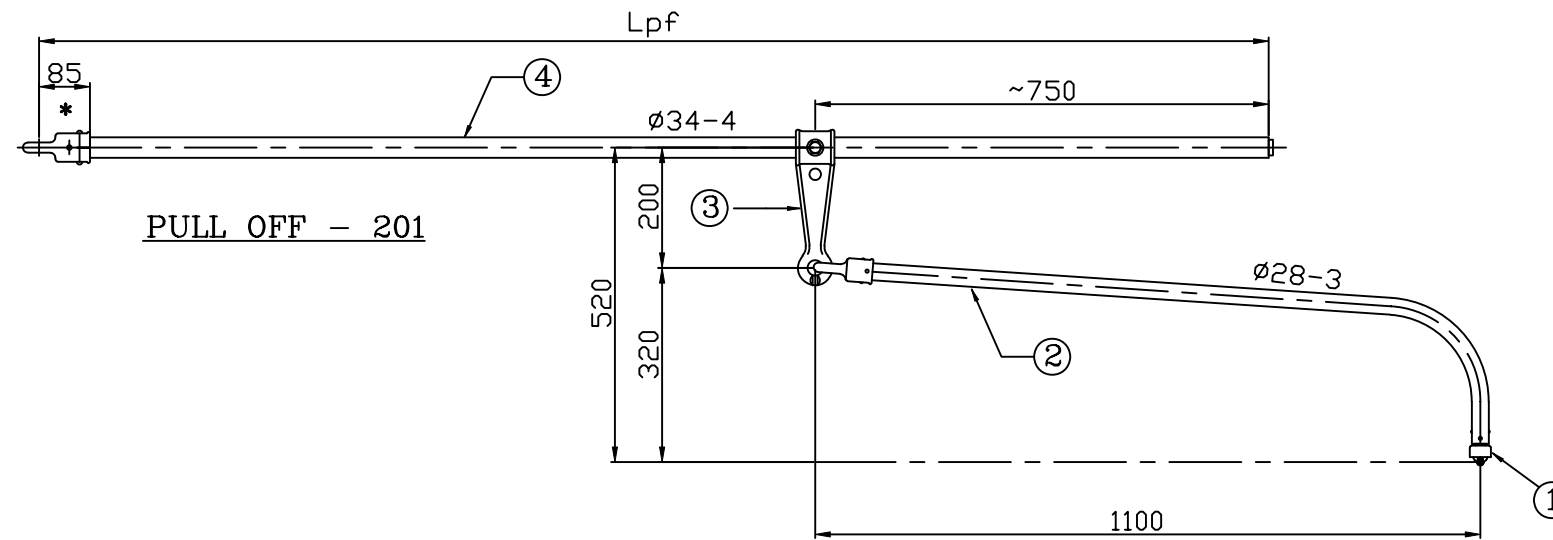

MARK GROUP	QUANTITY	1	4	∅34-4 TUBE FOR STEADY ARM	ELC 13-15.0B	
		1	3	STAND OFF ASSEMBLY FOR STEADY ARM	ELC 27-4.8.0	
		1	2	1.1m STEADY ARM FOR INSULATED OVERLAP	ELC 32-12.0A	
		1	1	ASSEMBLY CLAMP GROOVED CONTACT WIRE	ELC 32-9.5.5.0B	
	SEE TABLE	ITEM	DESIGNATION		REFERENCE DRAWING	MARK



PORTFIXATOR ∅ 34-4 CU FIXATOR 1.1m PENTRU ZONA IZOLATA
 ∅ 34-4 REGISTRATION ARM WITH 1.1m STEADY ARM FOR
 INSULATED OVERLAP

Numele fisierului/
 CAD file name:
01LC00BDG152

Scara/
 Scale:

Part
1 / 1

Rev.
0

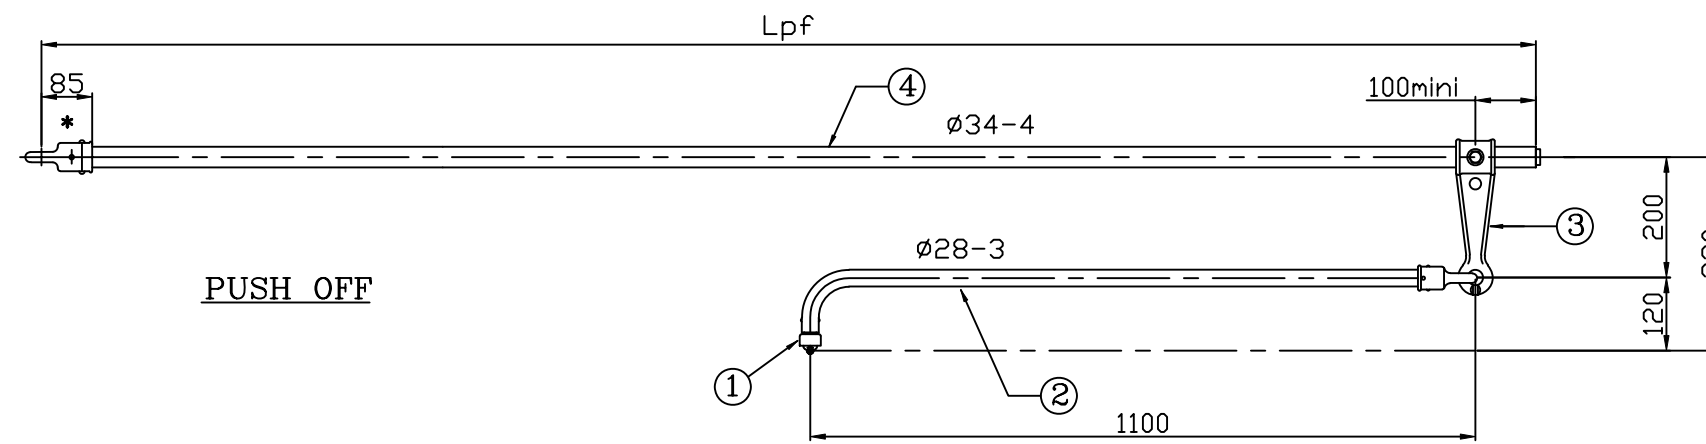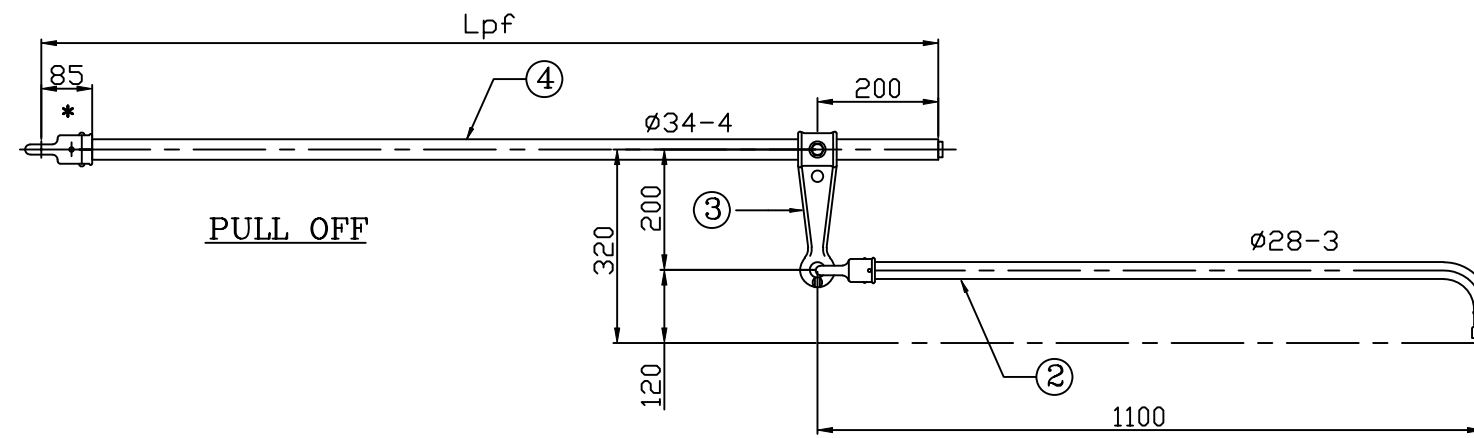

MARK GROUP	QUANTITY	1	4	Ø34-4 TUBE FOR STEADY ARM	ELC 13-15.0B	
		1	3	STAND OFF ASSEMBLY FOR STEADY ARM	ELC 27-4.8.0	
		1	2	1.1m STEADY ARM FOR CROSS-OVER	ELC 32-11.0A	
		1	1	ASSEMBLY CLAMP GROOVED CONTACT WIRE	ELC 32-9.5.5.0B	
MARK GROUP	SEE TABLE	ITEM	DESIGNATION		REFERENCE DRAWING	MARK


PORTFIXATOR Ø 34-4 CU FIXATOR 1.1m PENTRU INCRUCISARE
 Ø 34-4 REGISTRATION ARM WITH 1.1m STEADY ARM FOR
 CROSS-OVER

Numele fisierului/
 CAD file name:
01LC00BDG153

Scara/
 Scale:

Part
 1 / 1

Rev.
 0

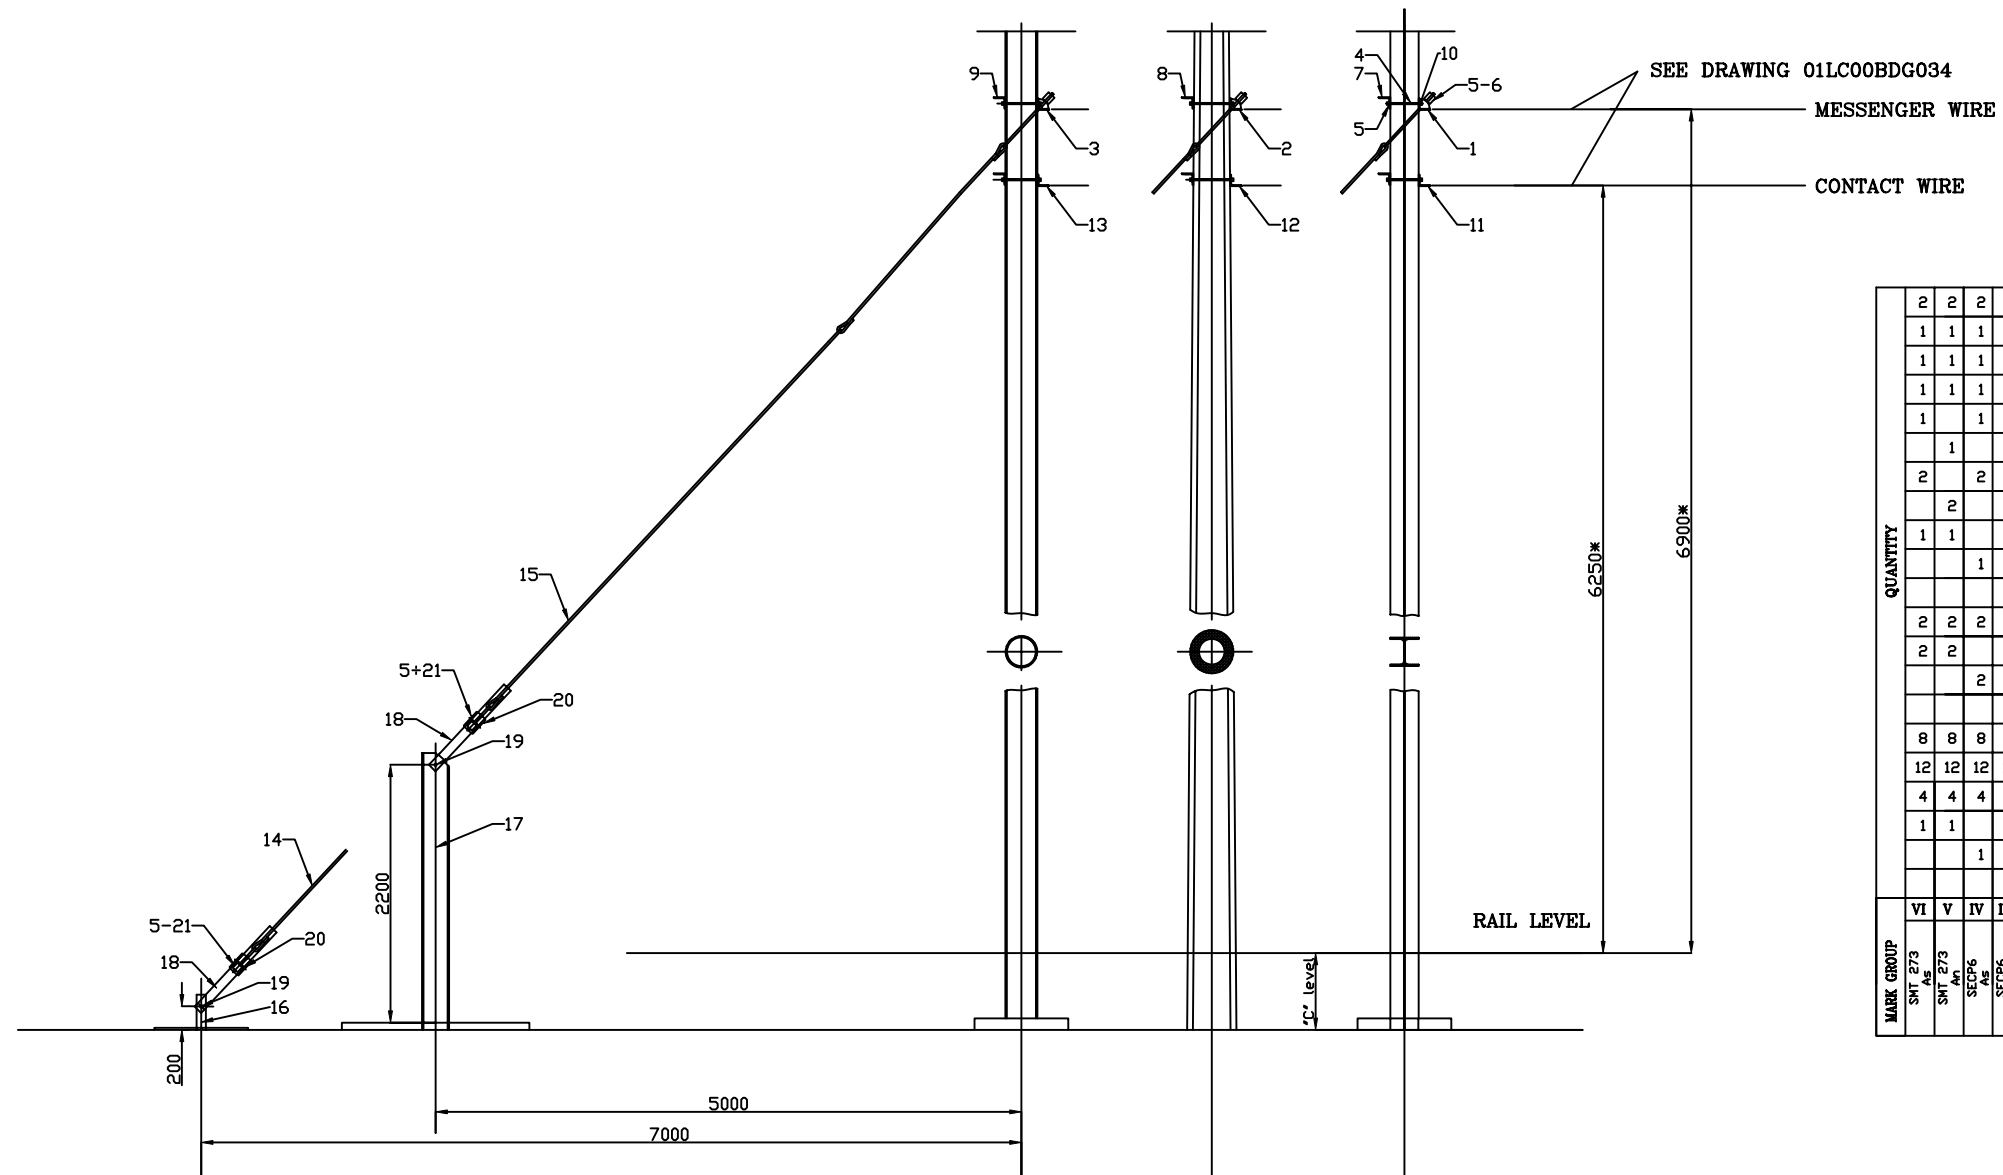


MARK GROUP	VI	V	IV	III	II	I	ITEM	DESIGNATION	UNIT	REFERENCE DRAWING	MARK
SMT 273	2	2	2	2	2	2	21	SPHERIC WASHER		ELC 31-5	
As	1	1	1	1	1	1	20	SUPPORT		01LC00BDG156	
SMT 273	1	1	1	1	1	1	19	SCREW		01LC00BDG144	2743TF
SECP6	1	1	1	1	1	1	18	ADJUSTABLE PLATE		ELC 49-17	
SECP6	1	1	1	1	1	1	17	SUPERELEVATED ANCHOR BEAM		01LC00BDG049	
MUD-5/6.2, HEB	1	1	1	1	1	1	16	LEVEL ANCHOR BEAM		01LC00BDG132	
MUD-5/6.2, HEB	2	2	2	2	2	2	15	ANCHOR TIE ROD		01LC00BDG130	102
As	2	2	2	2	2	2	14	ANCHOR TIE ROD		01LC00BDG130	101
As	1	1	1	1	1	1	13	COUNTERPLATE		ELC 50-15.1A	
As	1	1	1	1	1	1	12	COUNTERPLATE		ELC 50-14.1A	
As	1	1	1	1	1	1	11	COUNTERPLATE		ELC 50-13.1A	
As	2	2	2	2	2	2	10	SPECIAL WASHER		ELC 16-12.3.0	
As	2	2	2	2	2	2	9	COUNTERPLATE		01LC00BDG129	103
As	2	2	2	2	2	2	8	COUNTERPLATE		01LC00BDG129	102
As	2	2	2	2	2	2	7	COUNTERPLATE		01LC00BDG129	101
As	8	8	8	8	8	8	6	NUT M20 GR 8		SR EN ISO 4032-2002	
As	12	12	12	12	12	12	5	WASHER		01LC00BDG142	20A110
As	4	4	4	4	4	4	4	THREADED ROD		01LC00BDG141	2041E2
As	1	1	1	1	1	1	3	ANGLE FOR RIGID ANCHORING		ELC 50-5.1A	
As	1	1	1	1	1	1	2	ANGLE FOR RIGID ANCHORING		ELC 50-3.1A	
As	1	1	1	1	1	1	1	ANGLE FOR RIGID ANCHORING		ELC 50-4.1A	

LEGEND
 An - level anchor
 As - superelevated anchor
 HEB - metalical mast, H type
 SECP6 - concrete mast
 SMT 273 - metalical mast, tubular type

NOTE:
 * -THESE HEIGHTS ARE DEFINED FOR 5.75M CONTACT WIRE HEIGHT
 -FOR DIFFERENT CONTACT WIRE HEIGHT, IT'S NECESSARY TO INCREASE
 OR REDUCE THESE VALUES WITH THE SAME DIFFERENCES

ANCORAREA RIGIDA A CATENAREI CATENARY RIGID ANCHORING	Numele fisierului/ CAD file name:	Scara/ Scale:	Part	Rev.
	01LC00BDG154		1 / 1	0



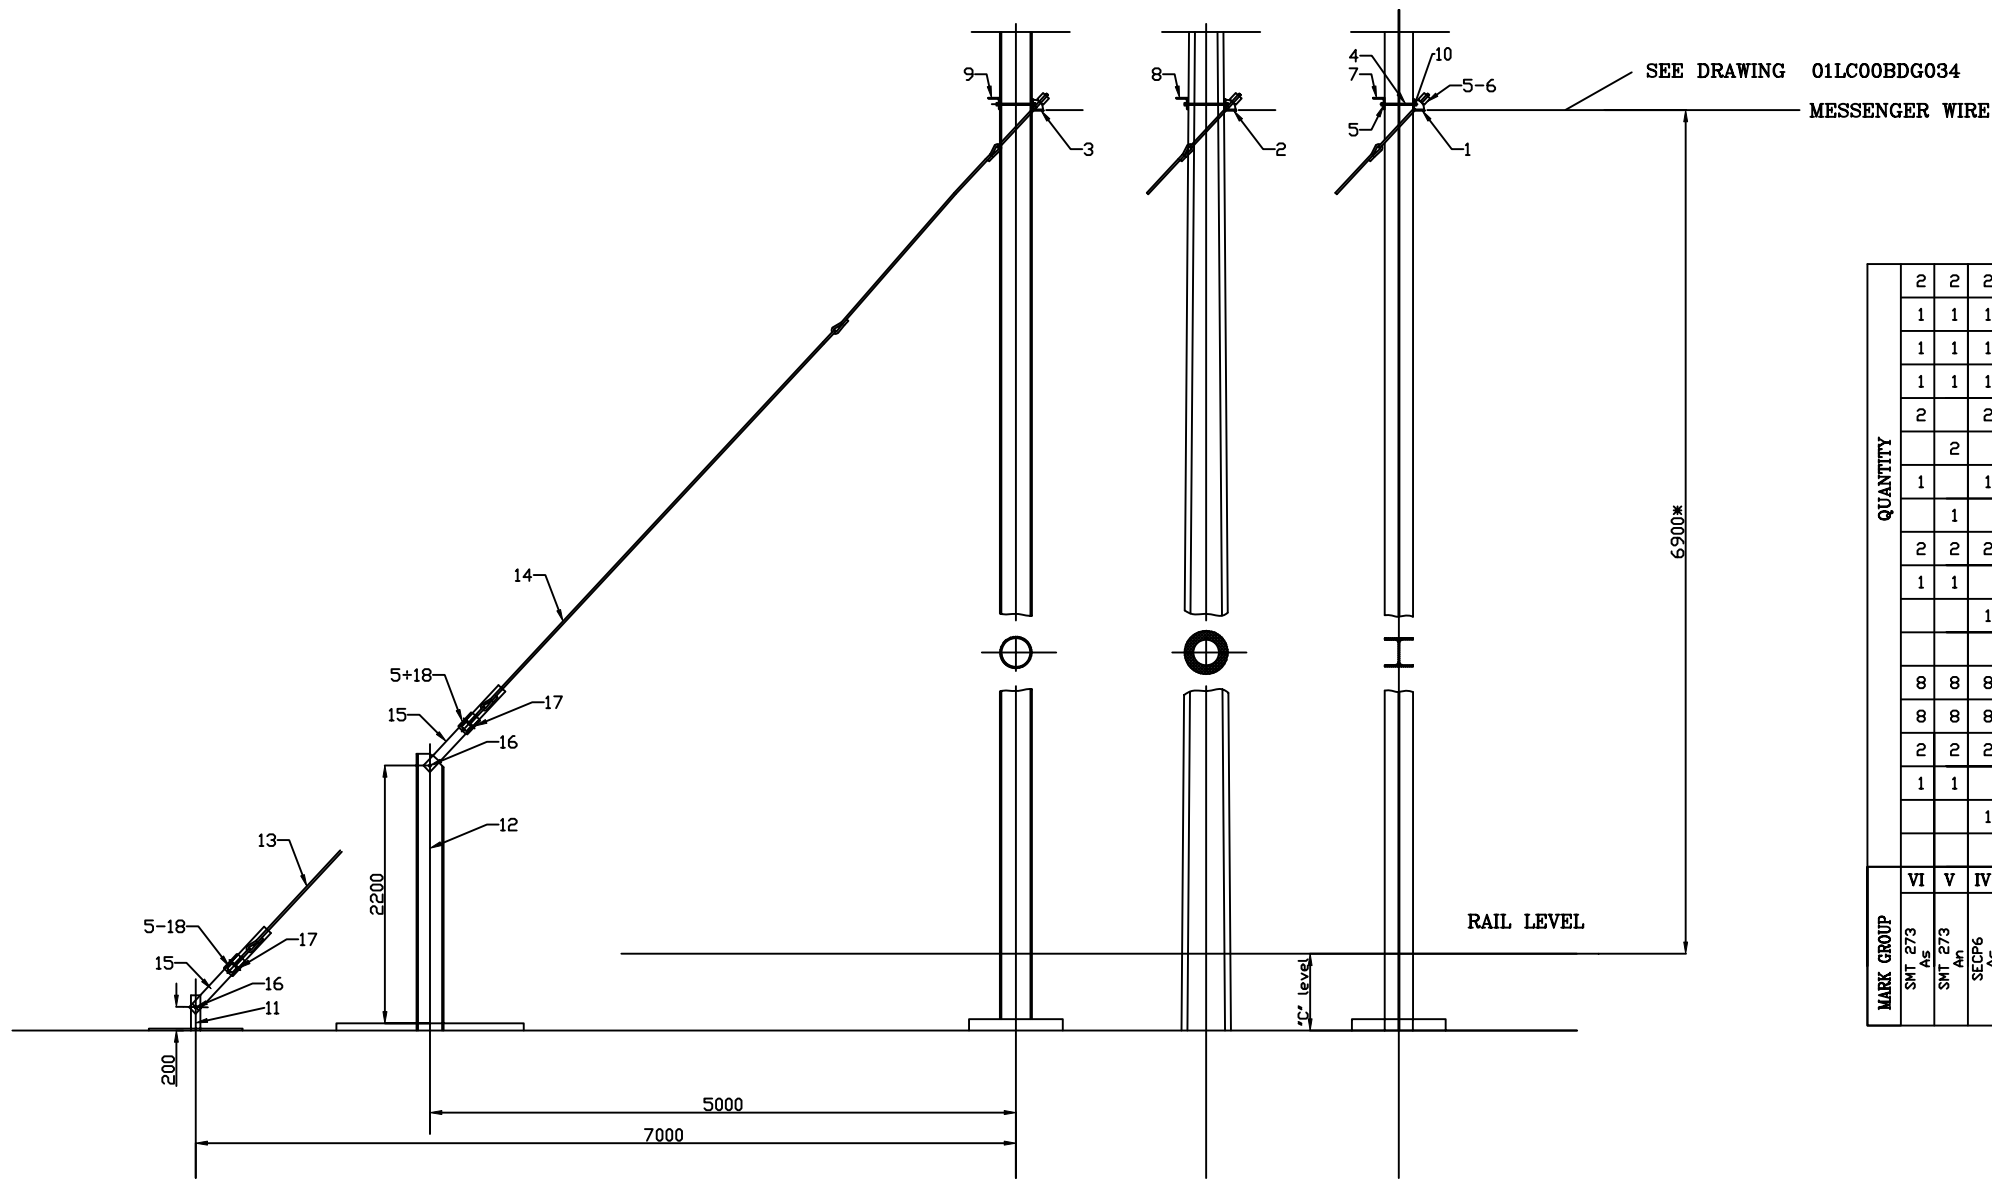


MARK GROUP	VI	V	IV	III	II	I	ITEM	DESIGNATION	UNIT	REFERENCE DRAWING	MARK
SMT 273							18	SPHERIC WASHER		ELC 31-5	
As							17	SUPPORT		01LC00BDG156	
SMT 273							16	SCREW		01LC00BDG144	2743TF
An							15	ADJUSTABLE PLATE		ELC 49-17	
SECP6							14	ANCHOR TIE ROD		01LC00BDG130	102
As							13	ANCHOR TIE ROD		01LC00BDG130	101
An							12	SUPERELEVATED ANCHOR BEAM		01LC00BDG049	
MU10-5/8.2, HEB							11	LEVEL ANCHOR BEAM		01LC00BDG132	
As							10	SPECIAL WASHER		ELC 16-12.3.0	
An							9	COUNTERPLATE		01LC00BDG129	103
							8	COUNTERPLATE		01LC00BDG129	102
							7	COUNTERPLATE		01LC00BDG129	101
							6	NUT M20 GR 8		SR EN ISO 4032-2002	
							5	WASHER		01LC00BDG142	20A110
							4	THREADED ROD		01LC00BDG141	2041E2
							3	ANGLE FOR RIGID ANCHORING		ELC 50-5.1A	
							2	ANGLE FOR RIGID ANCHORING		ELC 50-3.1A	
							1	ANGLE FOR RIGID ANCHORING		ELC 50-4.1A	

LEGEND
 An - level anchor
 As - superelevated anchor
 HEB - metalical mast, H type
 SECP6 - concrete mast
 SMT 273 - metalical mast, tubular type

NOTE:
 * -THESE HEIGHTS ARE DEFINED FOR 5.75M CONTACT WIRE HEIGHT
 -FOR DIFFERENT CONTACT WIRE HEIGHT, IT'S NECESSARY TO INCREASE
 OR REDUCE THESE VALUES WITH THE SAME DIFFERENCES

ANCORARE MEDIANA MID POINT ANCHORING	Numele fisierului/ CAD file name:	Scara/ Scale:	Part	Rev.
	01LC00BDG155		1 / 1	0

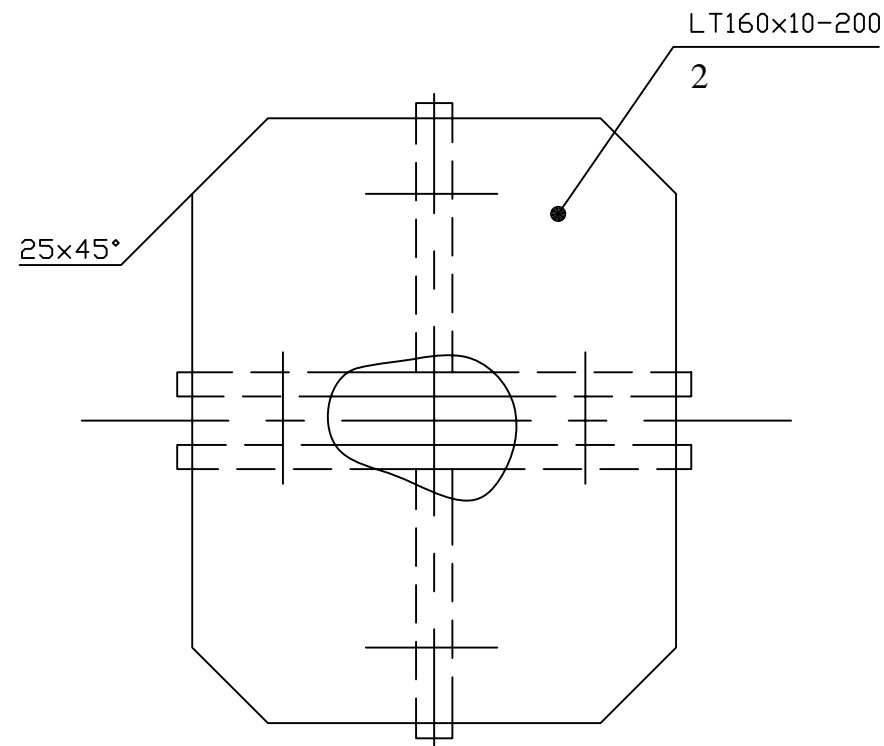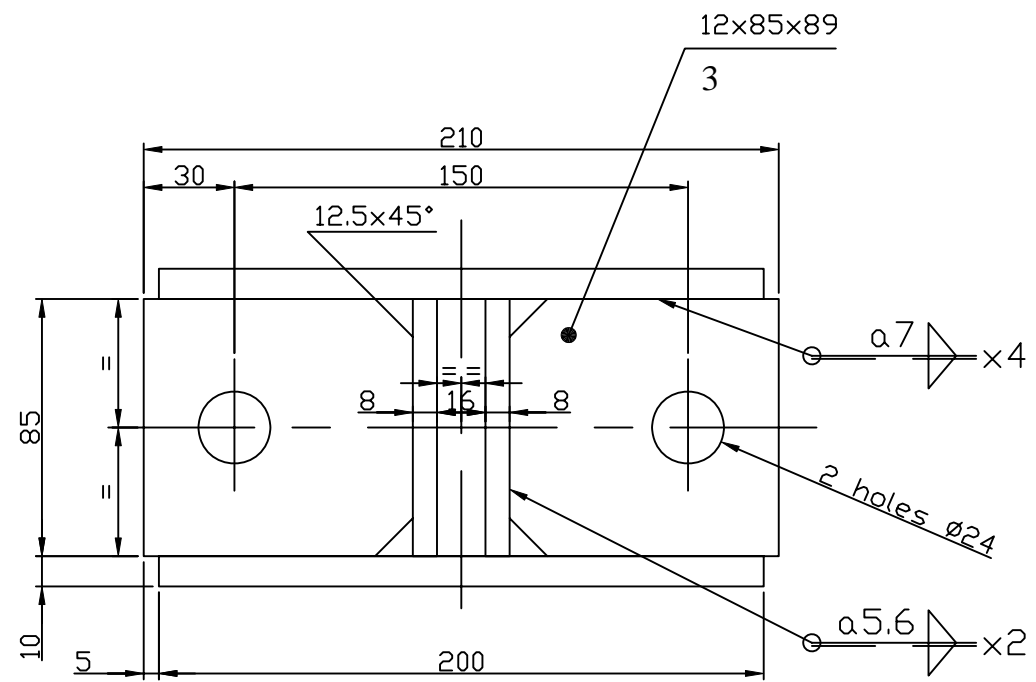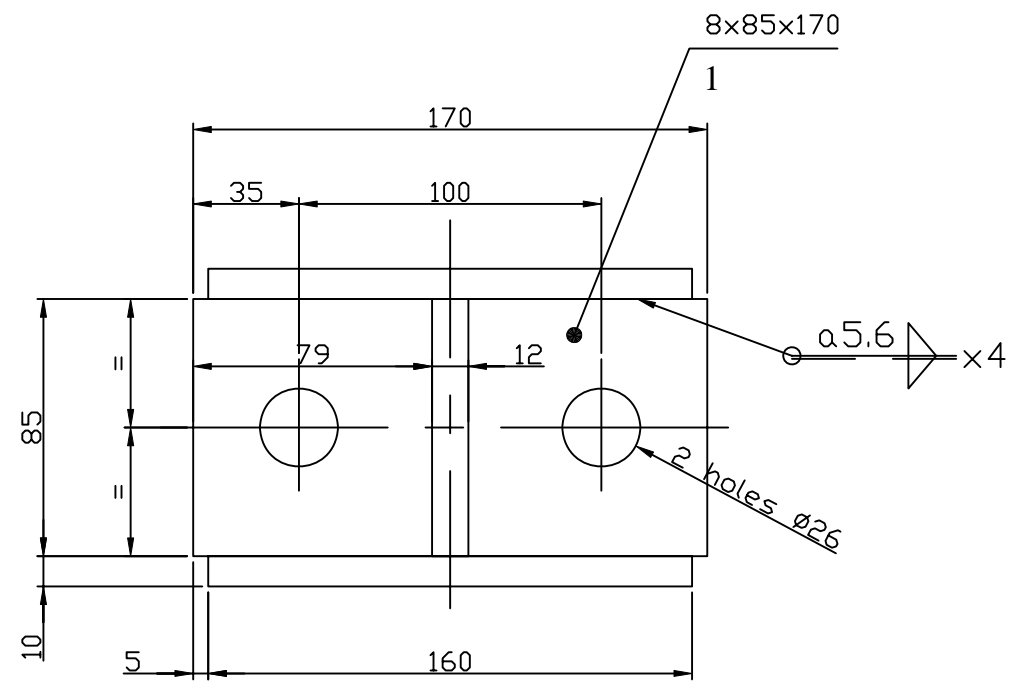


QUANTITY	2	3	PLATE II		S235JR
	2	2	PATE I		S235JR
	2	1	LONGERON		S235JR
MARK GROUP		ITEM	DESIGNATION	UNIT MASS	MATERIAL TECHNICAL SPECIFICATION
				kg	

NOTE:

- 1.The holes will be made after welding.
- 2.After welding and drilling will be hot galvanized AT/OL/Zn600-STAS 7221-90.


SUPPORT SUPPORT	Numele fisierului/ CAD file name:	Scara/ Scale:	Part	Rev.
	01LC00BDG156		1 / 1	0

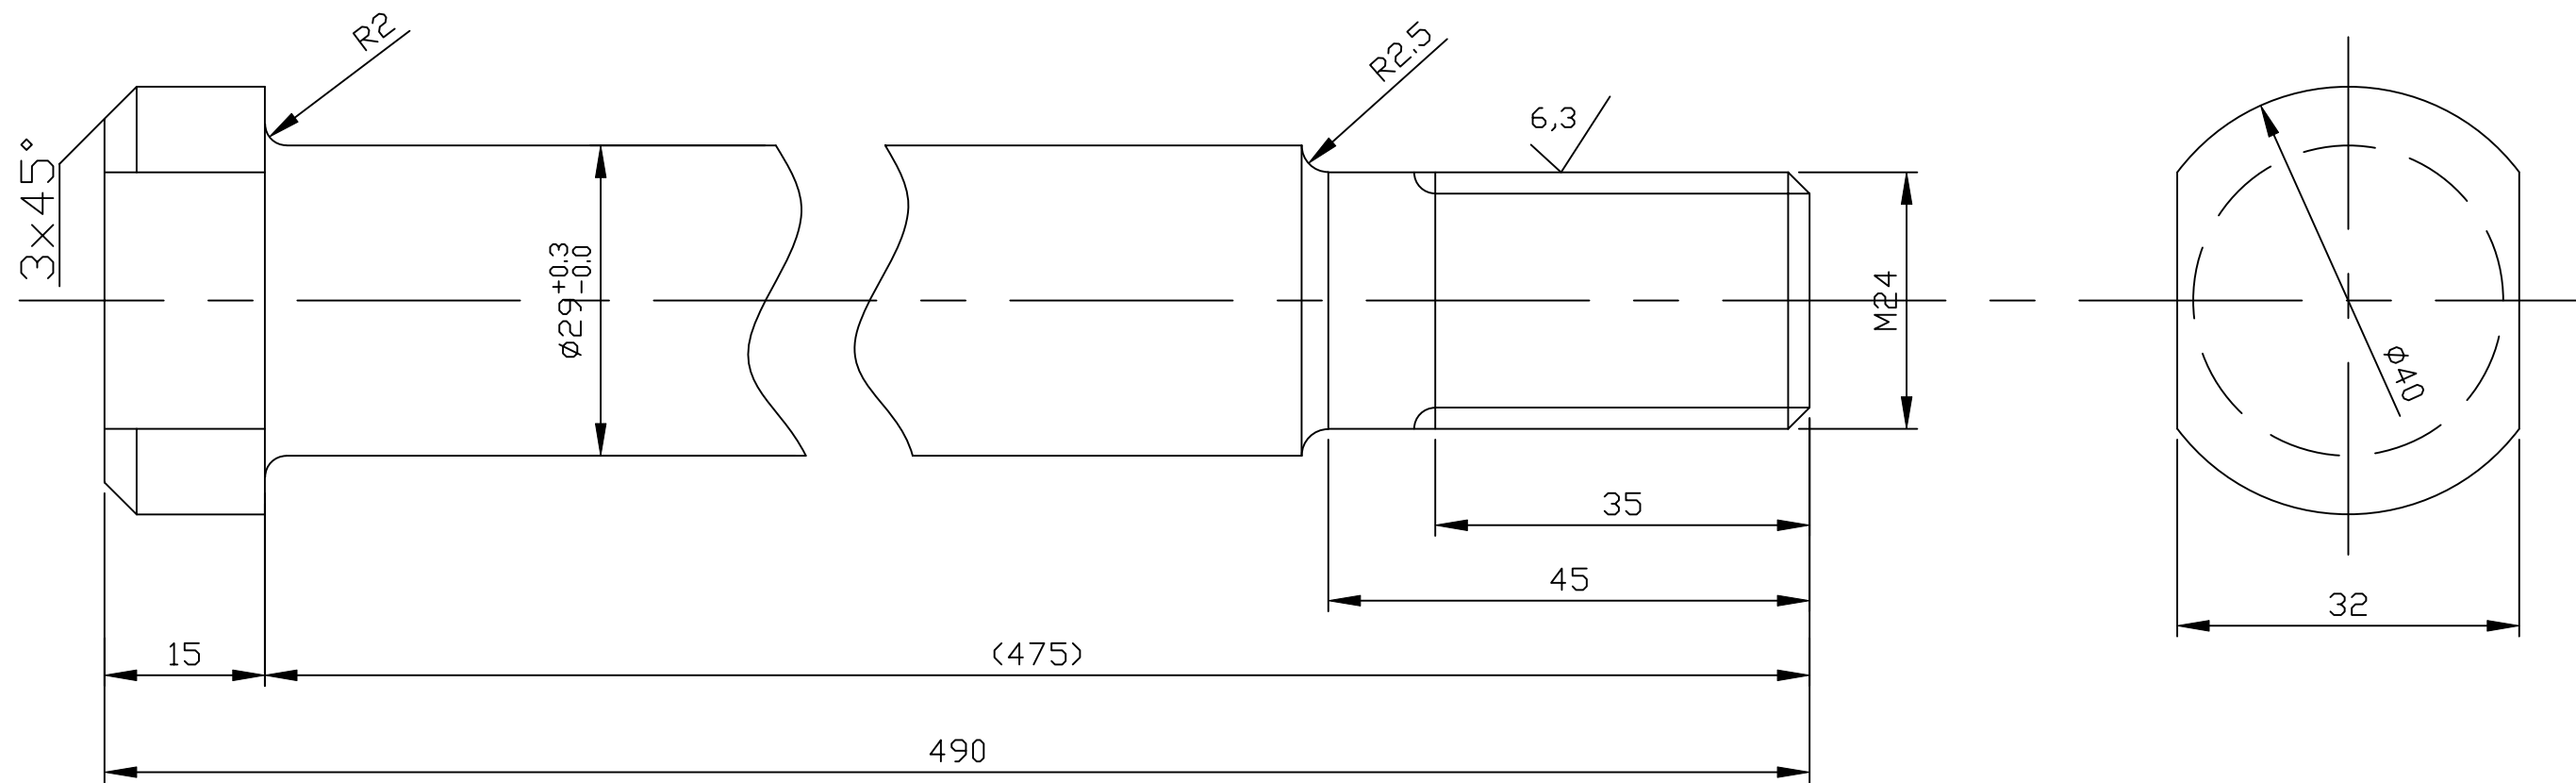

NOTE
MATERIAL: S355JO


AX SUPORT
COGWHEEL SUPORT AXIS

Numele fisierului/ CAD file name:	Scara/ Scale:	Part	Rev.
01LC00BDG157		1 / 1	0

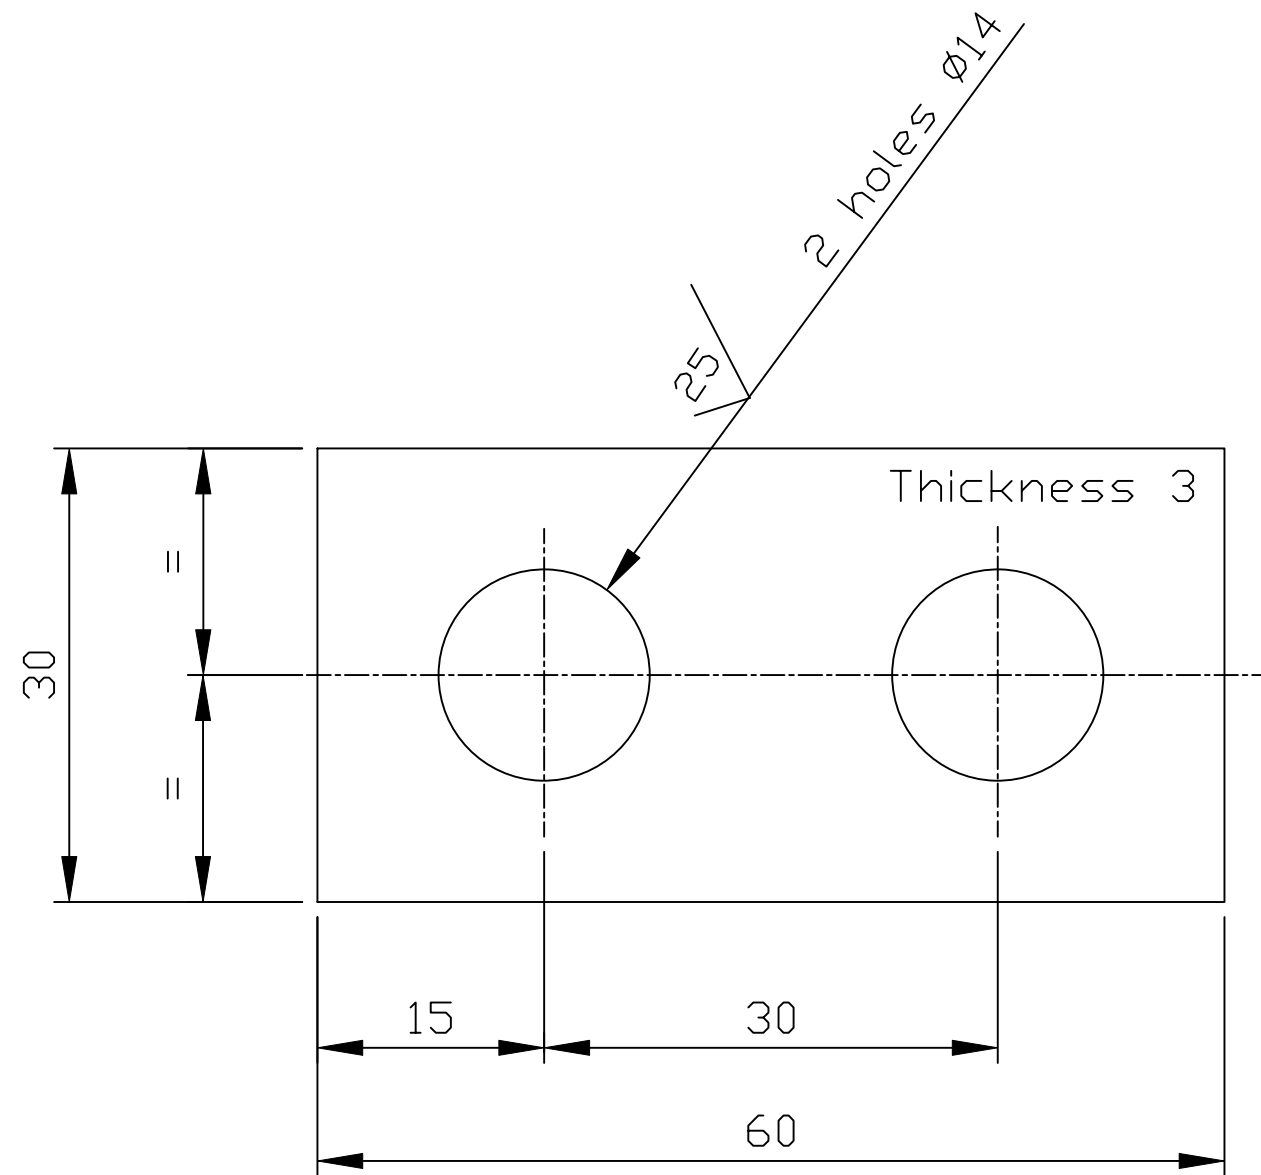

NOTE
 MATERIAL: S235JR



PLACA PLATE	Numele fisierului/ CAD file name:	Scara/ Scale:	Part	Rev.
	01LC00BDG158		1 / 1	0

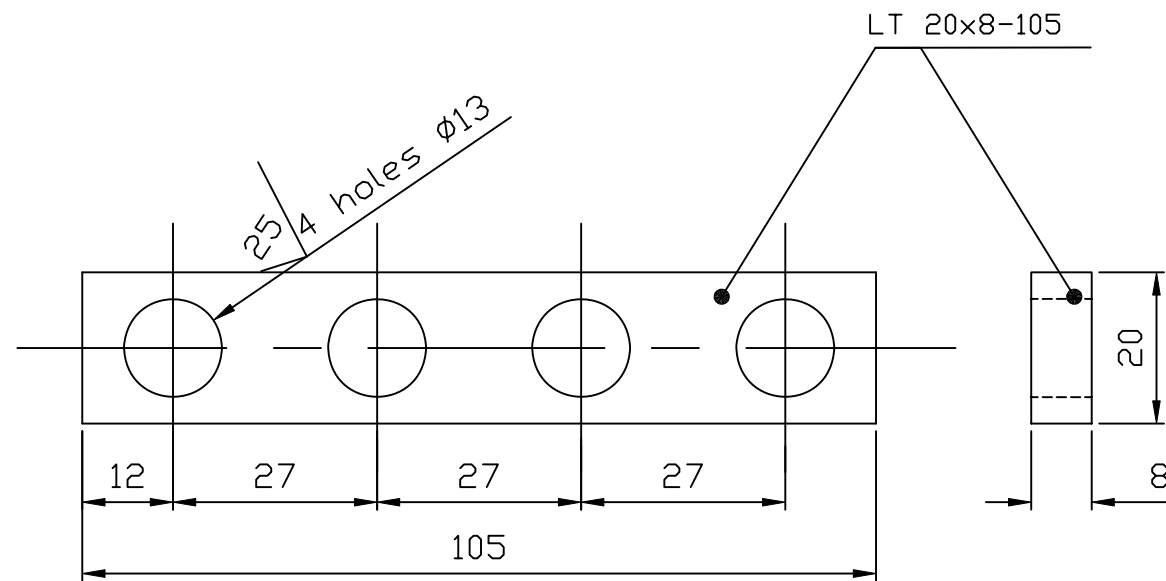

NOTE:




Will be hot galvanized AT/OL/Zn500-STAS 7221-90.
 MATERIAL: S235JR

PLACA PLATE	Numele fisierului/ CAD file name:	Scara/ Scale:	Part	Rev.
	01LC00BDG159		1 / 1	0

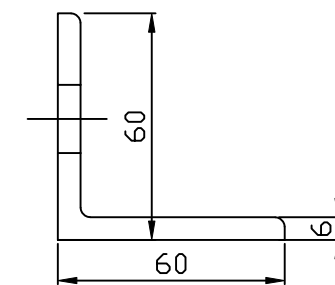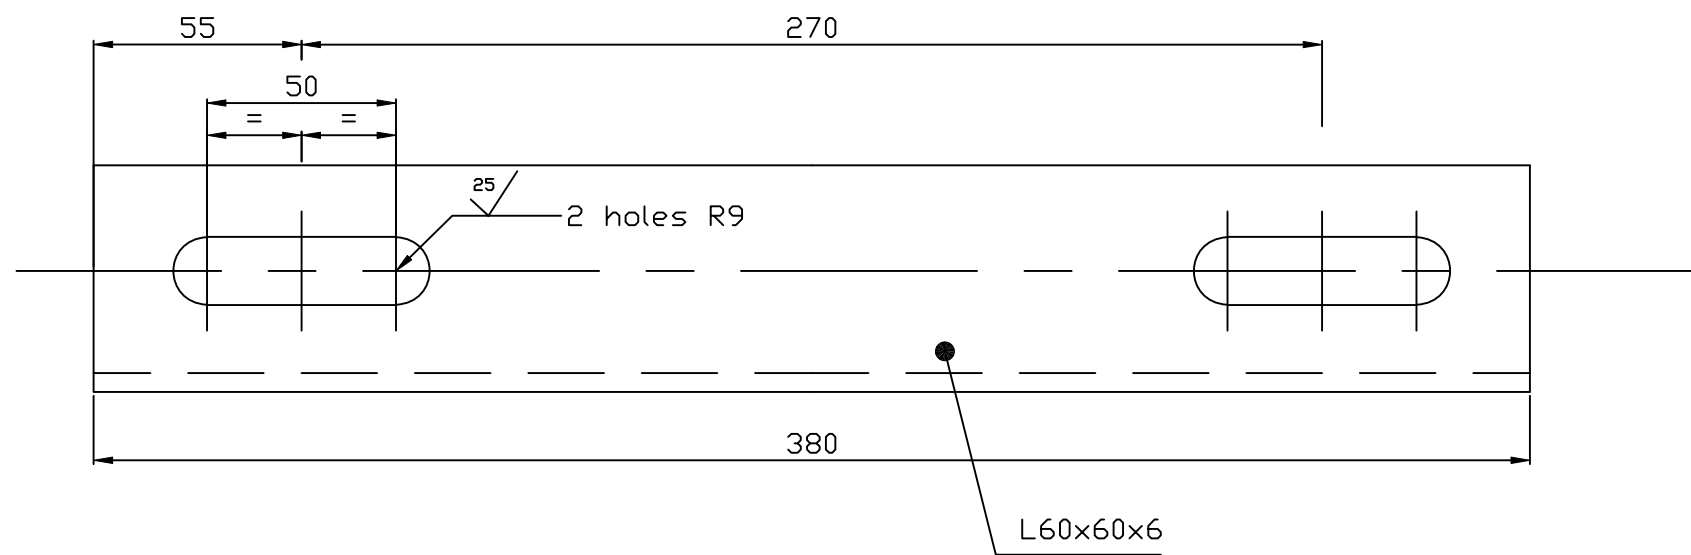

NOTE:
 Will be hot galvanized AT/OL/Zn500-STAS 7221-90.
 Material: S235JR

PROFIL II FRAME II	Numele fisierului/ CAD file name:	Scara/ Scale:	Part	Rev.
	01LC00BDG165		1 / 1	0

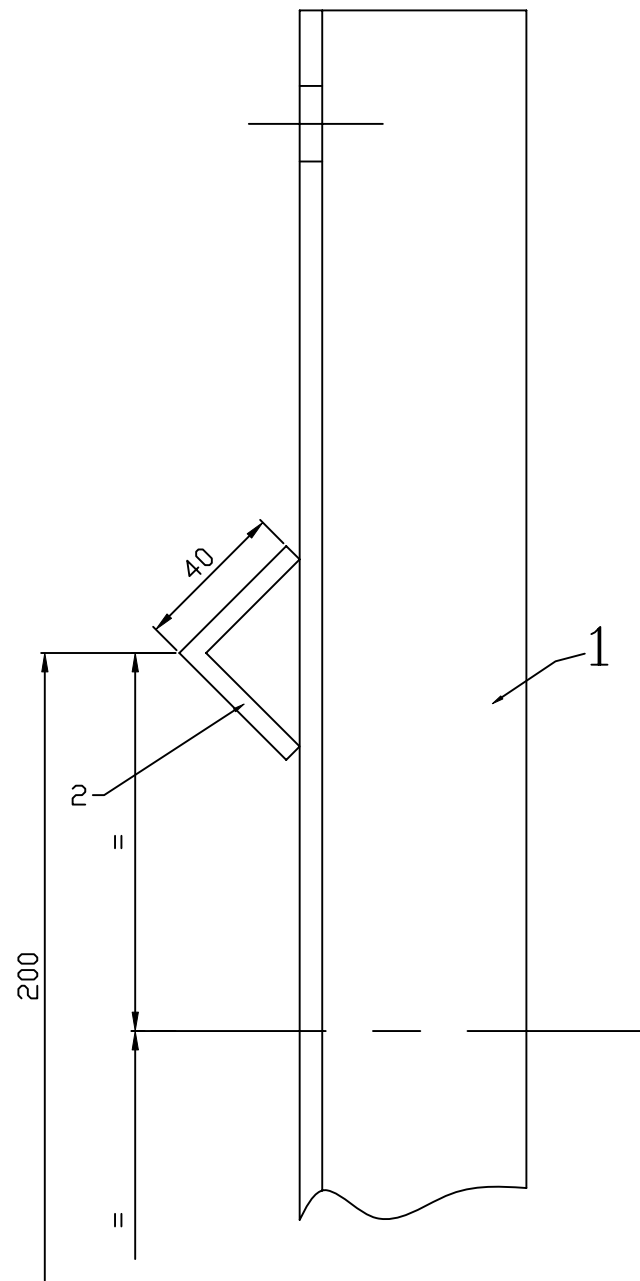
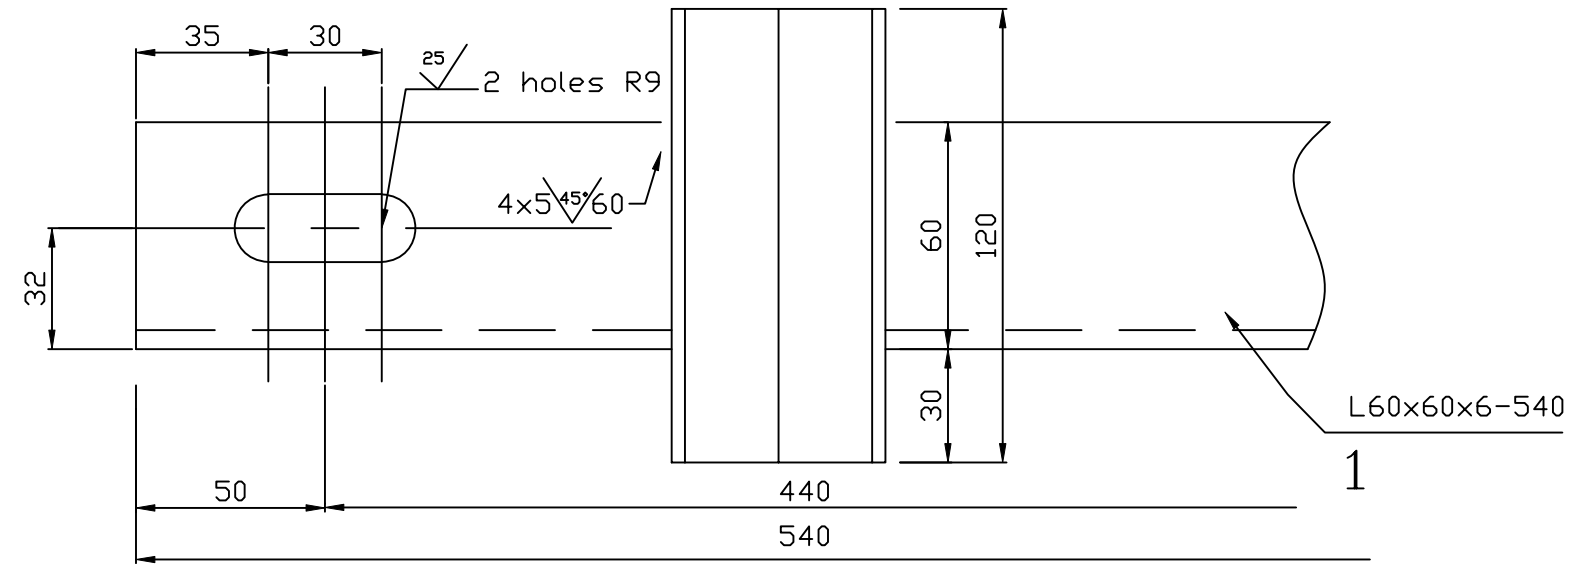
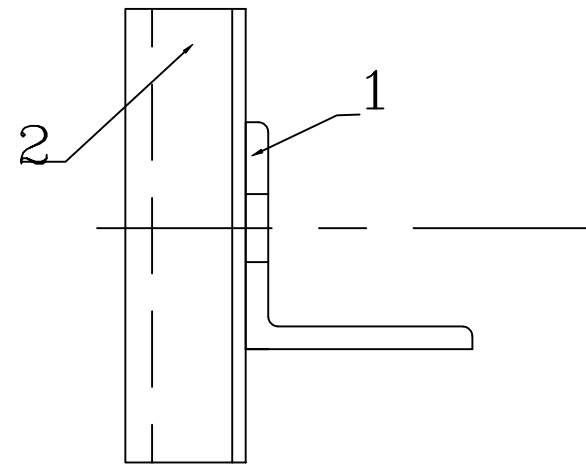


NOTE:

After welding and drilling will be hot galvanized AT/OL/Zn500-STAS 7221-90.

2	PROFILE	2	S235JR
1	FRAME	1	S235JR
ITEM	DESIGNATION	UNIT	MATERIAL TECHNICAL SPECIFICATION

PROFIL II FRAME II	Numele fisierului/ CAD file name:	Scara/ Scale:	Part	Rev.
	01LC00BDG168		1 / 1	0

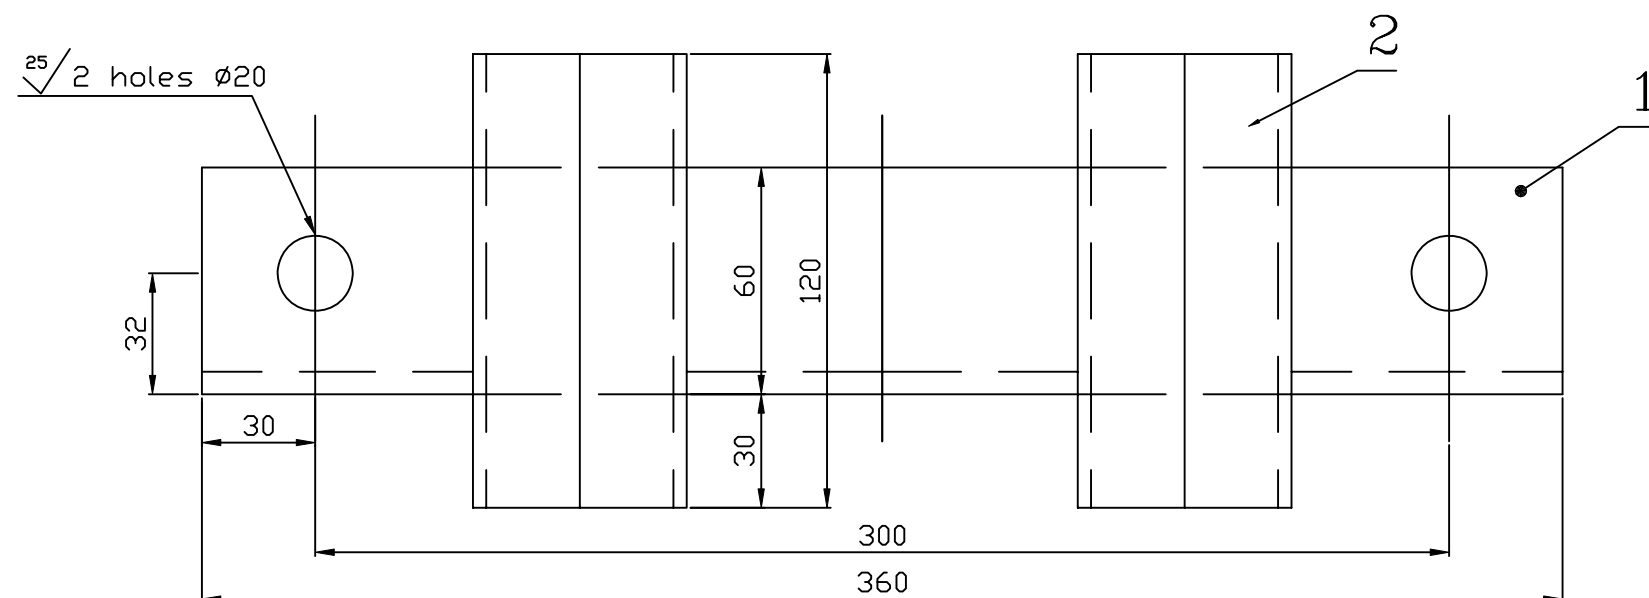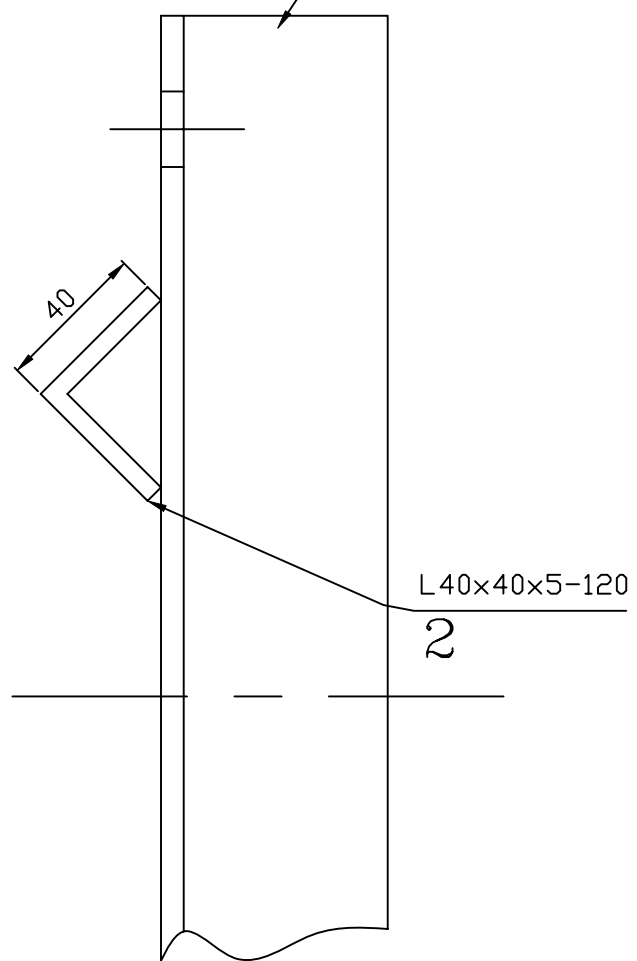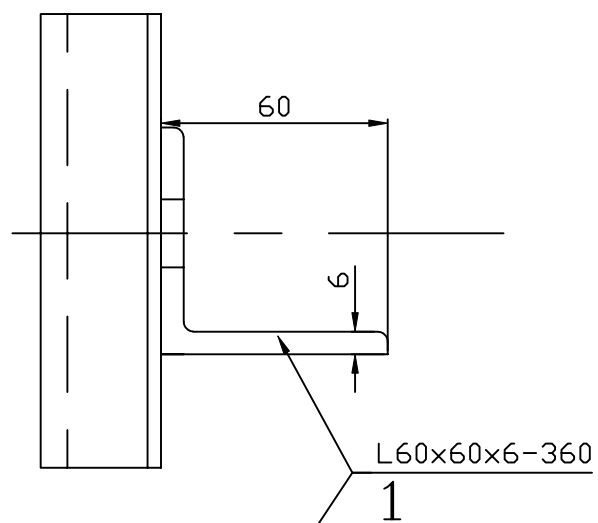

NOTE:

After welding and drilling will be hot galvanized AT/OL/Zn500-STAS 7221-90.

2	PROFILE	2	S235JR
1	FRAME	1	S235JR
ITEM	DESIGNATION	UNIT	MATERIAL TECHNICAL SPECIFICATION

PROFIL II
FRAME II

Numele fisierului/
CAD file name:
01LC00BDG171



Scara/
Scale:

Part

Rev.



1 / 1

0

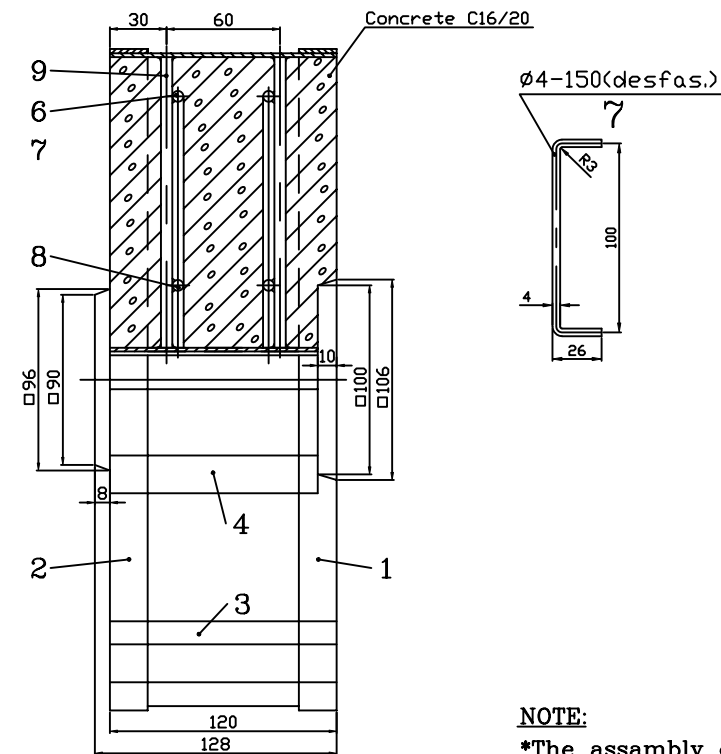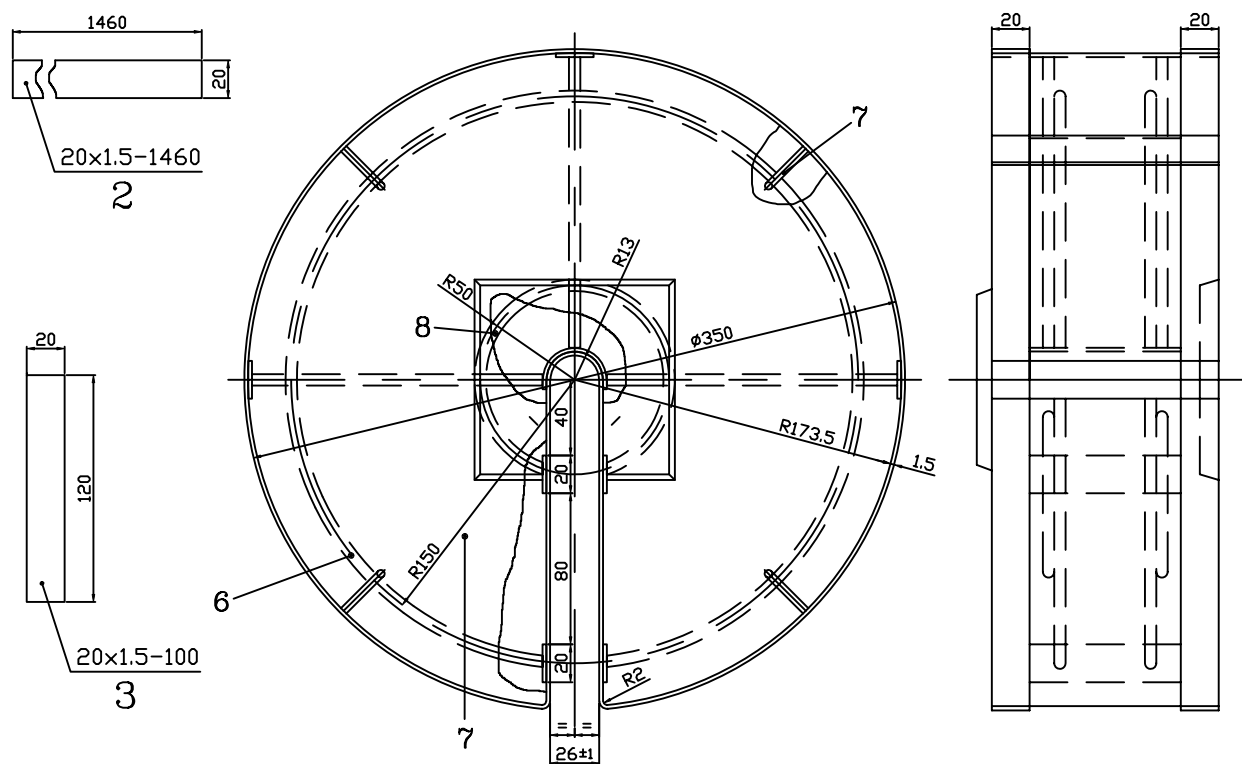

NOTE:


- *The assembly of the elements will be made by welding in points.
- *The frames items 1 and 2, the spacers items 3 and 4 and the sleeve item 5 will be apply a rime paint twice before concrete pouring.
- *The concrete mark will be minimum C16/20 in accordance with the code NE012-99.

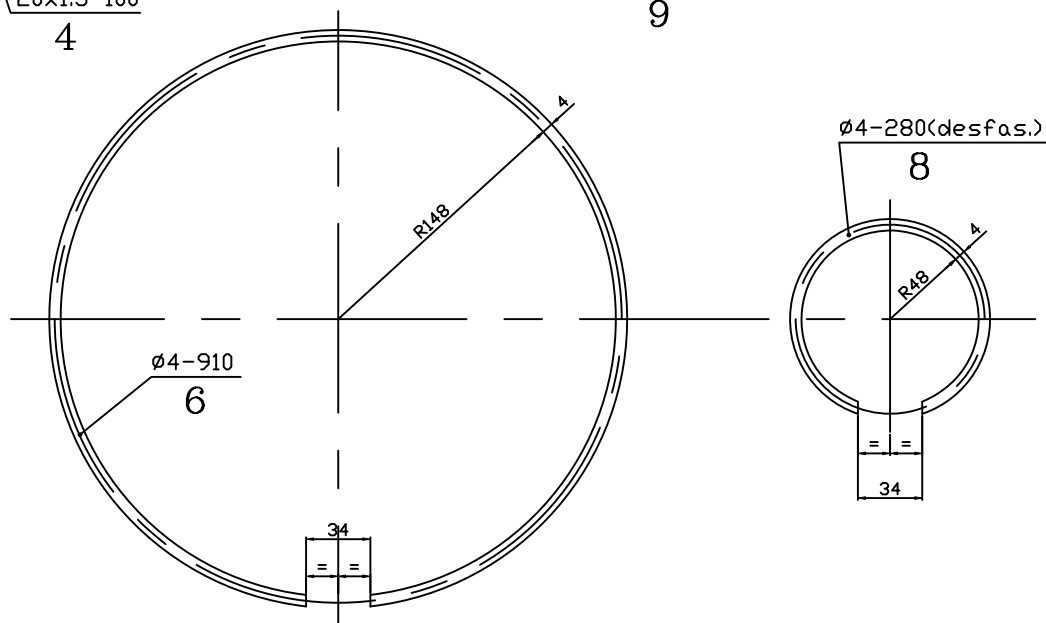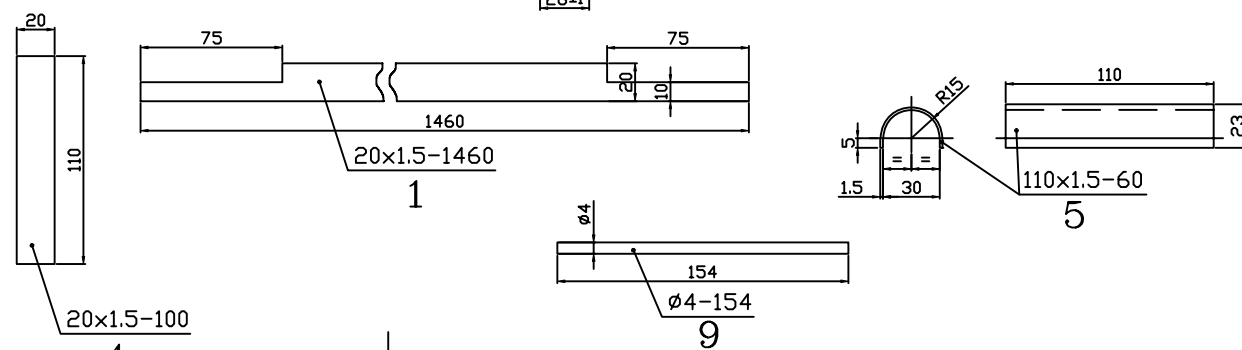

MARK GROUP	ITEM	DESIGNATION	UNIT MASS kg	MATERIAL TECHNICAL SPECIFICATION
6	9	CLAMP I		S235JR
2	8	COILE II		S235JR
4	7	CLAMP II		S235JR
2	6	COILE I		S235JR
1	5	SLEEVE		S235JR
2	4	SPACER II		S235JR
5	3	SPACER I		S235JR
1	2	FRAME II		S235JR
1	1	FRAME I		S235JR

CONTRAGREUTATE DIN BETON
CONCRETE COUNTERWEIGHT

Numele fisierului/ CAD file name:	Scara/ Scale:	Part	Rev.
01LC00BDG172		1 / 1	0

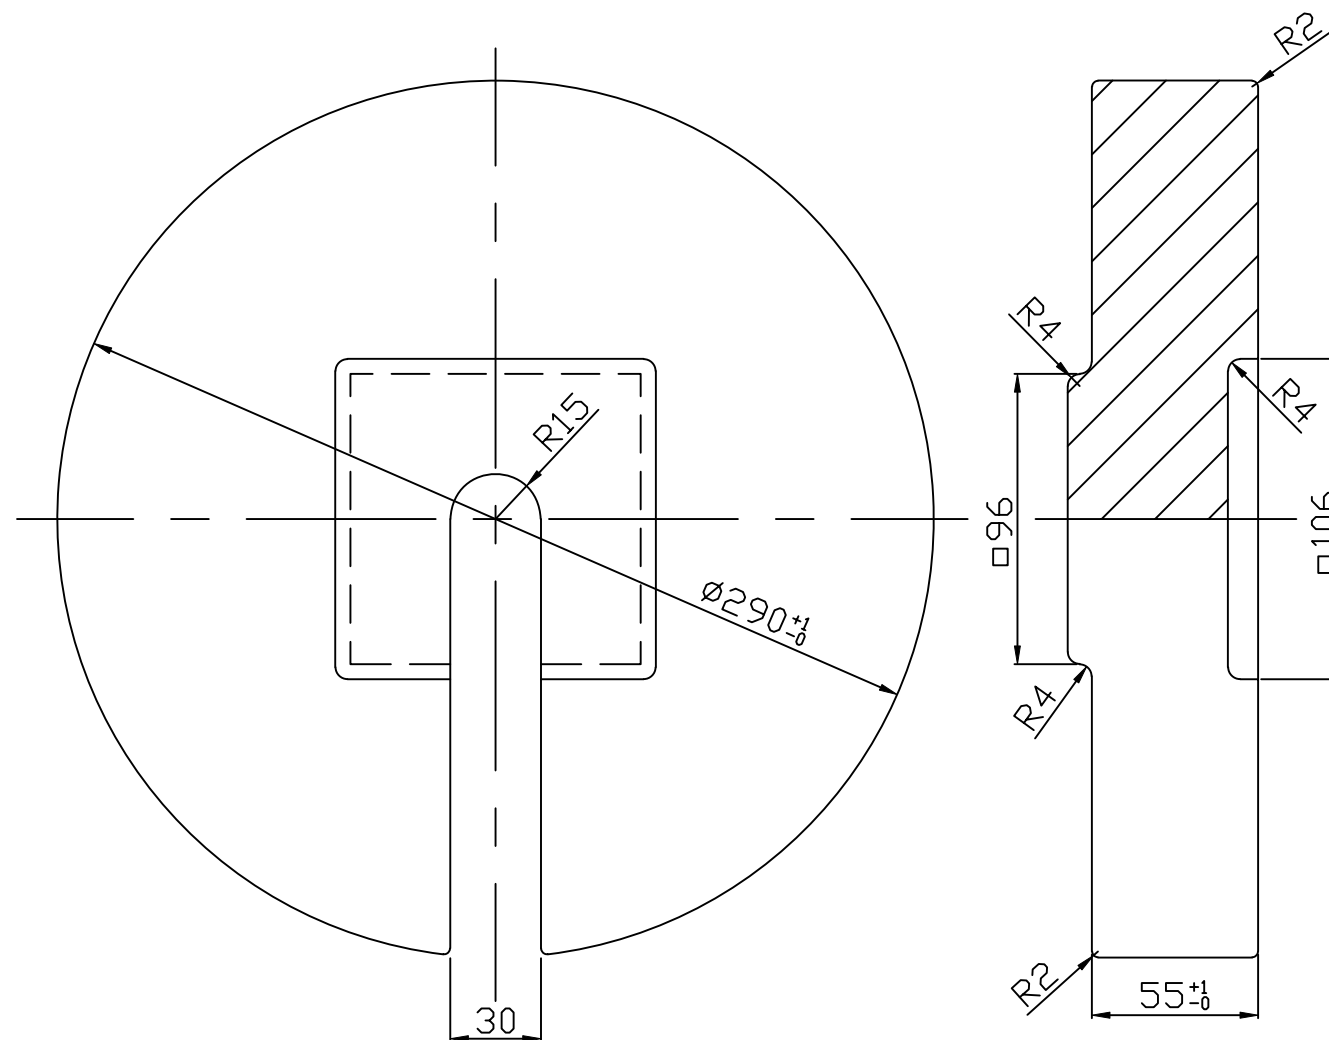


NOTE:

- 1.The minimal admissible weight is 25kg.
- 2.The piece will be clean, apply a prime paint and painted in two coats.
- 3.Material: EN-GJL-HB-155 SR EN 1562-1999

CONTRAGREUTATE DIN FONTA
CAST IRON COUNTERWEIGHT


Numele fisierului/ CAD file name:	Scara/ Scale:	Part	Rev.
01LC00BDG173		1 / 1	0

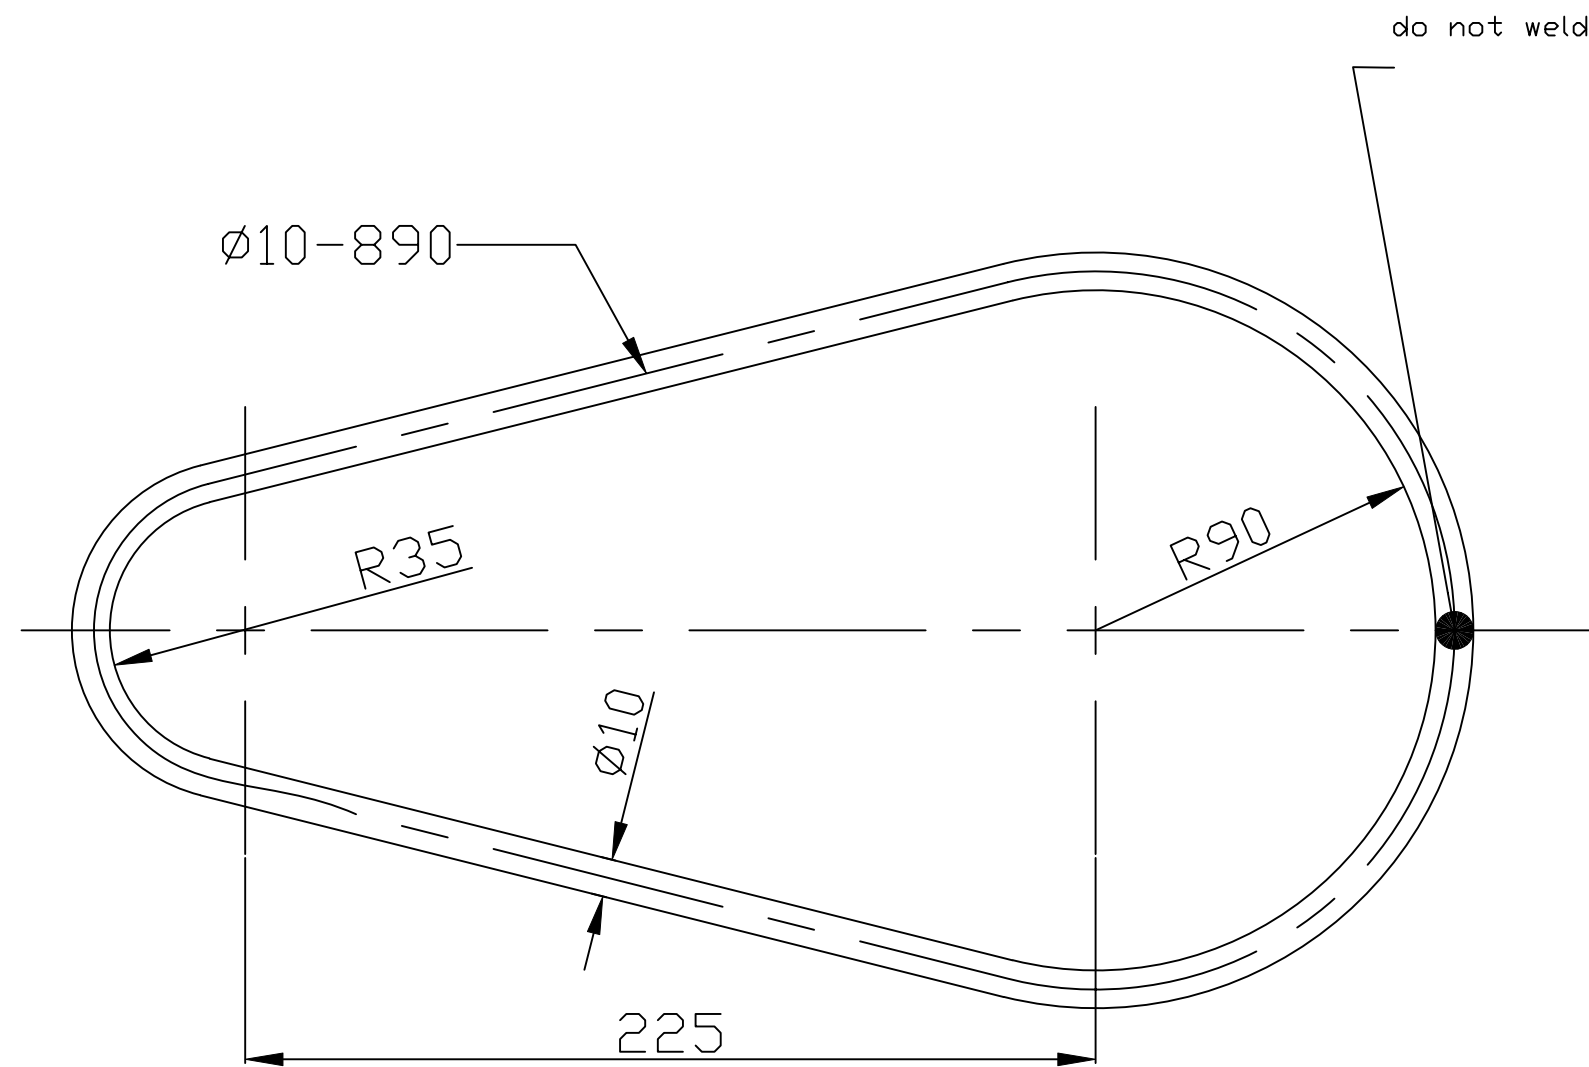

NOTE:

1. Will be hot galvanized AT/OL/Zn600-STAS 7221-90.
2. The eye will be used with the rod for iron cast counterweights 0173A1.
3. Material: S235JR


OCHI TIP I EYE I	Numele fisierului/ CAD file name:	Scara/ Scale:	Part	Rev.
	01LC00BDG174		1 / 1	0

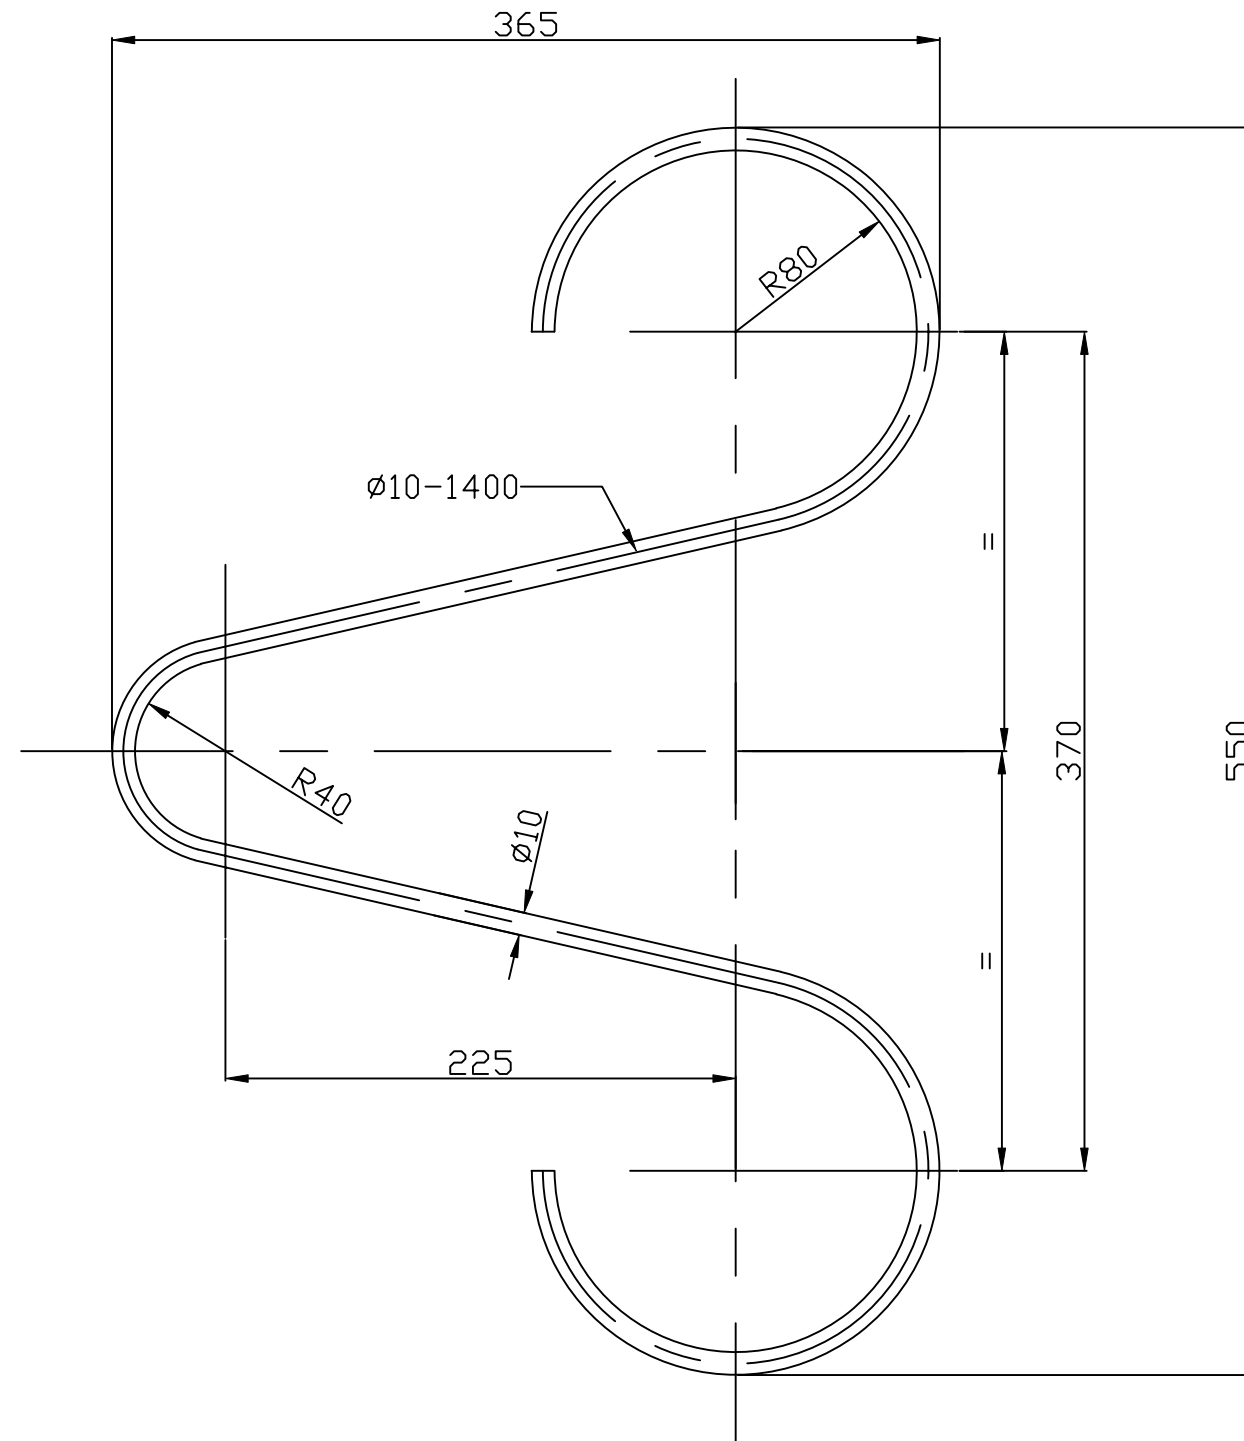

NOTE:

1. Will be hot galvanized AT/OL/Zn600-STAS 7221-90.
2. The eye will be used with the frame for concrete counterweights 0172A1.
3. Material: S235JR

OCHI TIP II EYE II	Numele fisierului/ CAD file name:	Scara/ Scale:	Part	Rev.
	01LC00BDG175		1 / 1	0


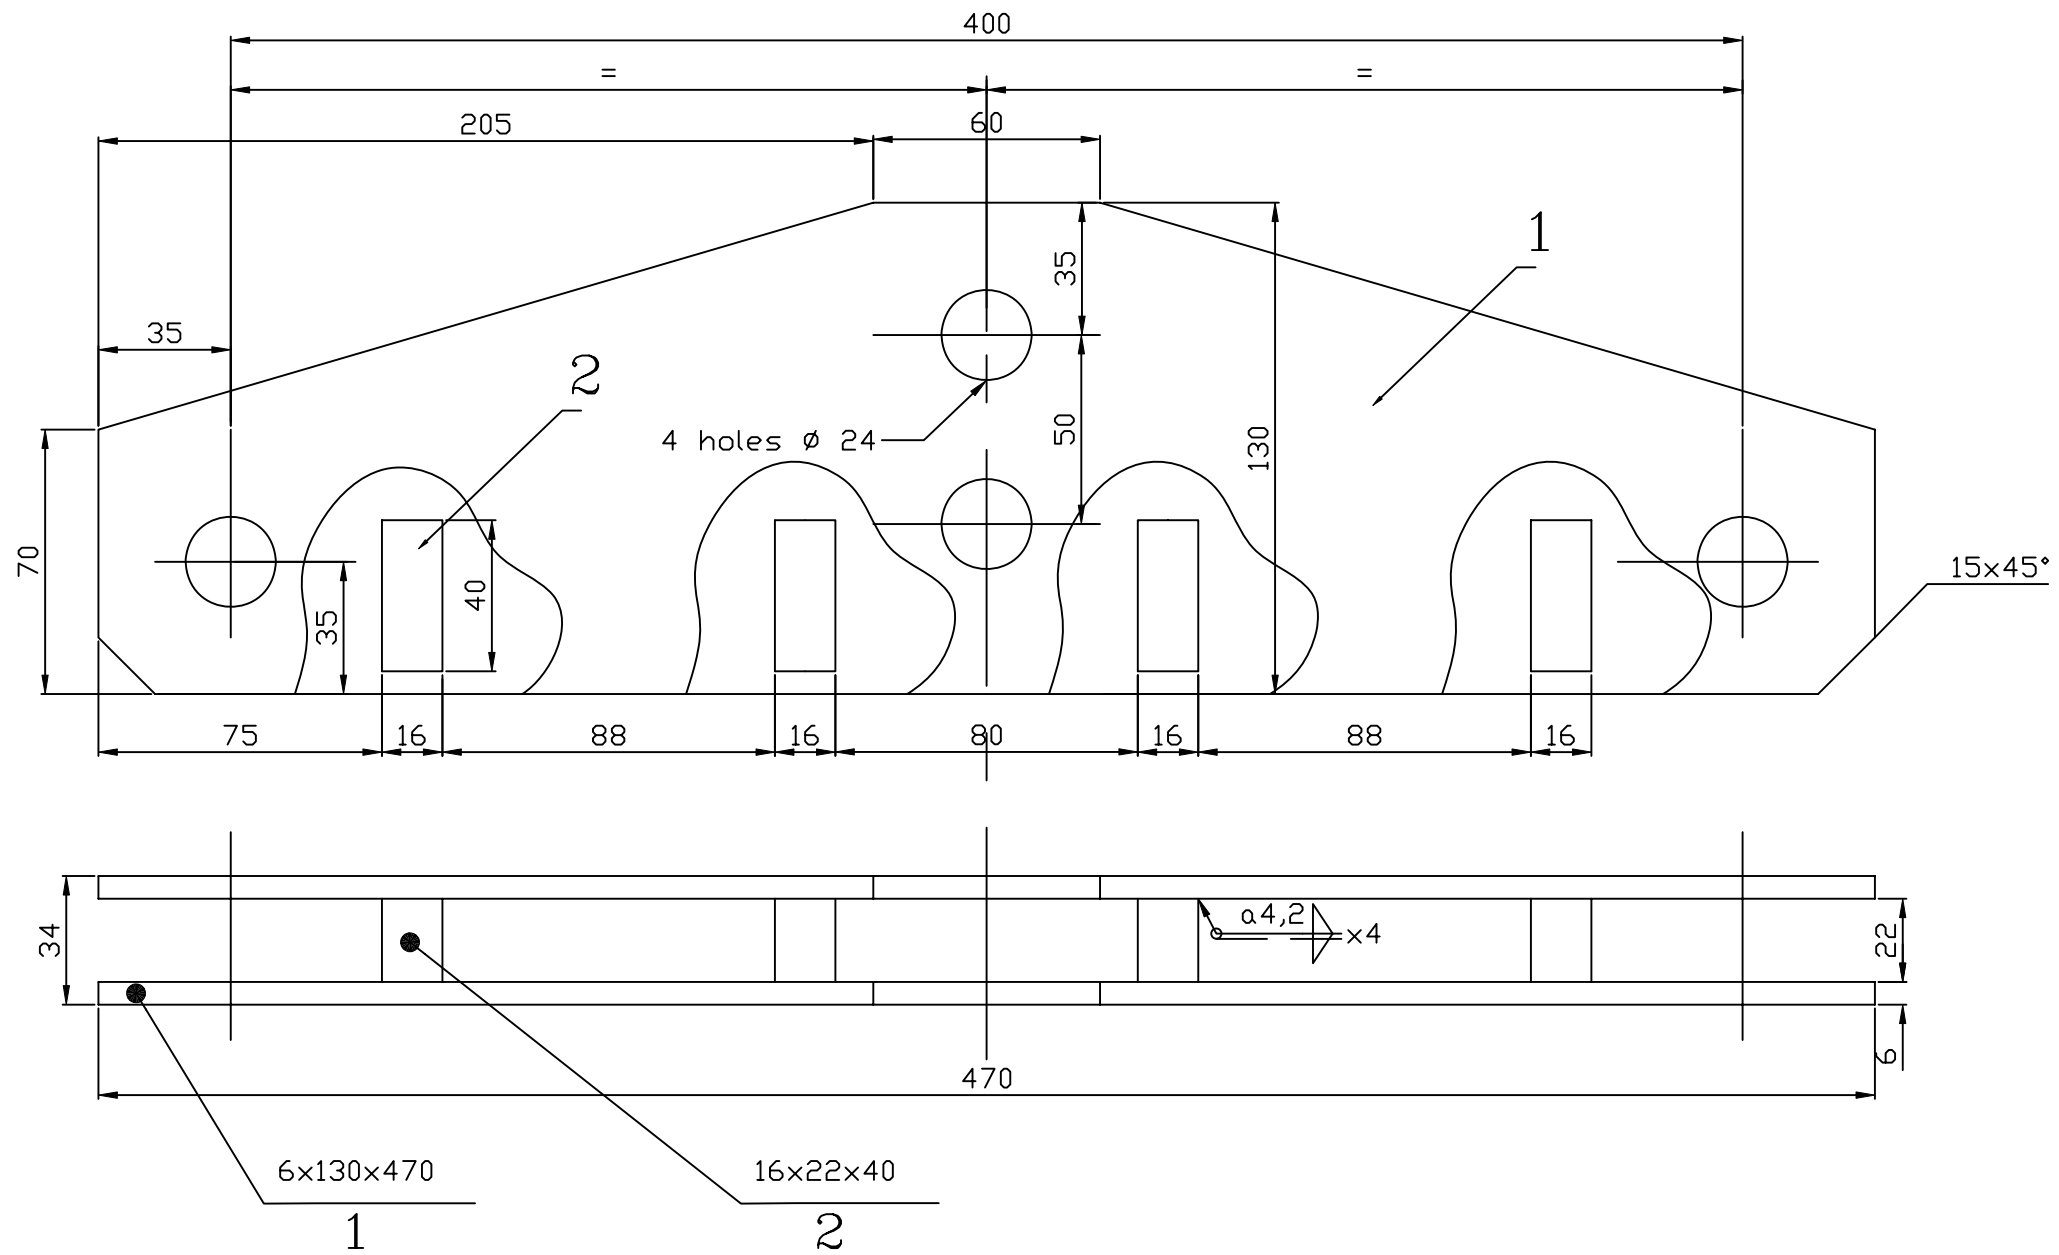


NOTE:
After welding and drilling will be hot galvanized AT/OL/Zn600-STAS 7221-90.

2	SPACER	3	S235JR
1	PLATE	1	S235JR
ITEM	DESIGNATION	UNIT	MATERIAL TECHNICAL SPECIFICATION

DISPOZITIV CU 3 PRINDERI
3 PIN CLEVIS


Numele fisierului/ CAD file name:	Scara/ Scale:	Part	Rev.
01LC00BDG179		1 / 1	0

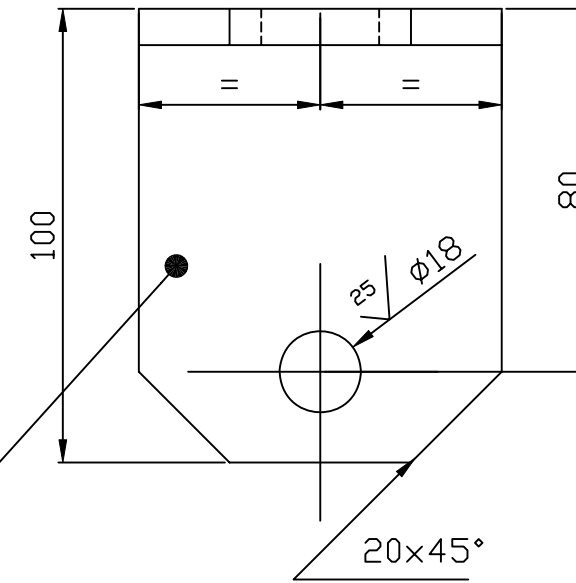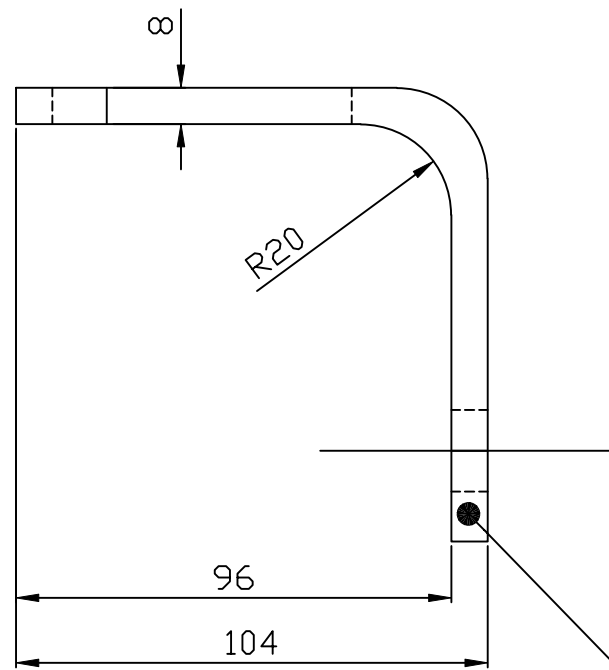

LT 80x8-190

NOTA:

1. Will be hot galvanized AT/OL/Zn600-STAS 7221-90.
2. Material: S275JR

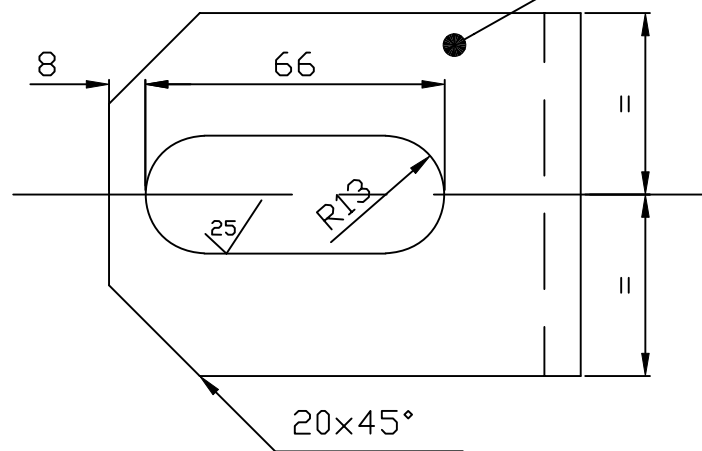


CLEMA DE PRINDERE IN COLT
CORNER CRAMP

Numele fisierului/ CAD file name:	Scara/ Scale:	Part	Rev.
01LC00BDG180		1 / 1	0


SEE DRAWING 01LC00BDG034

MESSENGER WIRE

CONTACT WIRE


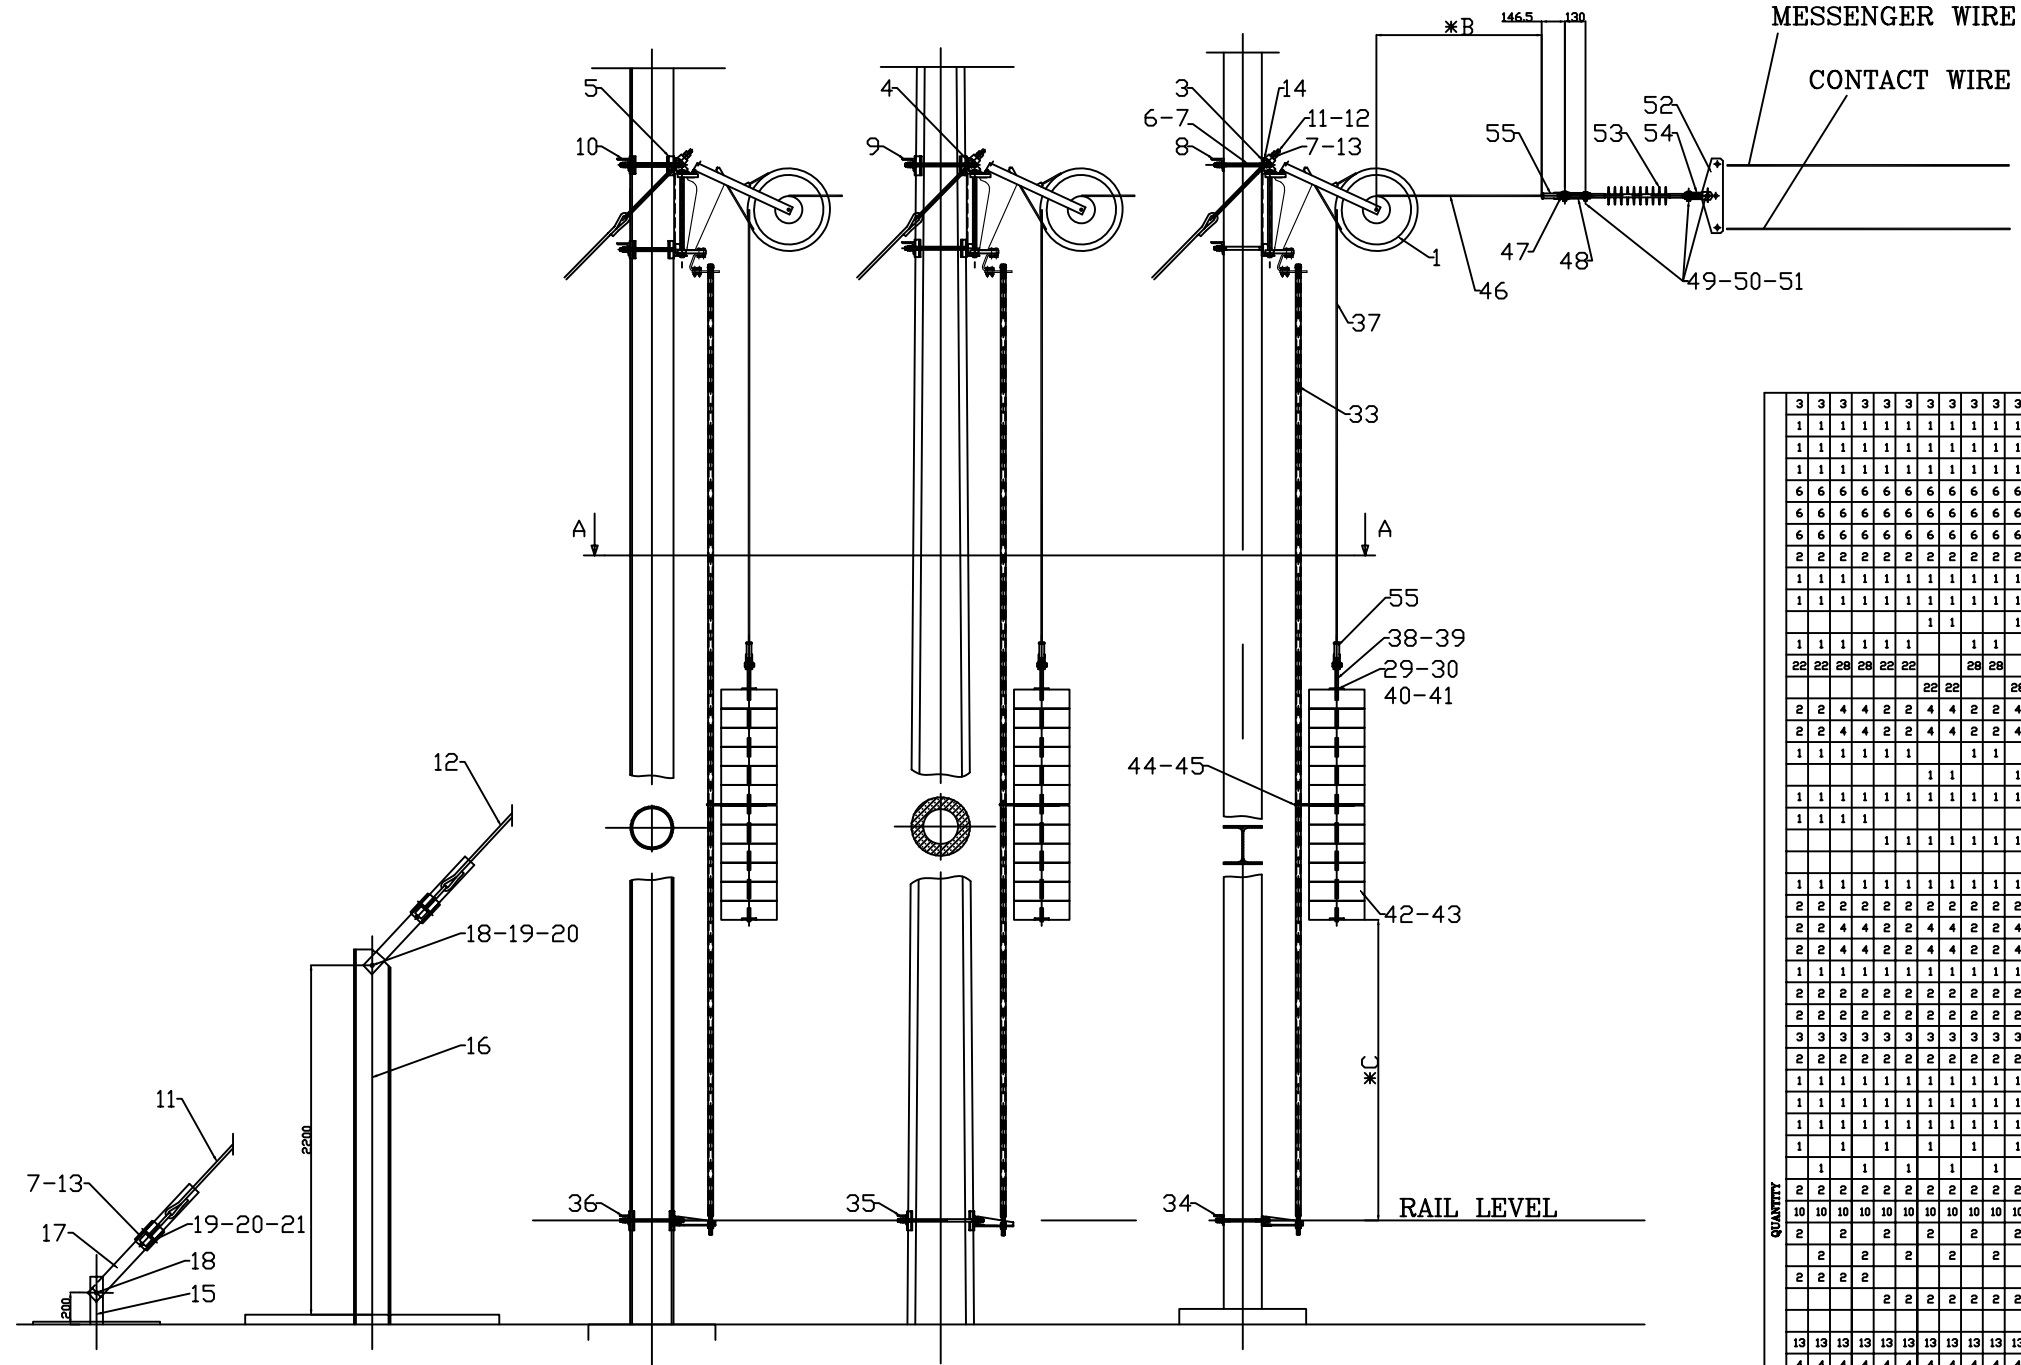


MARK GROUP	120	119	118	117	116	114	113	111	110	109	107	106	104	103	101	ITEM	DESIGNATION	UNIT	REFERENCE DRAWING	MARK
CGF	3	3	3	3	3	3	3	3	3	3	3	3	3	3	3	55	CLAMP		ELC 9-290	
TF 80	1	1	1	1	1	1	1	1	1	1	1	1	1	1	1	54	CLEVIS WITH EYE TWISTED		01LC00BDG192	
	1	1	1	1	1	1	1	1	1	1	1	1	1	1	1	53	INSULATOR		01LC00BDG018	
	1	1	1	1	1	1	1	1	1	1	1	1	1	1	1	52	3 PIN CLEVIS		01LC00BDG179	
	6	6	6	6	6	6	6	6	6	6	6	6	6	6	6	51	SPLIT PIN		01LC00BDG145	22A40
	6	6	6	6	6	6	6	6	6	6	6	6	6	6	6	50	WASHER		01LC00BDG142	22A11
	6	6	6	6	6	6	6	6	6	6	6	6	6	6	6	49	AXIS		01LC00BDG146	22460
	2	2	2	2	2	2	2	2	2	2	2	2	2	2	2	48	PLATE		01LC00BDG209	
	1	1	1	1	1	1	1	1	1	1	1	1	1	1	1	47	THREE PIN STRAP		01LC00BDG189	
	1	1	1	1	1	1	1	1	1	1	1	1	1	1	1	46	DOUBLE NORMAL CABLE 10-H-6x37-1770/8-g-s/z		STAS 1353-86	
																45	EYE II		01LC00BDG175	
	1	1	1	1	1	1	1	1	1	1	1	1	1	1	1	44	EYE I		01LC00BDG174	
	22	22	22	22	22	22	22	22	22	22	22	22	22	22	22	43	CAST IRON COUNTERWEIGHT		01LC00BDG173	
																42	CONCRETE COUNTERWEIGHT		01LC00BDG172	
	2	2	2	2	2	2	2	2	2	2	2	2	2	2	2	41	NUT M12 gr.4		SR EN ISO 4032-2002	
	2	2	2	2	2	2	2	2	2	2	2	2	2	2	2	40	CRAMP		ELC 51-22	
	1	1	1	1	1	1	1	1	1	1	1	1	1	1	1	39	ROD FOR CAST IRON COUNTERWEIGHTS		01LC00BDG202	
																38	CADRE FOR CONCRETE COUNTERWEIGHTS		01LC00BDG201	
	1	1	1	1	1	1	1	1	1	1	1	1	1	1	1	37	DOUBLE NORMAL CABLE 10-H-6x37-1770/8-g-s/z		STAS 1353-86	
	1	1	1	1	1	1	1	1	1	1	1	1	1	1	1	36	INFERIOR FASTENING ON SMT 273 POLE		01LC00BDG197	
																35	INFERIOR FASTENING ON SEC66 POLE		01LC00BDG195	
																34	INFERIOR FASTENING ON MU 10-5/8.2 DR HEB POLE		01LC00BDG193	
	1	1	1	1	1	1	1	1	1	1	1	1	1	1	1	33	GUIDEWAY		01LC00BDG187	
	2	2	2	2	2	2	2	2	2	2	2	2	2	2	2	31	PLATE		01LC00BDG158	
	2	2	2	2	2	2	2	2	2	2	2	2	2	2	2	30	WASHER		01LC00BDG142	12B51
	2	2	2	2	2	2	2	2	2	2	2	2	2	2	2	29	BOLT		01LC00BDG144	1222E7
	1	1	1	1	1	1	1	1	1	1	1	1	1	1	1	27	COGWHEEL SUPPORT AXIS		01LC00BDG186	
	2	2	2	2	2	2	2	2	2	2	2	2	2	2	2	23	NUT M24-gr.8		SR EN ISO 4032-2002	
	2	2	2	2	2	2	2	2	2	2	2	2	2	2	2	22	SPLIT PIN		01LC00BDG145	24A50
	3	3	3	3	3	3	3	3	3	3	3	3	3	3	3	21	WASHER		01LC00BDG142	24A11
	2	2	2	2	2	2	2	2	2	2	2	2	2	2	2	20	AXIS		01LC00BDG146	24460
	1	1	1	1	1	1	1	1	1	1	1	1	1	1	1	19	SUPPORT		01LC00BDG156	
	1	1	1	1	1	1	1	1	1	1	1	1	1	1	1	18	BOLT		01LC00BDG144	2743TF
	1	1	1	1	1	1	1	1	1	1	1	1	1	1	1	17	REGULATION PLATE		ELC 49-17	
	1	1	1	1	1	1	1	1	1	1	1	1	1	1	1	16	SUPERELEVATED ANCHOR BEAM		01LC00BDG049	
	1	1	1	1	1	1	1	1	1	1	1	1	1	1	1	15	LEVEL ANCHOR BEAM		01LC00BDG132	
	2	2	2	2	2	2	2	2	2	2	2	2	2	2	2	14	SPECIAL WASHER		ELC 16-12.30	
	10	10	10	10	10	10	10	10	10	10	10	10	10	10	10	13	NUT M20-gr.8		SR EN ISO 4032-2002	
	2	2	2	2	2	2	2	2	2	2	2	2	2	2	2	12	TIE ROD		01LC00BDG130	102
	2	2	2	2	2	2	2	2	2	2	2	2	2	2	2	11	TIE ROD		01LC00BDG130	101
	2	2	2	2	2	2	2	2	2	2	2	2	2	2	2	10	COUNTERPLATE		01LC00BDG129	103
																9	COUNTERPLATE		01LC00BDG129	102
																8	COUNTERPLATE		01LC00BDG129	101
	13	13	13	13	13	13	13	13	13	13	13	13	13	13	13	7	WASHER		01LC00BDG142	20A11
	4	4	4	4	4	4	4	4	4	4	4	4	4	4	4	6	THREADED ROD		01LC00BDG141	2041E2
	1	1	1	1	1	1	1	1	1	1	1	1	1	1	1	5	UPPER FASTENING FOR SMT 273 POLE		01LC00BDG185	
																4	UPPER FASTENING FOR SEC66 POLE		01LC00BDG184	
																3	UPPER FASTENING FOR MU 10-5/8.2 DR HEB POLE		01LC00BDG183	
	1	1	1	1	1	1	1	1	1	1	1	1	1	1	1	1	COGWHEEL		B624006h	RIBE
	120	119	118	117	116	114	113	111	110	109	107	106	104	103	101		DESIGNATION			
	As	An	As	An	As	An	As	An	As	An	As	An	As	An	As		UNIT			
	CGF	CGF	CGF	CGb	CGF	CGb	CGF	CGb	CGF	CGb	CGF	CGb	CGF	CGb	CGF		REFERENCE			
	TF 80	TF 100	TF 80	TF 100	TF 80	TF 100	TF 80	TF 100	TF 80	TF 100	TF 80	TF 100	TF 80	TF 100	TF 80		MARK			
	SMT 273		SEC66				MU10-5/8.2, HEB													

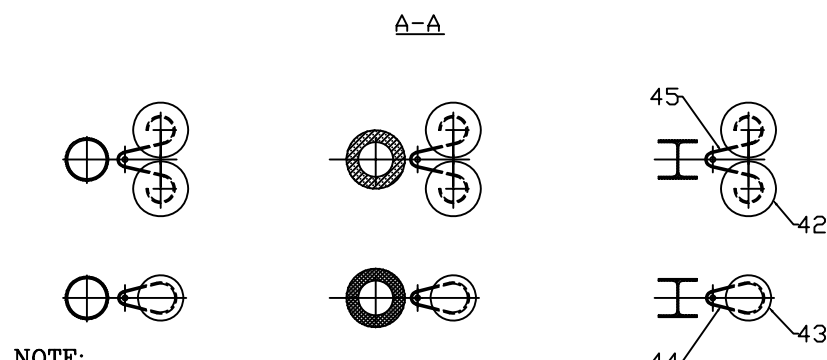


NOTE:
* -THE DIMENSIONS B AND C ARE IN DRAWING NO. 01LC00BDG053

ANCORAREA TOTAL COMPENSATA A CATENAREI FULL COMPENSATED CATENARY ANCHORING	Numele fisierului/ CAD file name:	Scara/ Scale:	Part	Rev.
	01LC00BDG182		1 / 1	0

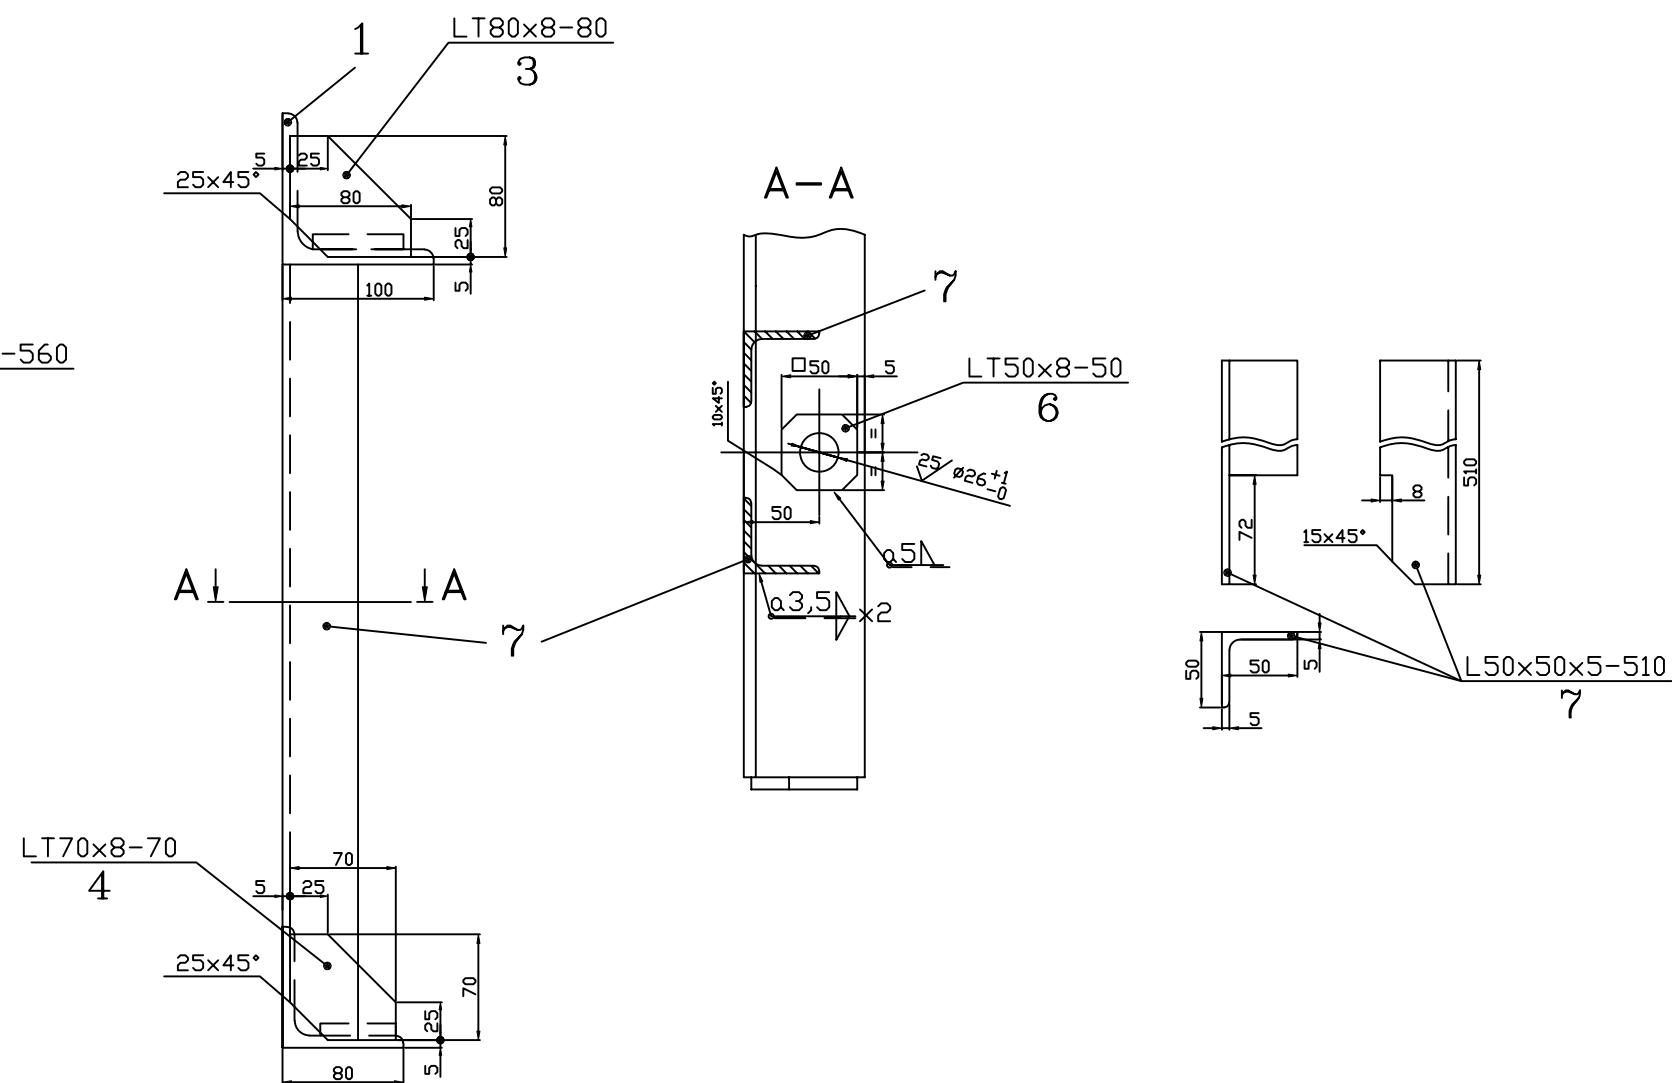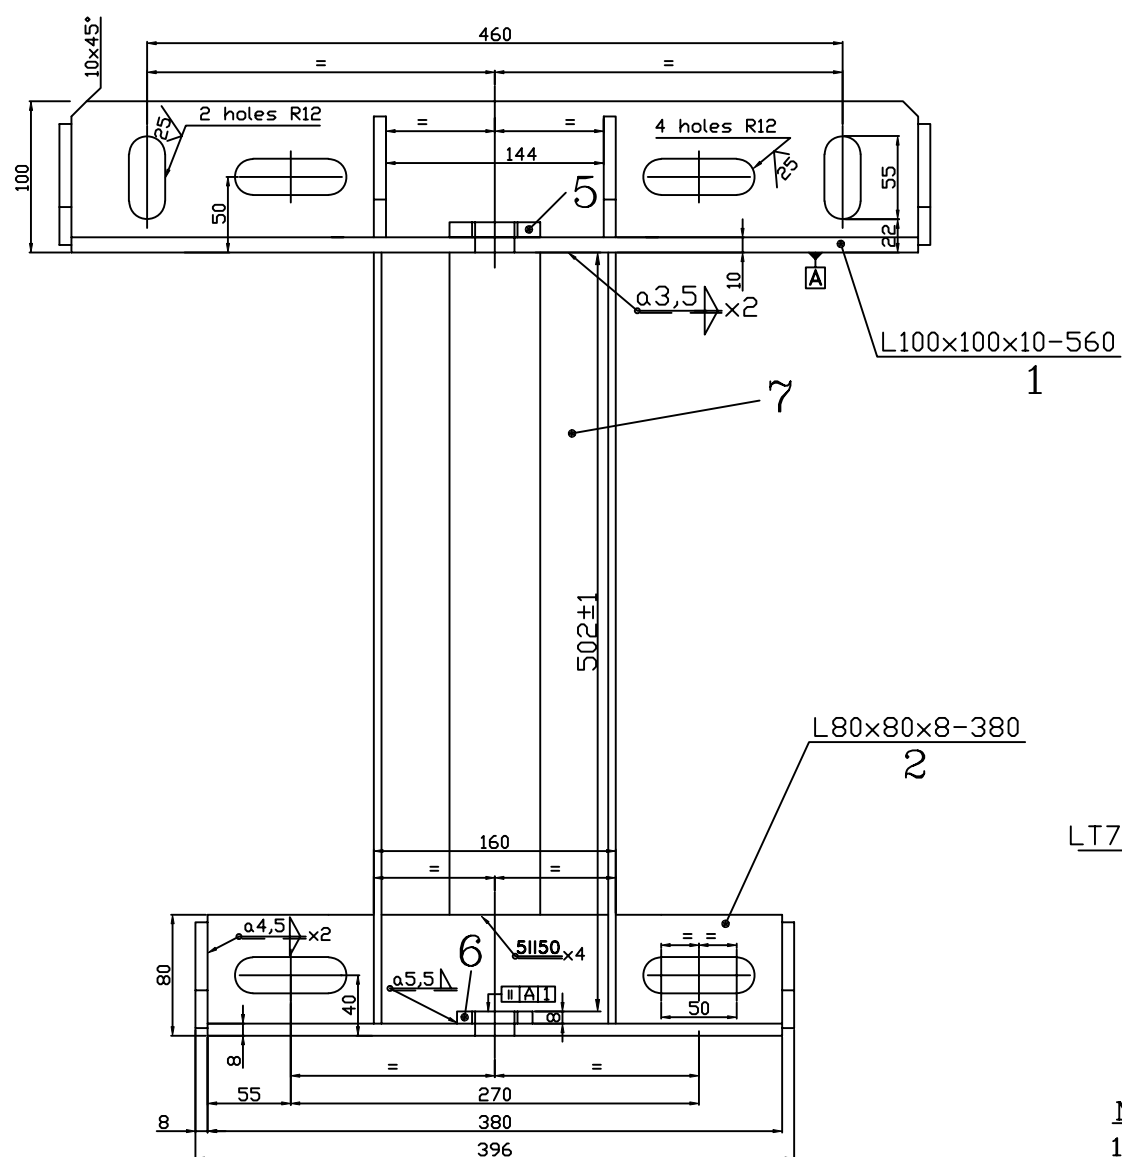


NOTE:

- 1.The weldings will be made continuous, tight for hot galvanize.
- 2.The hole $\varnothing 26$ will be coaxial, in bouth spreaders.
- 3.After welding and drilling will be hot galvanized AT/OL/Zn600-STAS 7221-90.

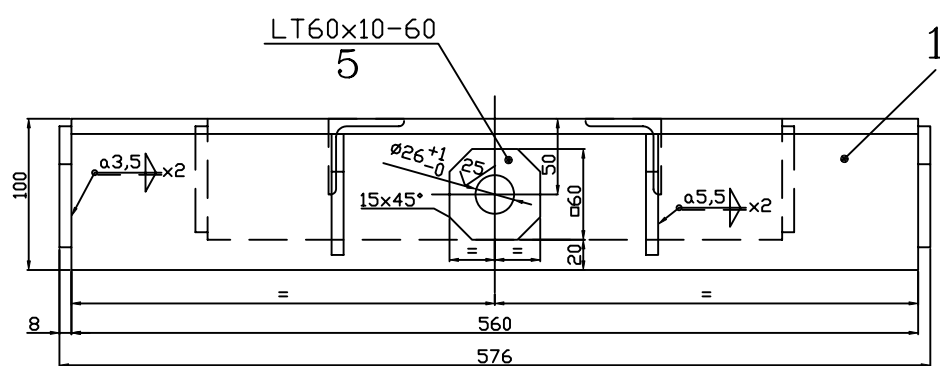

MARK GROUP	ITEM	DESIGNATION	UNIT MASS	MATERIAL TECHNICAL SPECIFICATION	MARK
QUANTITY	2	7	CADRE	S235JR	2
	1	6	ADDITION	S235JR	2
	1	5	ADDITION	S235JR	2
	2	4	RIB	S235JR	2
	4	3	RIB	S235JR	2
	1	2	SPREADER	S275JR	8
	1	1	SPREADER	S275JR	8

FIXARE SUPERIOARA PENTRU MU 10-5/8.2 SAU STALP HEB UPPER FASTENING FOR MU 10-5/8.2 OR HEB POLE	Numele fisierului/ CAD file name:	Scara/ Scale:	Part	Rev.
	01LC00BDG183		1 / 1	0

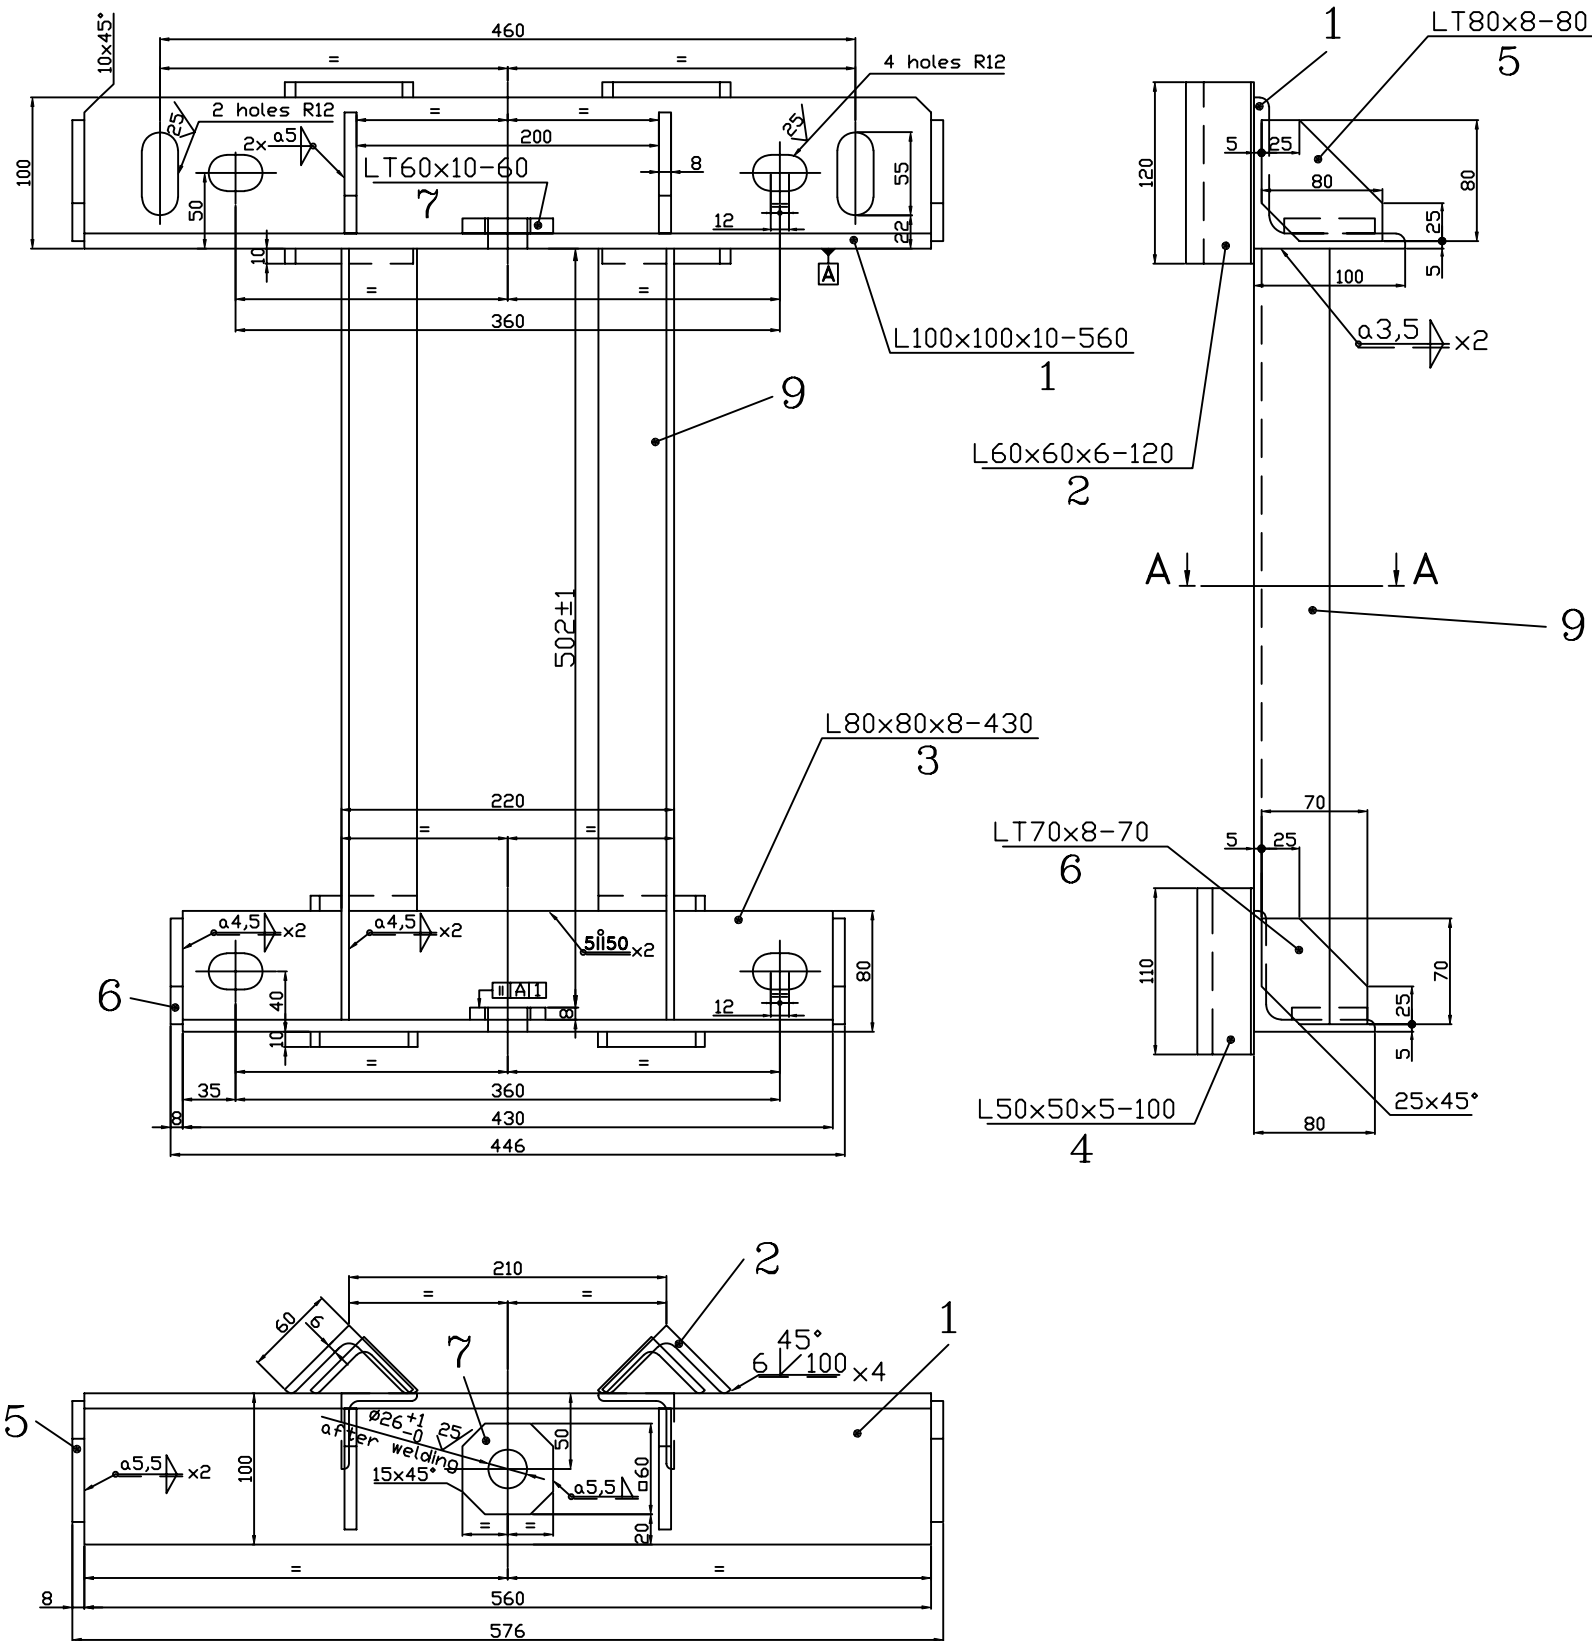


NOTE:

- 1.The frame, item 9, will be made one pcs for left and one for right.
- 2.The weldings will be made continuous, tight for hot galvanize.
- 3.The hole $\phi 26$ will be coaxial, in bouth spreaders.
- 4.After welding and drilling will be hot galvanized AT/OL/Zn600-STAS 7221-90.

MARK GROUP	ITEM	DESIGNATION	UNIT MASS kg	MATERIAL TECHNICAL SPECIFICATION
QUANTITY	2	9	CADRE	S235JR
	1	8	ADDITION	S235JR
	1	7	ADDITION	S235JR
	2	6	RIB	S235JR
	4	5	RIB	S235JR
	2	4	SPACER	S235JR
	1	3	SPREADER	S275JR
	2	2	SPACER	S235JR
	1	1	SPREADER	S275JR

FIXARE SUPERIOARA PENTRU STALP SECP6 UPPER FASTENING FOR SECP6 POLE	Numele fisierului/ CAD file name:	Scara/ Scale:	Part	Rev.
	01LC00BDG184		1 / 1	0

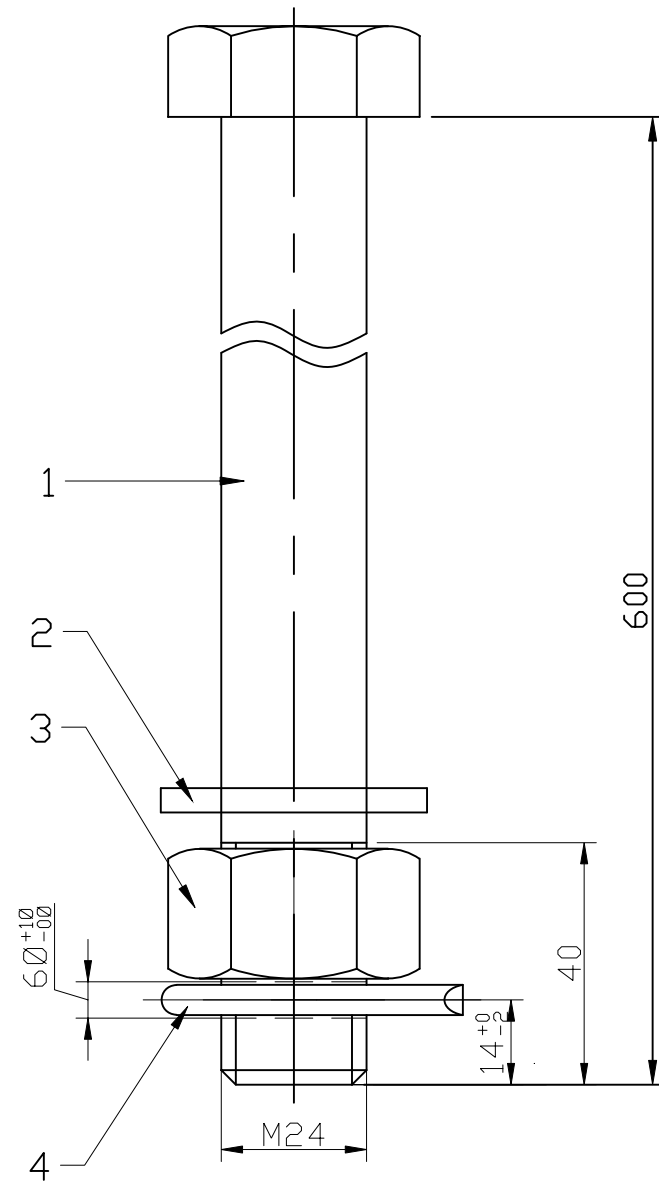

NOTE:


The axis 1 will be executed from OLC 45.
 The position 2 and 3 will be hot galvanized
 AT/OL/Zn500.

MARK GROUP	QUANTITY	ITEM	DESIGNATION	UNIT MASS	REFERENCE DRAWING	MARK
	1	4	SPLIT 5x40		01LC00BDG145	506040
	2	3	WASHER T24		01LC00BDG142	
	2	2	NUT M24		SR EN ISO 4032-2002	
	1	1	SCREW M24		-	
				kg		

AX SUPORT
 COGWHEEL SUPORT AXIS

Numele fisierului/
 CAD file name:
01LC00BDG186

Scara/ Scale:	Part	Rev.
	1 / 1	0

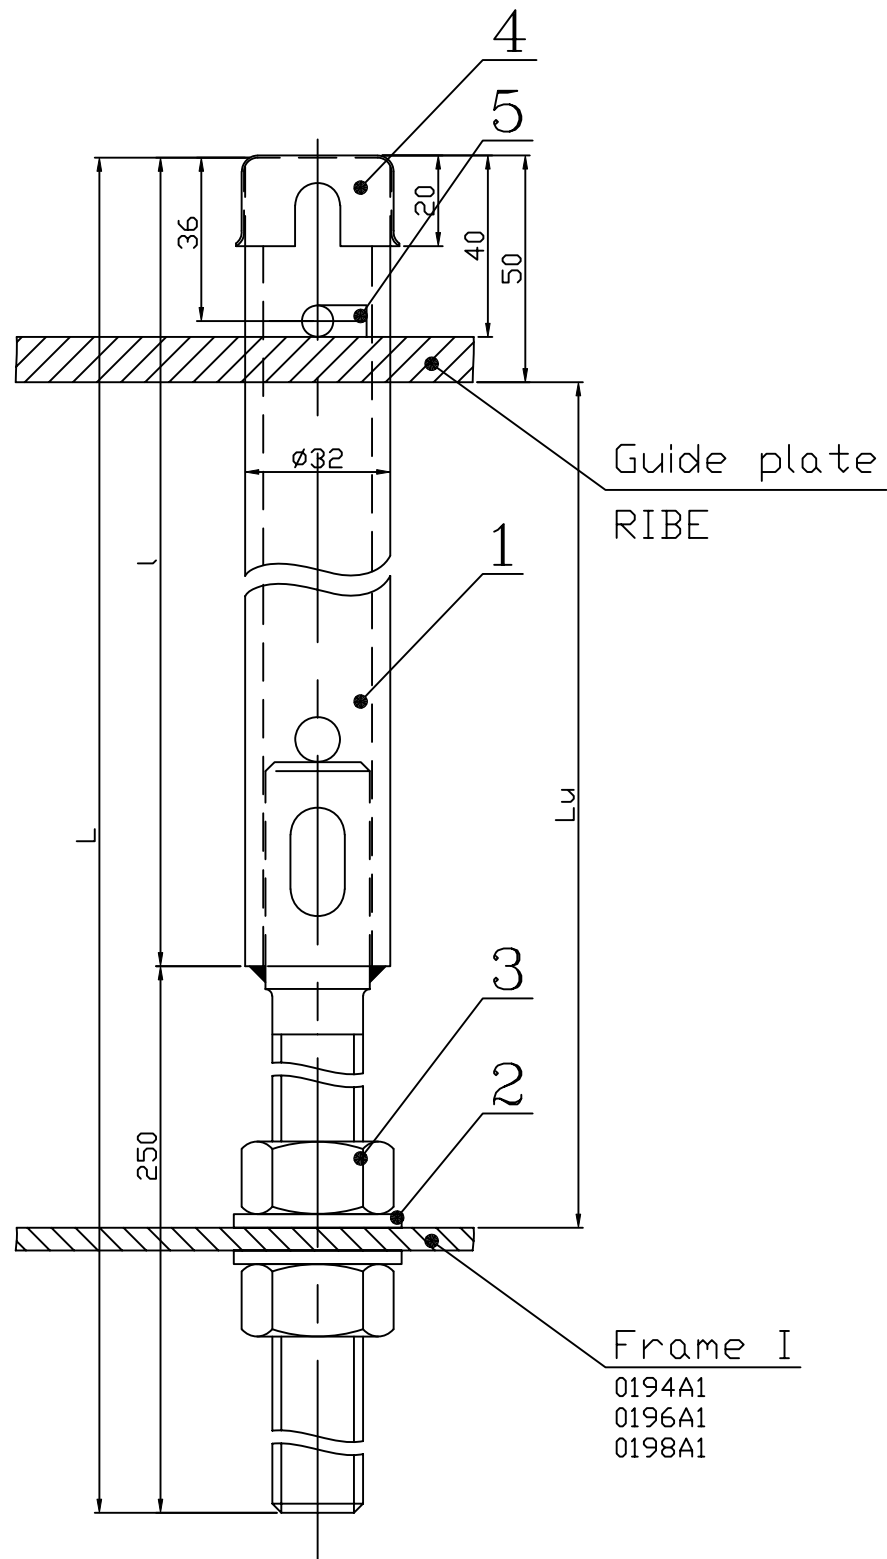


Mark	Hfc	L	l	Lu
101	5650-5500	5900	5650	5600-5750
102	5750-5600	6000	5750	5700-5850
103	5850-5700	6100	5850	5800-5950
104	5950-5800	6200	5950	5900-6050
105	6050-5900	6300	6050	6000-6150
106	6150-6000	6400	6150	6100-6250
107	6250-6100	6500	6250	6200-6350
108	6350-6200	6600	6350	6300-6450
109	6450-6300	6700	6450	6400-6550
110	6550-6400	6800	6550	6500-6650

NOTE:

The elements 2 and 3 will be hot galvanized
AT/OL/Zn500, except the threader AT/OL/Zn310.
Material P5: COOPER

MARK GROUP	ITEM	DESIGNATION	UNIT MASS	REFERENCE DRAWING	MARK
QUANTITY	1	5	Split 5x70 (32B70)	01LC00BDG145	32B070
	1	4	Cover	01LC00BDG191	
	2	3	NUT M20	SR EN ISO 4032-2002	
	2	2	WASHER T20	01LC00BDG142	20A110
	1	1	BAR	01LC00BDG188	
			kg		

GHIDAJ GUIDEWAY		Numele fisierului/ CAD file name:	Scara/ Scale:	Part	Rev.
		01LC00BDG187		1 / 1	0

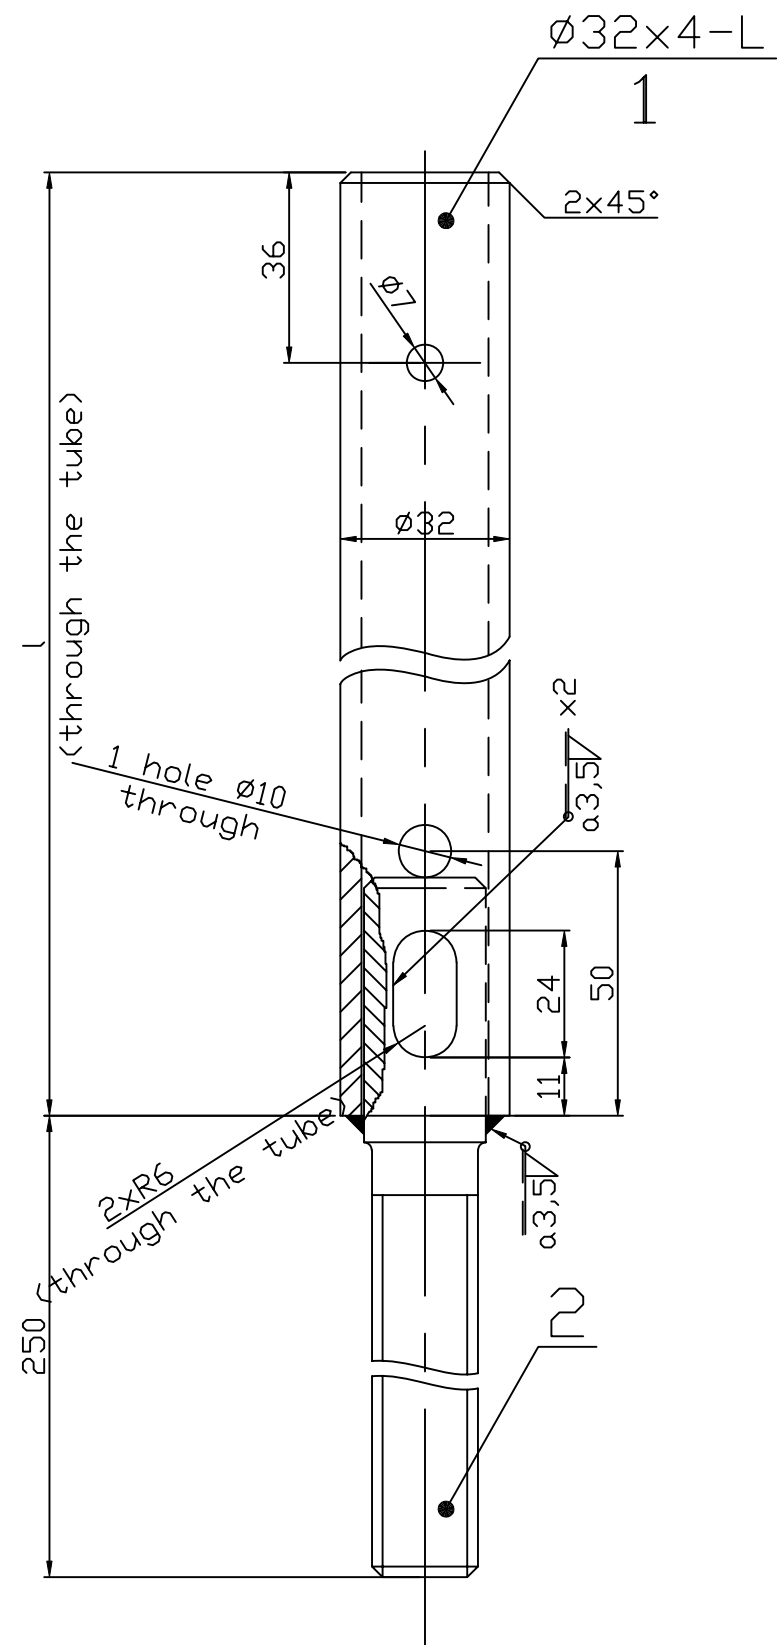


ANOTE:

fter the welding will be hot galvanized
AT/OL/Zn500, except the threader AT/OL/Zn310.

Material 1: OLT 45 STAS 8183-80
Material 2: S275JR

MARK GROUP	1	2	SCREW		03LC00BDG190	
	1	1	BAR		-	
	ITEM		DESIGNATION	UNIT MASS	REFERENCE DRAWING	MARK
				kg		


BARA BAR	Numele fisierului/ CAD file name:	Scara/ Scale:	Part	Rev.
	01LC00BDG188		1 / 1	0

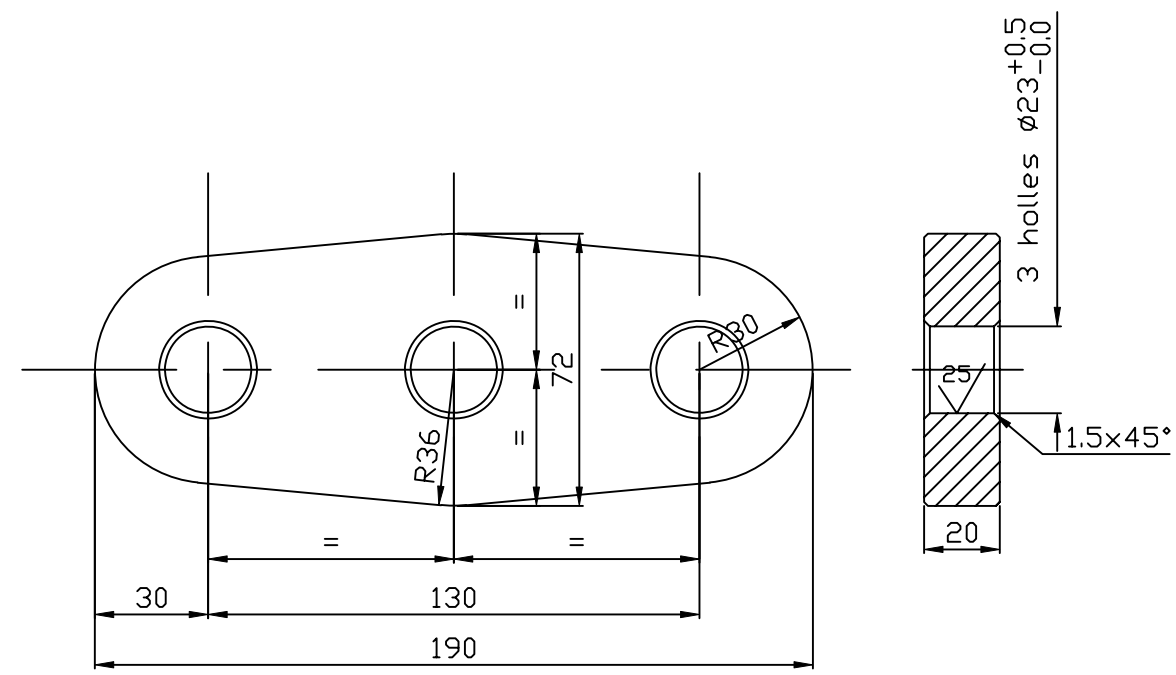

NOTE:

After welding and drilling will be hot galvanized AT/OL/Zn600-STAS 7221-90.
 MATERIAL: S275JR


LEGATURA CU 3 GAURI THREE PIN STRAP	Numele fisierului/ CAD file name:	Scara/ Scale:	Part	Rev.
	01LC00BDG189		1 / 1	0

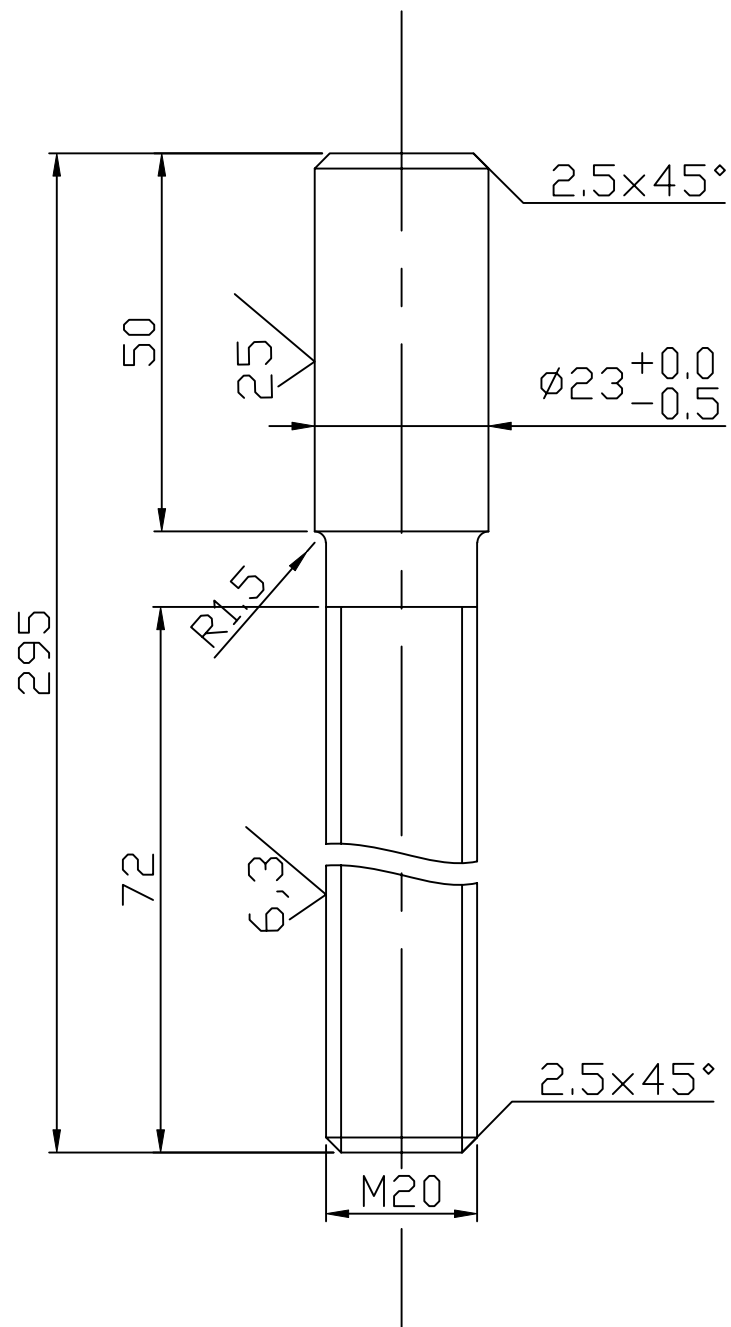

NOTE

MATERIAL: S235JR

SURUB SCREW	Numele fisierului/ CAD file name:	Scara/ Scale:	Part	Rev.
	01LC00BDG190		1 / 1	0




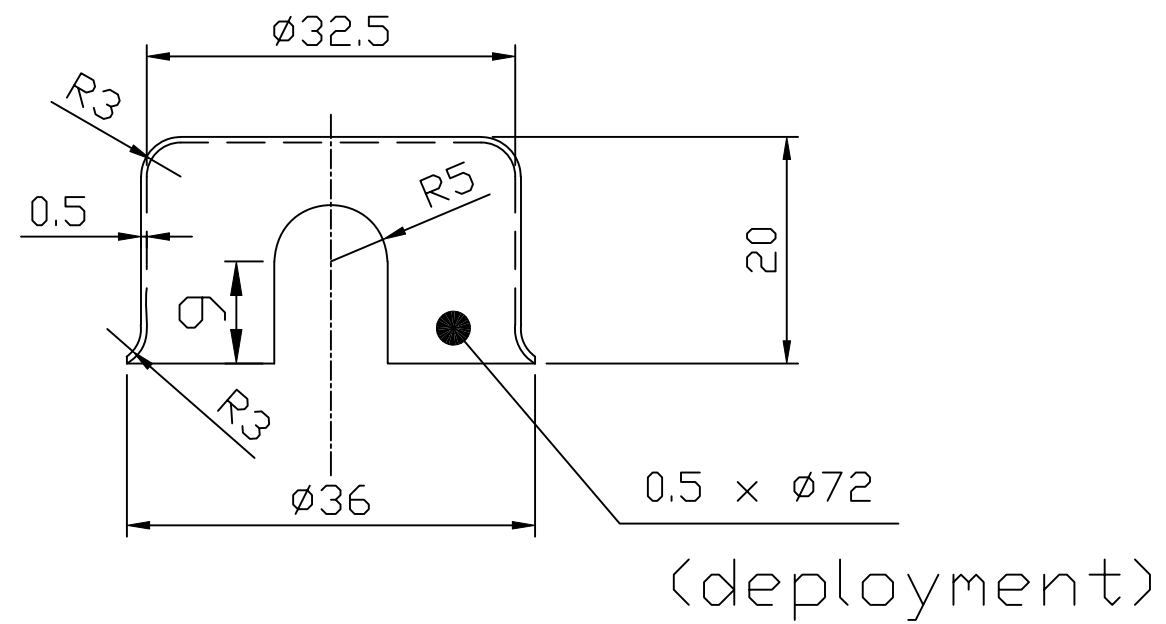


NOTE:

The part will be hot galvanized AT/OL/Zn500

MATERIAL: S235JR

CAPAC COVER	Numele fisierului/ CAD file name:	Scara/ Scale:	Part	Rev.
	01LC00BDG191		1 / 1	0

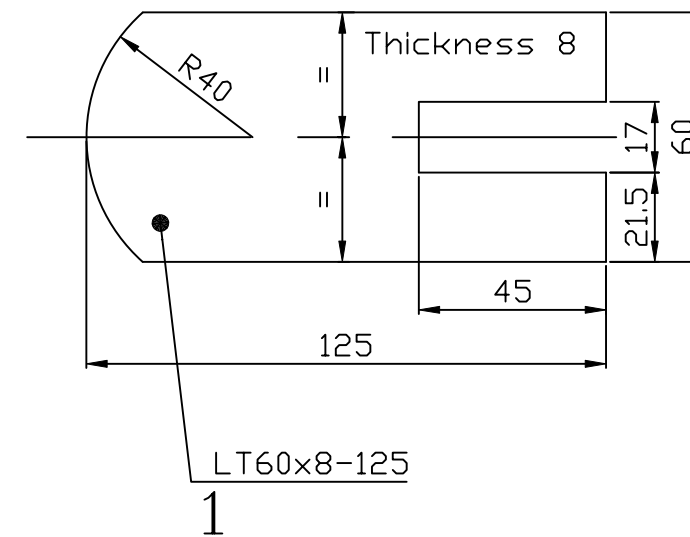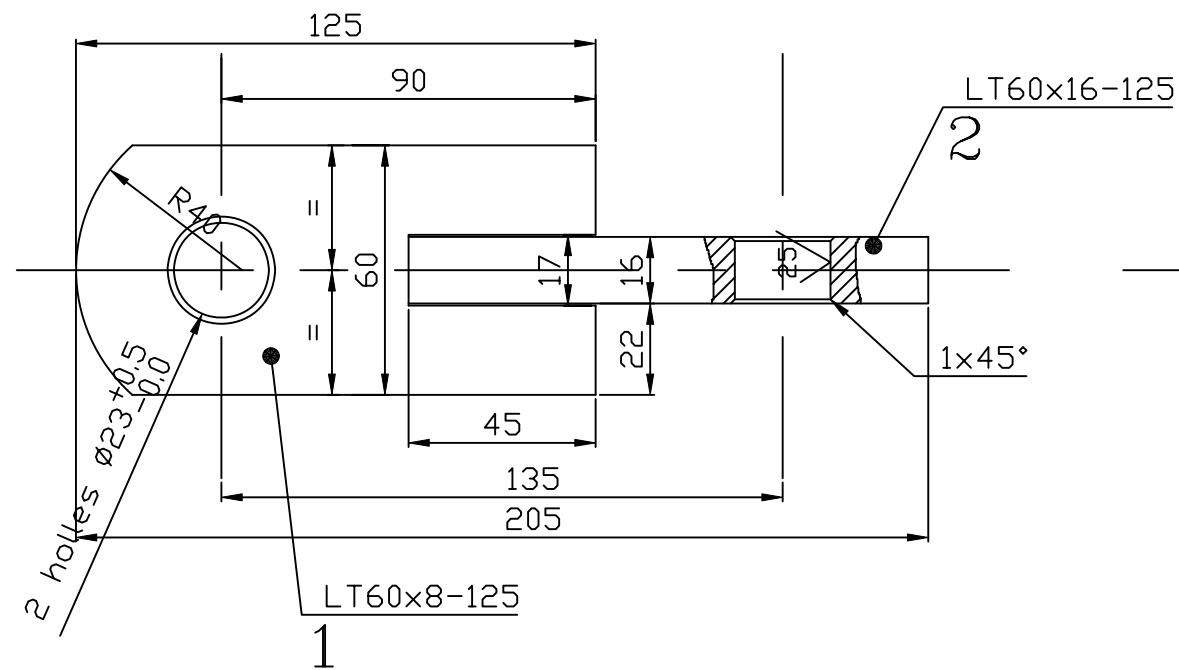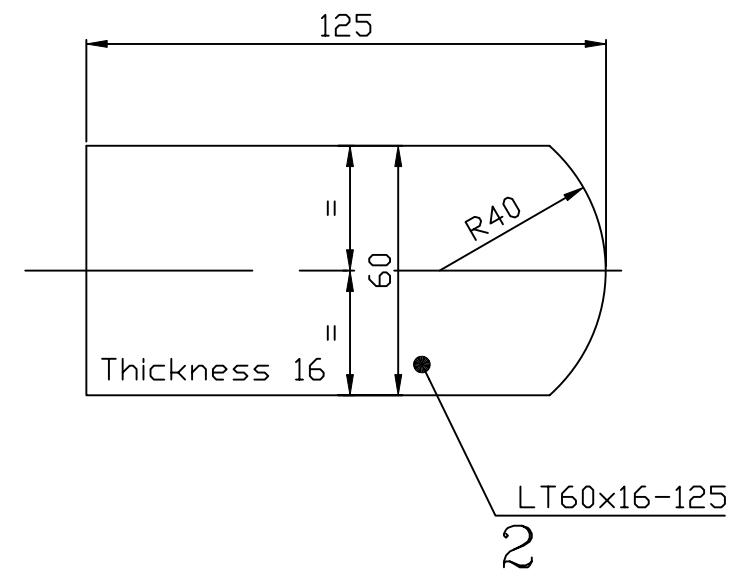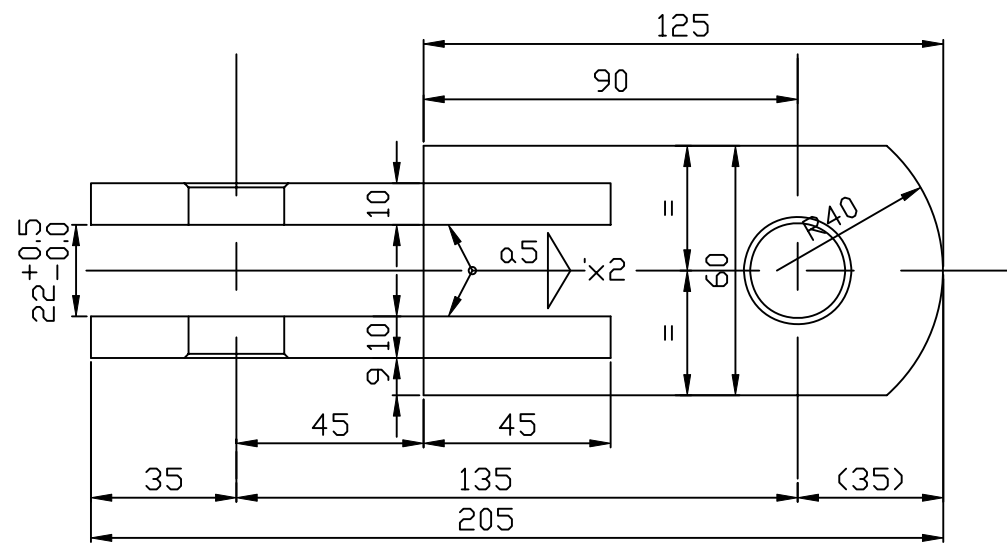


NOTE:

After welding and drilling will be hot galvanized AT/OL/Zn600-STAS 7221-90.

2	EYE II	2	S275JR
1	EYE I	1	S275JR
ITEM	DESIGNATION	UNIT	MATERIAL TECHNICAL SPECIFICATION

PRINDERE RASUCITA CU OCHI
CLEVIS WITH EYE TWISTED

Numele fisierului/ CAD file name:	Scara/ Scale:	Part	Rev.
01LC00BDG192		1 / 1	0

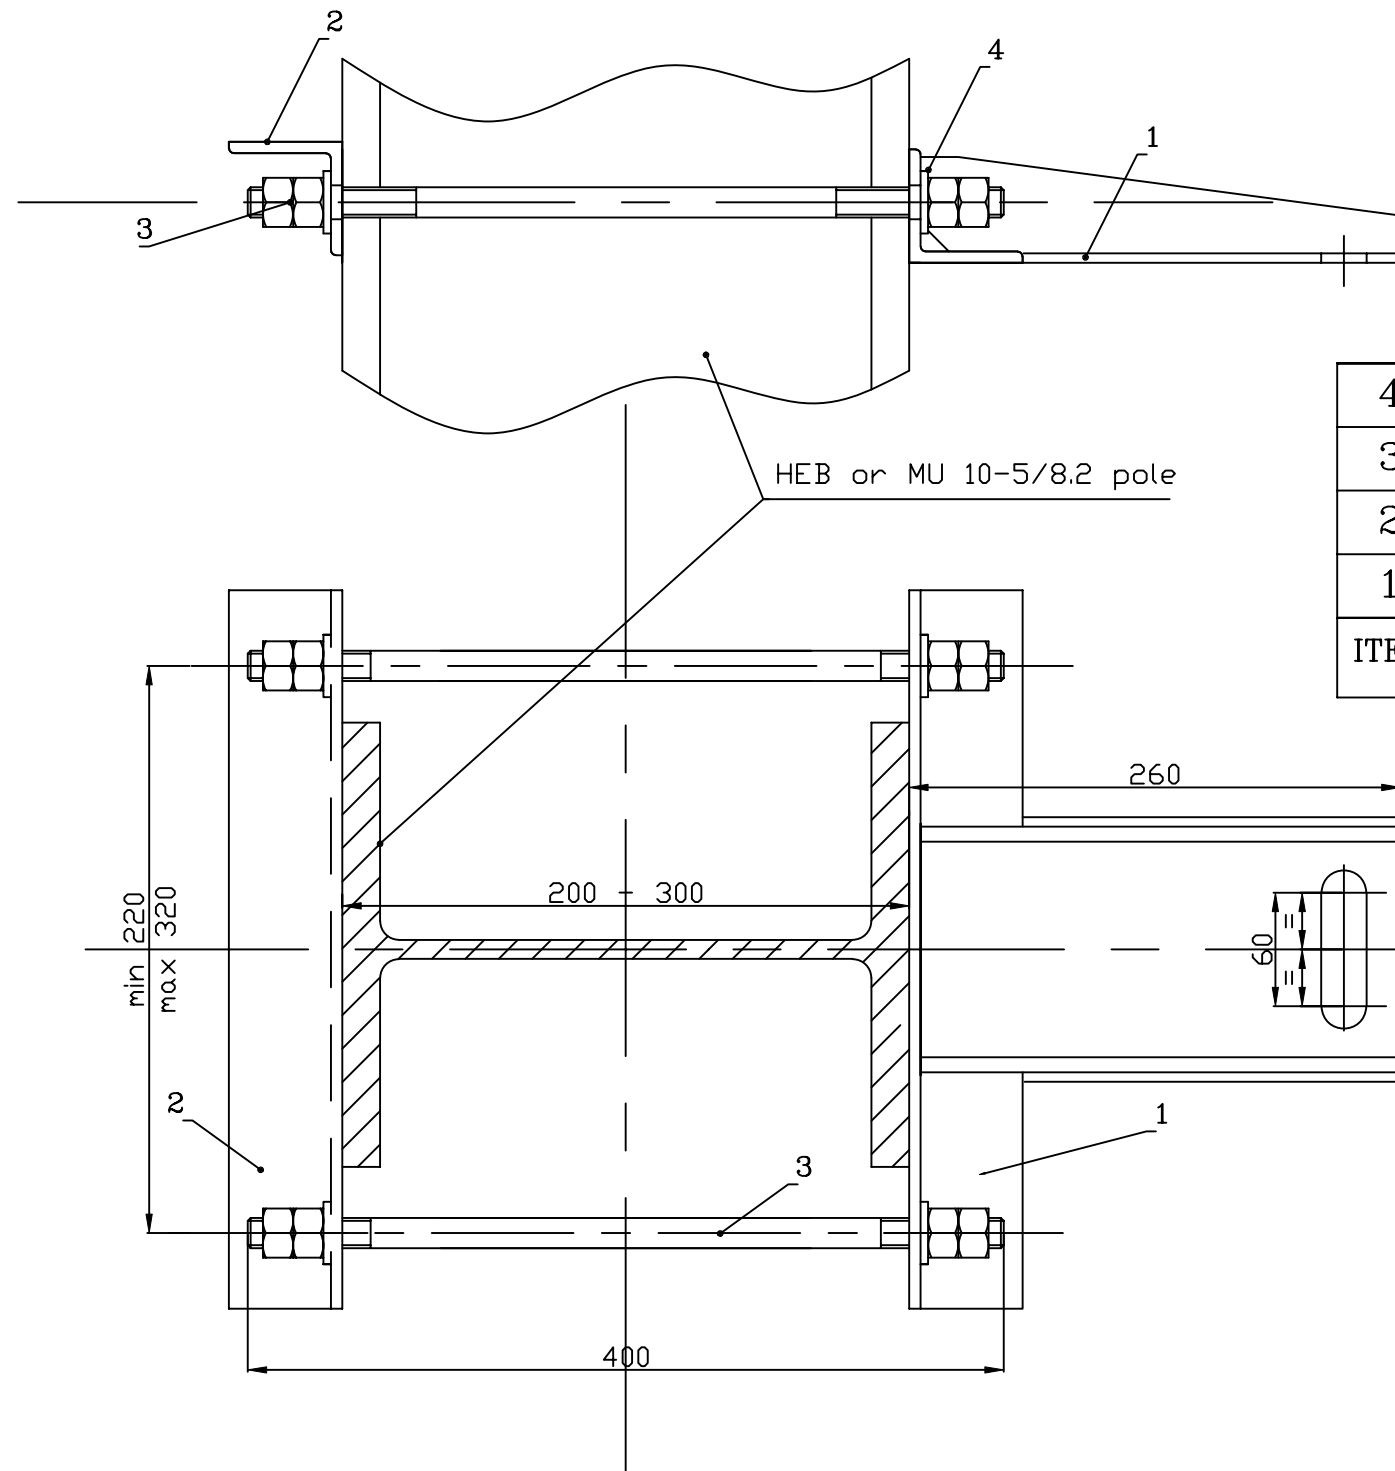

4	WASHER	4	01LC00BDG142	16A21
3	THREADED ROD	2	01LC00BDG141	1611D2
2	FRAME II	1	01LC00BDG165	
1	FRAME I	1	01LC00BDG194	
ITEM	DESIGNATION	UNIT	REFERENCE DRAWING	MARK

FIXARE INFERIOARA PE STALP HEB SAU MU
INFERIOR FASTENING ON HEB OR MU POLE

Numele fisierului/
CAD file name:
01LC00BDG193




Scara/
Scale:

Part

Rev.

1 / 1


0

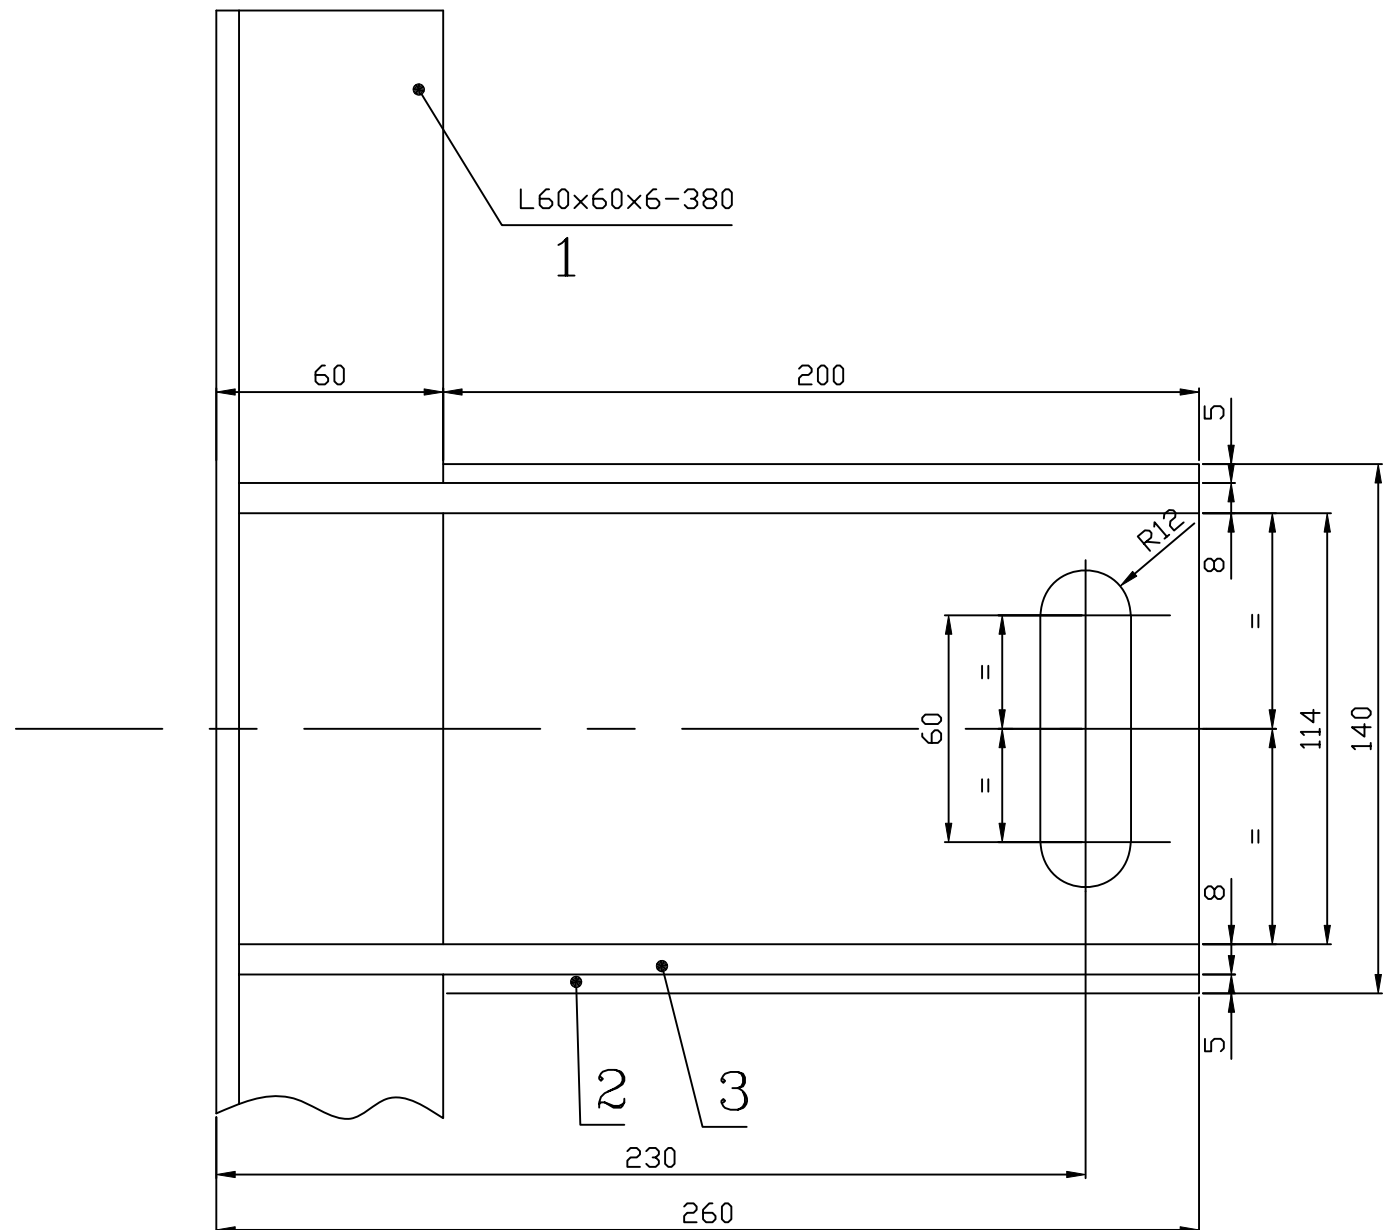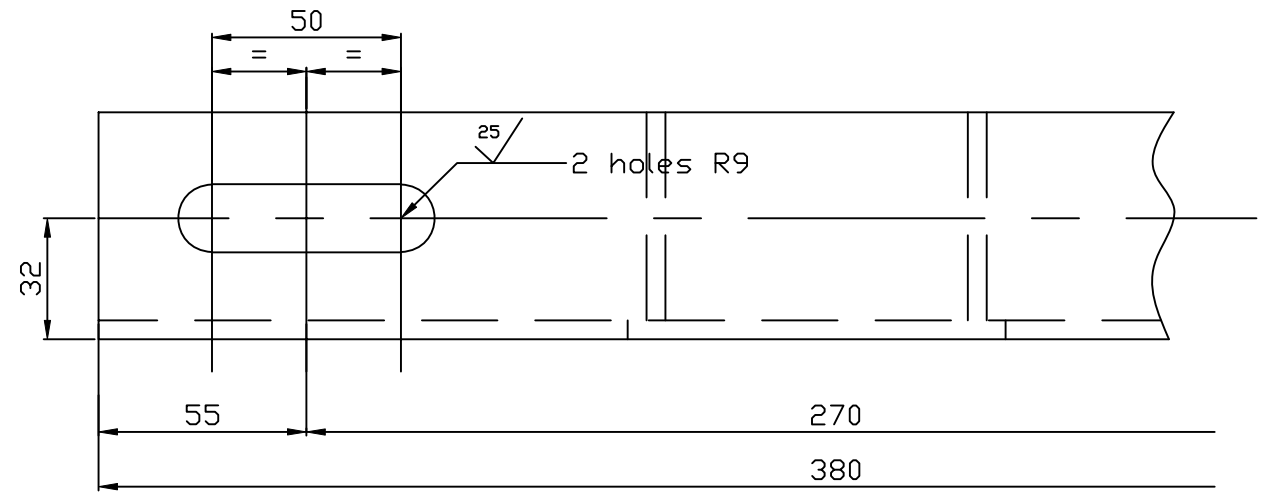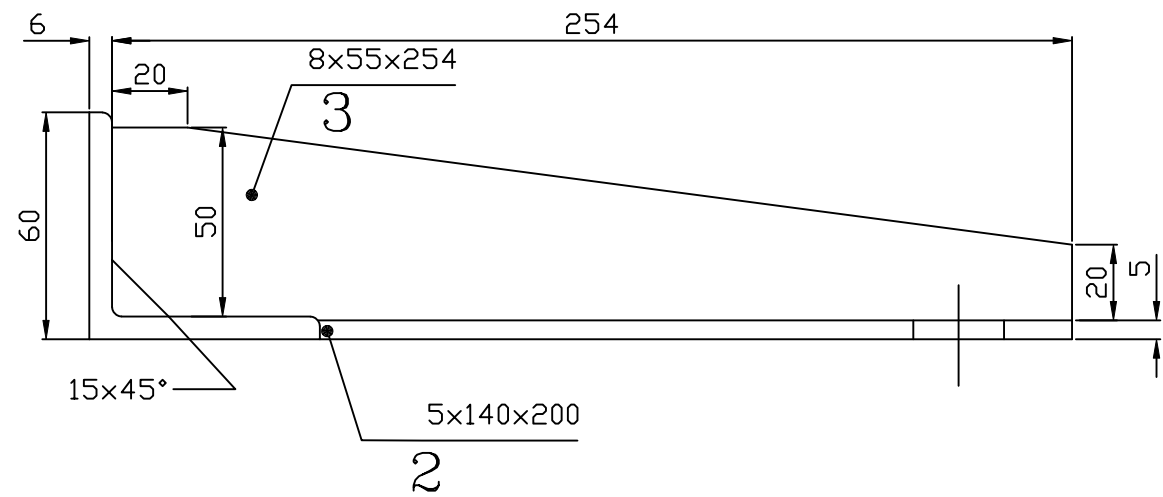

NOTE:
After welding and drilling will be hot galvanized AT/OL/Zn500-STAS 7221-90.

3	RIB	2	S235JR
2	ADDITION	1	S235JR
1	FRAME	1	S235JR
ITEM	DESIGNATION	UNIT	MATERIAL TECHNICAL SPECIFICATION

PROFIL I FRAME I	Numele fisierului/ CAD file name:	Scara/ Scale:	Part	Rev.
	01LC00BDG194		1 / 1	0

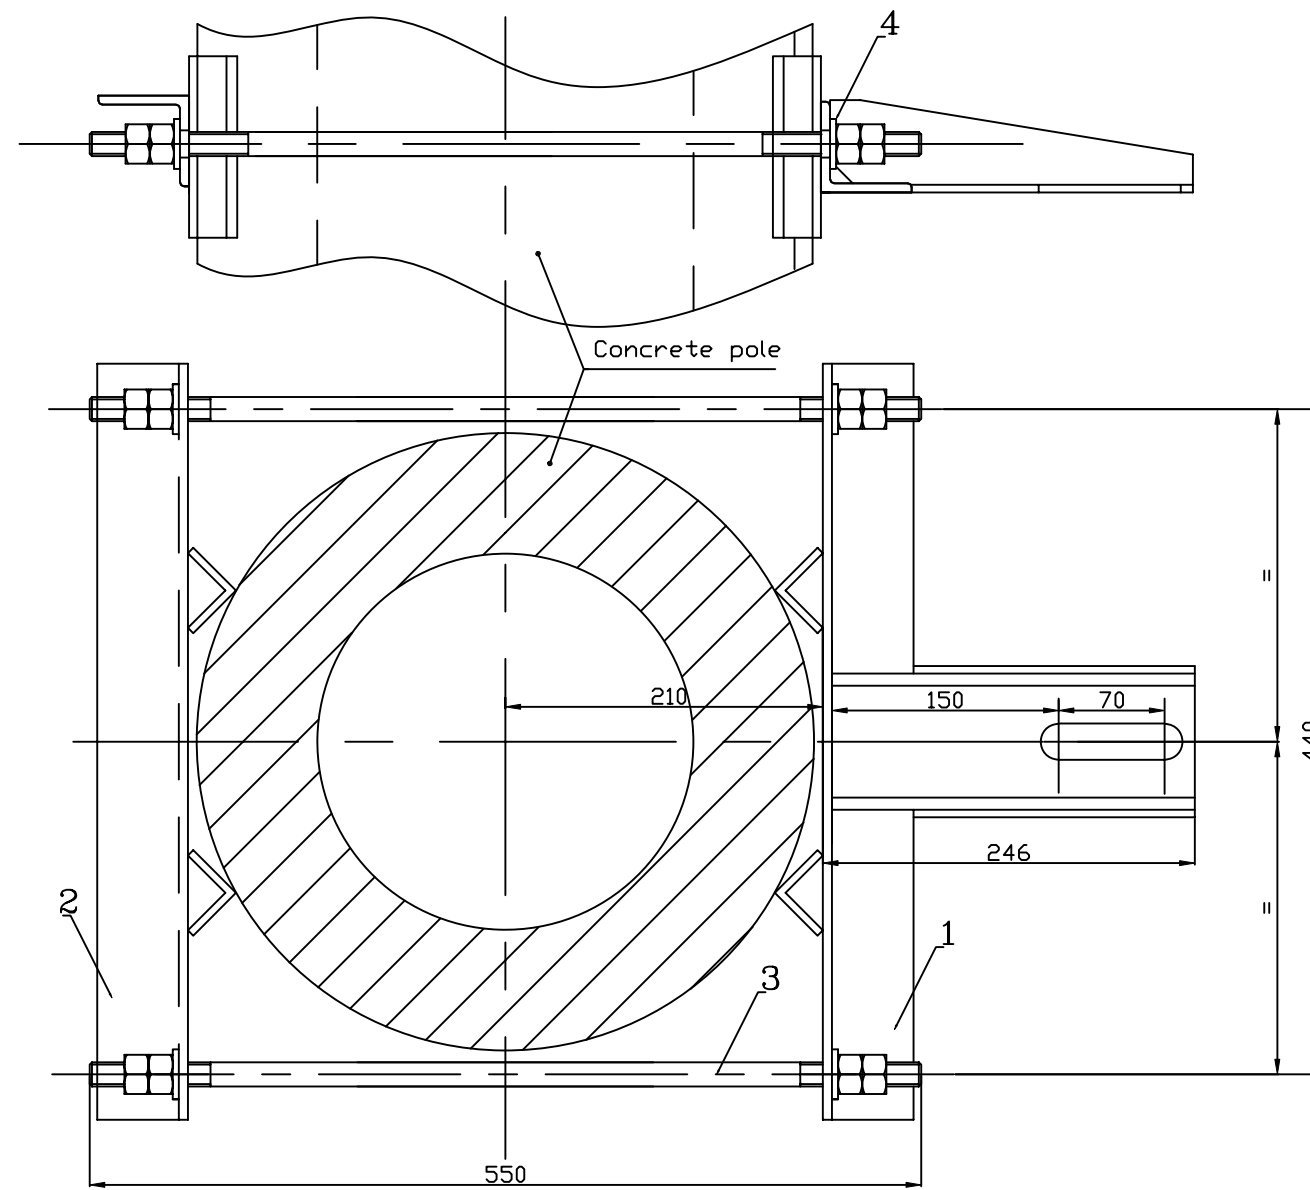

4	WASHER	4	01LC00BDG142	16A21
3	THREADED ROD	2	01LC00BDG141	1611G2
2	FRAME II	1	01LC00BDG168	
1	FRAME I	1	01LC00BDG196	
ITEM	DESIGNATION	UNIT	REFERENCE DRAWING	MARK




FIXARE INFERIOARA PENTRU STALP SECP6
INFERIOR FASTENING ON SECP6 POLE

Numele fisierului/
CAD file name:
01LC00BDG195

Scara/
Scale:

Part
1 / 1

Rev.
0

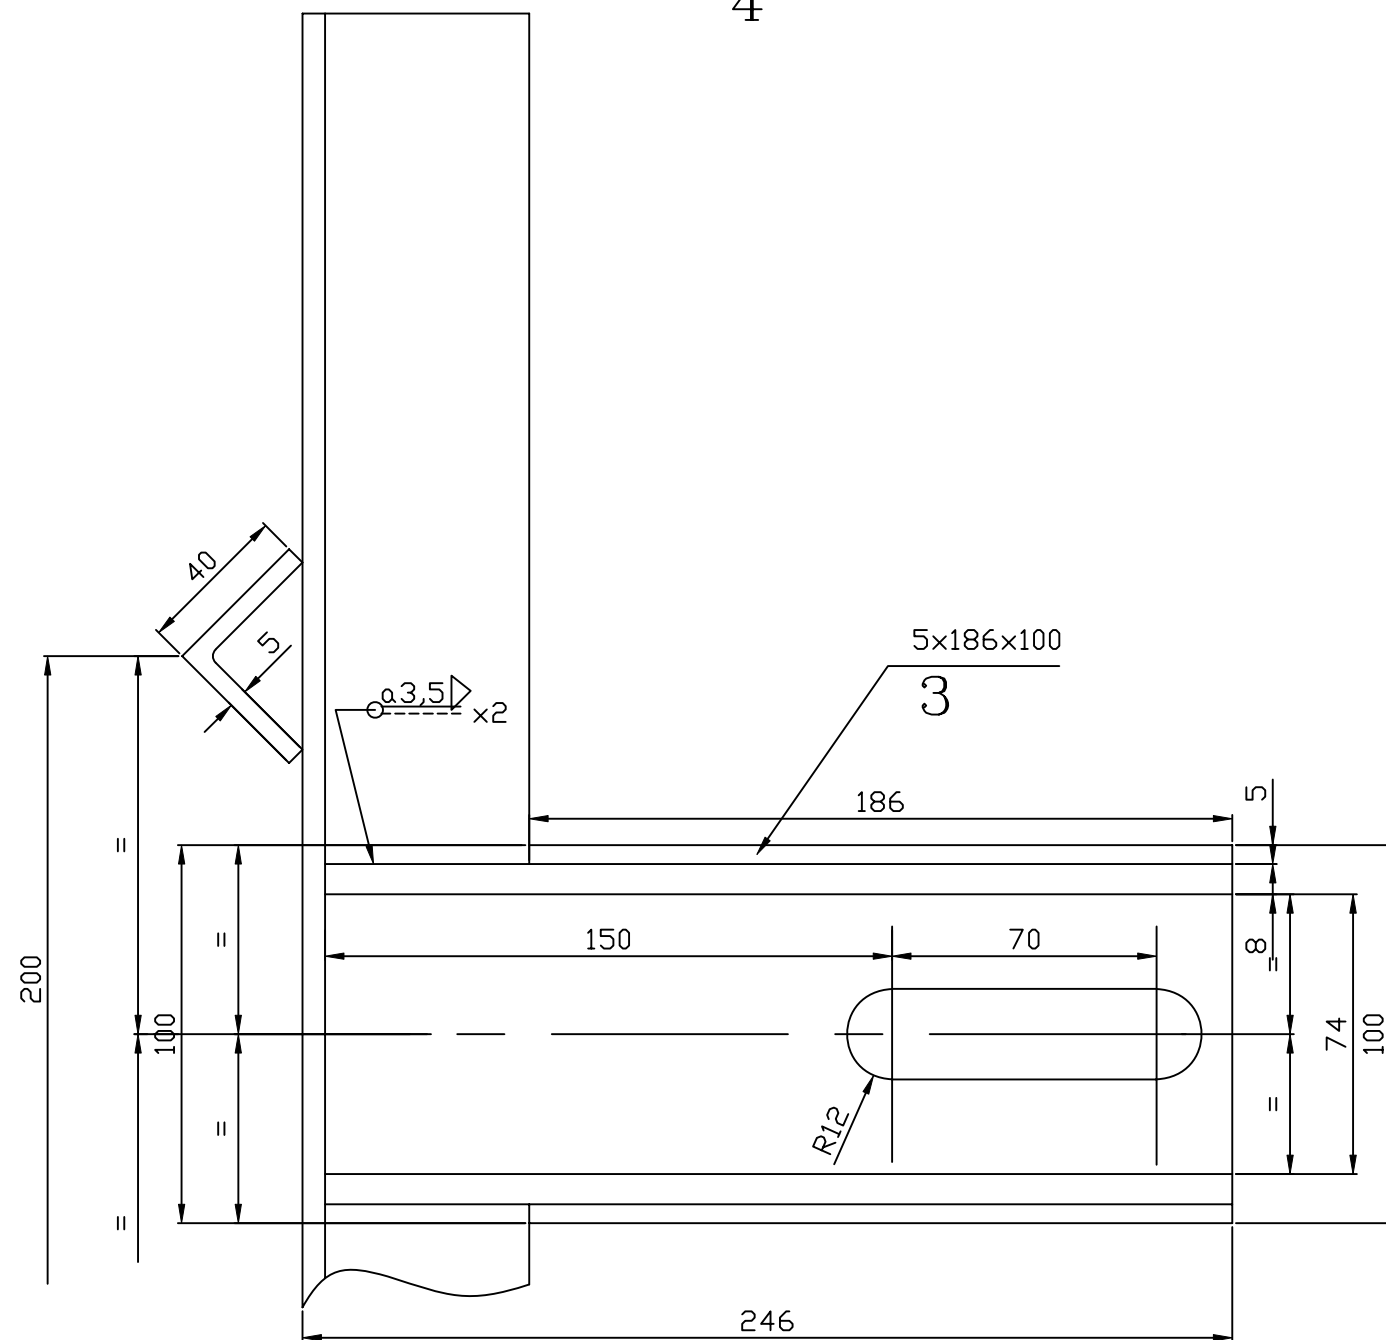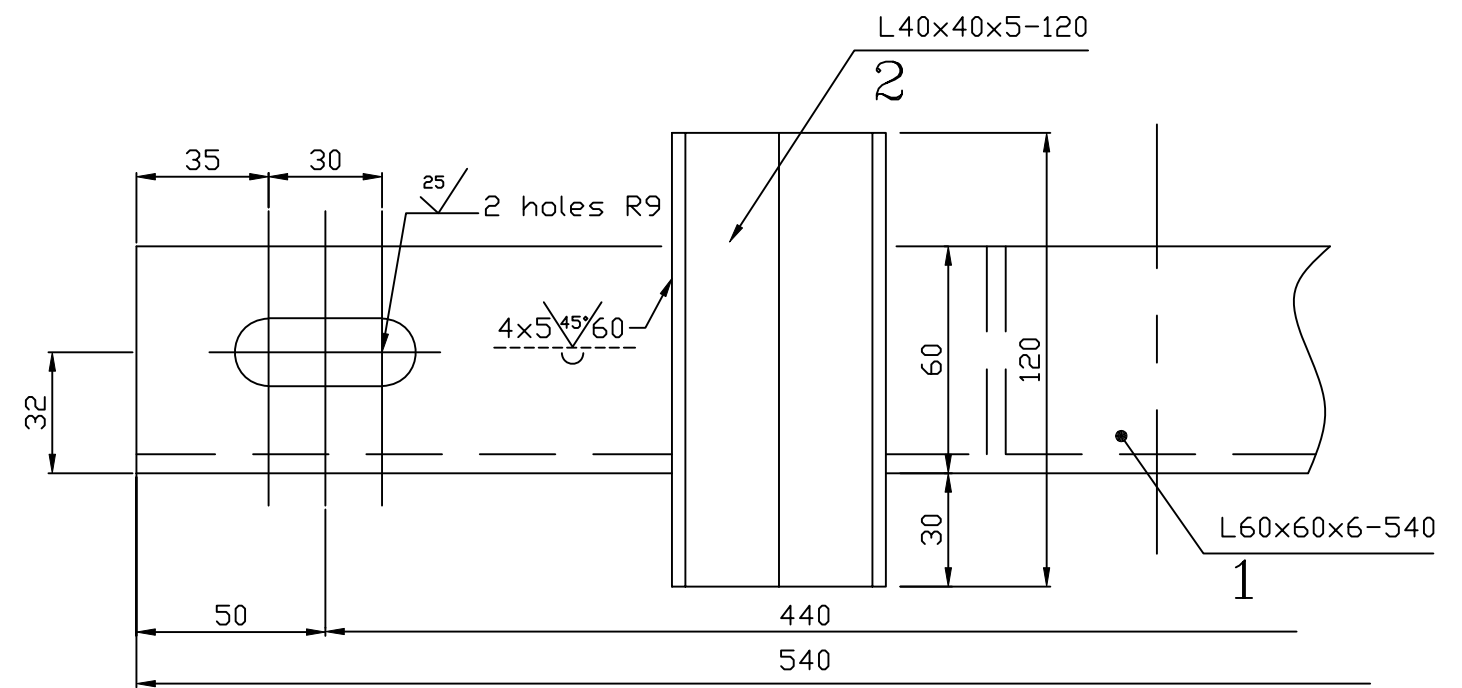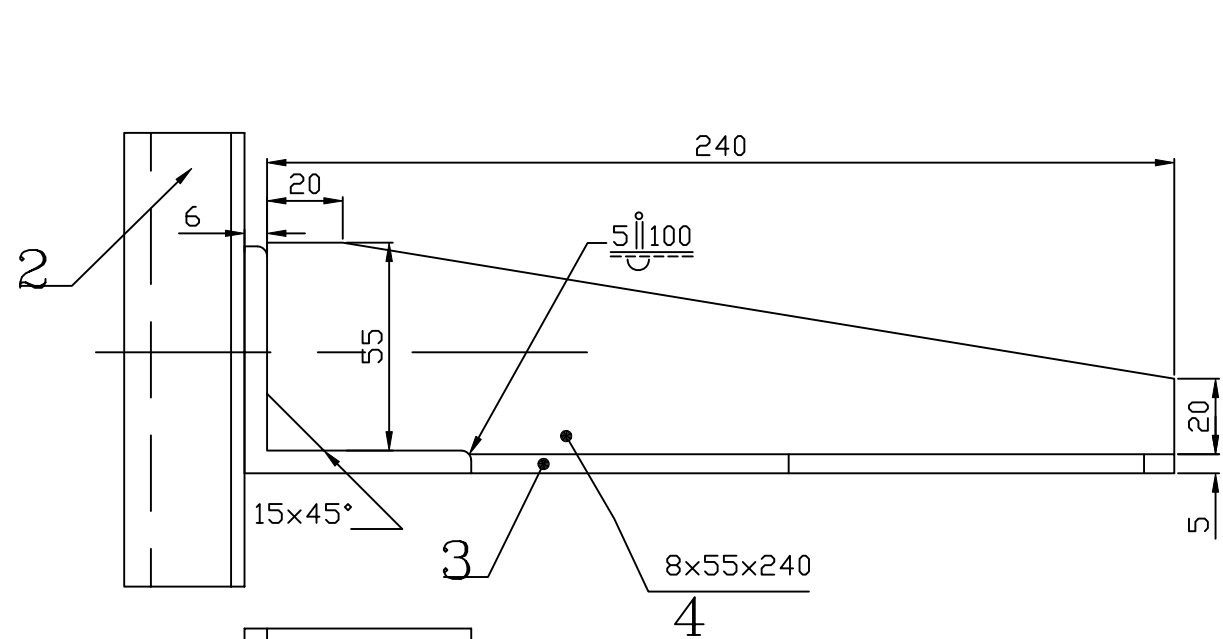


NOTE:

After welding and drilling will be hot galvanized AT/OL/Zn500-STAS 7221-90.

ITEM	DESIGNATION	UNIT	MATERIAL TECHNICAL SPECIFICATION
4	RIB	2	S235JR
3	ADDITION	1	S235JR
2	PROFILE	2	S235JR
1	FRAME	1	S235JR

PROFIL I FRAME I	Numele fisierului/ CAD file name:	Scara/ Scale:	Part	Rev.
	01LC00BDG196		1 / 1	0

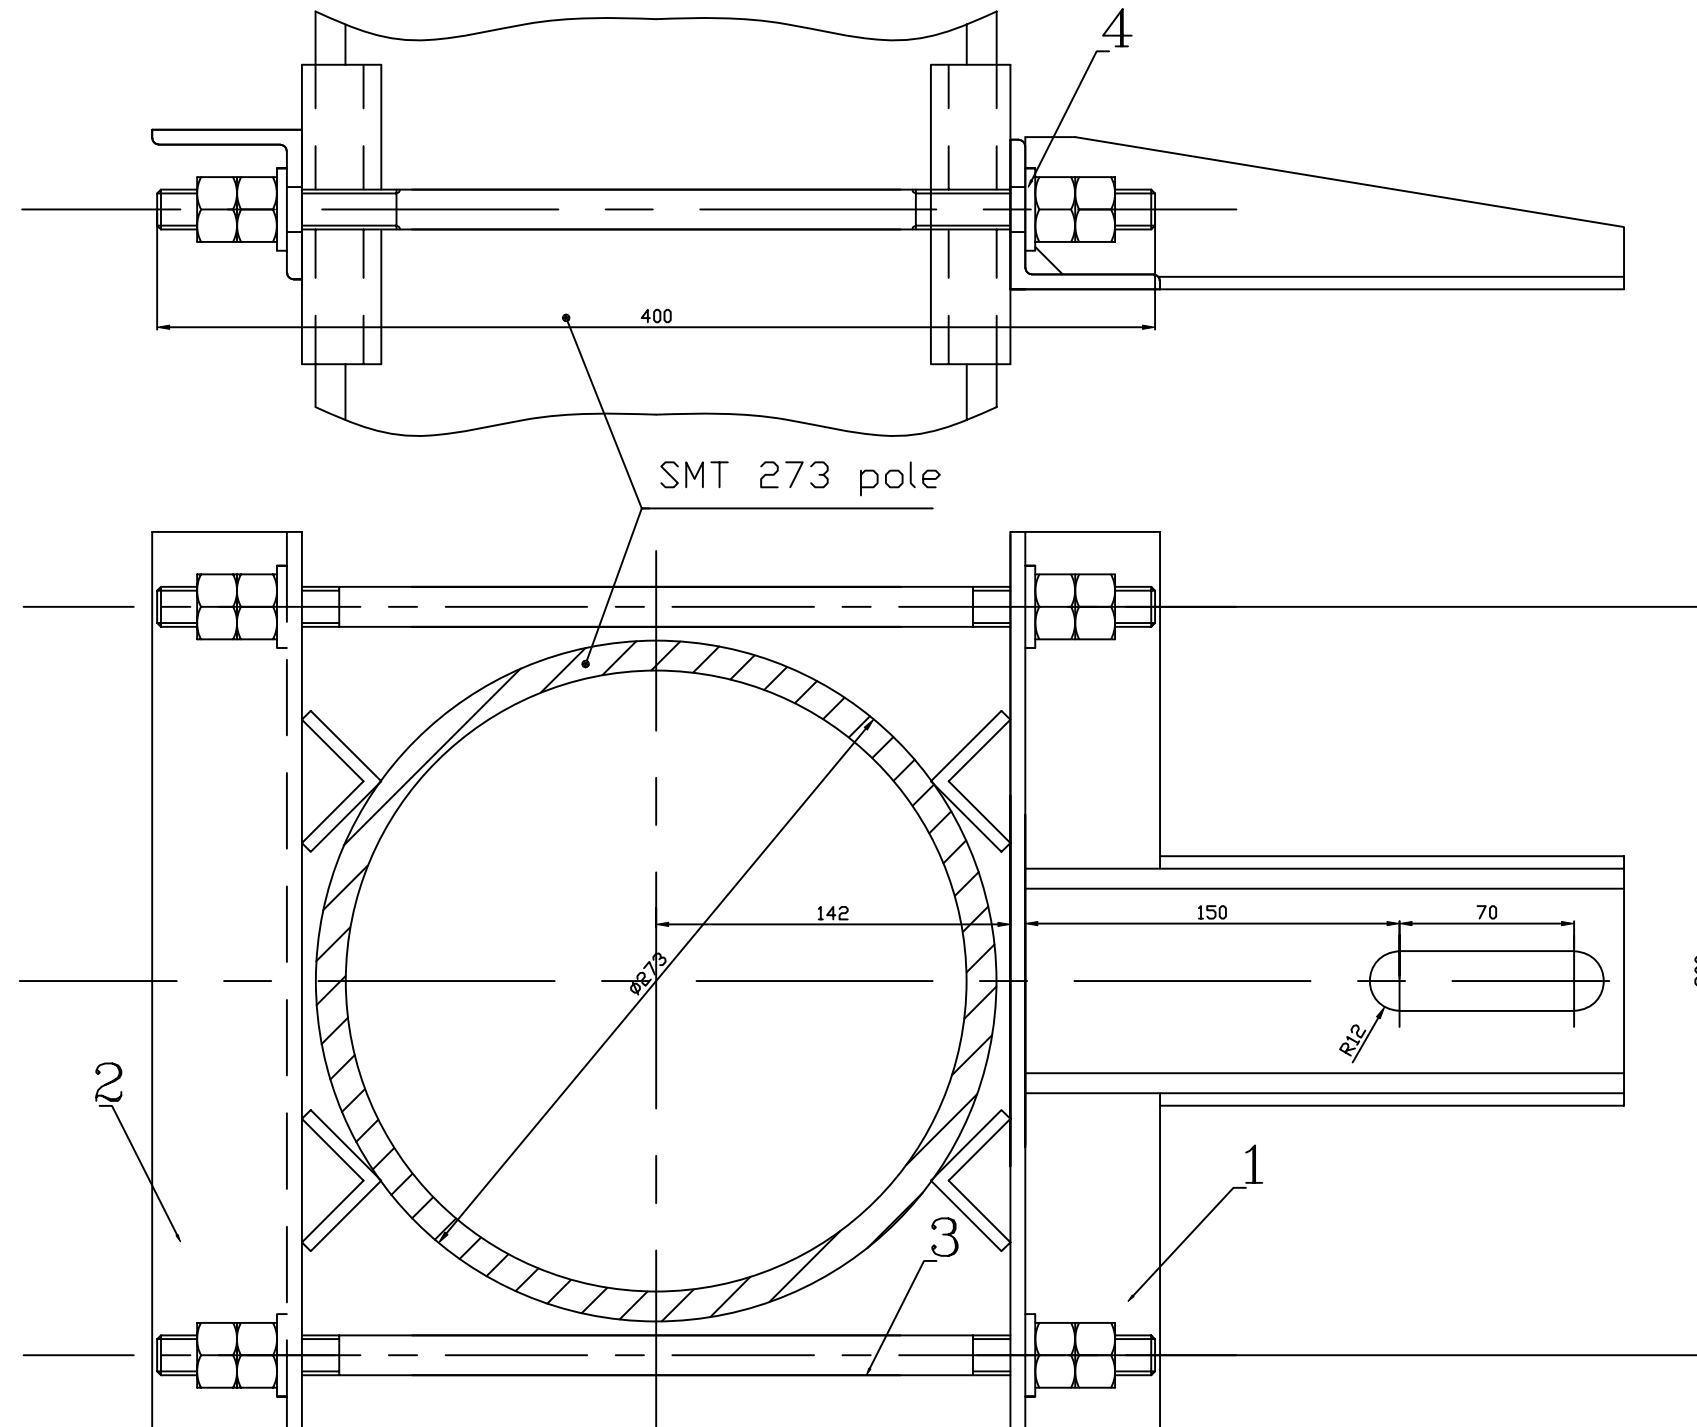

4	WASHER	4	01LC00BDG142	16A21
3	THREADED ROD	2	01LC00BDG141	1611D2
2	FRAME II	1	01LC00BDG171	
1	FRAME I	1	01LC00BDG198	
ITEM	DESIGNATION	UNIT	REFERENCE DRAWING	MARK




FIXARE INFERIOARA PENTRU STALP SMT
INFERIOR FASTENING ON SMT POLE

Numele fisierului/
CAD file name:
01LC00BDG197

Scara/
Scale:

Part
1 / 1

Rev.
0

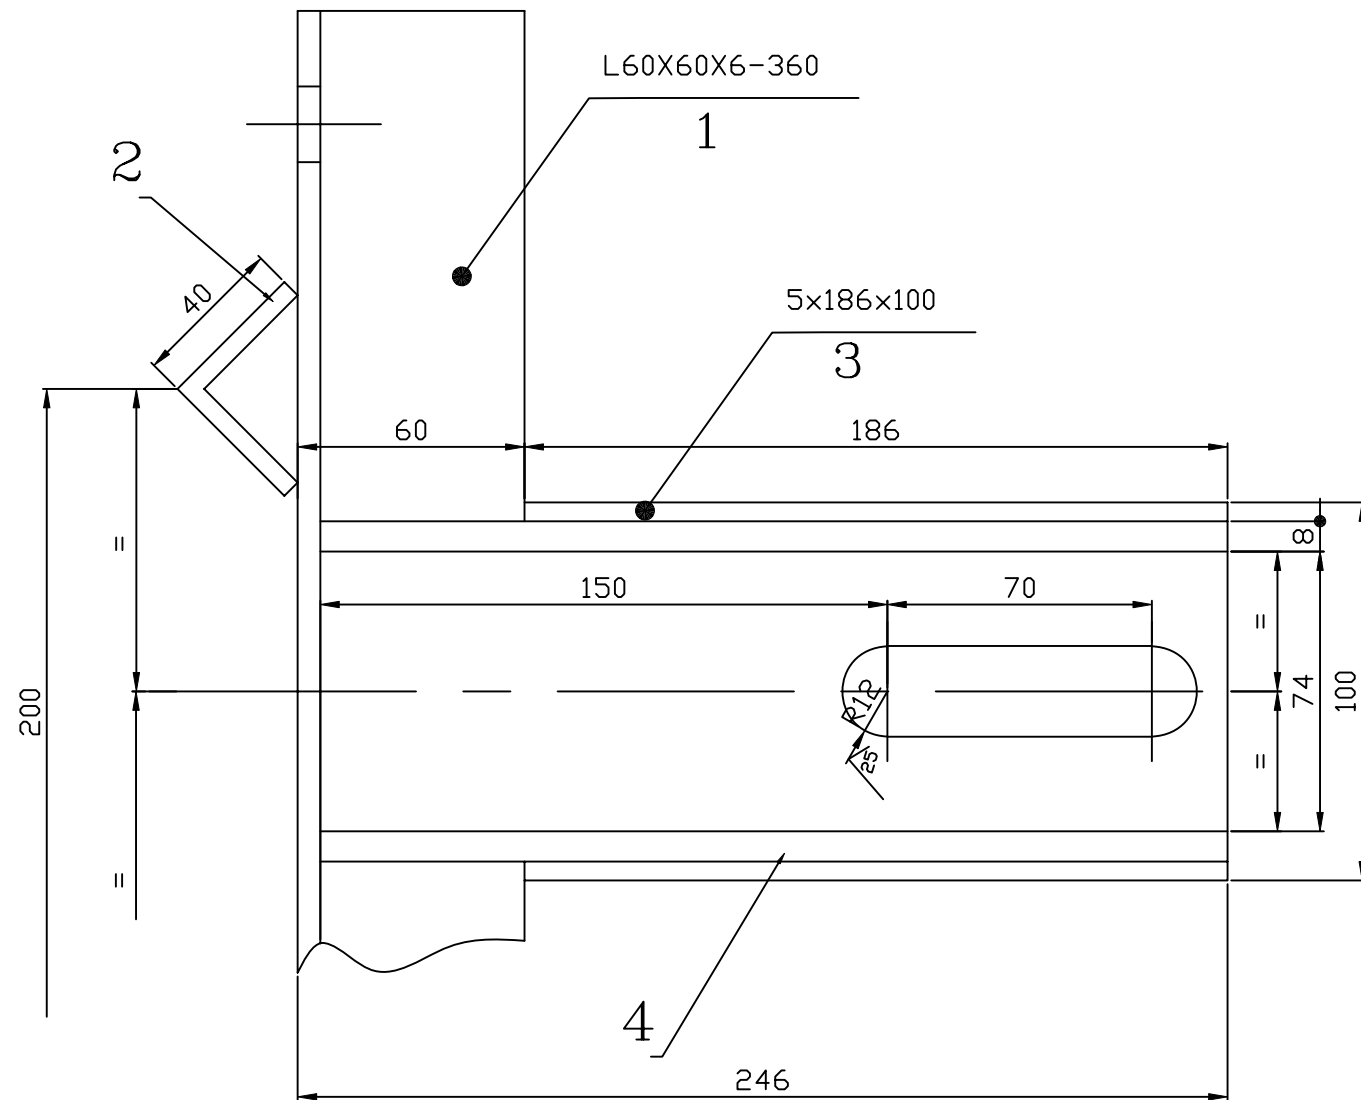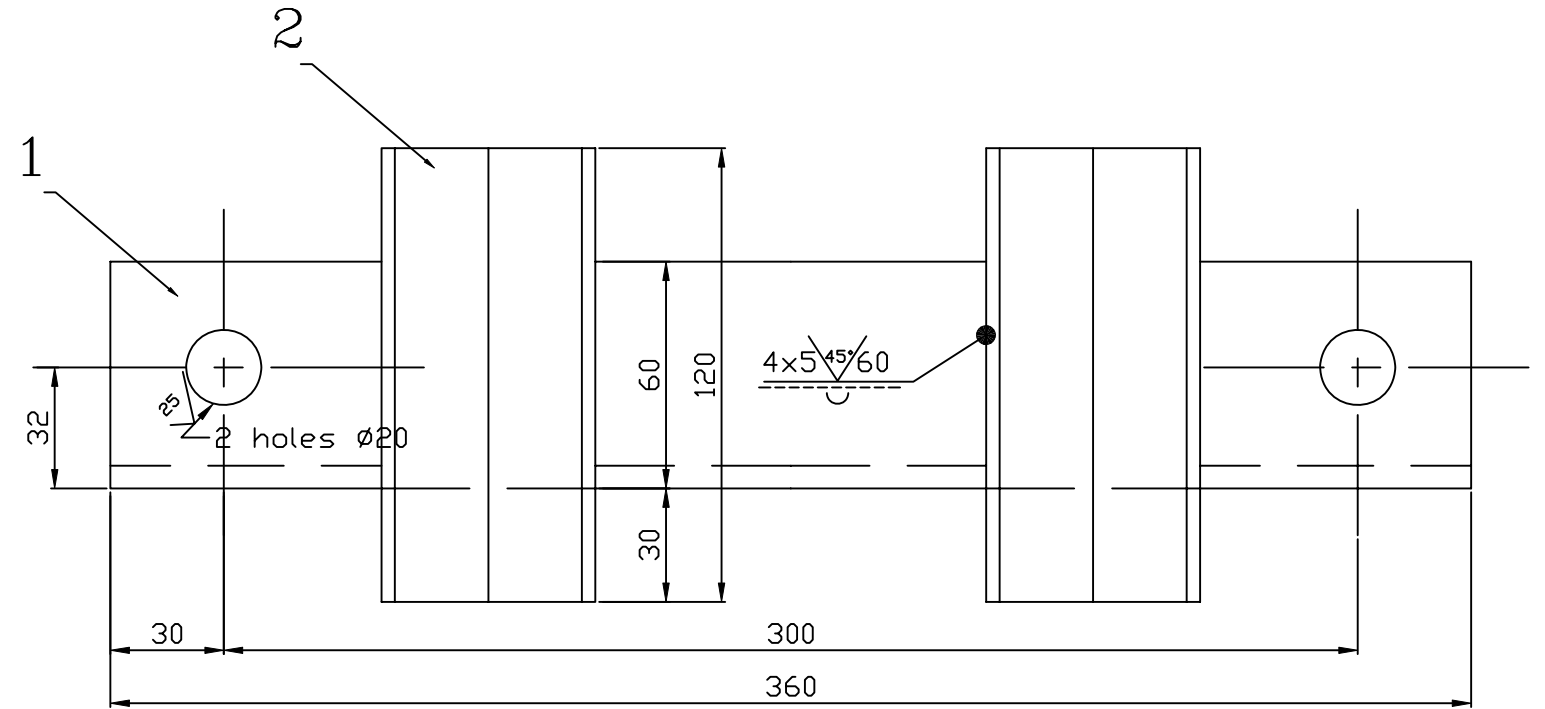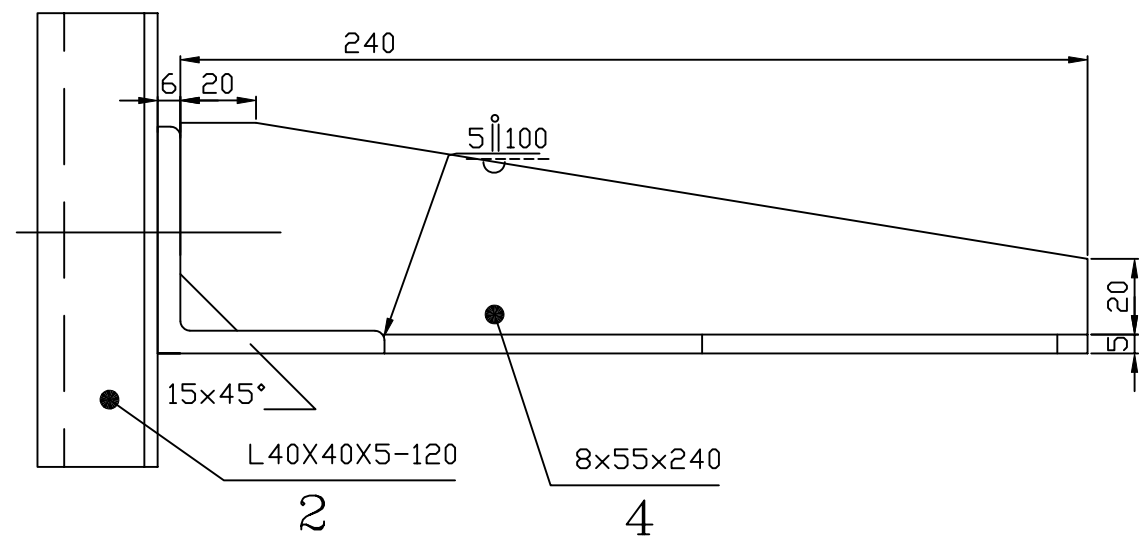

NOTE:
After welding and drilling will be hot galvanized AT/OL/Zn500-STAS 7221-90.

4	RIB	2	S235JR
3	ADDITION	1	S235JR
2	PROFILE	2	S235JR
1	SINGLE-BANK EAR	1	S235JR
ITEM	DESIGNATION	UNIT	MATERIAL TECHNICAL SPECIFICATION

PROFIL I
FRAME I


Numele fisierului/
CAD file name:
01LC00BDG198

Scara/
Scale:


Part
1 / 1

Rev.
0

NEUTRAL SECTION

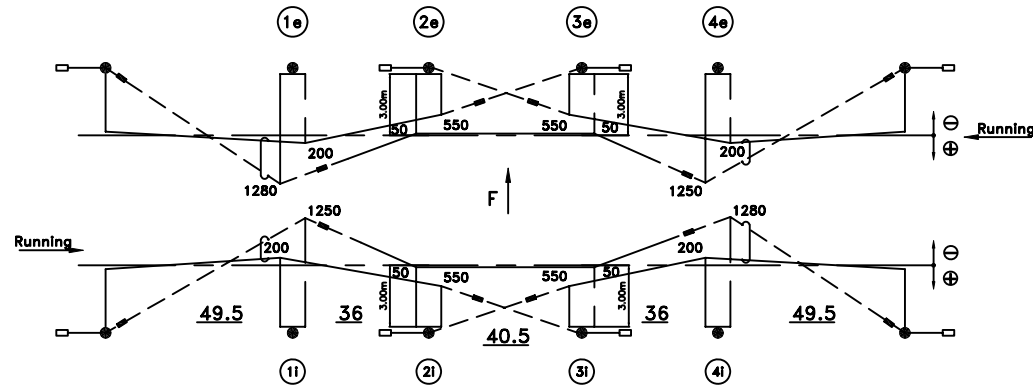


VIEW F

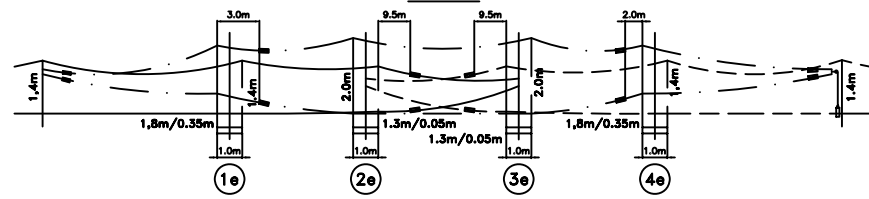


NOTE: JUMPERS OMITTED FOR CLARITY


high speed (aluminium cantilever)
CANTILEVERS ARRANGEMENT

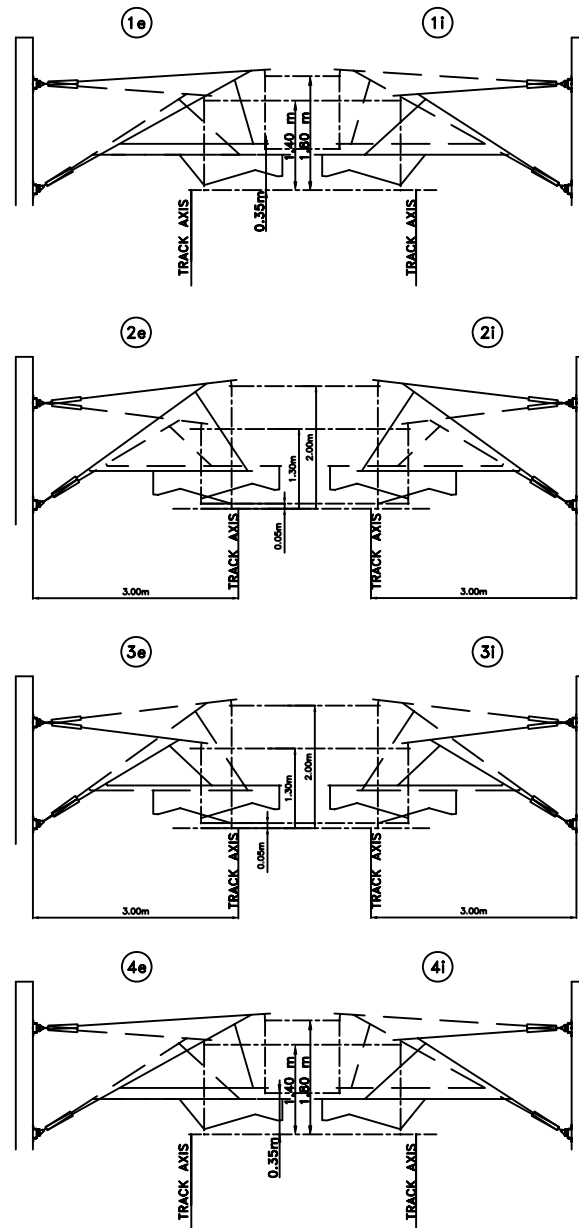

reduced speed (steel steady arm - DCM+Vvari)
CANTILEVERS ARRANGEMENT


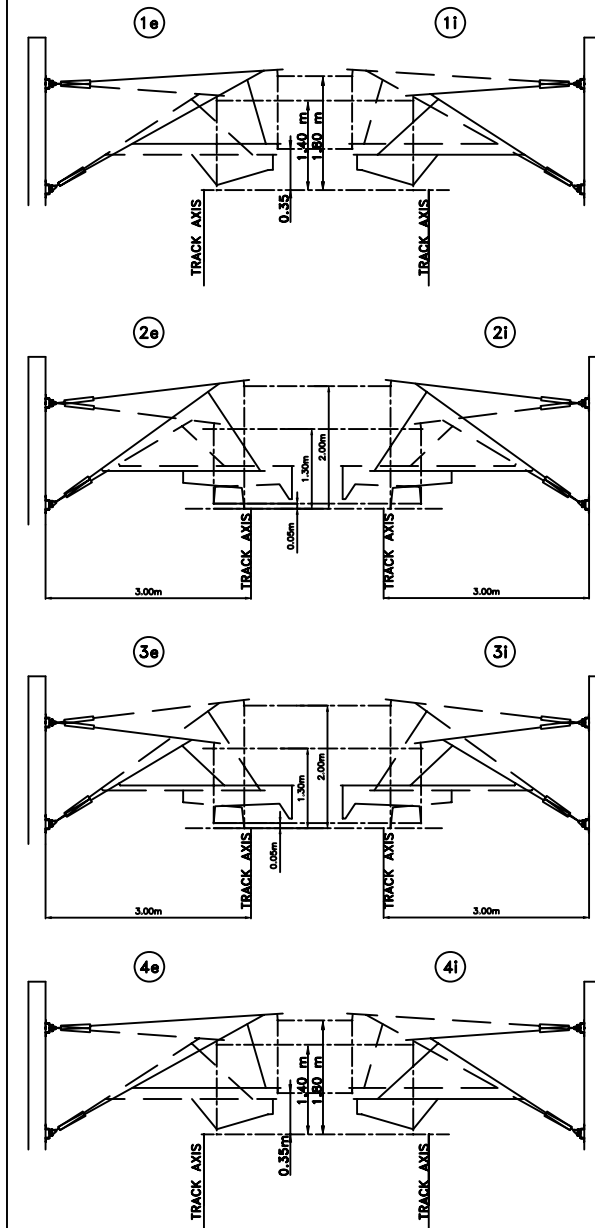


reduced speed (steel steady arm - DCM+ICM)
CANTILEVERS ARRANGEMENT

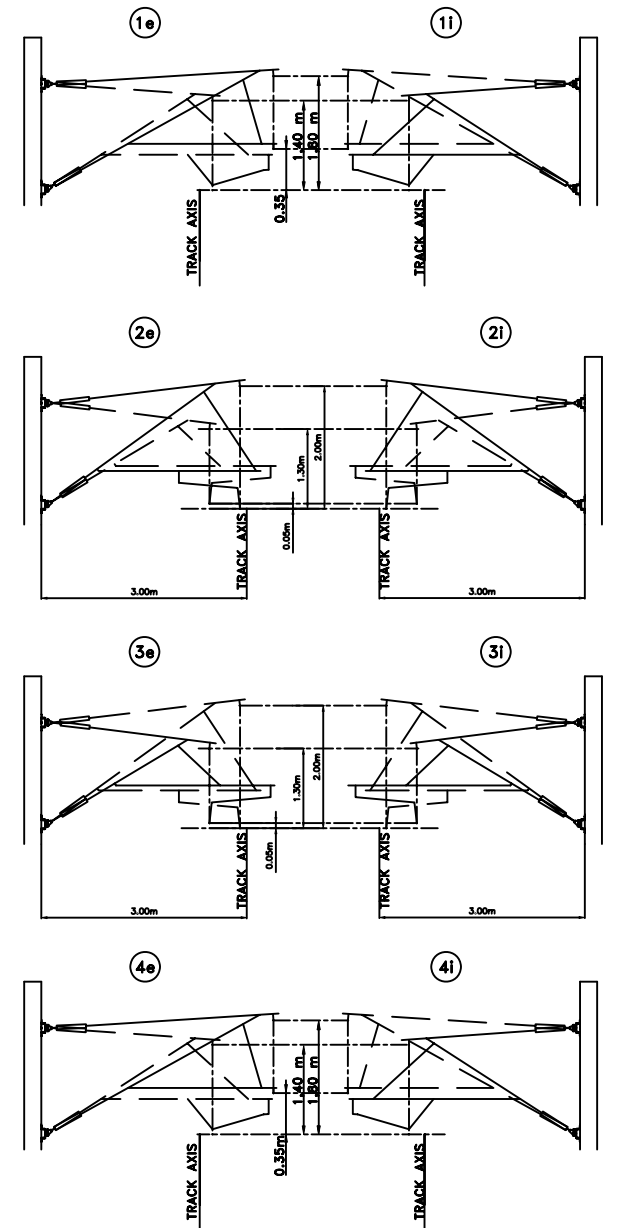

ZONA NEUTRA
NEUTRAL SECTION

Numele fisierului/ CAD file name:	Scara/ Scale:	Part	Rev.
01LC00BDG199		1 / 1	0

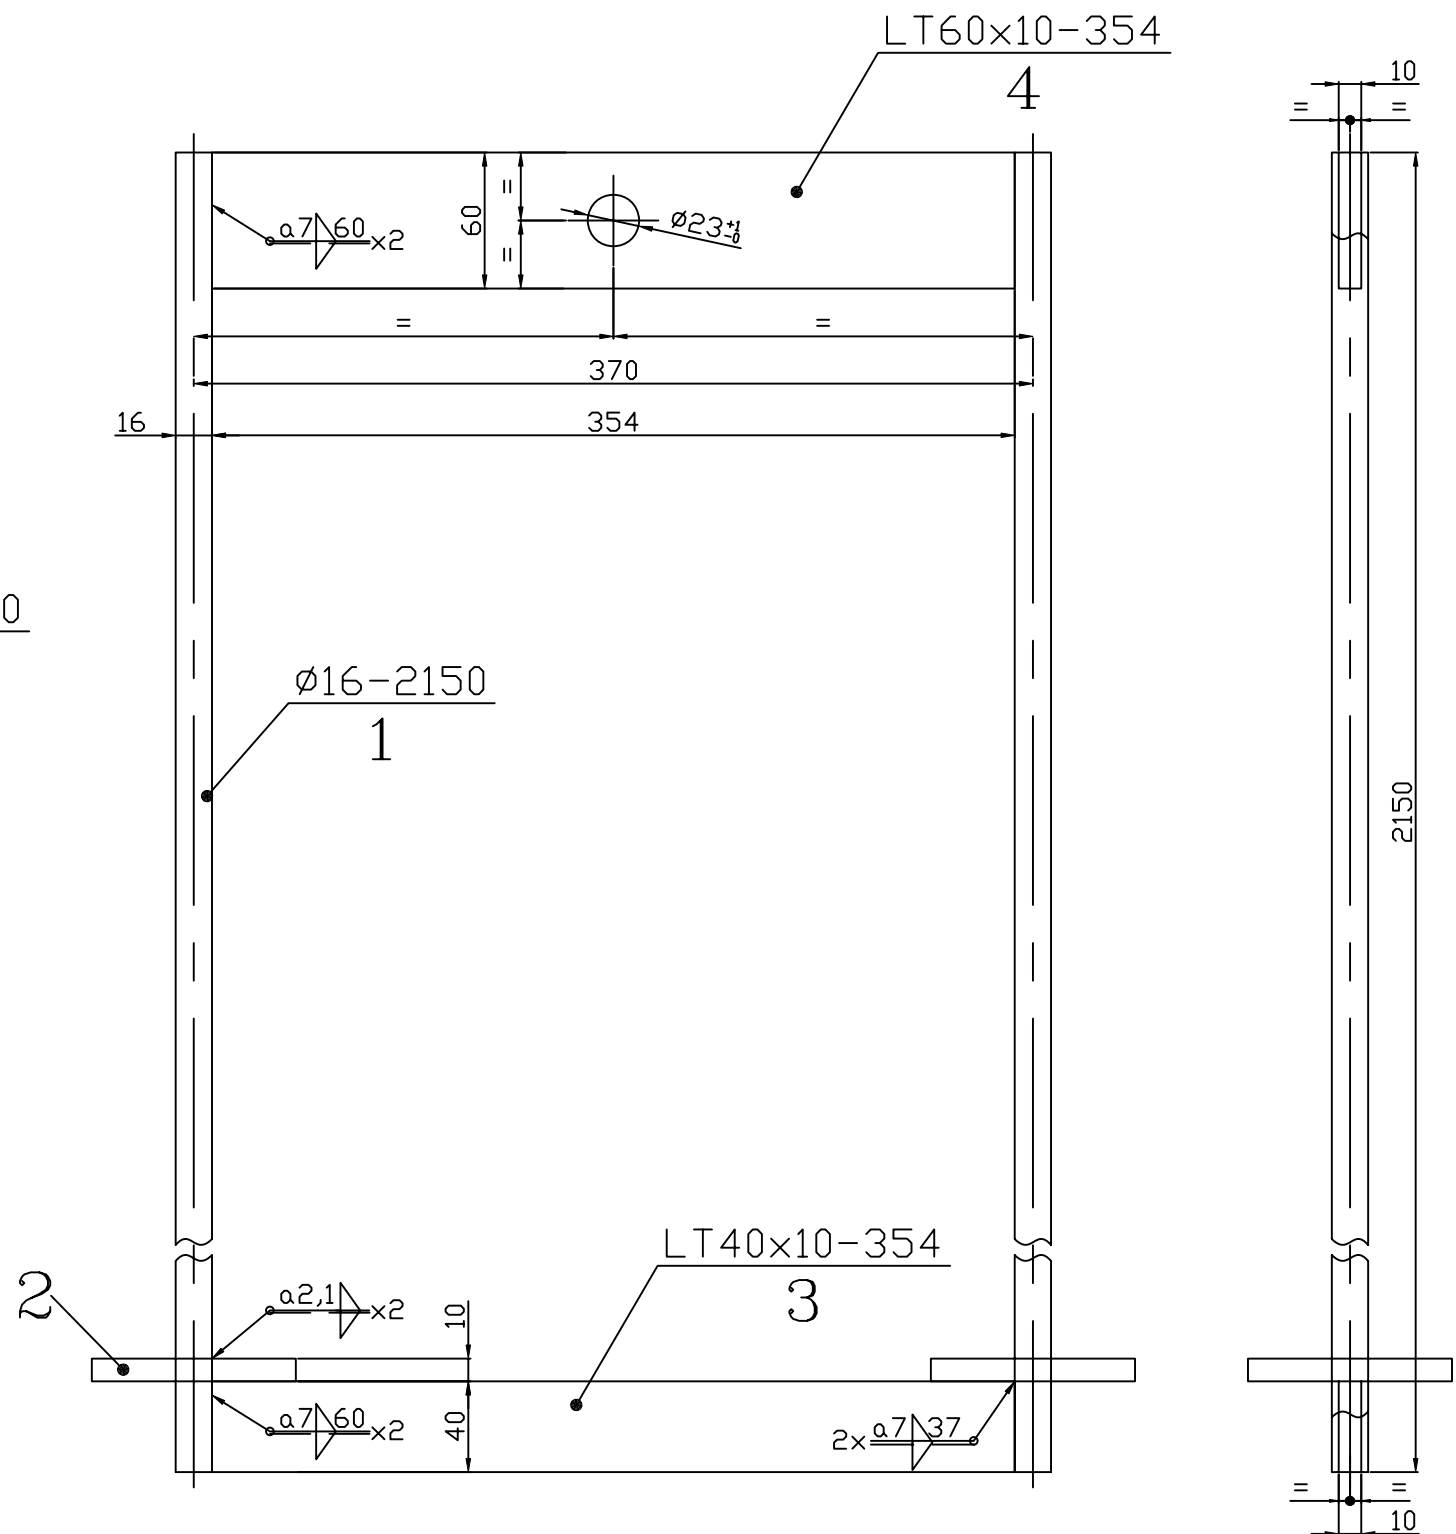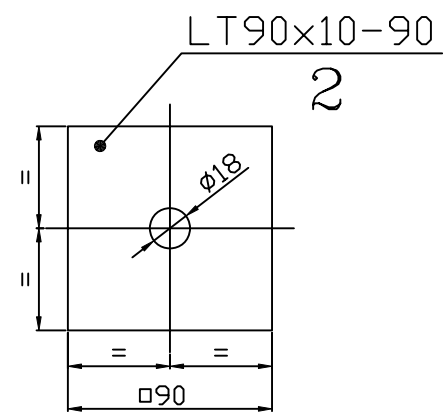

NOTE:
Will be hot galvanized AT/OL/Zn500-STAS 7221-90.

MARK GROUP	ITEM	DESIGNATION	UNIT MASS	MATERIAL TECHNICAL SPECIFICATION
1	4	UPPER BAR		S235JR
1	3	LOWER BAR		S235JR
2	2	PLATE		S235JR
2	1	ROD		S275JR


CADRU PENTRU CONTRAGREUTATI DIN BETON
CADRE FOR CONCRETE COUNTERWEIGHTS

Numele fisierului/
CAD file name:
01LC00BDG201

Scara/
Scale:

Part
1 / 1

Rev.
0

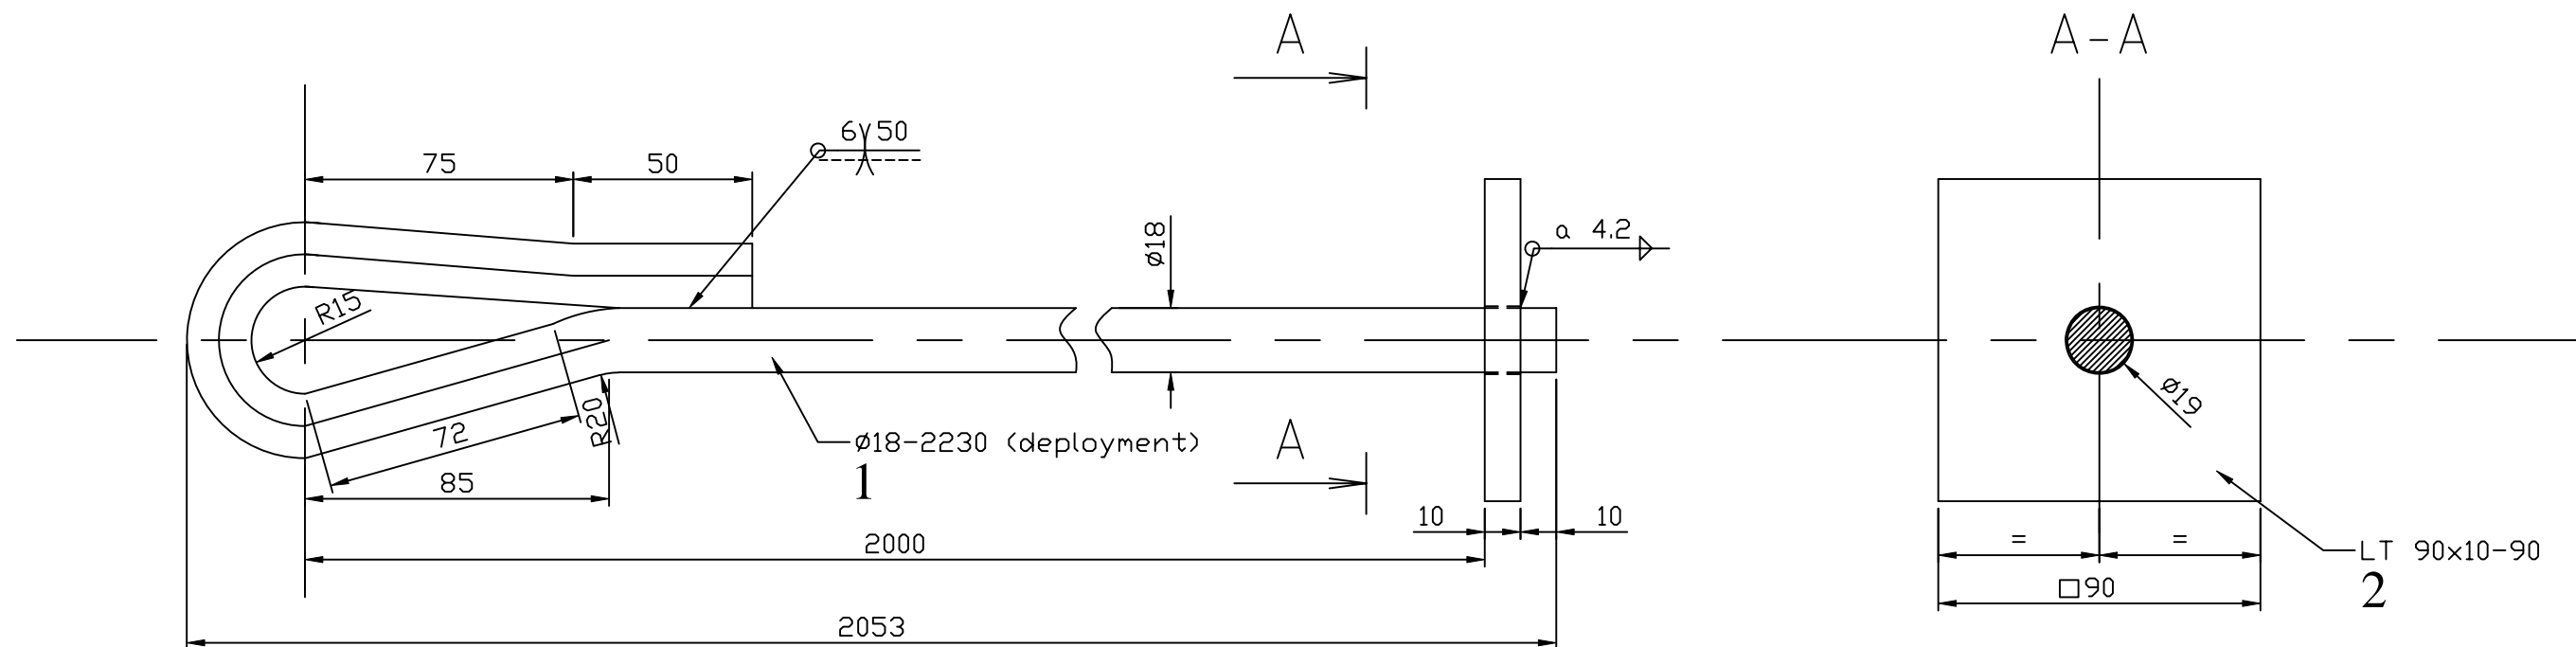




NOTE:

Will be hot galvanized AT/OL/Zn500-STAS 7221-90.

ITEM	DESIGNATION	UNIT	MATERIAL TECHNICAL SPECIFICATION
2	PLATE	1	S235JR
1	ROD WITH EYE	1	S275JR

BARA PENTRU CONTRAGREUTATI DIN FONTA ROD FOR CAST IRON COUNTERWEIGHTS	Numele fisierului/ CAD file name:	Scara/ Scale:	Part	Rev.
	01LC00BDG202		1 / 1	0

CONTINUOUS BEAD WATERPROOF WELDS MINIMUM THICKNESS: 4mm
BETWEEN SQUARE WASHER AND CONCRETE ROD

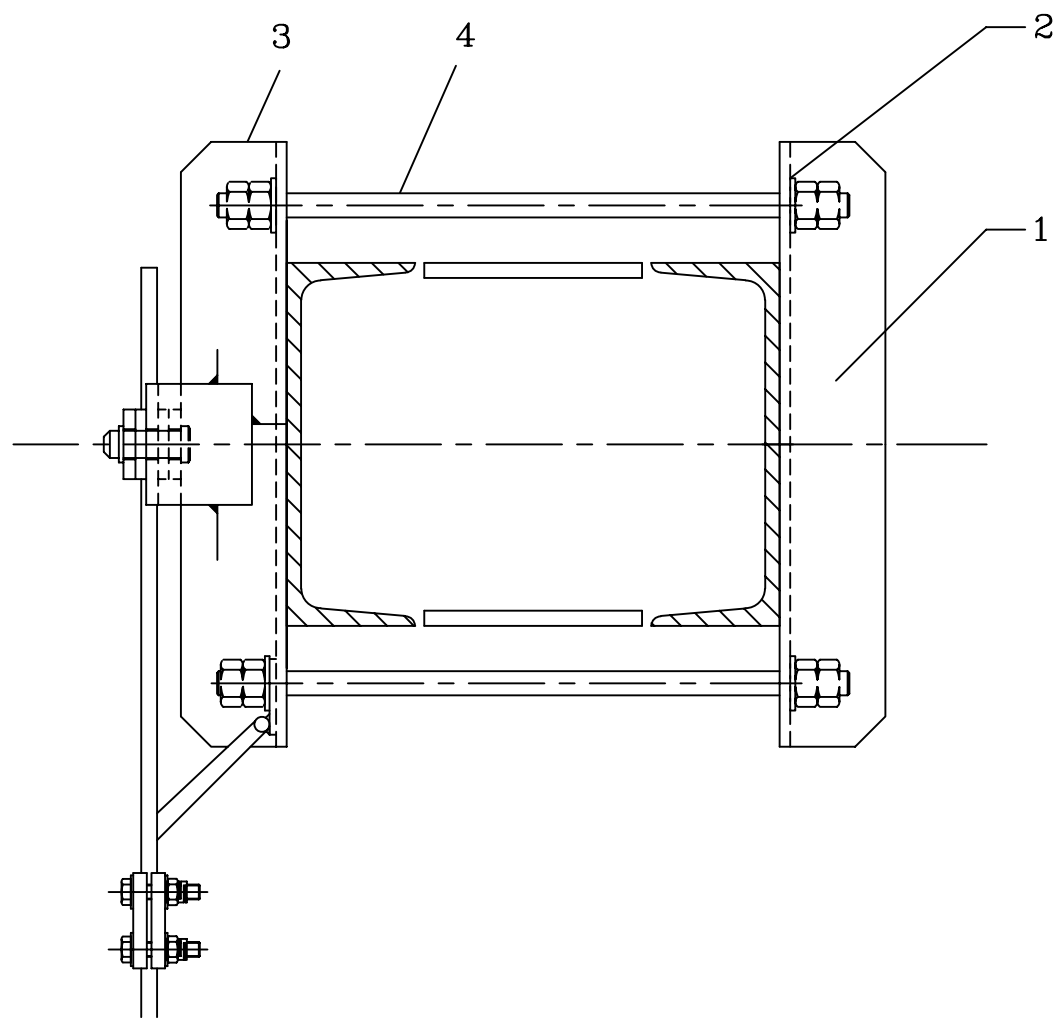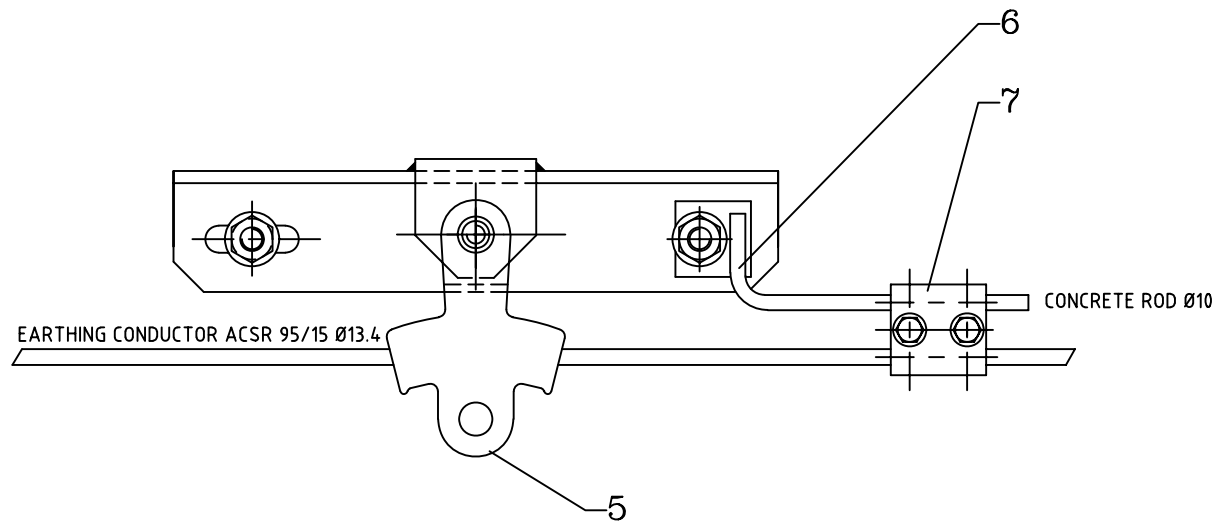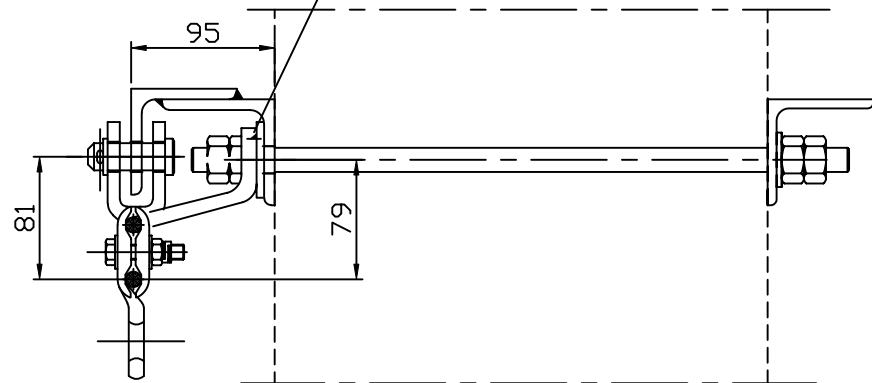

1	7	CLAMP	0.59	ELC 2-4.0	
1	6	EARTHING CONNECTION	0.25	01LC00BDG260	101
1	5	EARTHING CONDUCTOR SUSPEION TYPE I	1.30	ELC 13-1.4.0	
2	4	THREADED ROD M16- 500/100		01LC00BDG141	1611F2
1	3	COUNTERPLATE WITH EARTHING CONDUCTOR		01LC00BDG102	102
4	2	WASHER M16N		01LC00BDG142	161110
1	1	COUNTERPLATE		01LC00BDG090	102
QUANTITY	ITEM	DESIGNATION	UNIT MASS kg	REFERENCE DRAWING	MARK

FIXARE CABLUL COLECTOR PENTRU STALP MU
EARTHING CONDUCTOR FASTENING FOR MU POLES

Numele fisierului/
CAD file name:
01LC00BDG203


Scara/
Scale:

Part

Rev.


1 / 1

0

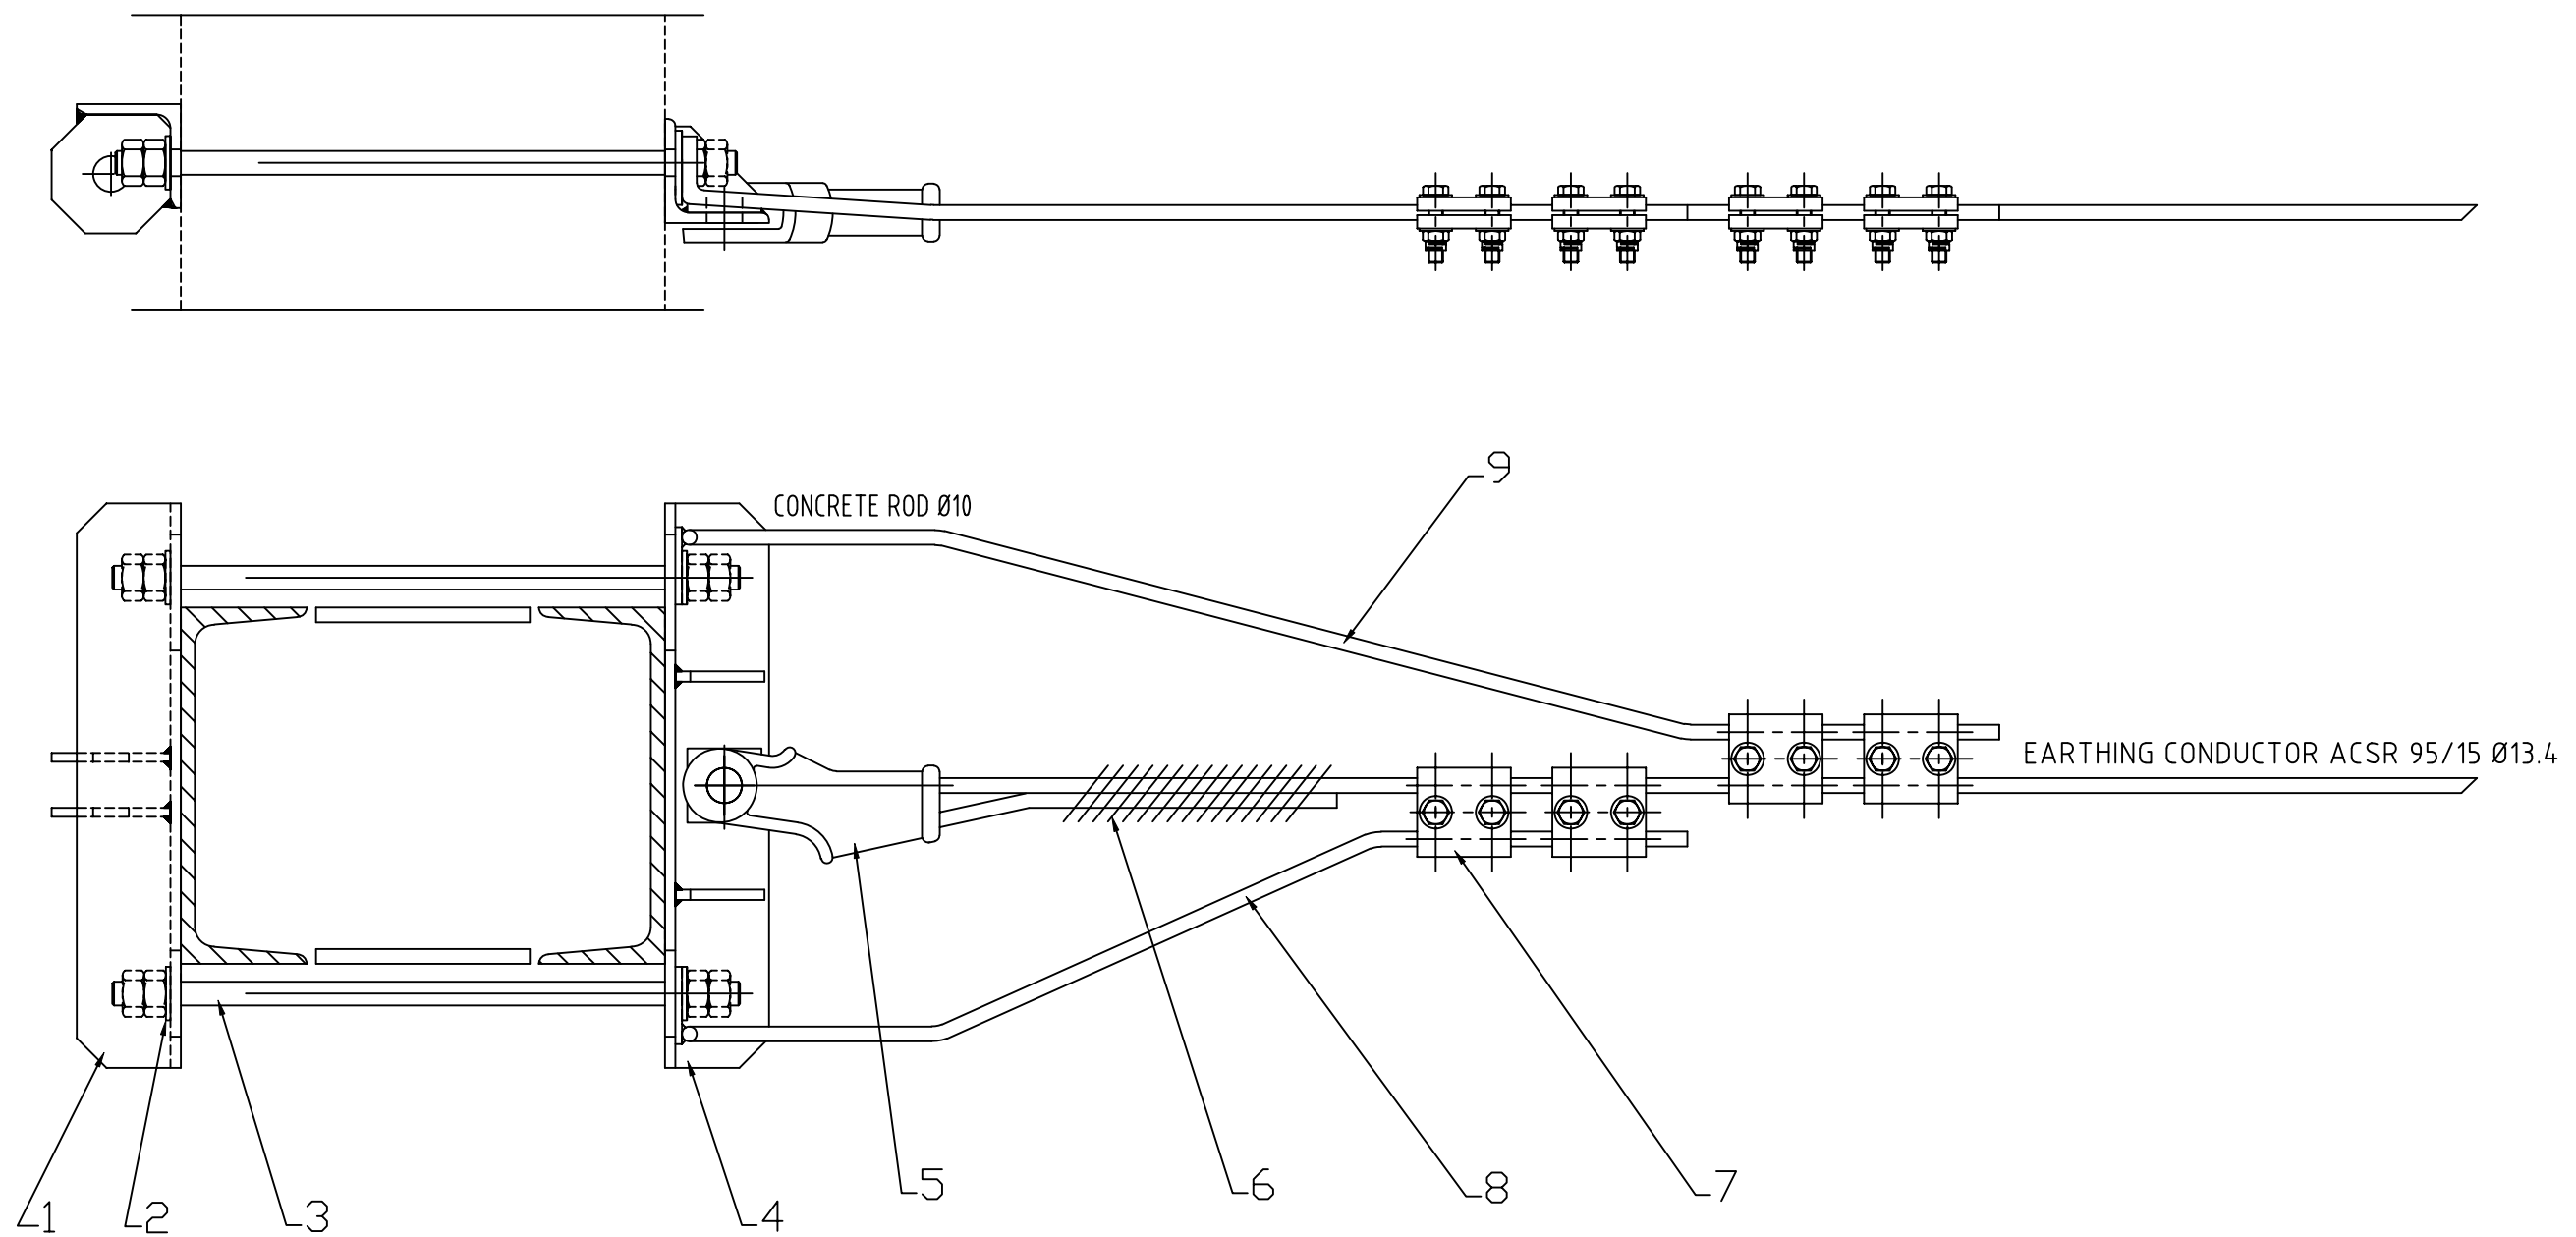

9	EARTHING CONNECTION L=900	1	01LC00BDG260	103
8	EARTHING CONNECTION L=700	1	01LC00BDG260	102
7	CLAMP	4	ELC 2-4.0	
6	IRON	1	STAS 434-73	
5	CLAMP	1	ELC 9-29-0	
4	ANGLE FOR EARTHING ANCHORING	1	01LC00BDG131	102
3	THREADED ROD M16- 500/100	2	01LC00BDG141	1611F2
2	WASHER M16	4	01LC00BDG142	16A110
1	COUNTERPLATE FOR EARTHING ANCHORING	1	01LC00BDG133	102
ITEM	DESIGNATION	QUANTITY	REFERENCE DRAWING	MARK

FIXARE PENTRU ANCORAREA CABLULUI COLECTOR PENTRU STALP MU FASTENING FOR ANCHORING OF EARTH CONDUCTOR FOR MU POLE	Numele fisierului/ CAD file name:	Scara/ Scale:	Part	Rev.
	01LC00BDG204		1 / 1	0

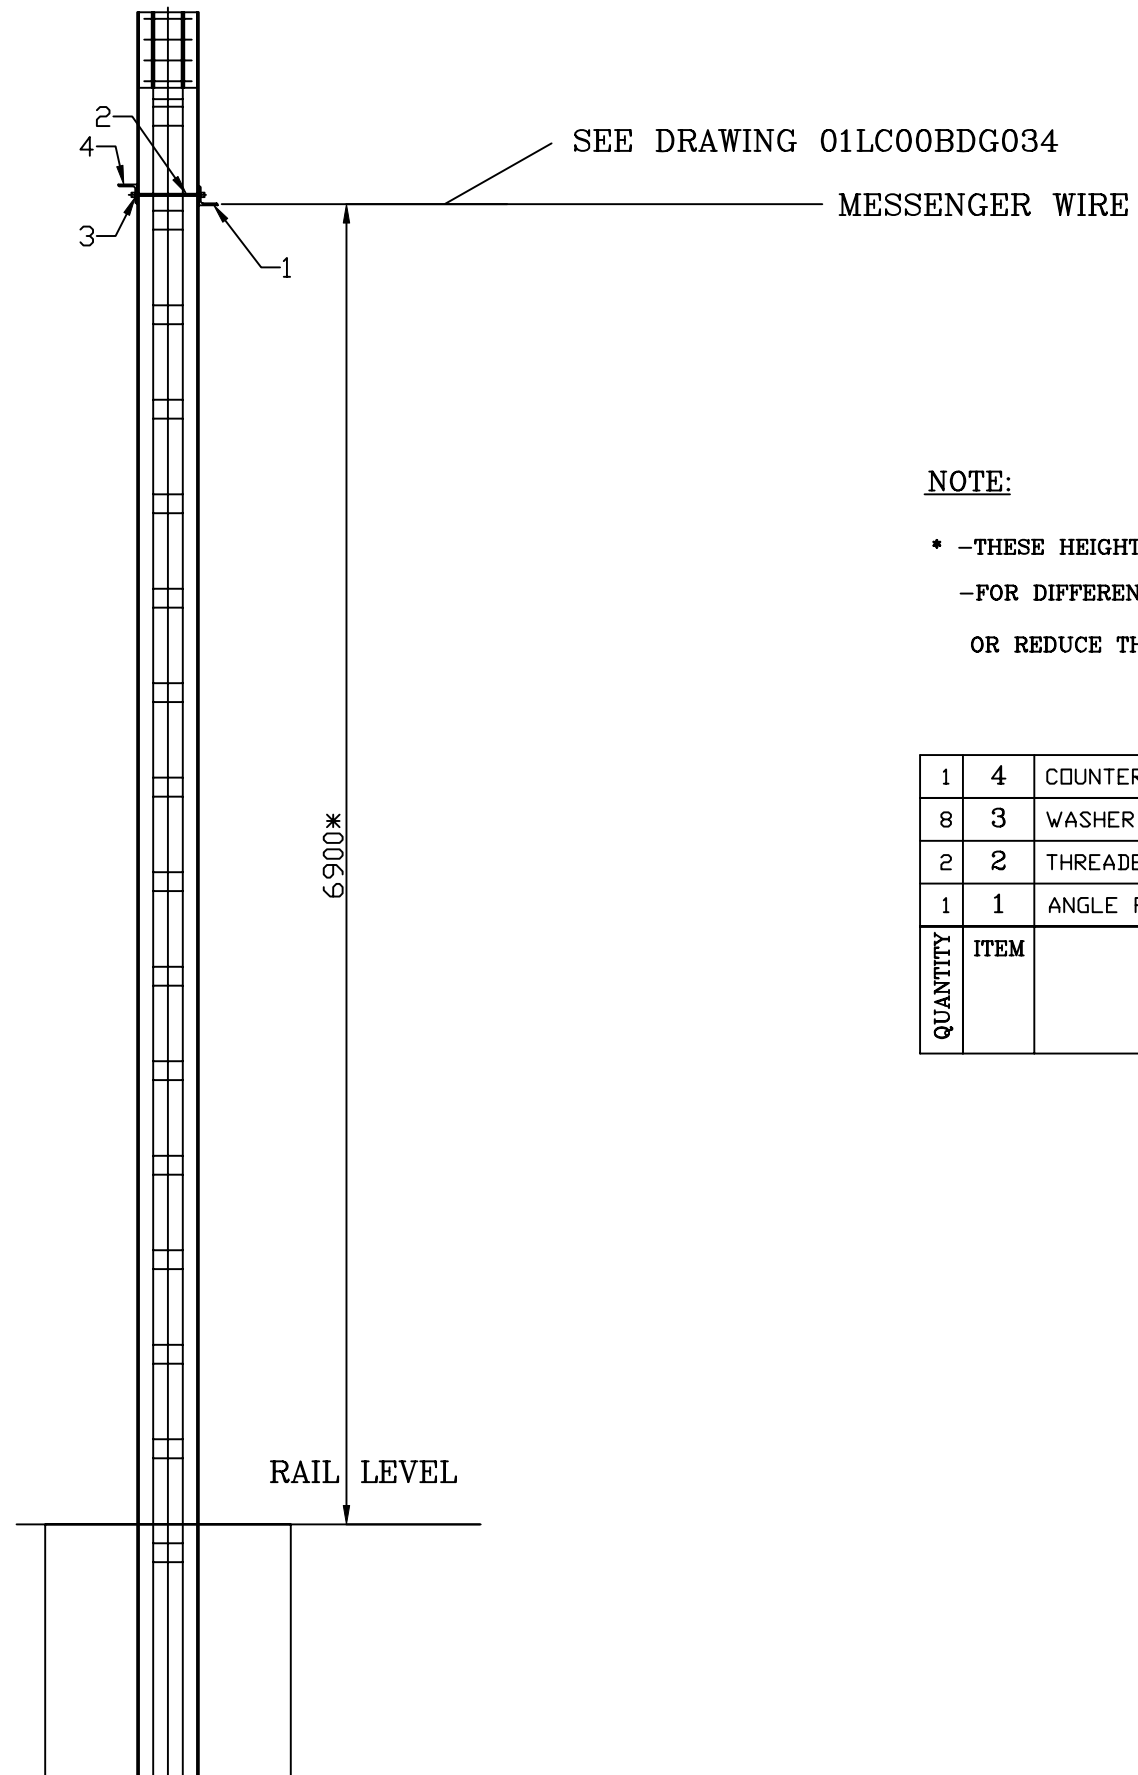

NOTE:

- * -THESE HEIGHTS ARE DEFINED FOR 5.75M CONTACT WIRE HEIGHT
- FOR DIFFERENT CONTACT WIRE HEIGHT, IT'S NECESSARY TO INCREASE
- OR REDUCE THESE VALUES WITH THE SAME DIFFERENCES

1	4	COUNTERPLATE		01LC00BDG129	101
8	3	WASHER		01LC00BDG142	20A110
2	2	THREADED ROD		01LC00BDG141	2041F2
1	1	ANGLE FOR RIGID ANCHORING		01LC00BDG206	
QUANTITY	ITEM	DESIGNATION	UNIT	REFERENCE DRAWING	MARK

ANCORARE MEDIANA PENTRU STALP MU
MID POINT ANCHORING ON MU POLES

Numele fisierului/
CAD file name:
01LC00BDG205


Scara/
Scale:

Part

Rev.



1 / 1

0

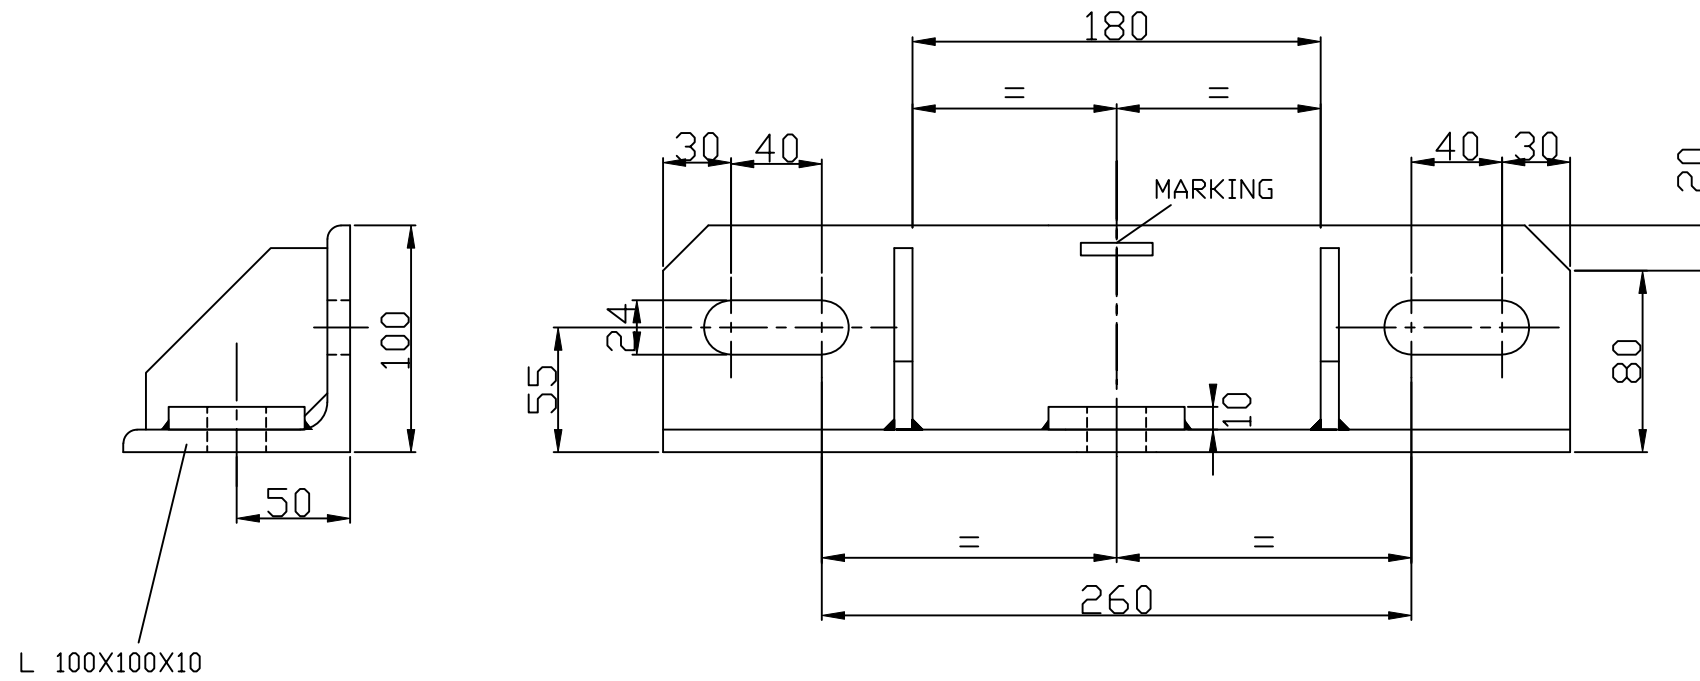

L 100X100X10

GUSSET

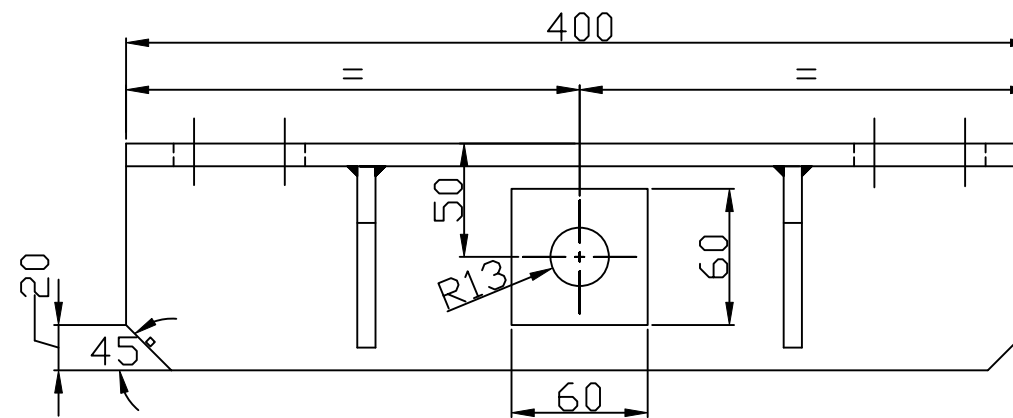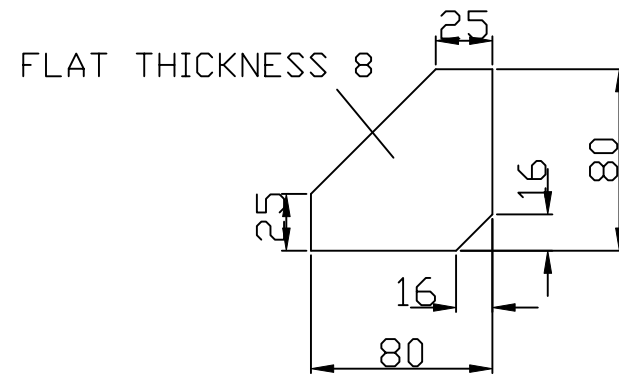


NOTE:

Continuous bead waterproof welds minimum thickness: 3mm

Material: S235JR

After welding and drilling will be hot galvanized AT/OL/Zn600-STAS 7221-90.

PROFIL PENTRU ANCORAREA RIGIDA PE STALP MU ANGLE FOR RIGID ANCHORING ON MU POLE	Numele fisierului/ CAD file name:	Scara/ Scale:	Part	Rev.
	01LC00BDG206		1 / 1	0

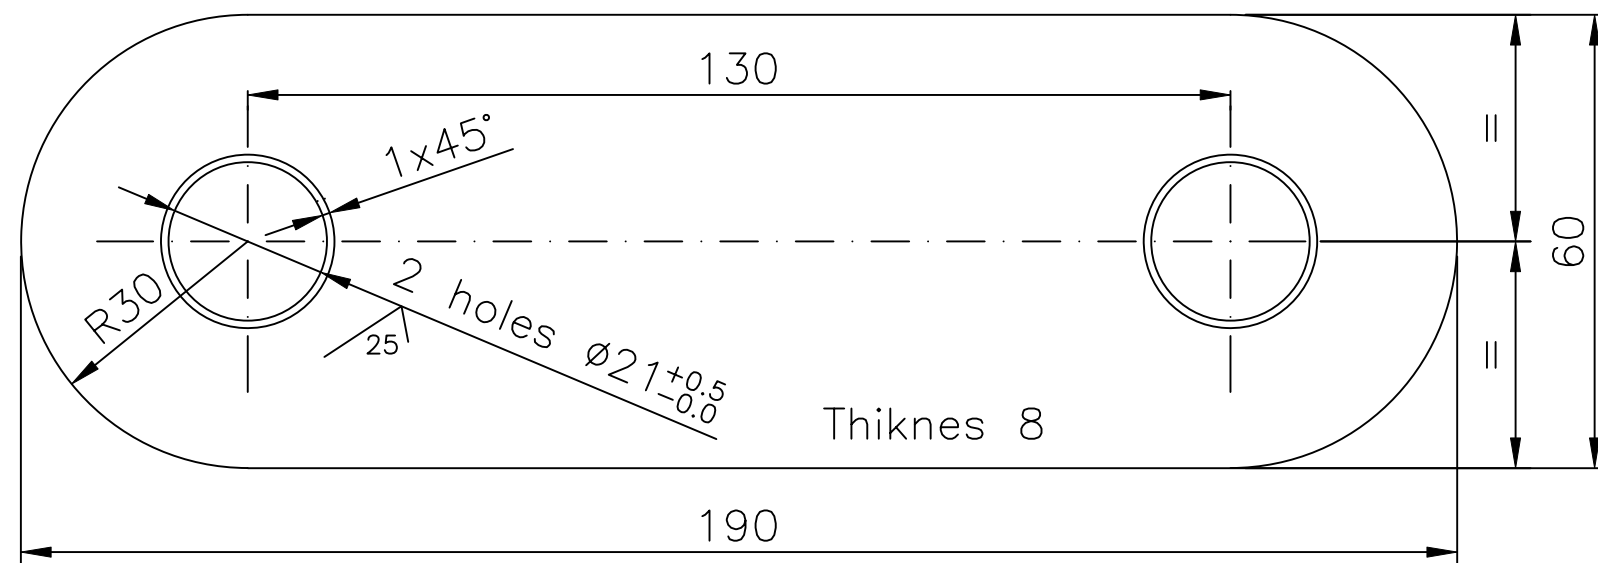


Note:

After drilling will be hot galvanised AL/OL/Zn500-STAS 7221-90

PLACA PLATE	Numele fisierului/ CAD file name:	Scara/ Scale:	Part	Rev.
	01LC00BDG209		1 / 1	0

FOR MOUNTING, SEE DRAWING TYPICAL CATENARY EQUIPMENT

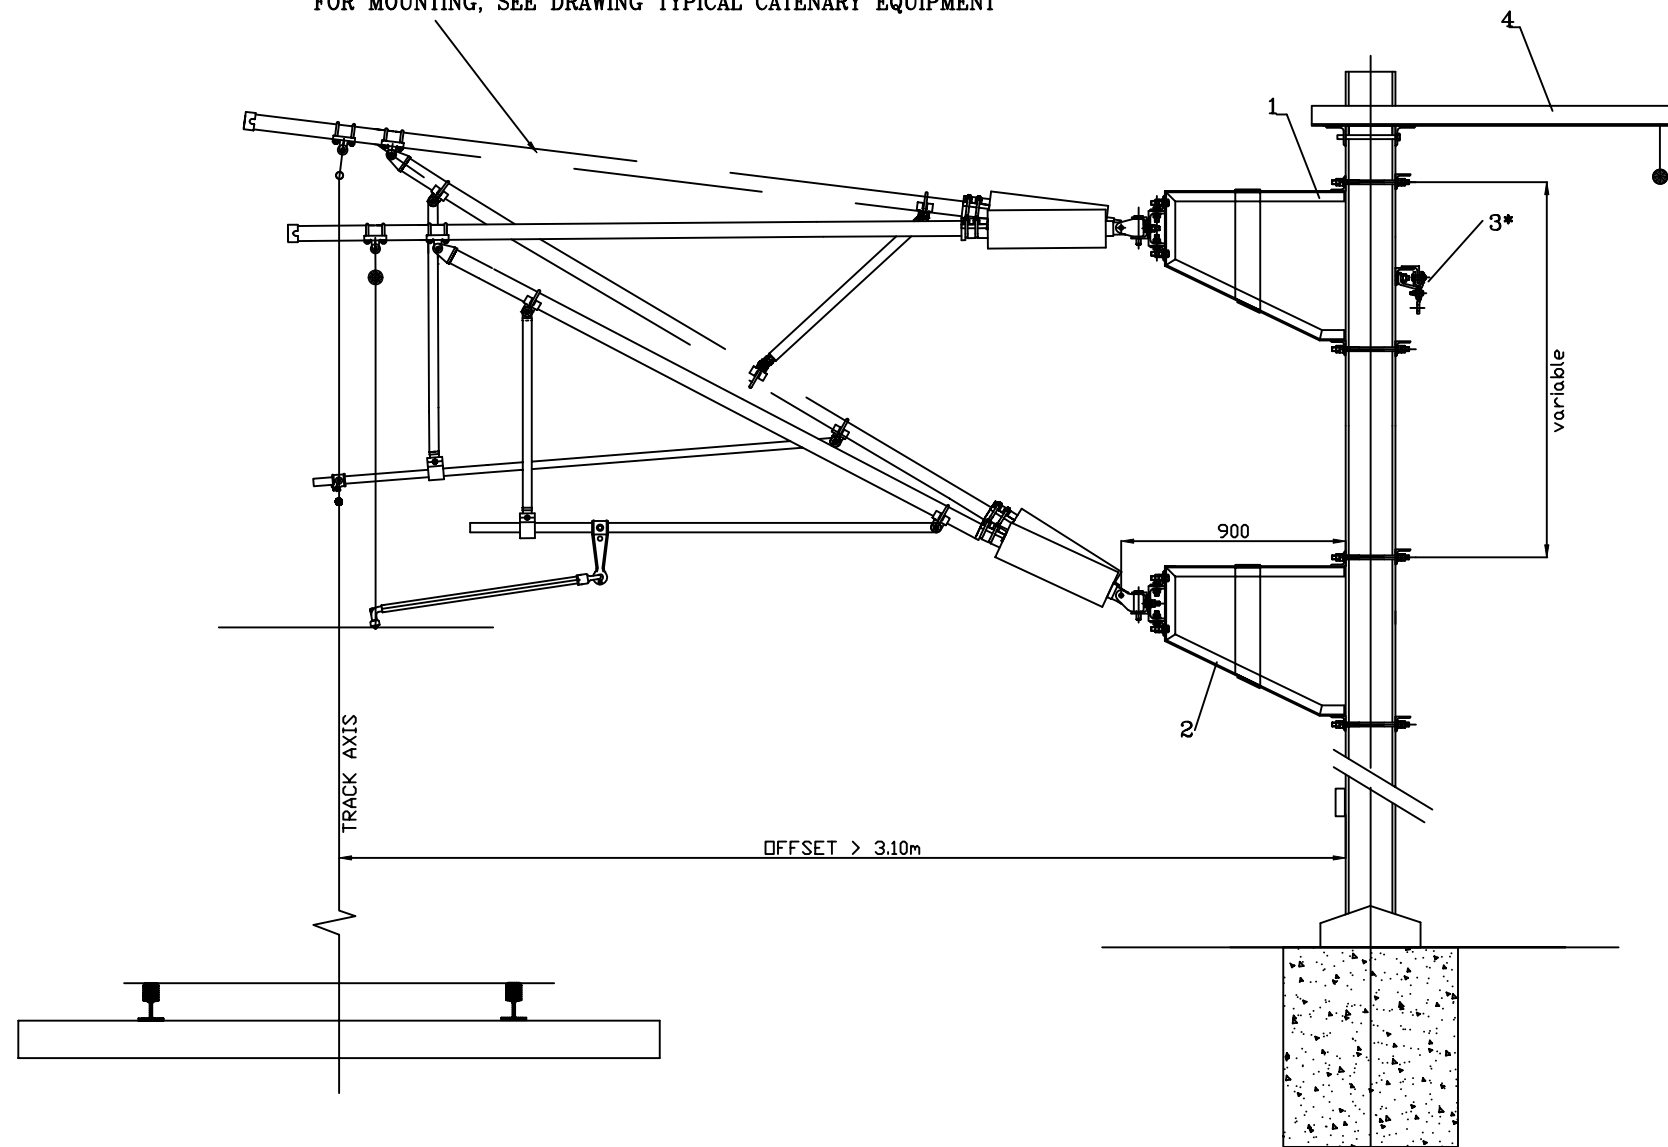



NOTE:

* EXACTE POSITION (HEIGHT, FIELD OR TRACK SIDE) WILL BE DEFINED DURING DETAIL DESIGN STAGE

4	OPTICAL FIBER BRACKET	01LC00BDG054	
3	EARTHING SUSPENSION	01LC00BDG072	
2	FASTENING FOR STRUT TUBE L=900 FOR 2 EQUIPMENTS	01LC00BDG212	
1	FASTENING FOR TOP TUBE L=900 FOR 2 EQUIPMENTS	01LC00BDG211	
ITEM	DESIGNATION	REFERENCE DRAWING	MARK

ECHIPARE TIP PENTRU CATENARA CU FIXARE PENTRU 2 CONSOLE L=900
TYPICAL CATENARY EQUIPMENT WITH FASTENING FOR 2 CANTILEVER L=900

Numele fisierului/ CAD file name:	Scara/ Scale:	Part	Rev.
01LC00BDG210		1 / 1	0

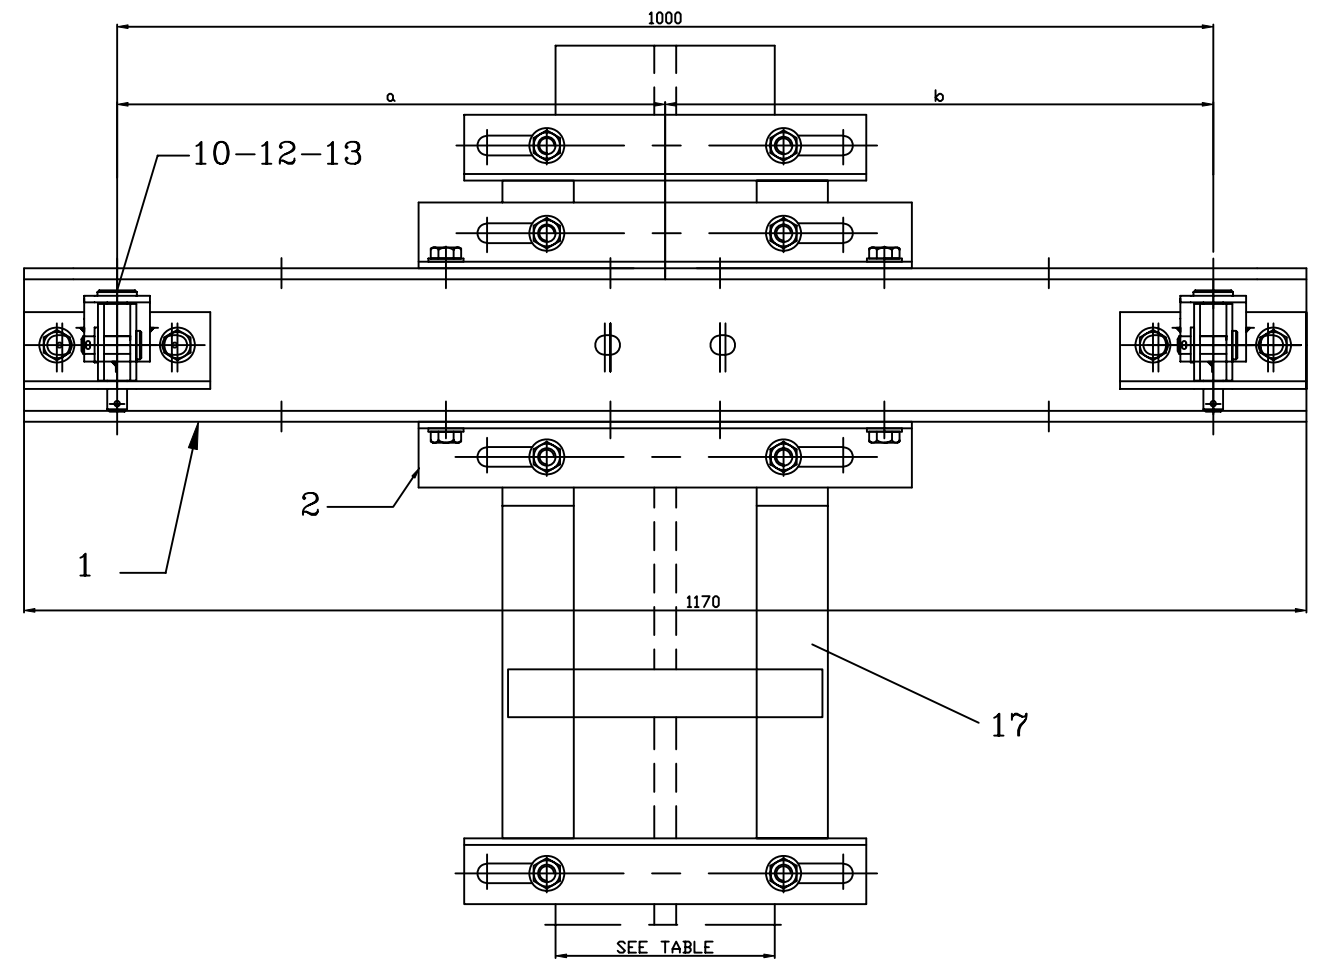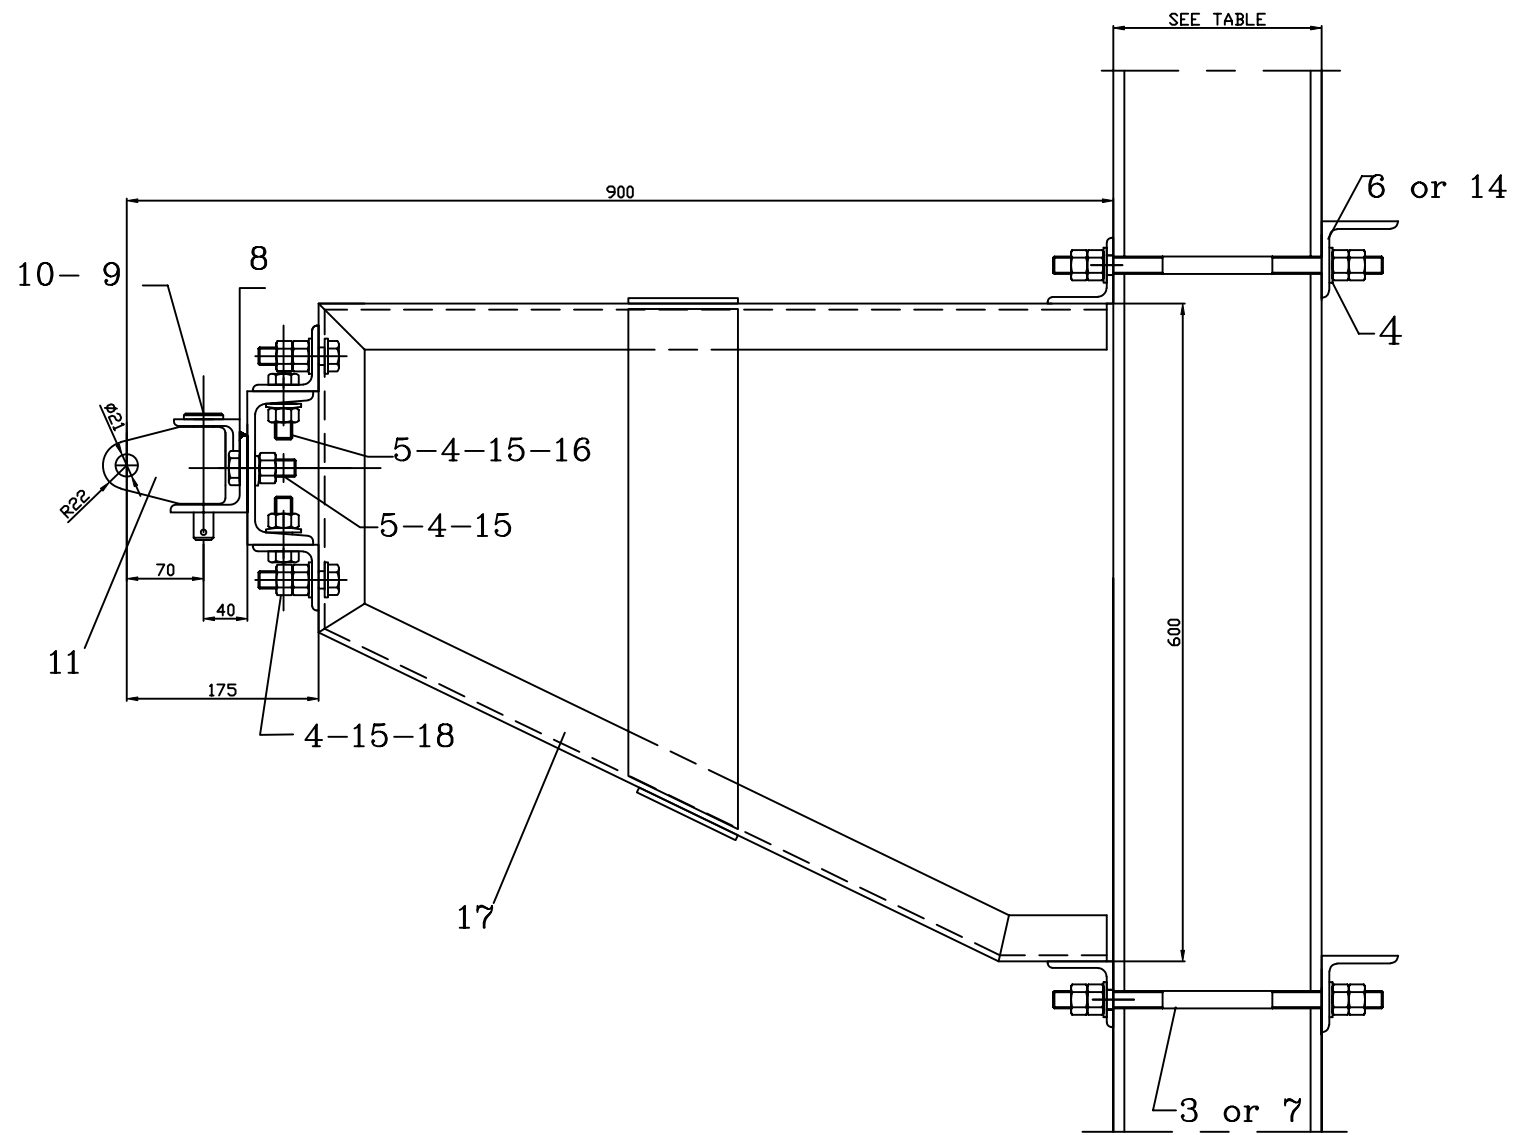



QUANTITY	4	4	18	BOLT HM 16-50/50		01LC00BDG144	1613K1
	1	1	17	FASTENING FOR 2 EQUIPEMENTS L=900		01LC00BDG212	
	4	4	16	WASHER TYPE U		01LC00BDG142	16A710
	8	8	15	WASHER . CS-16-32-2.8		01LC00BDG142	16A310
	2		14	COUNTERPLATE		01LC00BDG090	102
	2	2	13	AXIS 20-50		01LC00BDG146	201050
	2	2	12	WASHER M20		01LC00BDG142	20A110
	2	2	11	HINGE TOP TUBE		E.L.C 13-9-10 A REV C	
	4	4	10	PIN 4.5*40		01LC00BDG145	45A040
	2	2	9	AXIS 18-110		01LC00BDG146	181110
	2	2	8	HINGE SUPPORT		01LC00BDG114	
	4		7	THREADED ROD M16-450/100		01LC00BDG141	1611E2
		2	6	COUNTERPLATE		01LC00BDG090	101
	8	8	5	BOLT HM 16-50/50		01LC00BDG144	1612H1
	16	16	4	WASHER M16N		01LC00BDG142	16A110
		4	3	THREADED ROD M16 -350/100		01LC00BDG141	1611C2
		2	2	COUNTERPLATE FOR SPREADER		01LC00BDG094	
	1	1	SPREADER		01LC00BDG089		
MARK GROUP	102	101	ITEM	DESIGNATION	UNIT MASS	REFERENCE DRAWING	MARK
					kg		

Note
For cotes a and b see the mounting diagrams.

MARK	DESIGNATION
101	FROM HE 200 TO 240
102	FROM HE 260 TO 320

FIXARE TIRANT PENTRU 2 CONSOLE L=900
FASTENING FOR TOP TUBE FOR 2
CANTILEVER L=900

Numele fisierului/ CAD file name:	Scara/ Scale:	Part	Rev.
01LC00BDG211		1 / 1	0

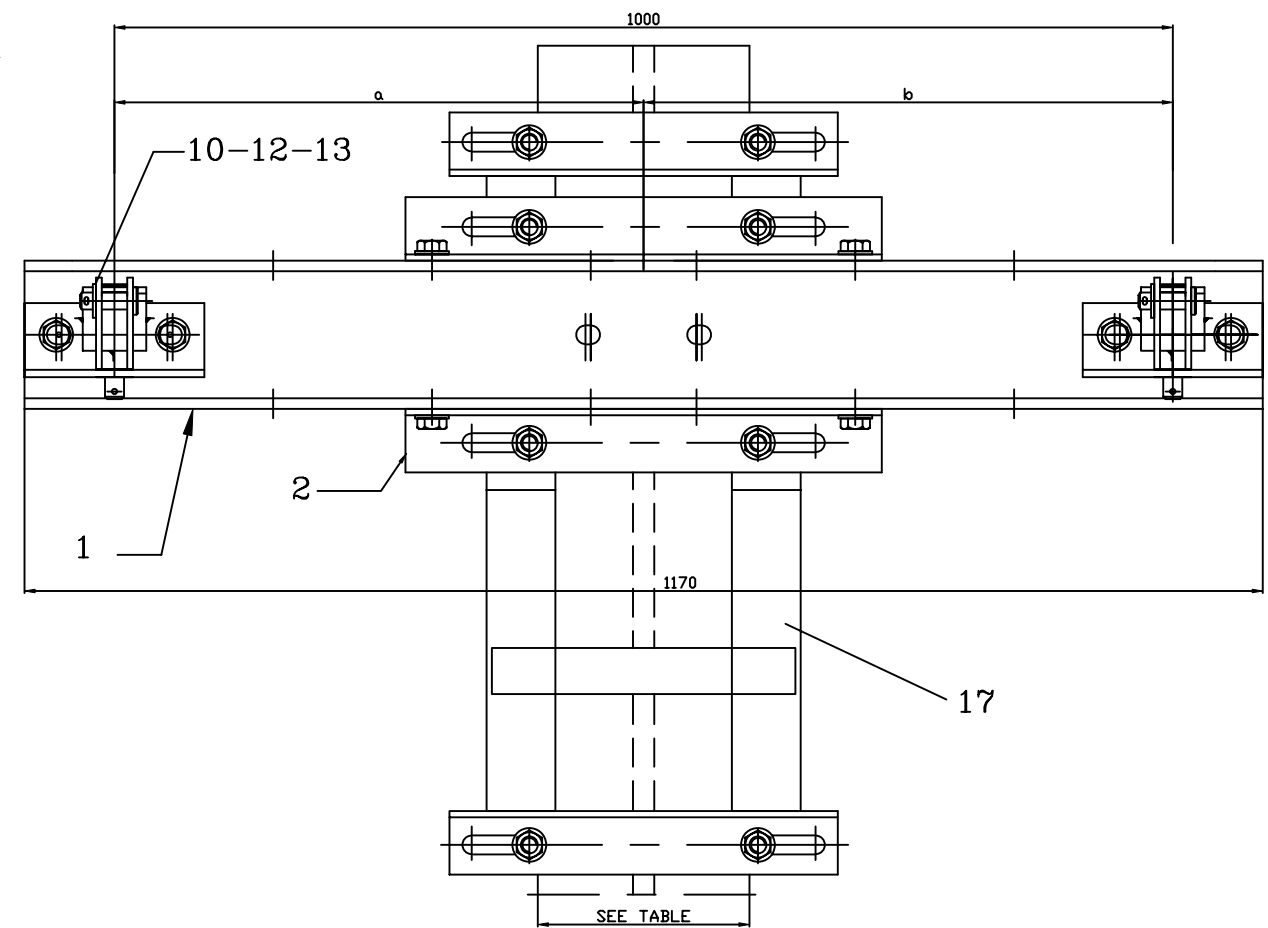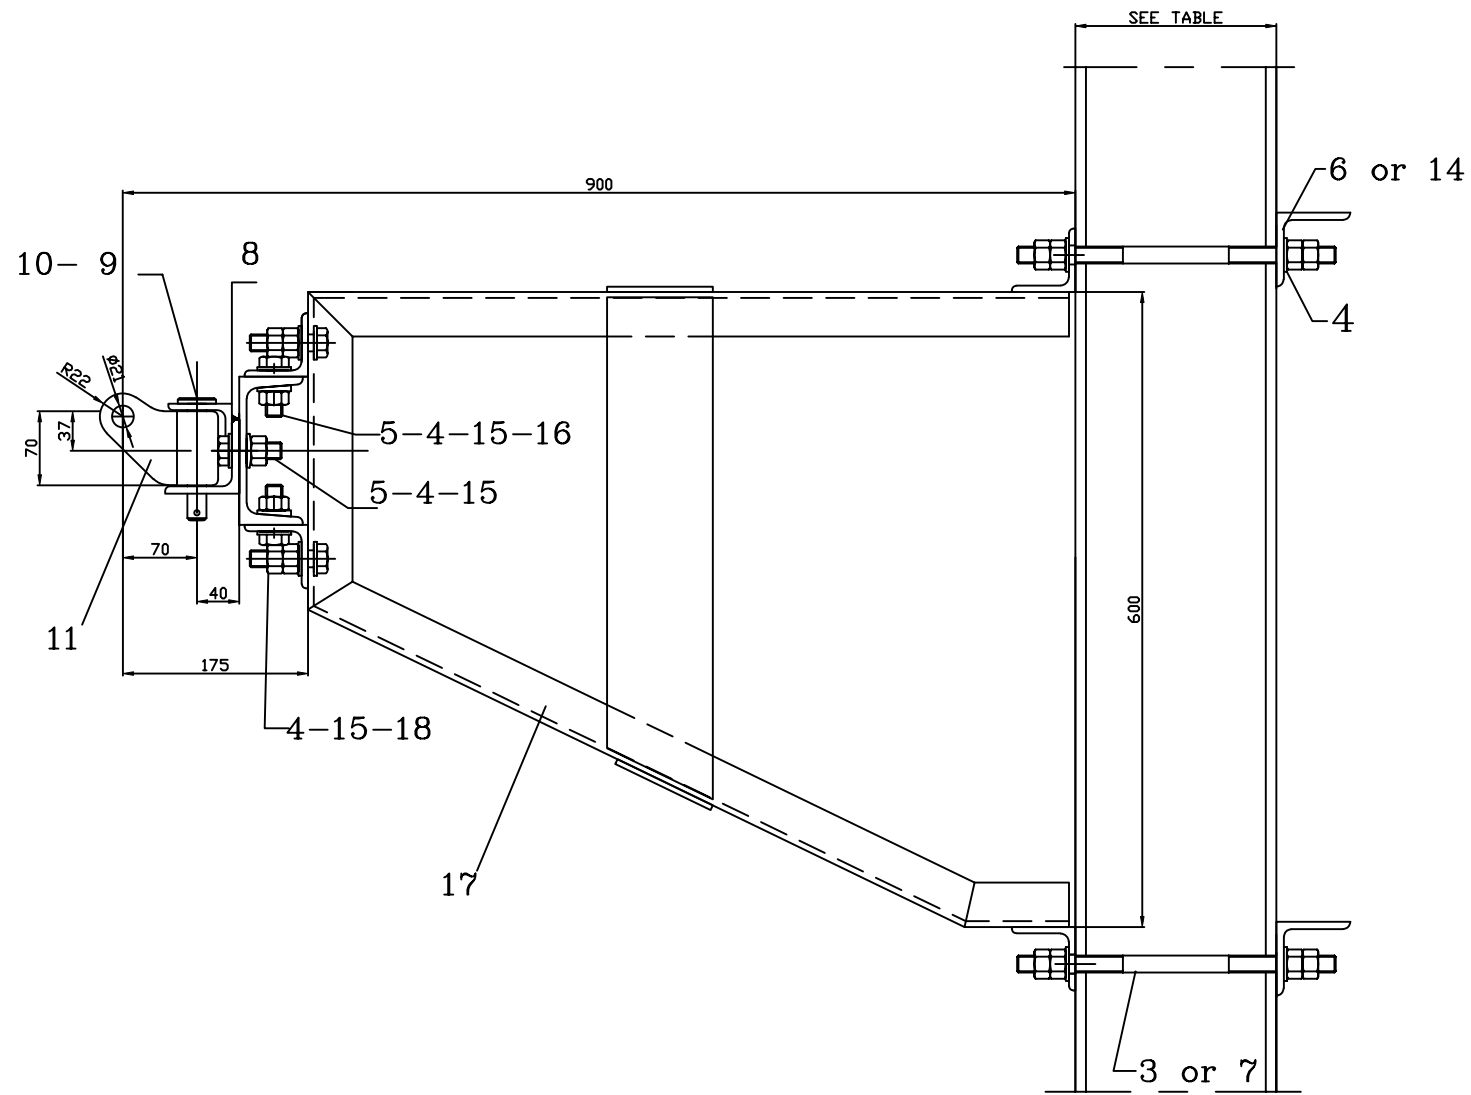





Note
For cotes a and b see the mounting diagrams.

MARK	DESIGNATION
101	FROM HE 200 TO 240
102	FROM HE 280 TO 320

	4	4	18	BOLT HM 16-50/50	01LC00BDG144	1613K1
	1	1	17	FASTENING FOR 2 EQUIPEMENTS L=900	01LC00BDG212	
	4	4	16	WASHER . TYPE U	01LC00BDG142	16A710
	12	12	15	WASHER . CS-16-32-2.8	01LC00BDG142	16A310
	2		14	COUNTERPLATE	01LC00BDG090	102
	2	2	13	AXIS 20-50	01LC00BDG146	201050
	2	2	12	WASHER M20	01LC00BDG142	20A110
	2	2	11	HINGE STRUT TUBE	E.L.C 13-9-11 A REV C	
	4	4	10	PIN 4.5*40	01LC00BDG145	45A040
	2	2	9	AXIS 18-110	01LC00BDG146	181110
	2	2	8	HINGE SUPPORT	01LC00BDG114	
	4		7	THREADED ROD M16-450/100	01LC00BDG141	1611E2
	2		6	COUNTERPLATE	01LC00BDG090	101
	8	8	5	BOLT HM 16-50/50	01LC00BDG114	1612H1
	24	24	4	WASHER M16N	01LC00BDG142	16A110
	4		3	THREADED ROD M16-350/100	01LC00BDG141	1611C2
	2	2	2	COUNTERPLATE FOR SPREADER	01LC00BDG094	
	1	1	1	SPREADER	01LC00BDG089	
MARK GROUP	102	101	ITEM	DESIGNATION	UNIT MASS	REFERENCE DRAWING
					kg	MARK

FIXARE CONTRAFISA PENTRU 2 CONSOLE L=900
FASTENING FOR STRUT TUBE FOR 2 CANTILEVER
L=900

Numele fisierului/ CAD file name:	Scara/ Scale:	Part	Rev.
01LC00BDG212		1 / 1	0

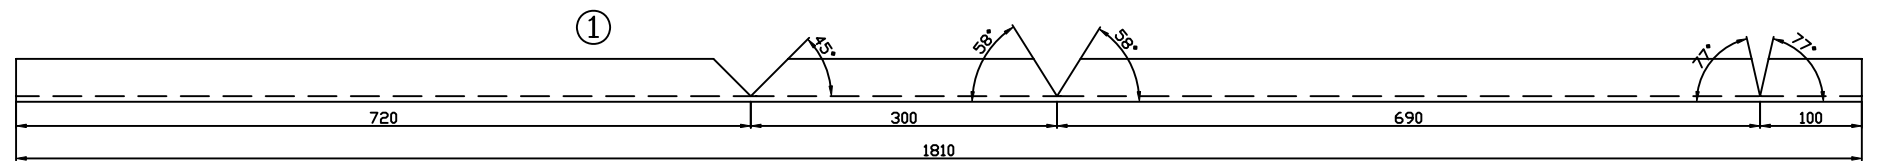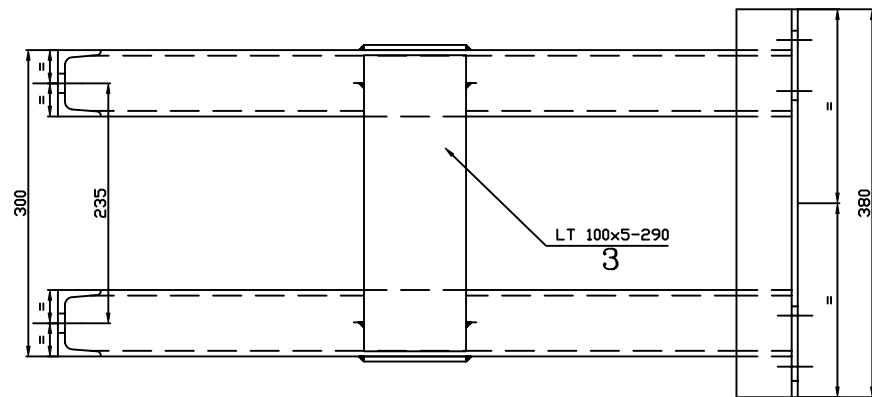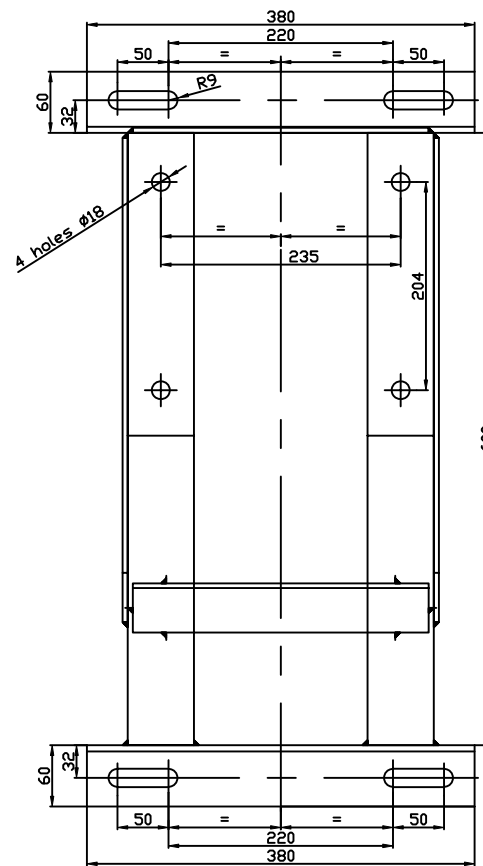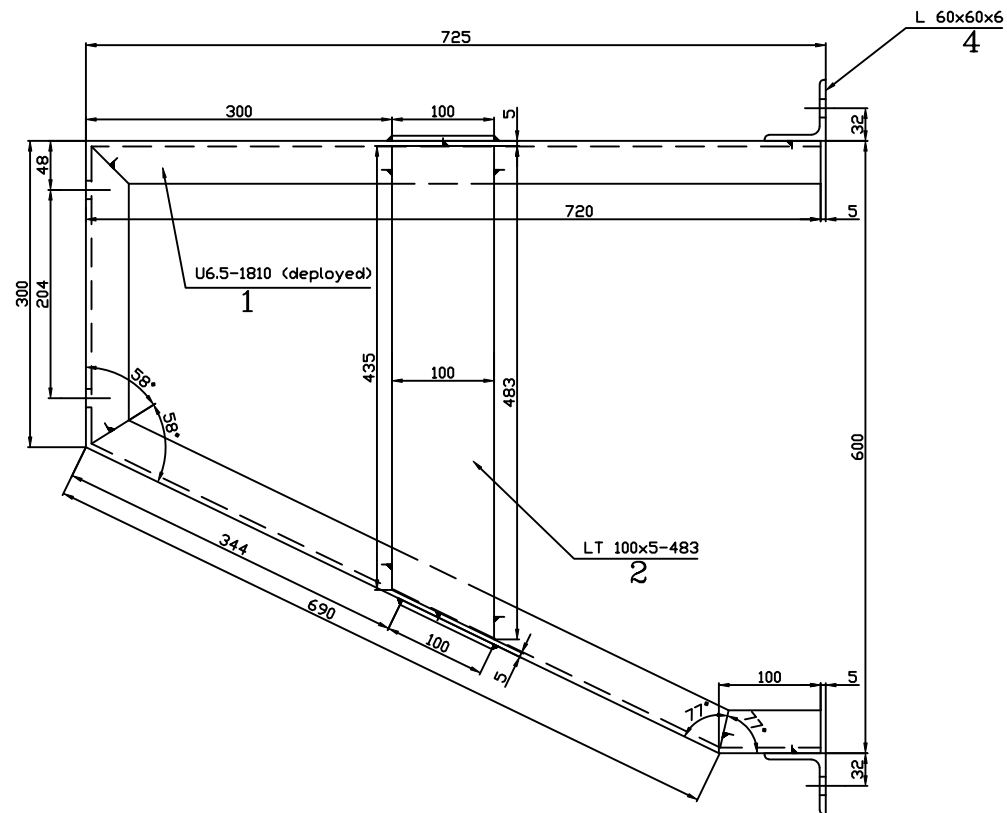


NOTE:
 1.The weldings will be made continuous, tight for hot galvanize.
 2.After welding and drilling will be hot galvanized AT/OL/Zn600-STAS 7221-90.

2	4	CADRE		S235JR
2	3	PLATE		S235JR
2	2	PLATE		S235JR
1	1	CADRE		S235JR
QUANTITY	ITEM	DESIGNATION	UNIT MASS	MATERIAL TECHNICAL SPECIFICATION
			kg	

FIXARE PENTRU 2 CONSOLE L=900
 FASTENING FOR 2 CANTILEVER L=900

Numele fisierului/
 CAD file name:
01LC00BDG213

Scara/ Scale:	Part	Rev.
	1 / 1	0

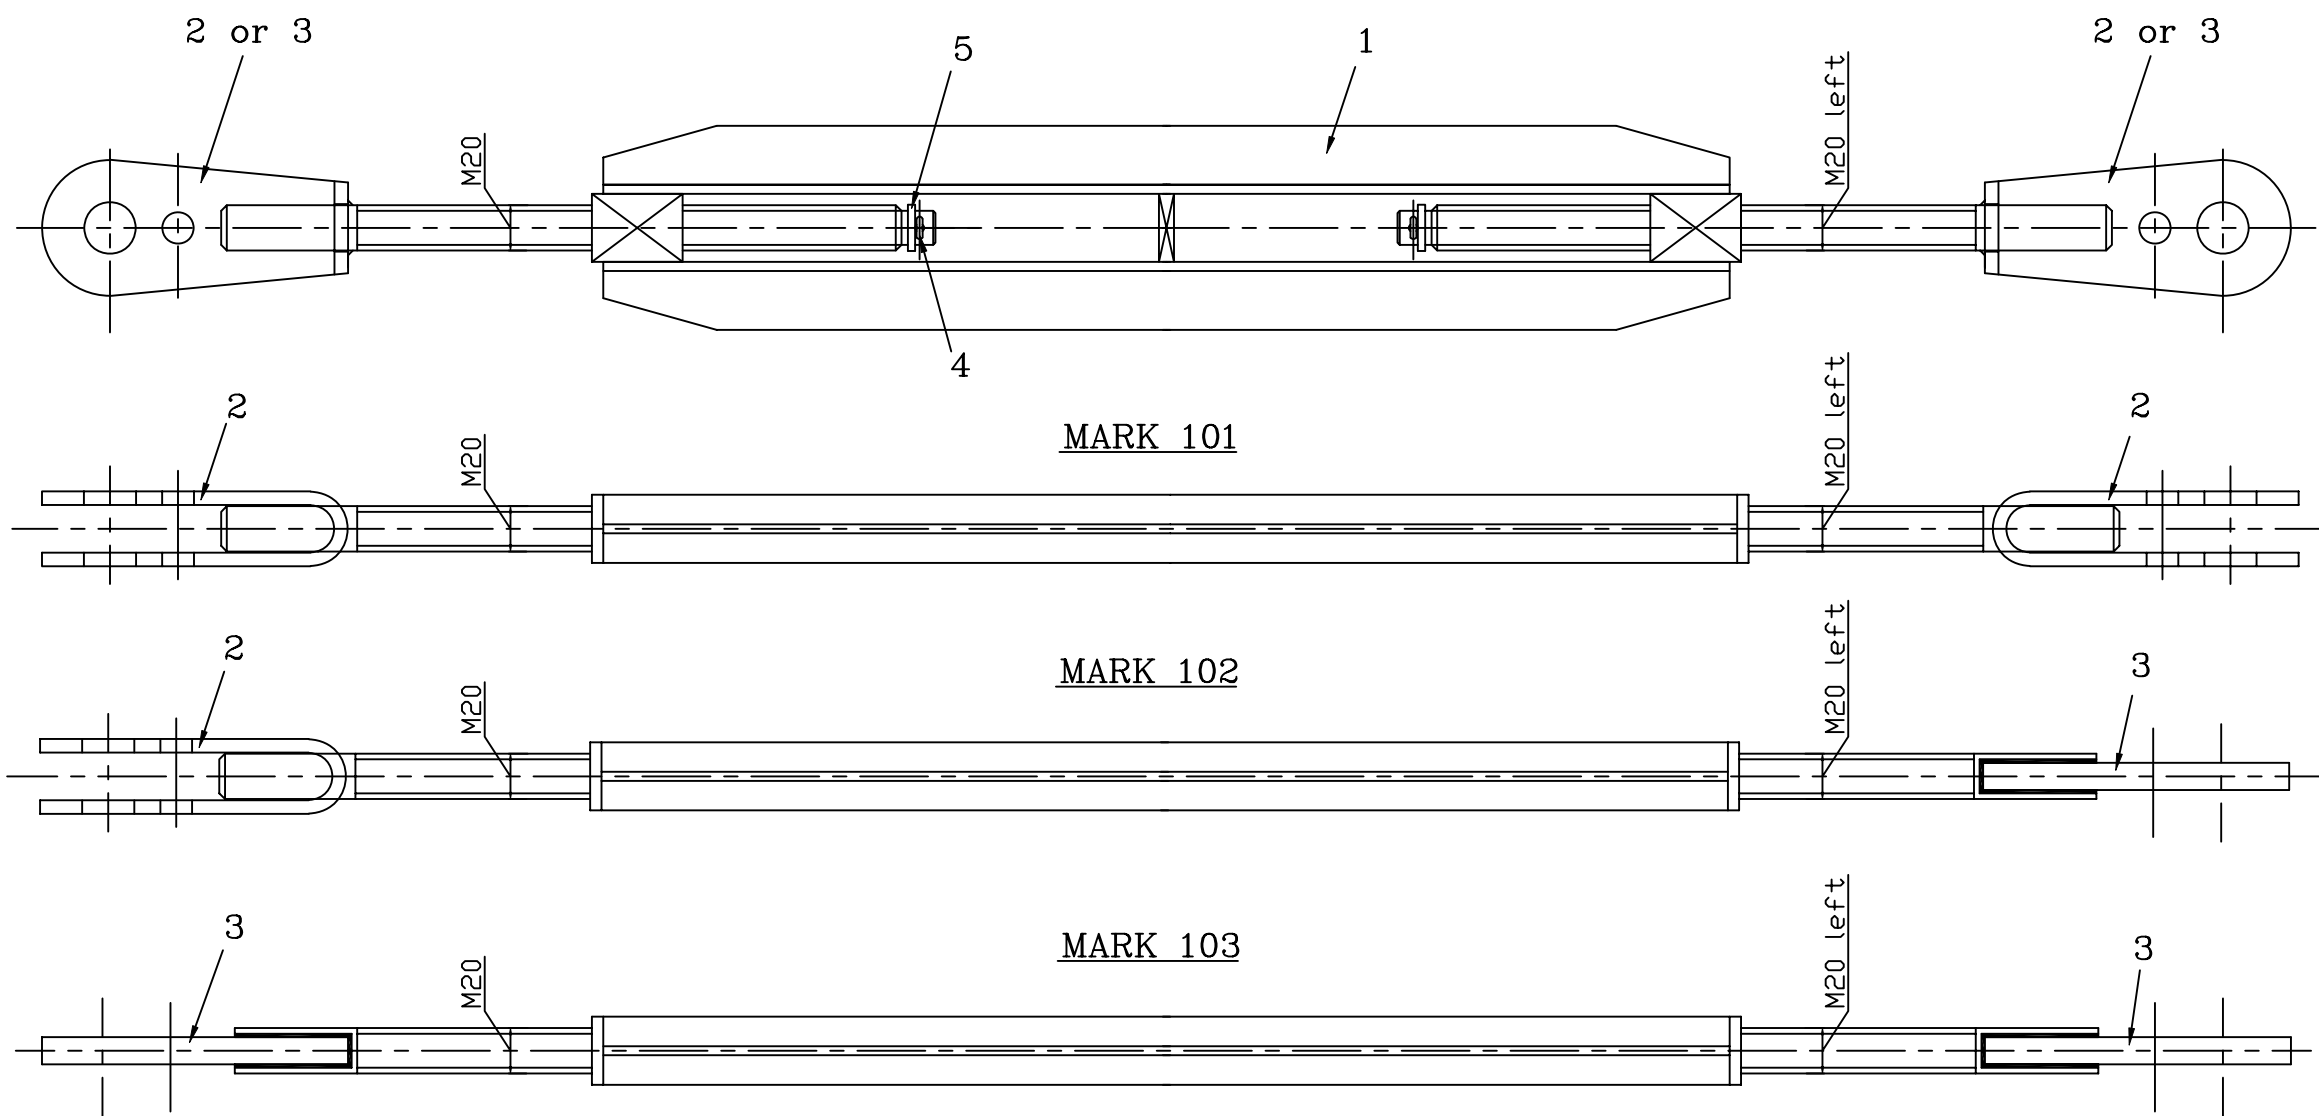


Note:
 Each turnbuckle will have a rod with right thread and the other rod with left thread.

2	2	2	5	SPLIT PIN	stainless steel
2	2	2	4	WASHER	stainless steel
2	1	-	3	ROD WITH EYE	S235JR
-	1	2	2	ROD WITH CLEVIS	S235JR
1	1	1	1	TURNBUCKLE BODY	S235JR
103	102	101	ITEM	DESIGNATION	MATERIAL

INTINZATOR
 TURNBUCKLE

Numele fisierului/
 CAD file name:
 01LC00BDG214

Scara/ Scale:	Part	Rev.
1 / 1	1 / 1	0

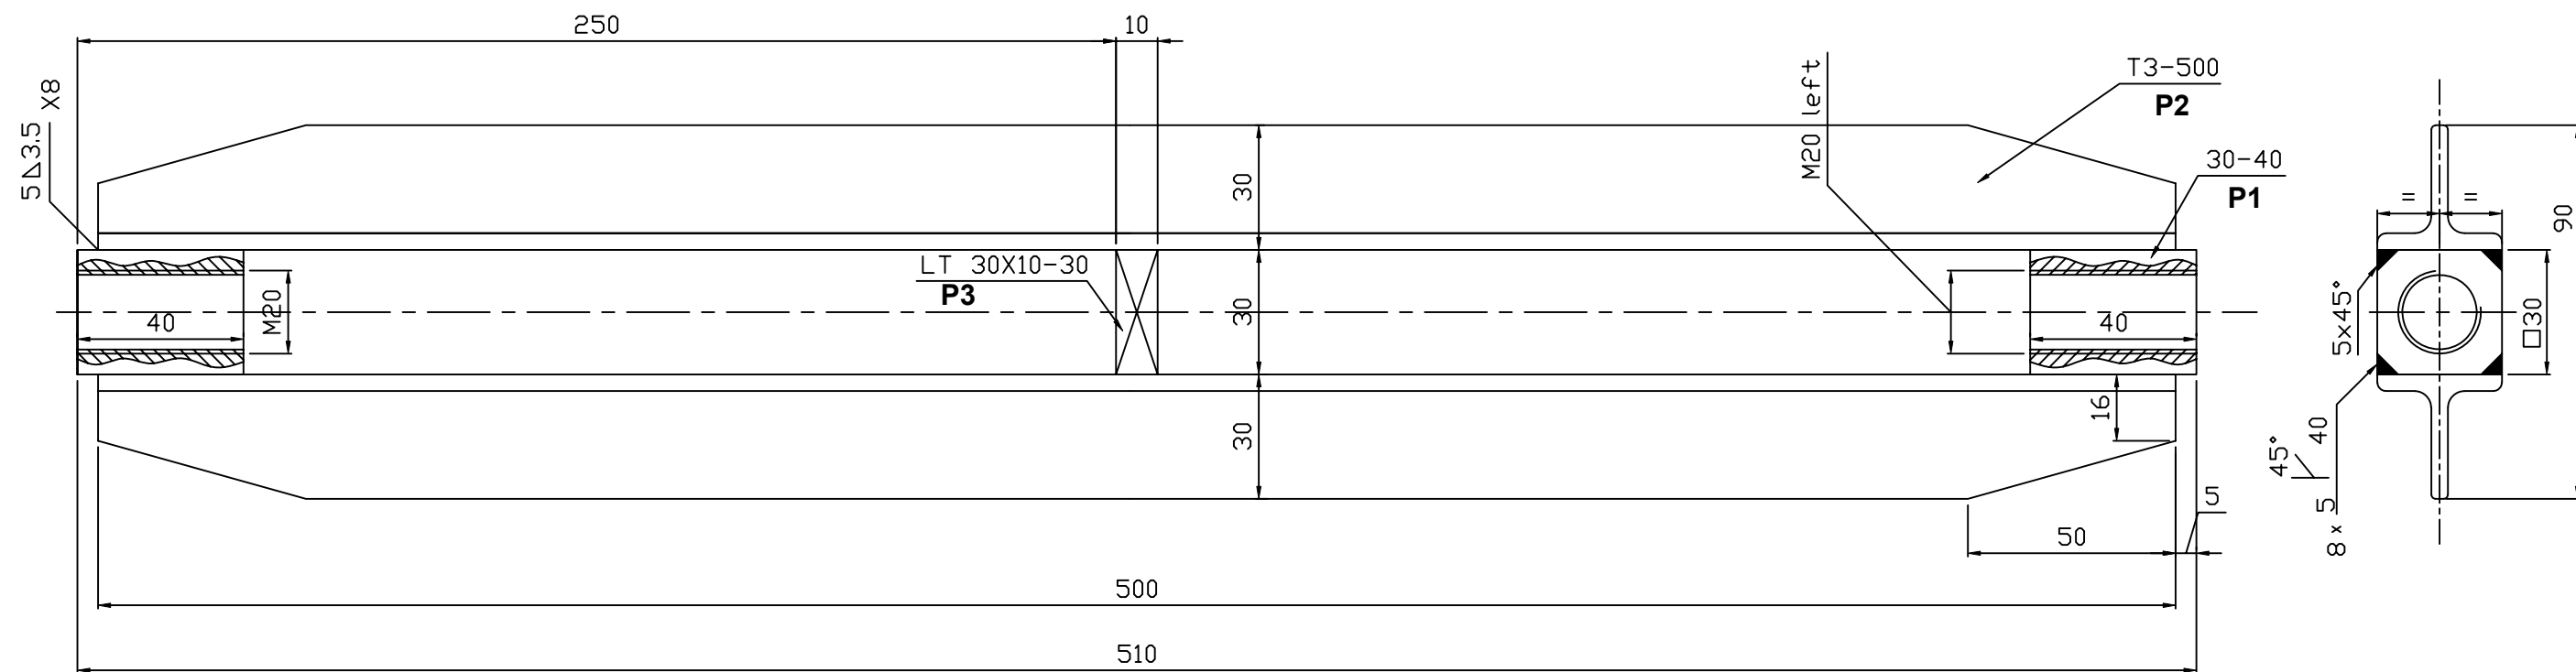

NOTE

- 1.All weldings will be made tight and continuous.
- 2.After welding, drilling and threading , will be hot galvanised AT/OL/Zn 500 excepting the threads , wich will be galvanised AT/OL/Zn 510 - STAS7221-90.

3	Spacer	1	S235JR
2	"T" profile 30x30x4 - 500	2	S235JR
1	Square rod 30x30 - 40	2	S235JR
ITEM	DESIGNATION	QUANTITY	MATERIAL

CORP INTINZATOR
TURNBUCKLE BOADY

Numele fisierului/
CAD file name:
01LC00BDG215



Scara/
Scale:

Part

Rev.

1 / 1

0

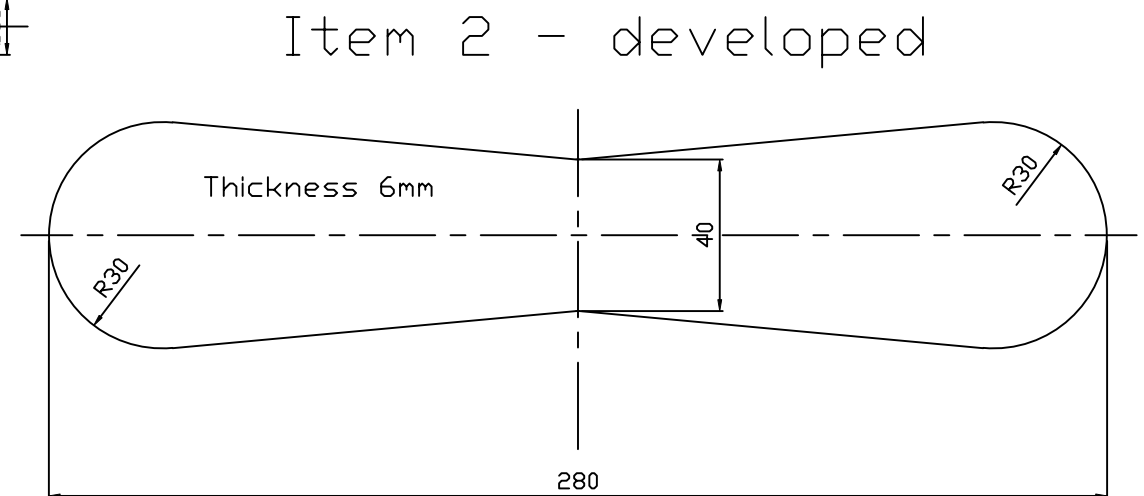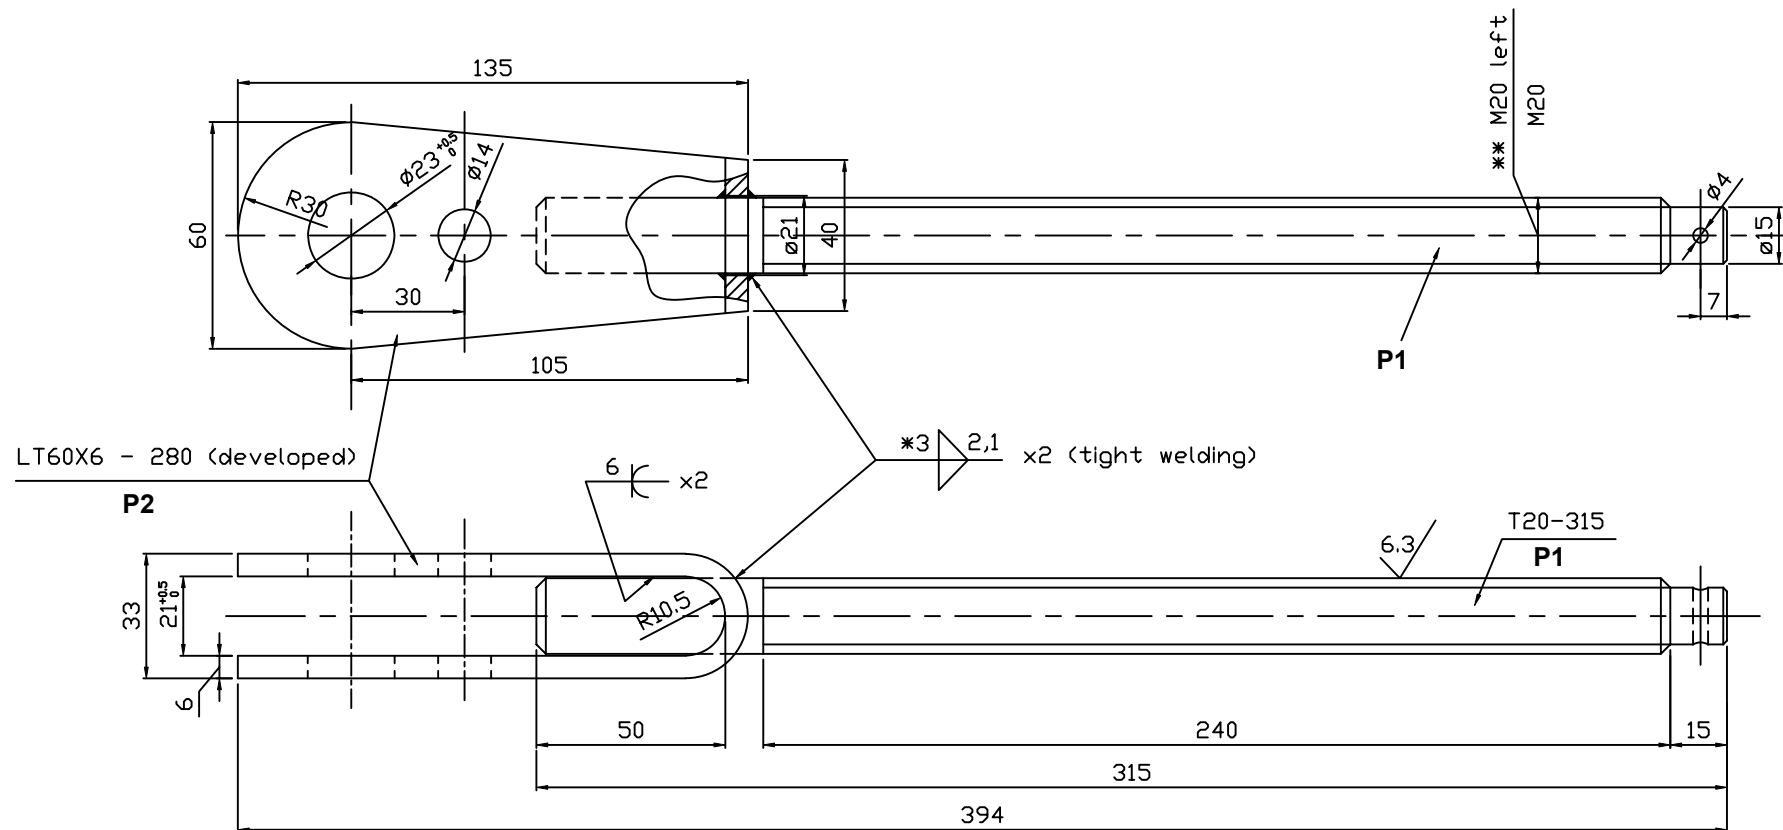

NOTE

- 1.All weldings will be made tight and continuous.
- 2.After welding, drilling and threading , will be hot galvanised AT/OL/Zn 500 excepting the thread , wich will be galvanised AT/OL/Zn 510 - STAS7221-90.

P2	Clevis	1	S235JR
P1	Threaded bar	1	S235JR
ITEM	DESIGNATION	QUANTITY	MATERIAL


BARA CU URECHE
ROD WITH CLEVIS

Numele fisierului/
CAD file name:
01LC00BDG216

Scara/
Scale:

Part
1 / 1

Rev.
0

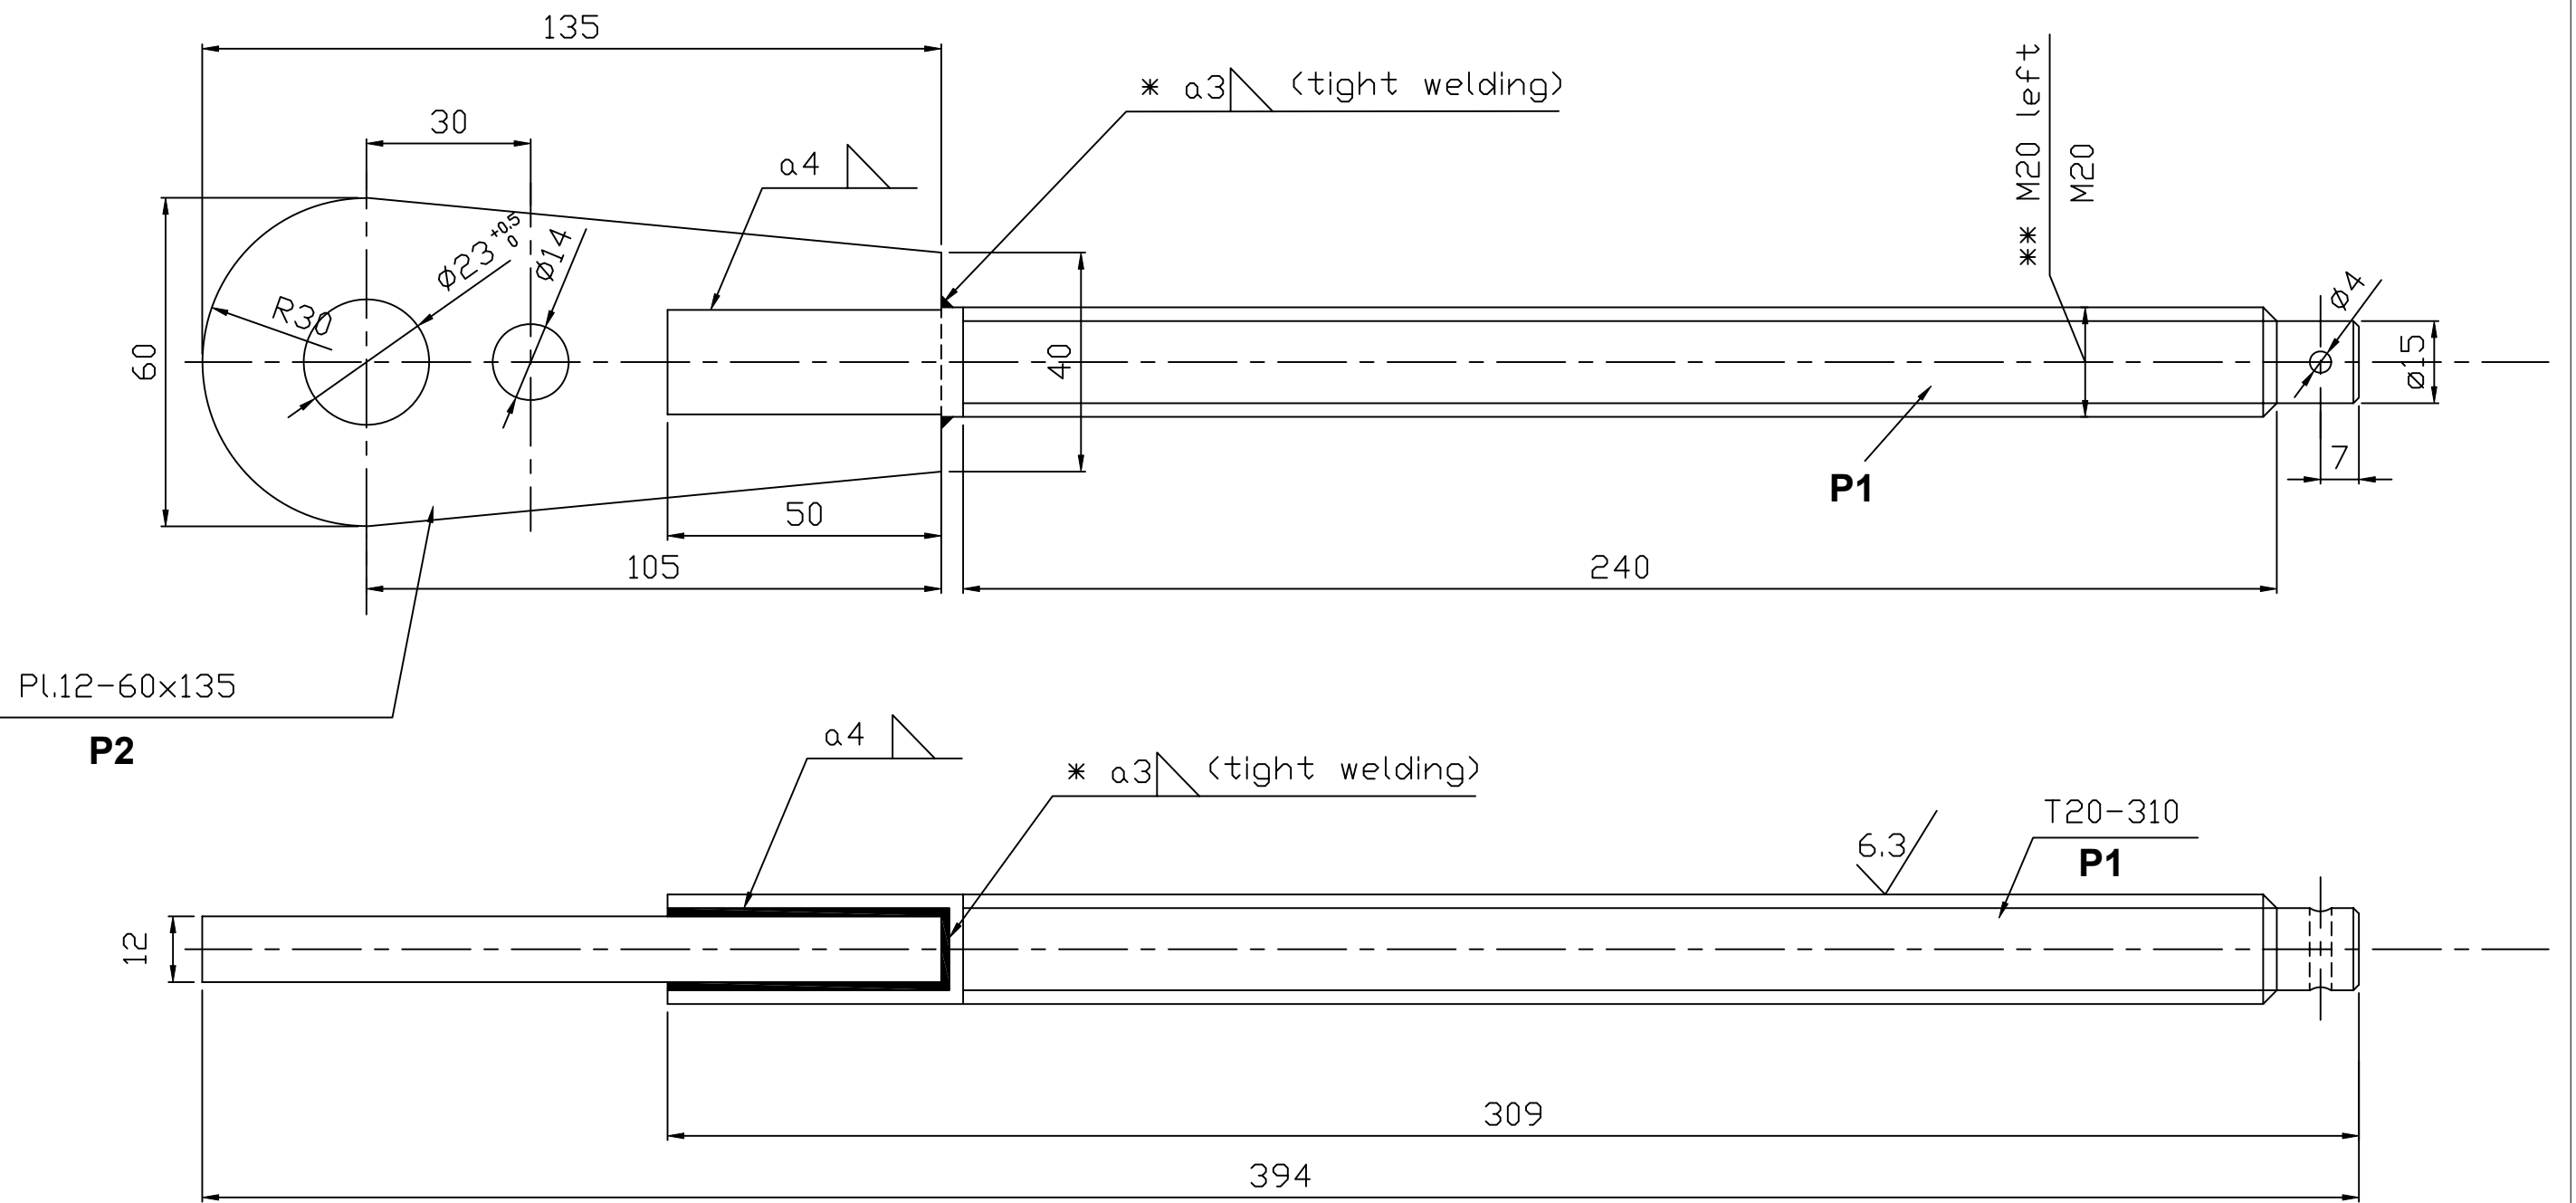

NOTE


- 1.All weldings will be made tight and continuous.
- 2.After welding, drilling and threading , will be hot galvanised AT/OL/Zn 500 excepting the thread , wich will be galvanised AT/OL/Zn 510 - STAS7221-90.

P2	Plate	1	S235JR
P1	Threaded bar	1	S235JR
ITEM	DESIGNATION	QUANTITY	MATERIAL

BARA CU OCHI
ROD WITH EYE

Numele fisierului/
CAD file name:
01LC00BDG217

Scara/ Scale:	Part	Rev.
1 / 1	1 / 1	0

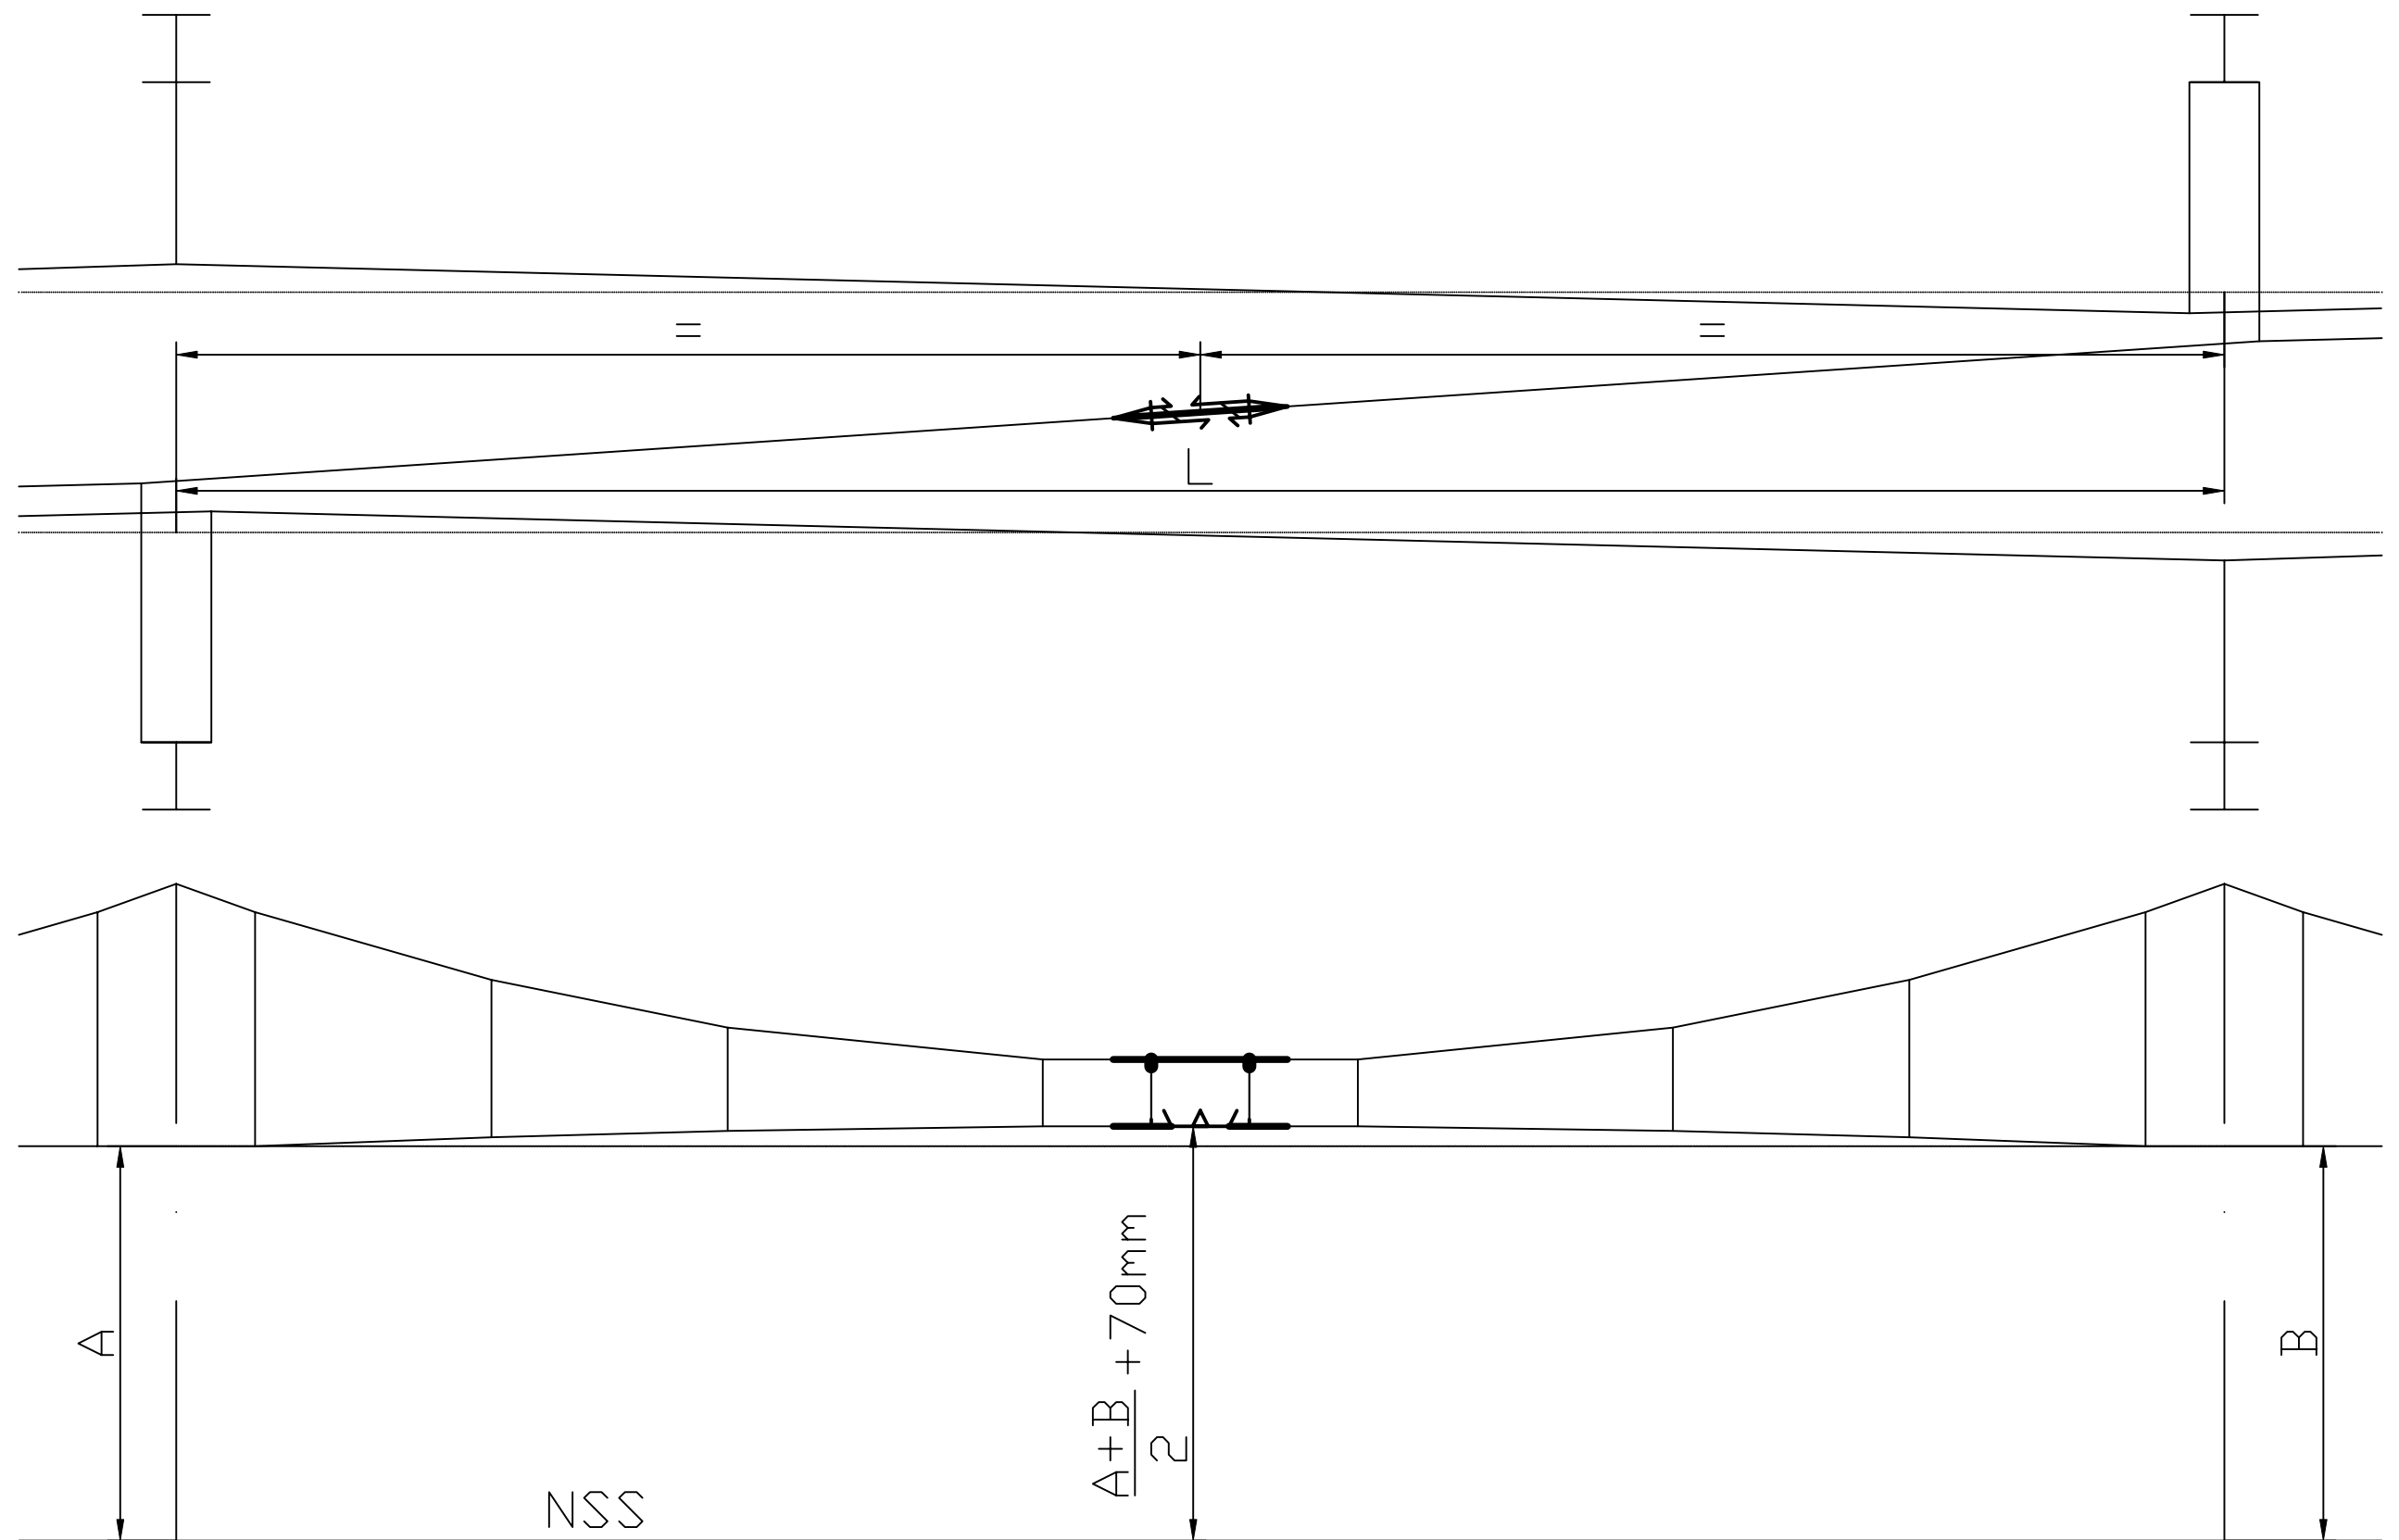



NOTE
 Admissible tolerances at the assemblage of SI
 regarding to the track axis: 0±50 mm

MONTARE IZOLATOR DE SECTIONARE IN ZONA MACAZURILOR SECTION INSULATOR MOUNTING ON TURN-OUT	Numele fisierului/ CAD file name:	Scara/ Scale:	Part	Rev.
	01LC00BDG220		1 / 1	0


8 Bolts HM 16-120/38

2 UPN 140 x 60 x 7

Plat 420 x 160 x 10 welded

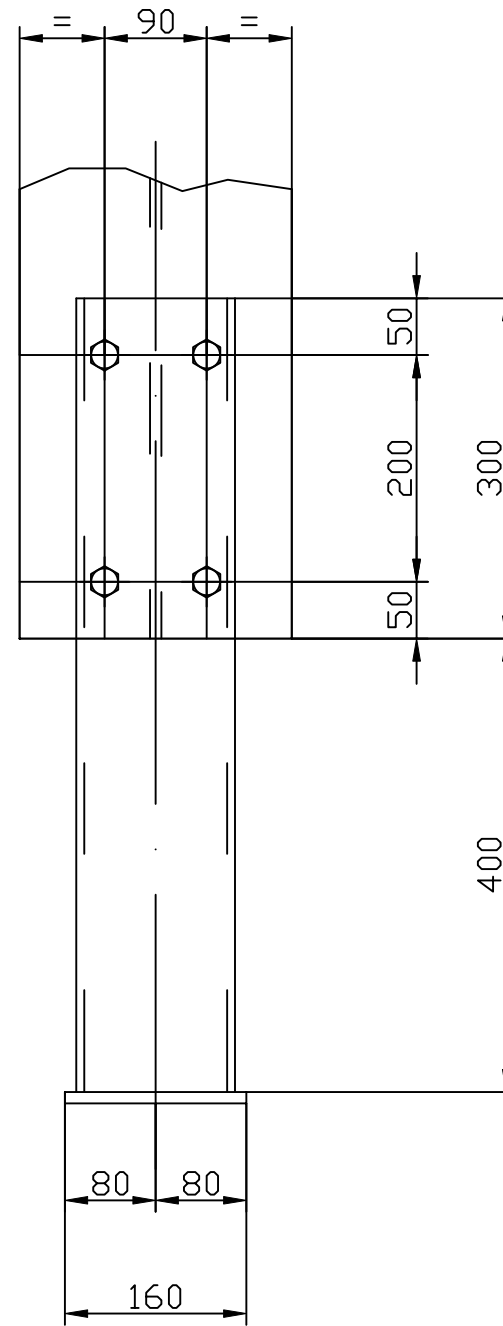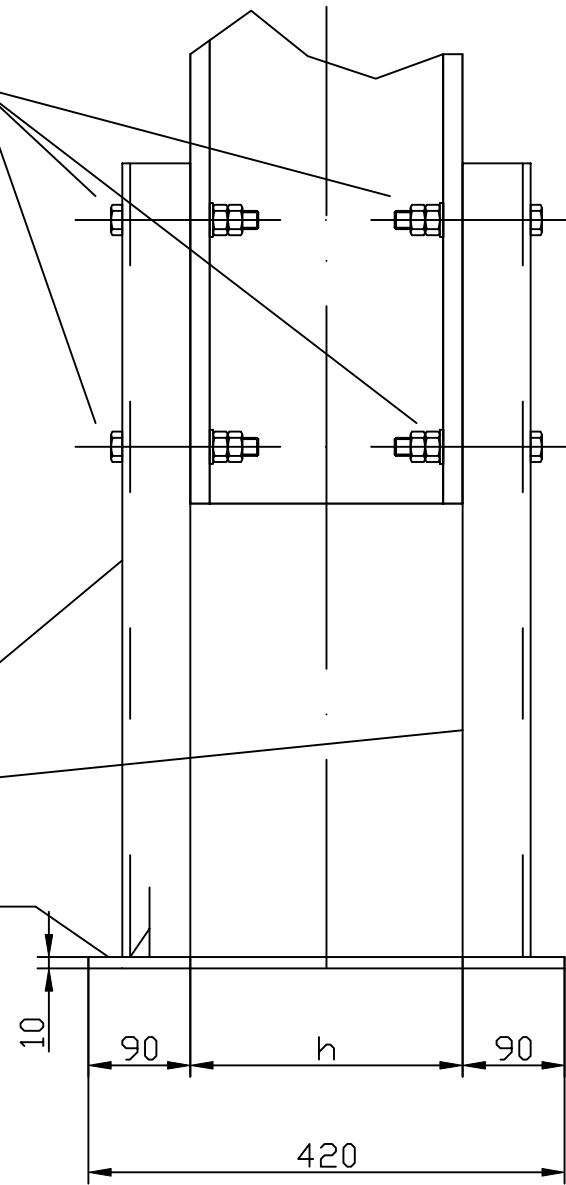

Note: for h dimension see tables

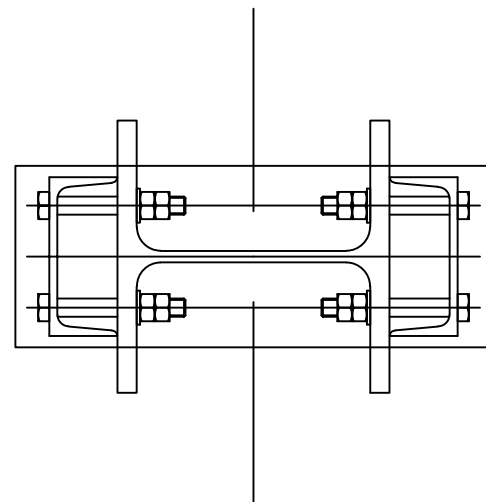

MARK	POLE TYPE	h
101	HEA200	190
102	HEA220	210
103	HEA240	230
104	HEA260	250
105	HEA280	270


MARK	POLE TYPE	h
201	HEB240	240
202	HEB260	260
203	HEB280	280
204	HEB300	300

PIESA DE EXTENSIE PENTRU STALP H
EXTENSION PIECE FOR H POLES

Numele fisierului/
CAD file name:
01LC00BDG222

Scara/
Scale:

Part
1 / 1
Rev.
0

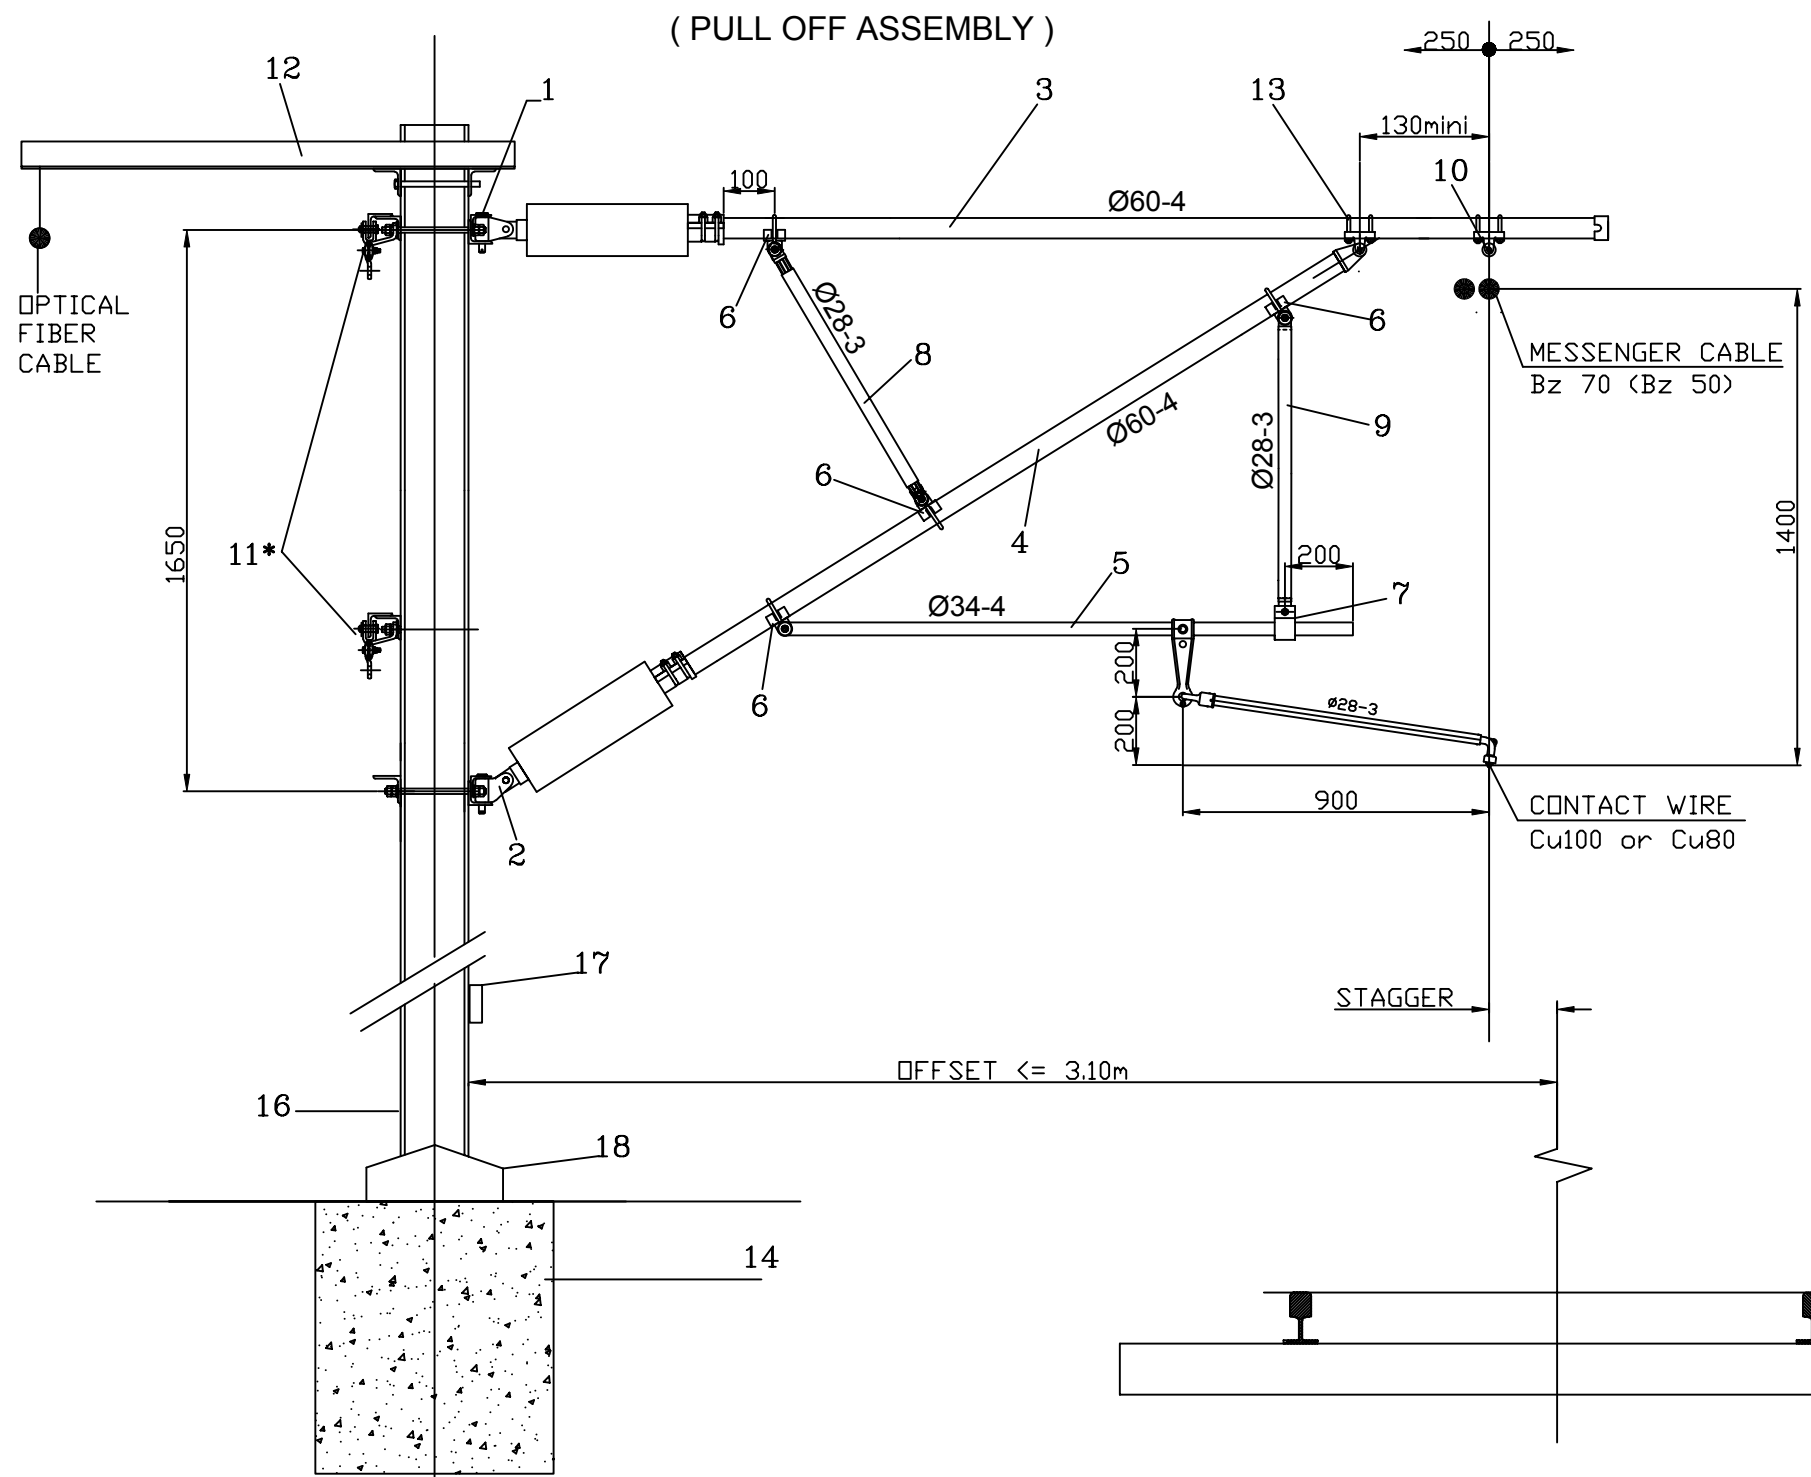


18	DICE PROTECTION	01LC00BDG008	
17	ASSEMBLY OF SAFETY DEVICES		
16	MAST TYPES AND REFERENCES	01LC00BDG010	
15	-	-	
14	FOUNDATION	01LC00BDG006	
13	FASTENING FOR TOP TUBE	01LC00BDG069	
12	OPTICAL FIBER BRACKET	01LC00BDG054	
11	EARTHING SUSPENSION	or 01LC00BDG071 01LC00BDG072	
10	SUSPENSION FOR 2 MESSENGERS	01LC00BDG070	102
9	AUXILIARY STRUT TUBE	01LC00BDG083	
8	AUXILIARY STRUT TUBE	01LC00BDG083	
7	FASTENING ON TUBE Ø34	ELC 26-4.7.0	
6	FASTENING ON TUBE Ø60	ELC 13-1.2.3.0	
5	Ø34-4 REGISTRATION ARM WITH 0.9m STEADY ARM FOR STRAIGHT LINE	01LC00BDG150	201
4	INSULATED FOR STRUT TUBE Ø60	01LC00BDG066	
3	INSULATED FOR TOP TUBE Ø60	01LC00BDG064	
2	FASTENING FOR STRUT TUBE	or 01LC00BDG058 01LC00BDG071	
1	FASTENING FOR TOP TUBE	or 01LC00BDG059 01LC00BDG135	
ITEM	DESIGNATION	REFERENCE DRAWING	MARK

NOTE:

* EXACTE POSITION (HEIGHT, FIELD OR TRACK SIDE) WILL BE DEFINED DURING DETAIL DESIGN STAGE

MONTARE TIP ECHIPAMENT MEDIAN PENTRU LINIE CURENTA (ANSAMBLU TENSIONAT) TYPICAL MID POINT EQUIPMENT ON OPEN ROUTE (PULL OF ASSEMBLY)	Numele fisierului/ CAD file name:	Scara/ Scale:	Part	Rev.
	01LC00BDG230		1 / 2	0

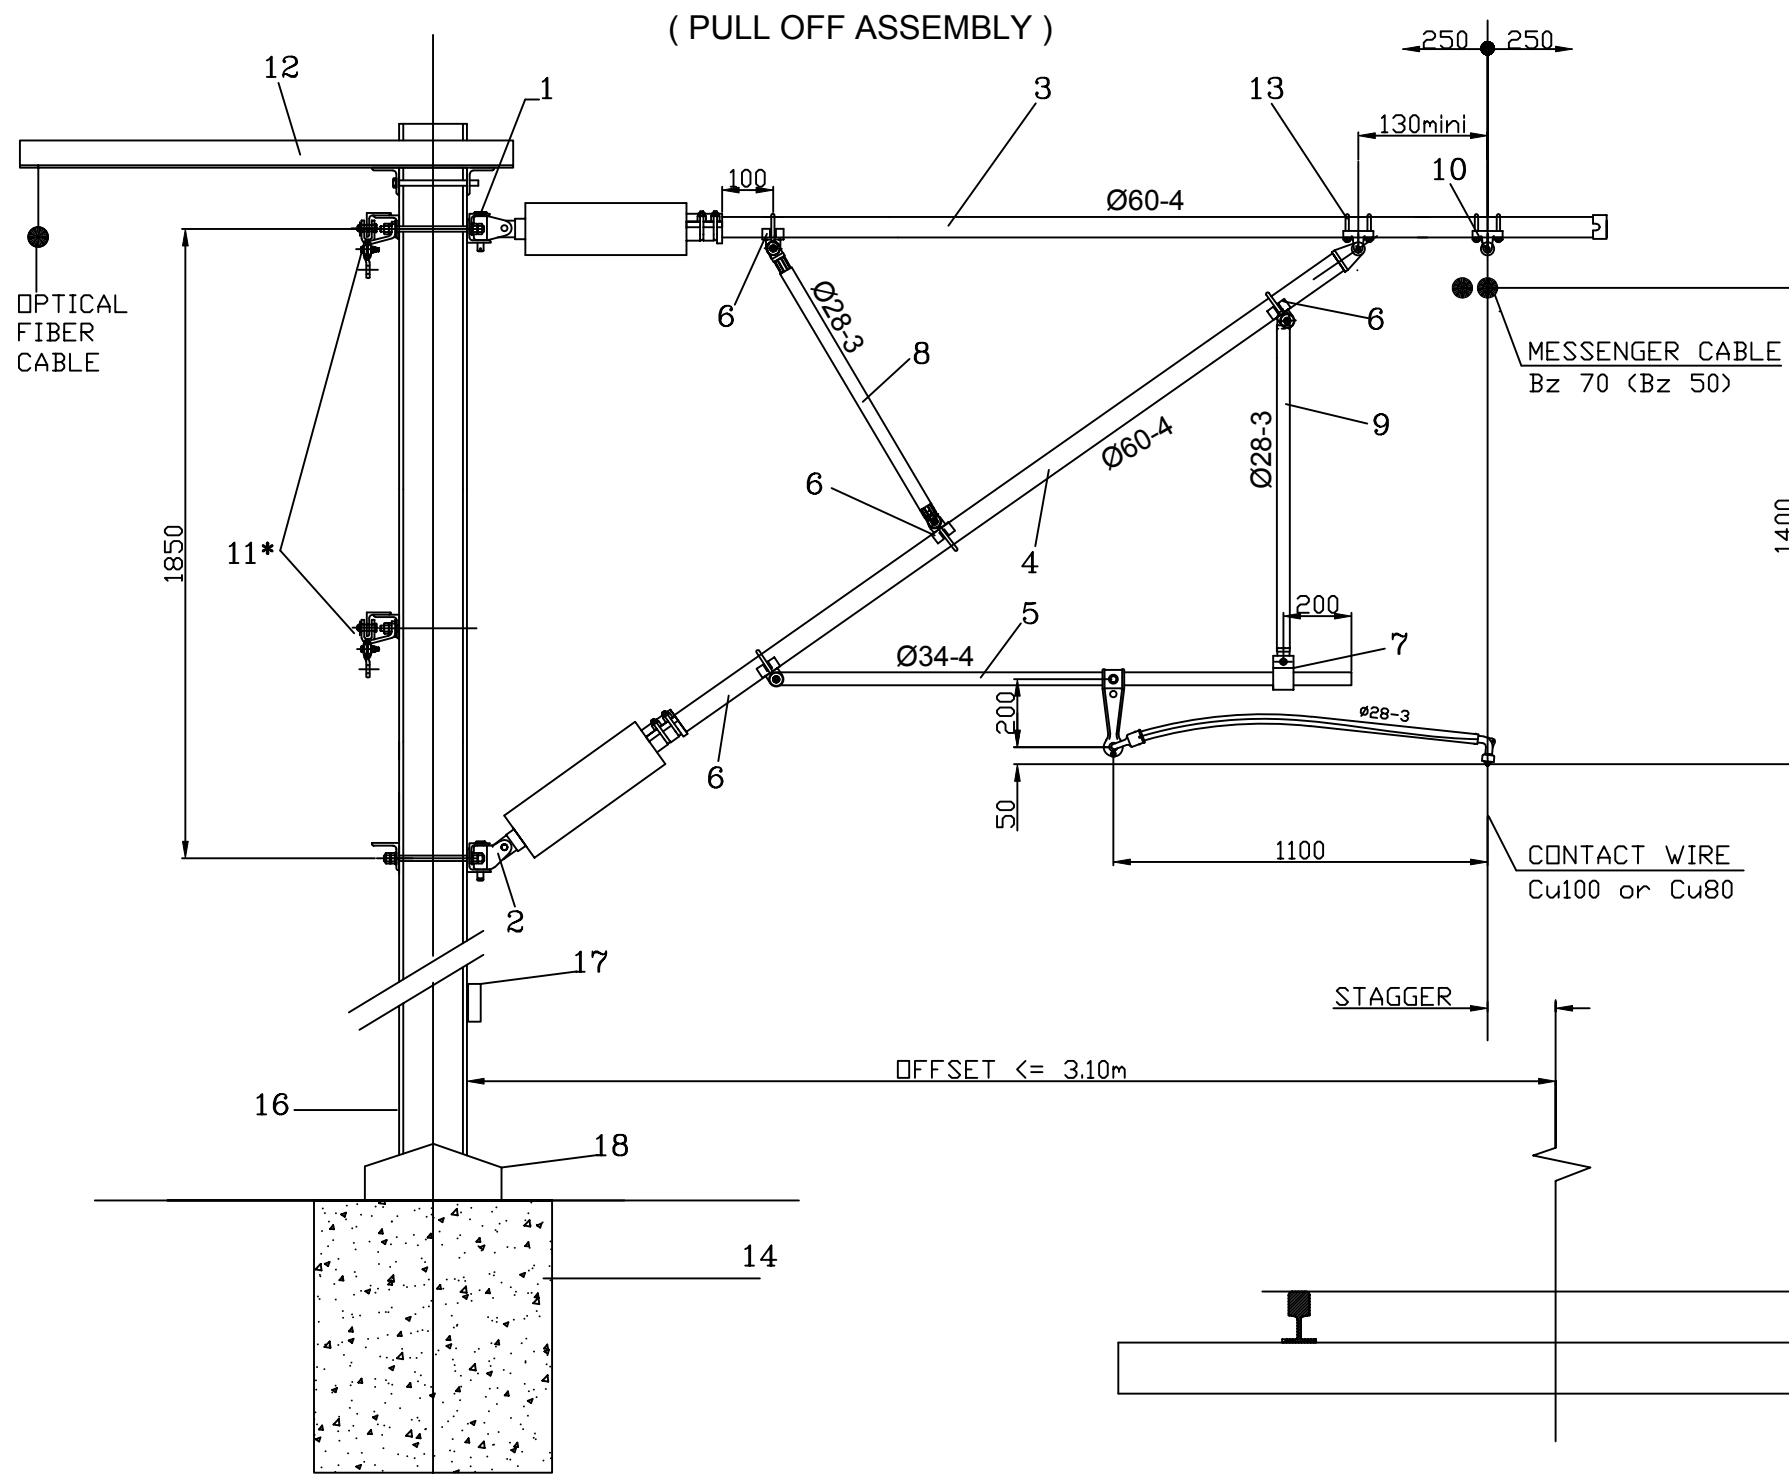


18	DICE PROTECTION	01LC00BDG008	
17	ASSEMBLY OF SAFETY DEVICES		
16	MAST TYPES AND REFERENCES	01LC00BDG010	
15	-	-	
14	FOUNDATION	01LC00BDG006	
13	FASTENING FOR TOP TUBE	01LC00BDG069	
12	OPTICAL FIBER BRACKET	01LC00BDG054	
11	EARTHING SUSPENSION	or 01LC00BDG071 01LC00BDG072	
10	SUSPENSION FOR 2 MESSENGERS	01LC00BDG070	102
9	AUXILIARY STRUT TUBE	01LC00BDG083	
8	AUXILIARY STRUT TUBE	01LC00BDG083	
7	FASTENING ON TUBE $\phi 34$	ELC 26-4.7.0	
6	FASTENING ON TUBE $\phi 60$	ELC 13-1.2.3.0	
5	$\phi 34-4$ REGISTRATION ARM WITH 1.1m STEADY ARM FOR CURVE	01LC00BDG151	201
4	INSULATED FOR STRUT TUBE $\phi 60$	01LC00BDG066	
3	INSULATED FOR TOP TUBE $\phi 60$	01LC00BDG064	
2	FASTENING FOR STRUT TUBE	or 01LC00BDG058 01LC00BDG071	
1	FASTENING FOR TOP TUBE	or 01LC00BDG059 01LC00BDG135	
ITEM	DESIGNATION	REFERENCE DRAWING	MARK

NOTE:

* EXACTE POSITION (HEIGHT, FIELD OR TRACK SIDE) WILL BE DEFINED DURING DETAIL DESIGN STAGE

MONTARE TIP ECHIPAMENT MEDIAN PENTRU LINIE CURENTA (ANSAMBLU TENSIONAT)
TYPICAL MID POINT EQUIPMENT ON OPEN ROUTE (PULL OF ASSEMBLY)

Numele fisierului/ CAD file name:	Scara/ Scale:	Part	Rev.
01LC00BDG230		2 / 2	0

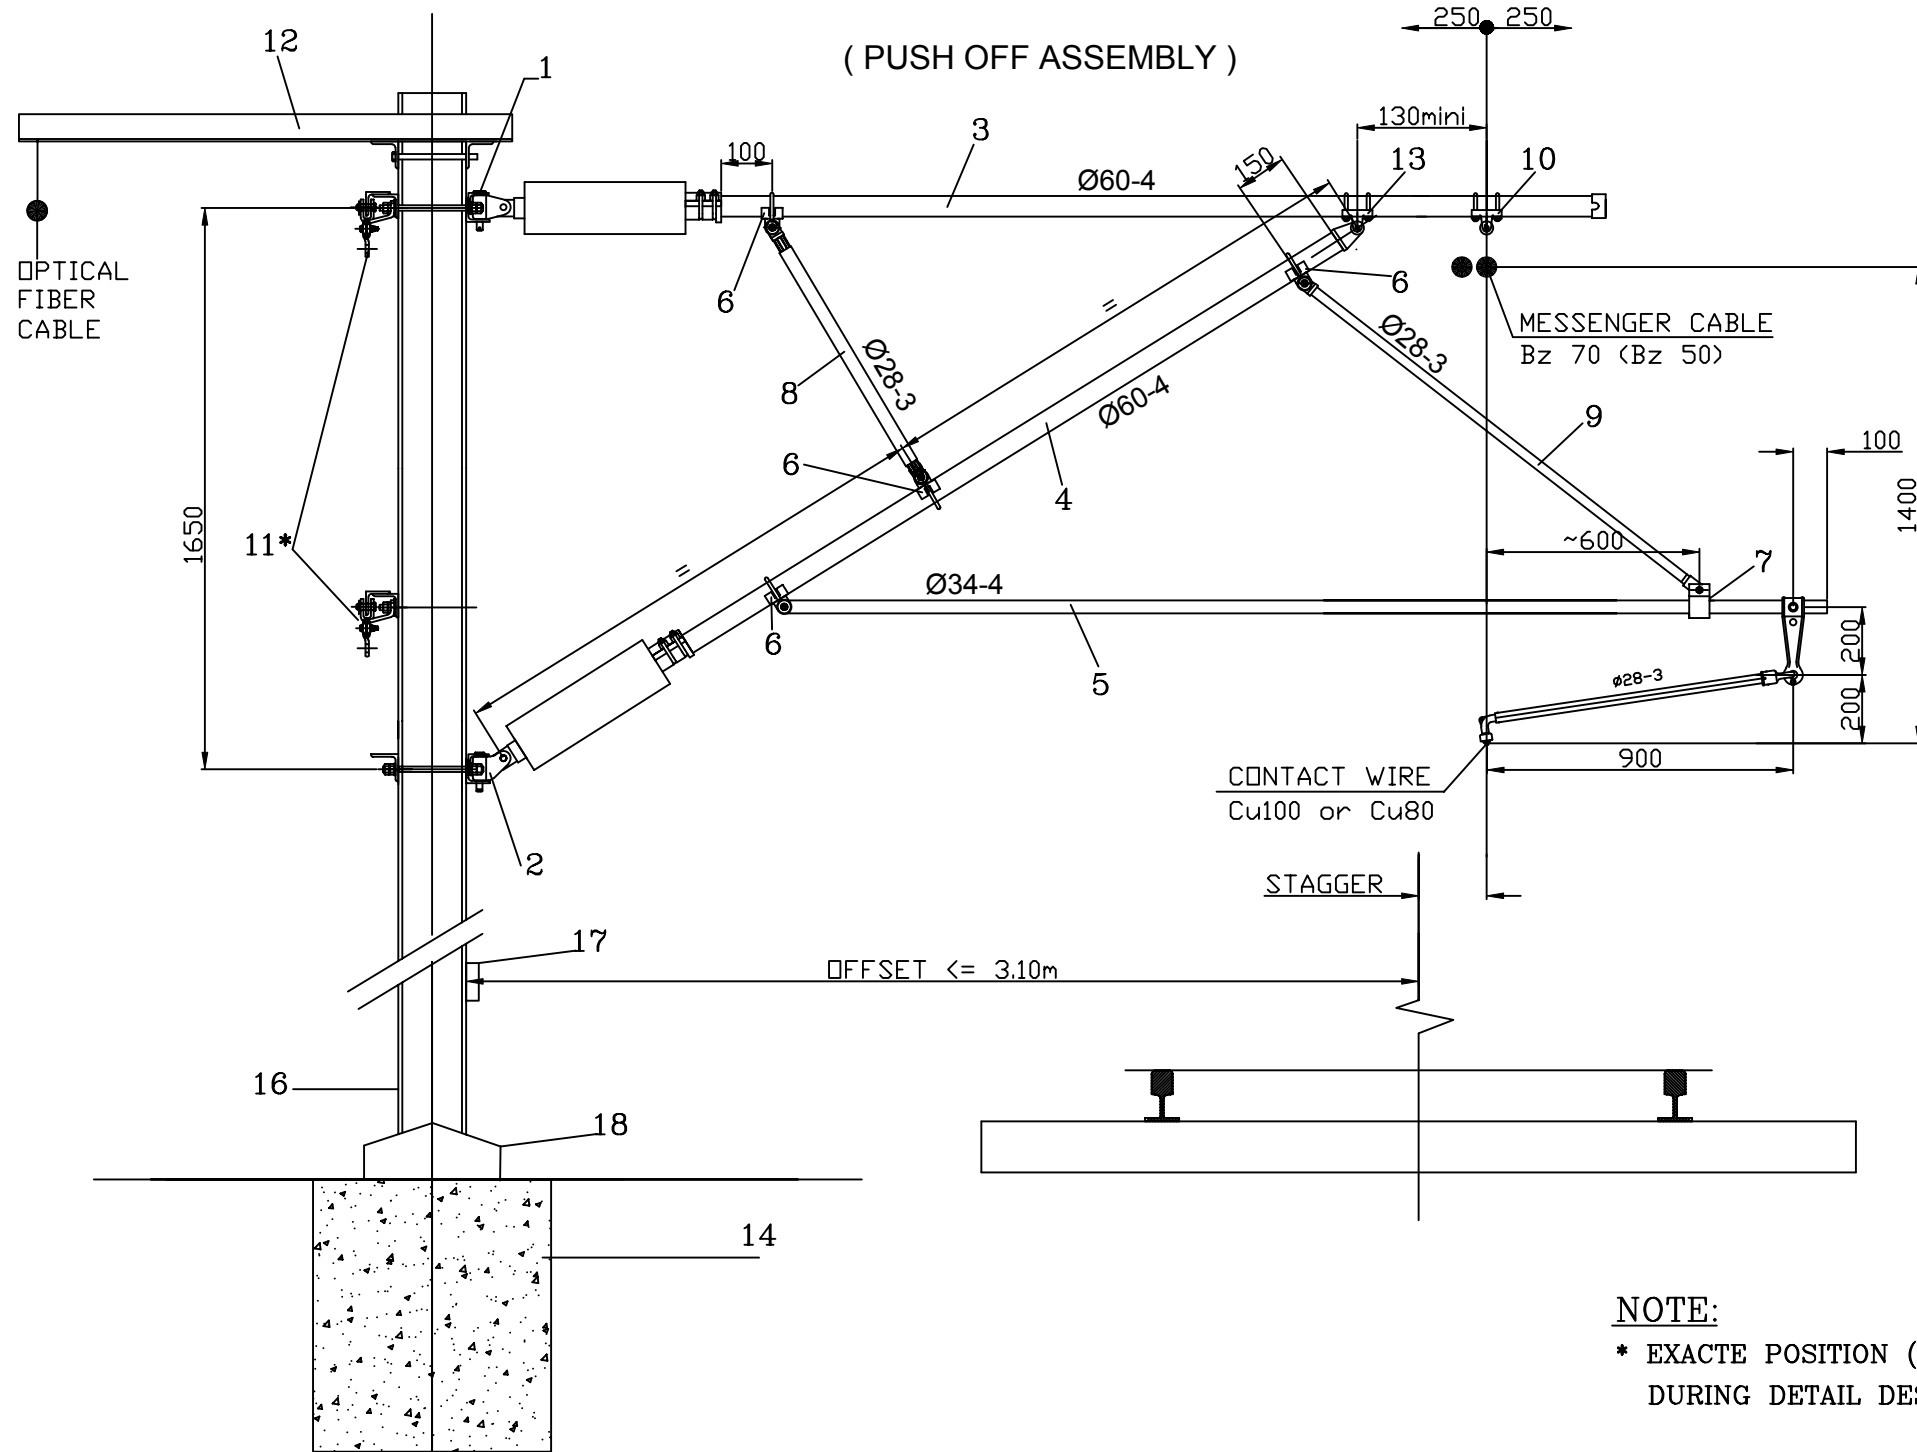


18	DICE PROTECTION	01LC00BDG008	
17	ASSEMBLY OF SAFETY DEVICES		
16	MAST TYPES AND REFERENCES	01LC00BDG010	
15	-	-	
14	FOUNDATION	01LC00BDG006	
13	FASTENING FOR TOP TUBE	01LC00BDG069	
12	OPTICAL FIBER BRACKET	01LC00BDG054	
11	EARTHING SUSPENSION	or 01LC00BDG071 01LC00BDG072	
10	SUSPENSION FOR MESSENGERS	01LC00BDG070	102
9	AUXILIARY STRUT TUBE	01LC00BDG083	
8	AUXILIARY STRUT TUBE	01LC00BDG083	
7	FASTENING ON TUBE Ø34	ELC 26-4.7.0	
6	FASTENING ON TUBE Ø60	ELC 13-1.2.3.0	
5	Ø34-4 REGISTRATION ARM WITH 0.9m STEADY ARM FOR STRAIGHT LINE	01LC00BDG150	202
4	INSULATED FOR STRUT TUBE Ø60	01LC00BDG066	
3	INSULATED FOR TOP TUBE Ø60	01LC00BDG064	
2	FASTENING FOR STRUT TUBE	or 01LC00BDG058 01LC00BDG071	
1	FASTENING FOR TOP TUBE	or 01LC00BDG059 01LC00BDG135	
ITEM	DESIGNATION	REFERENCE DRAWING	MARK

NOTE:

* EXACTE POSITION (HEIGHT, FIELD OR TRACK SIDE) WILL BE DEFINED DURING DETAIL DESIGN STAGE

MONTARE TIP ECHIPAMENT MEDIAN PENTRU LINIE CURENTA (ANSAMBLU COMPRIMAT)	Numele fisierului/ CAD file name:	Scara/ Scale:	Part	Rev.
TYPICAL MID POINT EQUIPMENT ON OPEN ROUTE (PUSH OFF ASSEMBLY)	01LC00BDG231		1 / 2	0

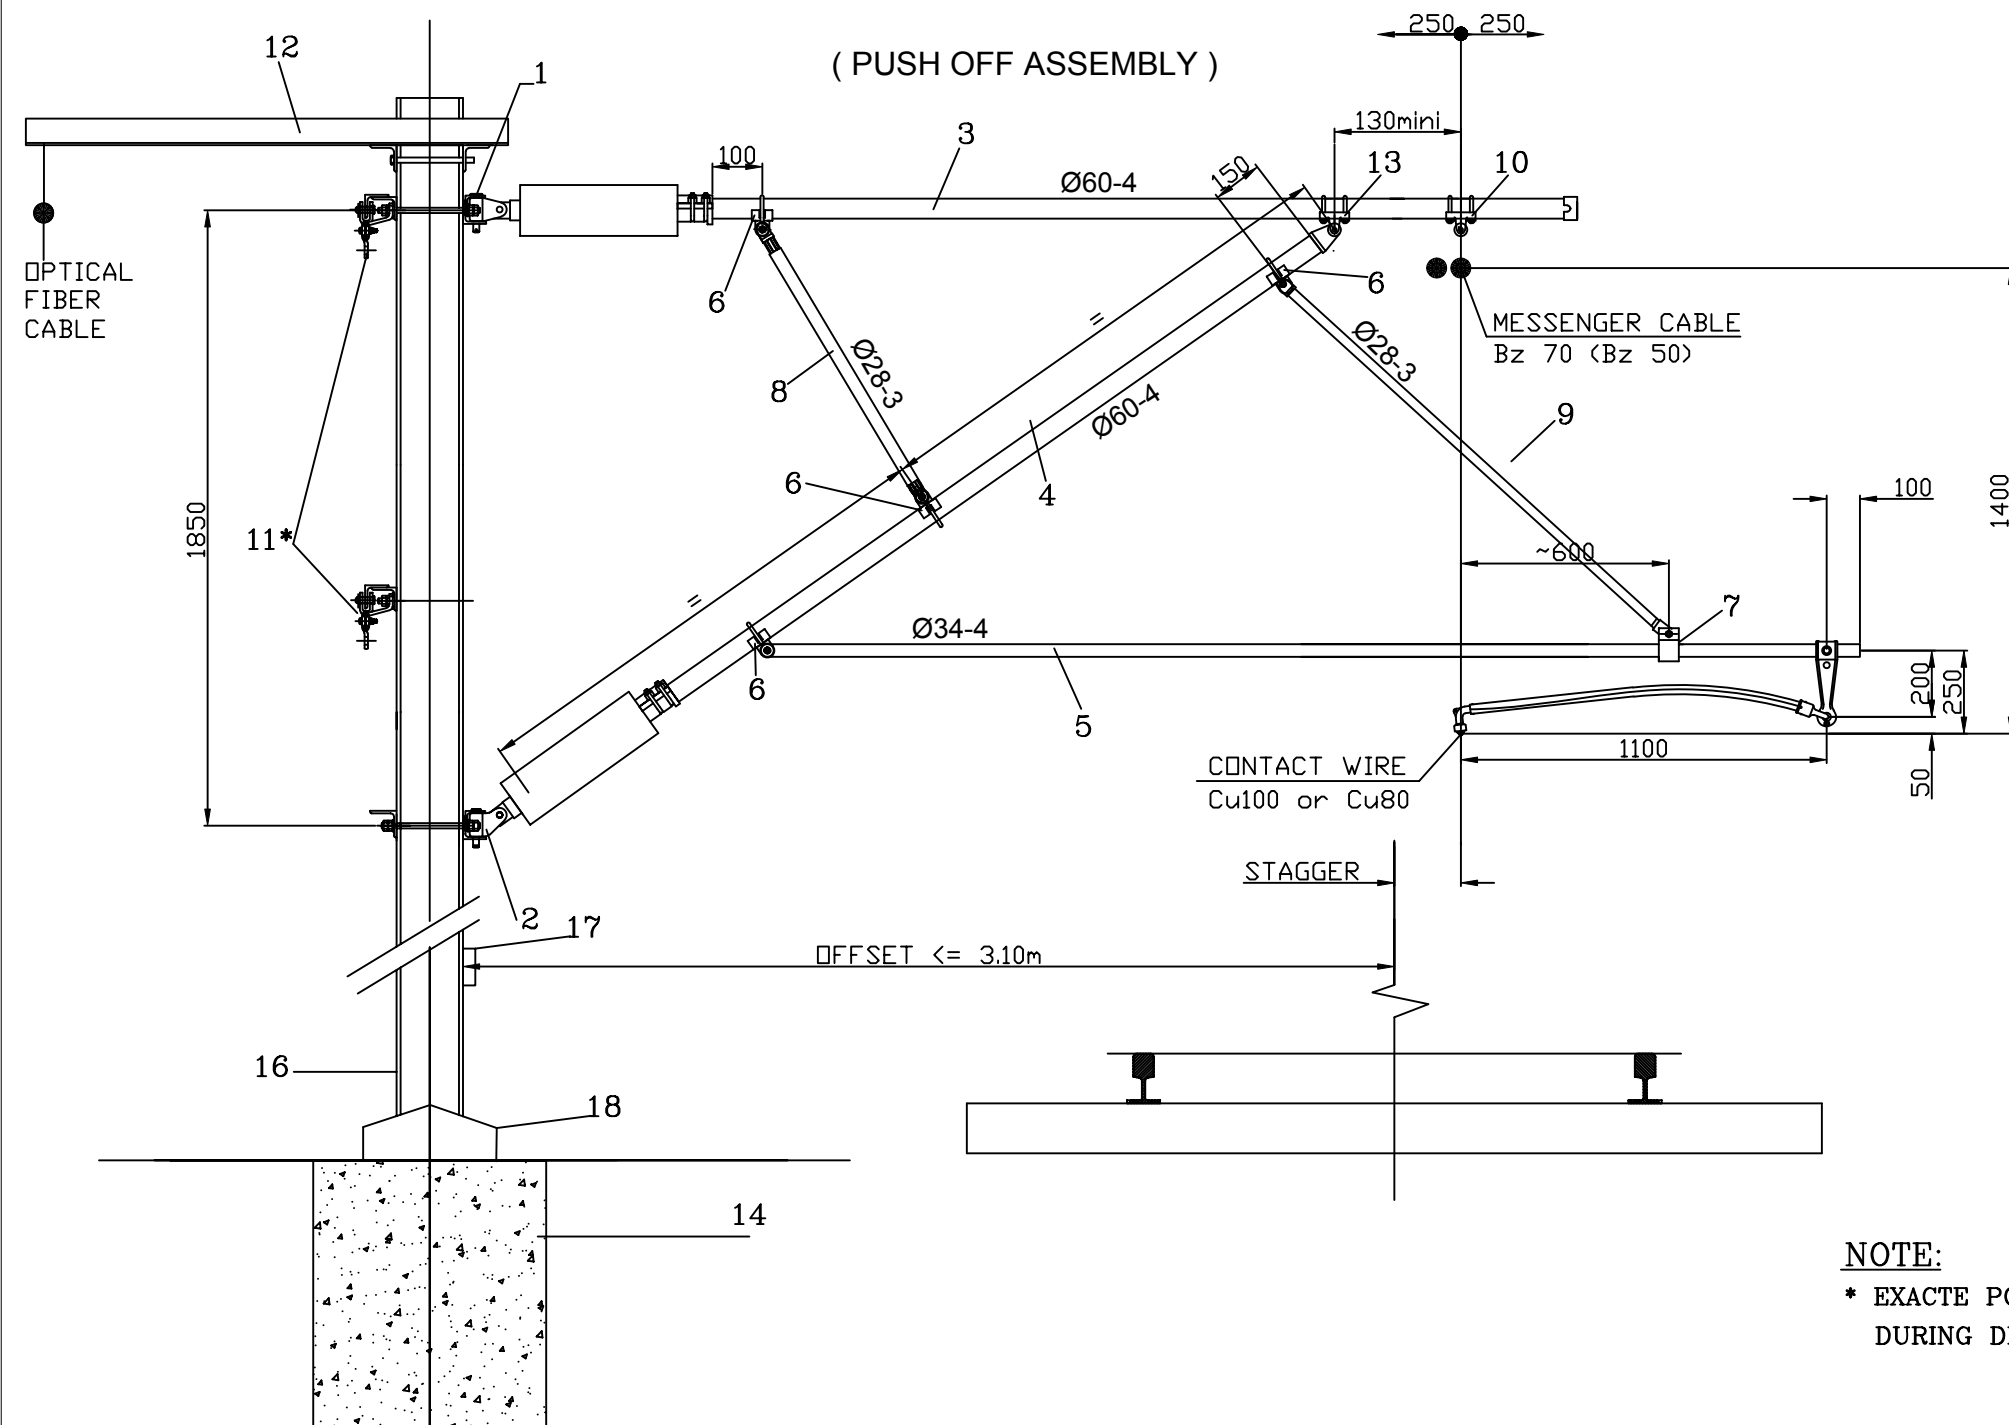


18	DICE PROTECTION	01LC00BDG008	
17	ASSEMBLY OF SAFETY DEVICES		
16	MAST TYPES AND REFERENCES	01LC00BDG010	
15	-	-	
14	FOUNDATION	01LC00BDG006	
13	FASTENING FOR TOP TUBE	01LC00BDG069	
12	OPTICAL FIBER BRACKET	01LC00BDG054	
11	EARTHING SUSPENSION	or 01LC00BDG071 01LC00BDG072	
10	SUSPENSION FOR 2 MESSENGERS	01LC00BDG070	102
9	AUXILIARY STRUT TUBE	01LC00BDG083	
8	AUXILIARY STRUT TUBE	01LC00BDG083	
7	FASTENING ON TUBE Ø34	ELC 26-4.7.0	
6	FASTENING ON TUBE Ø60	ELC 13-1.2.3.0	
5	Ø34-4 REGISTRATION ARM WITH 1.1m STEADY ARM FOR CURVE	01LC00BDG151	202
4	INSULATED FOR STRUT TUBE Ø60	01LC00BDG066	
3	INSULATED FOR TOP TUBE Ø60	01LC00BDG064	
2	FASTENING FOR STRUT TUBE	or 01LC00BDG058 01LC00BDG071	
1	FASTENING FOR TOP TUBE	or 01LC00BDG059 01LC00BDG135	
ITEM	DESIGNATION	REFERENCE DRAWING	MARK

NOTE:

* EXACTE POSITION (HEIGHT, FIELD OR TRACK SIDE) WILL BE DEFINED DURING DETAIL DESIGN STAGE


MONTARE TIP ECHIPAMENT MEDIAN PENTRU LINIE CURENTA (ANSAMBLU COMPRIMAT)	Numele fisierului/ CAD file name:	Scara/ Scale:	Part	Rev.
TYPICAL MID POINT EQUIPMENT ON OPEN ROUTE (PUSH OFF ASSEMBLY)	01LC00BDG231		2 / 2	0

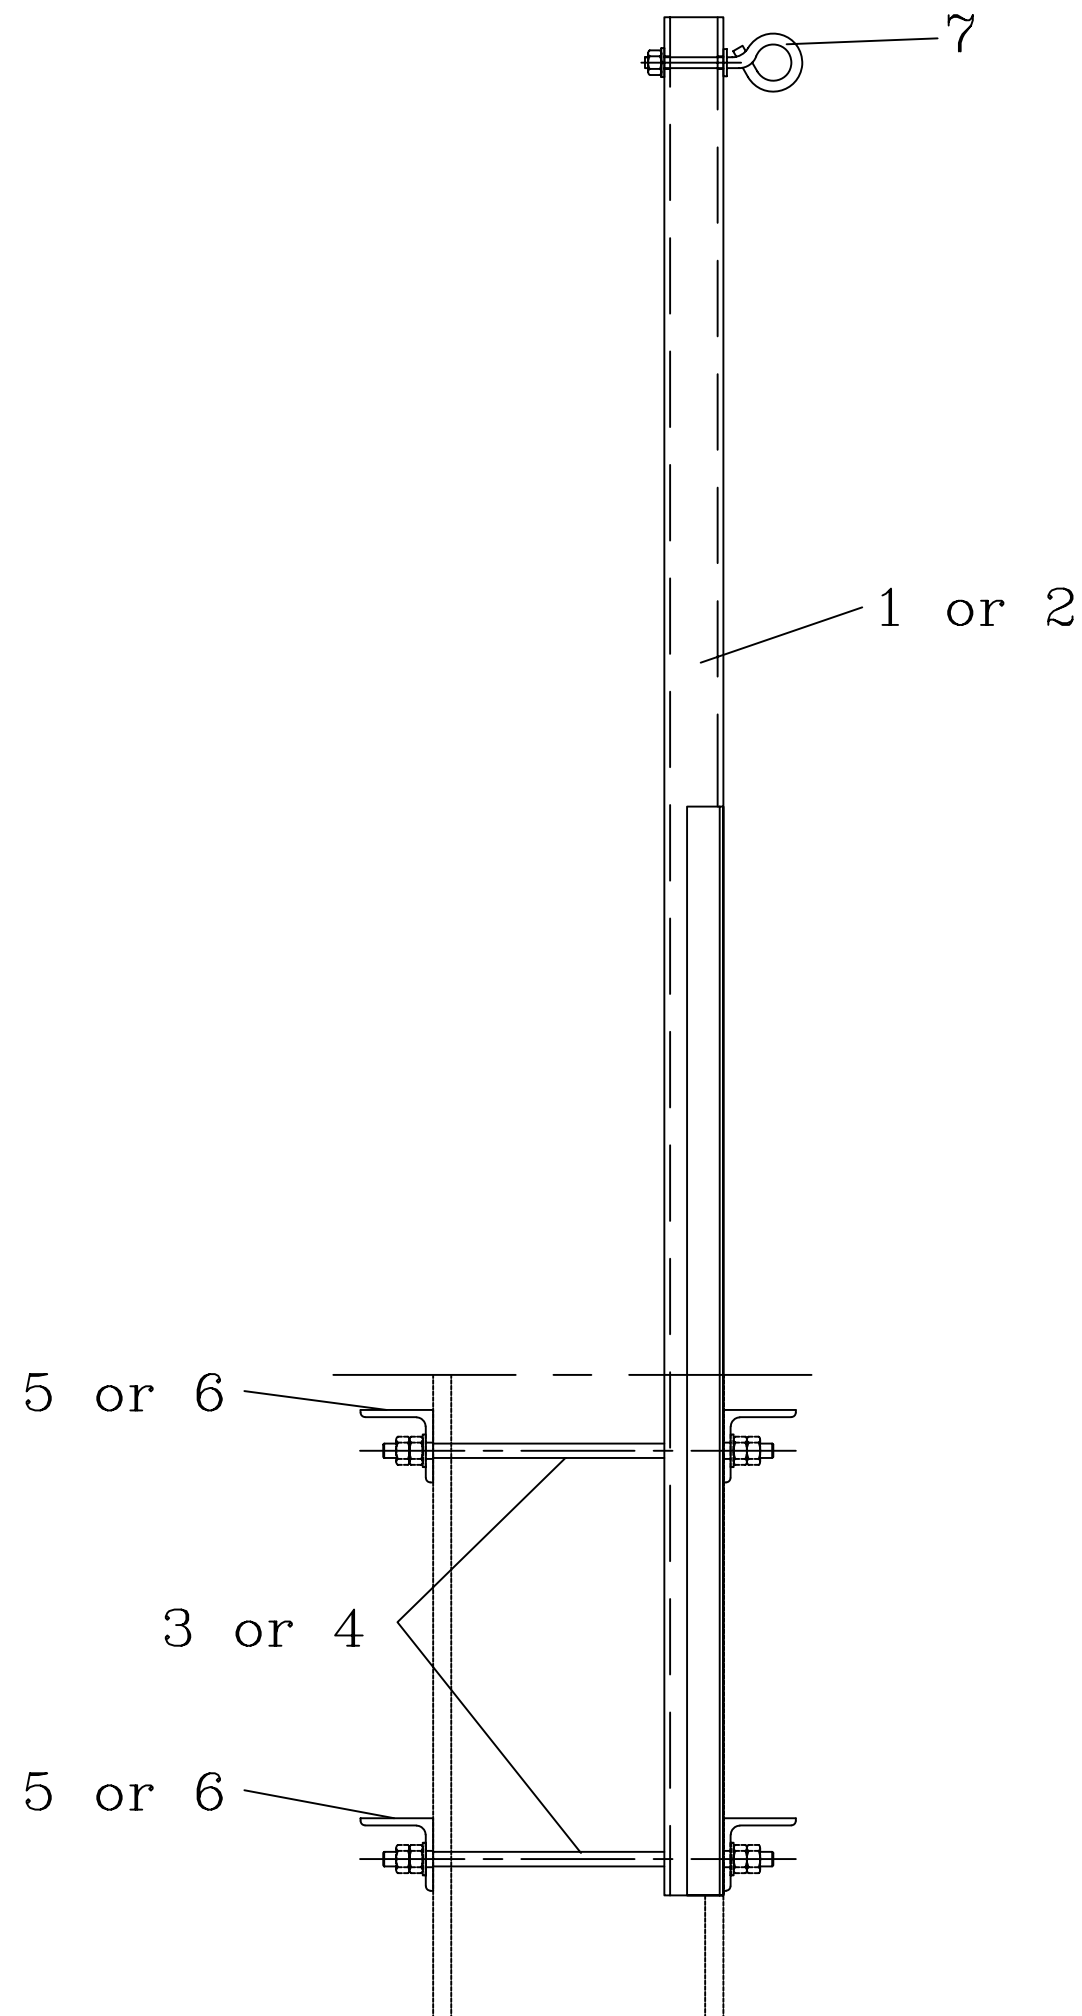

FROM HE 200 TO HE240	101
FROM HE 260 TO HE320	102

MARK GROUP	QUANTITY	ITEM	DESIGNATION	UNIT MASS	REFERENCE DRAWING	MARK
102	1	7	SUPPORT RING TYPE II	.024	ELC/CF0 3-15.0	
101	2	6	COUNTERPLATE FOR OPTICAL FIBER	3.85	01LC00BDG087	204
	2	5	COUNTERPLATE FOR OPTICAL FIBER	3.08	01LC00BDG087	104
	4	4	THREADED ROD M12-400/100	0.35	01LC00BDG141	1211D2
	4	3	THREADED ROD M12-350/100	0.30	01LC00BDG141	1211C2
	1	2	SUPPORT FOR OPTICAL FIBER	28.00	01LC00BDG252	102
	1	1	SUPPORT FOR OPTICAL FIBER	26.34	01LC00BDG252	101


VARFAR CU INEL PENTRU FIBRA OPTICA SURELEVATED SUPPORT FOR OPTICAL FIBER WITH RING	Numele fisierului/ CAD file name:	Scara/ Scale:	Part	Rev.
	01LC00BDG250		1 / 1	0

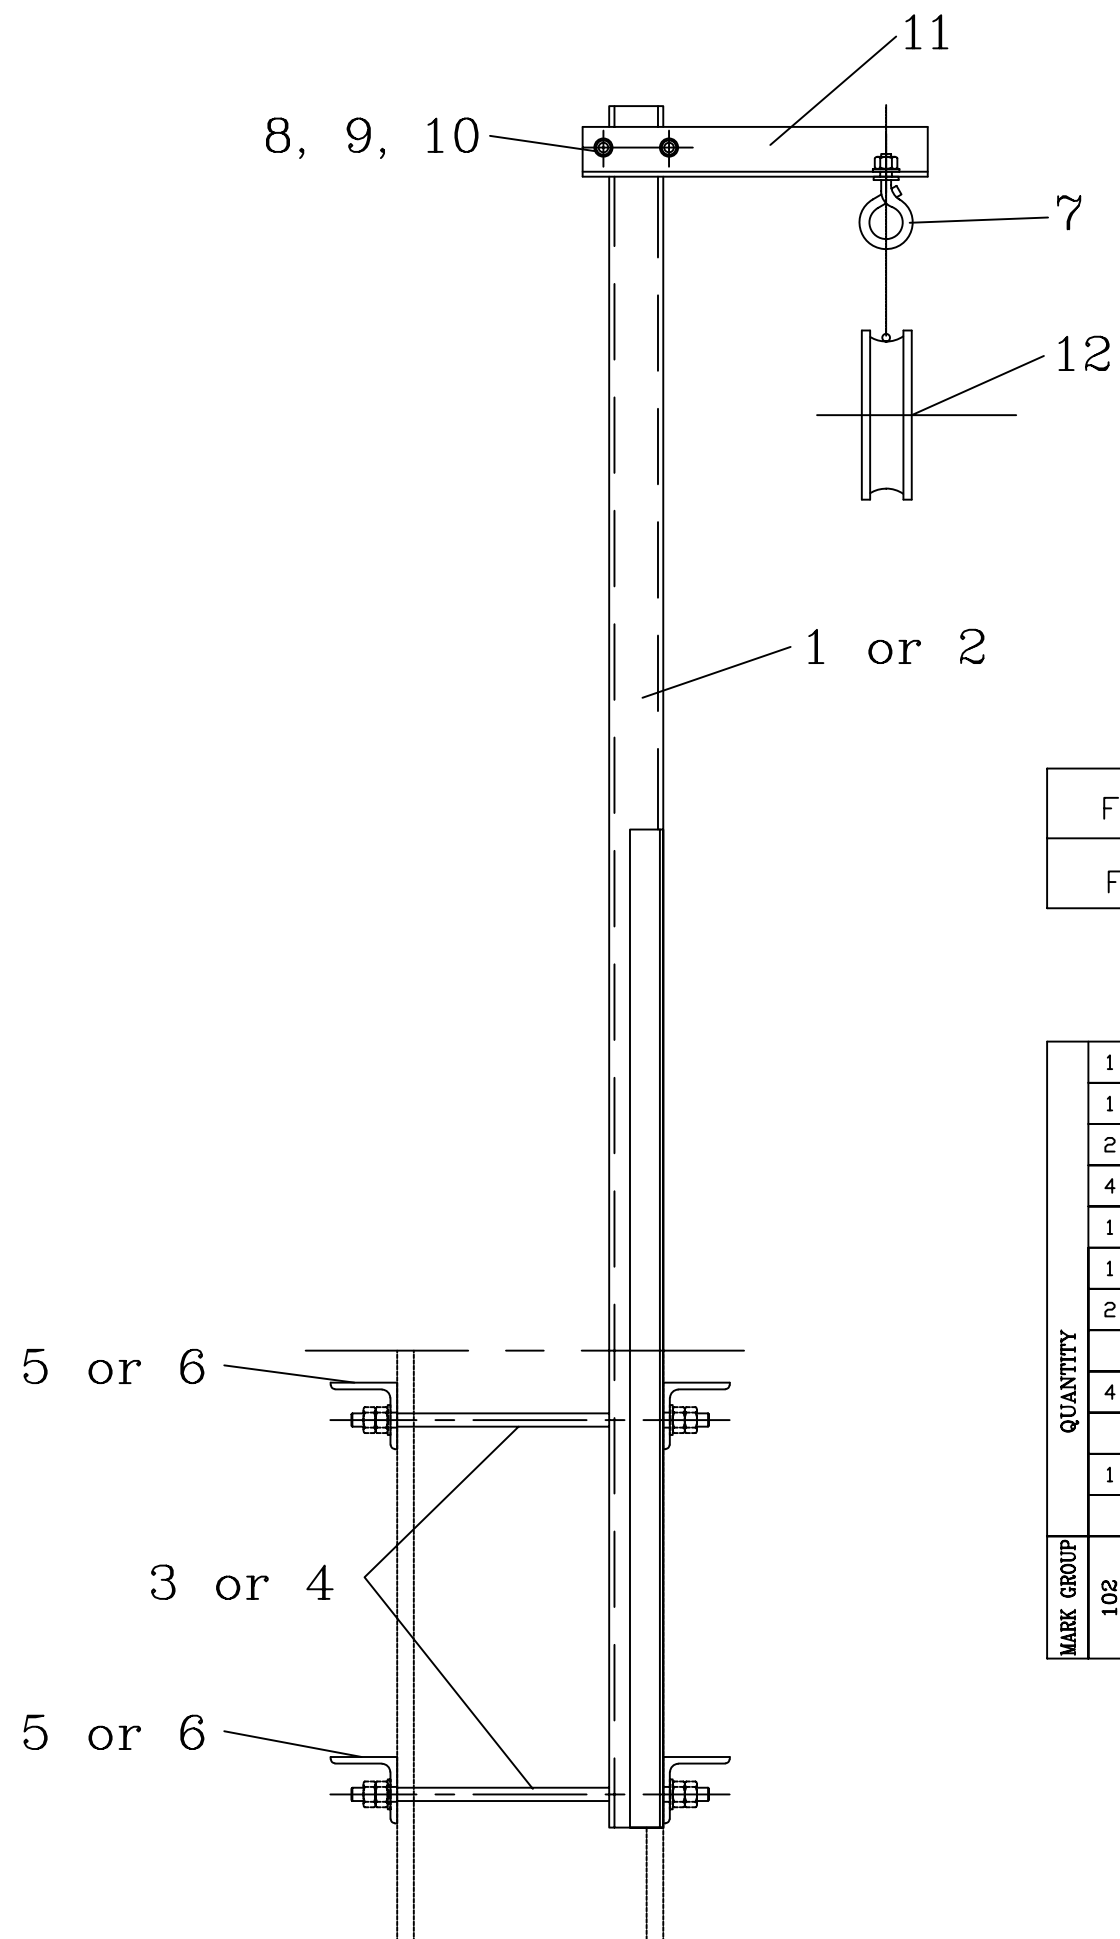

FROM HE 200 TO HE240	101
FROM HE 260 TO HE320	102

MARK GROUP	QUANTITY	ITEM	DESIGNATION	UNIT MASS	REFERENCE DRAWING	MARK
102	1	12	PULLEY ASSEMBLY (TYPE R)	-	BE-F' 13252	
101	1	11	COUNTERPLATE	2.25	01LC00BDG254	
	2	10	WASHER M12	0.03	SR EN 7089/4	
	4	9	NUT M12-gr8	0.02	SR EN ISD 4032	
	1	8	STRUT	0.26	01LC00BDG253	
	1	7	PULLEY SUPPORT RING (TYPE A)	0.24	ELC/CF0 3-15.0 B	
	2	6	COUNTERPLATE FOR OPTICAL FIBER	3.85	01LC00BDG087	204
	2	5	COUNTERPLATE FOR OPTICAL FIBER	3.08	01LC00BDG087	104
	4	4	THREADED ROD M12-400/100	0.35	01LC00BDG141	1211D2
	4	3	THREADED ROD M12-350/100	0.30	01LC00BDG141	1211C2
	1	2	SUPPORT FOR OPTICAL FIBER	28.00	01LC00BDG252	102
	1	1	SUPPORT FOR OPTICAL FIBER	26.34	01LC00BDG252	101

VARFAR CU ROLA PENTRU FIBRA OPTICA SURELEVATED SUPPORT FOR OPTICAL FIBER WITH PULLEY	Numele fisierului/ CAD file name:	Scara/ Scale:	Part	Rev.
	01LC00BDG251		1 / 1	0

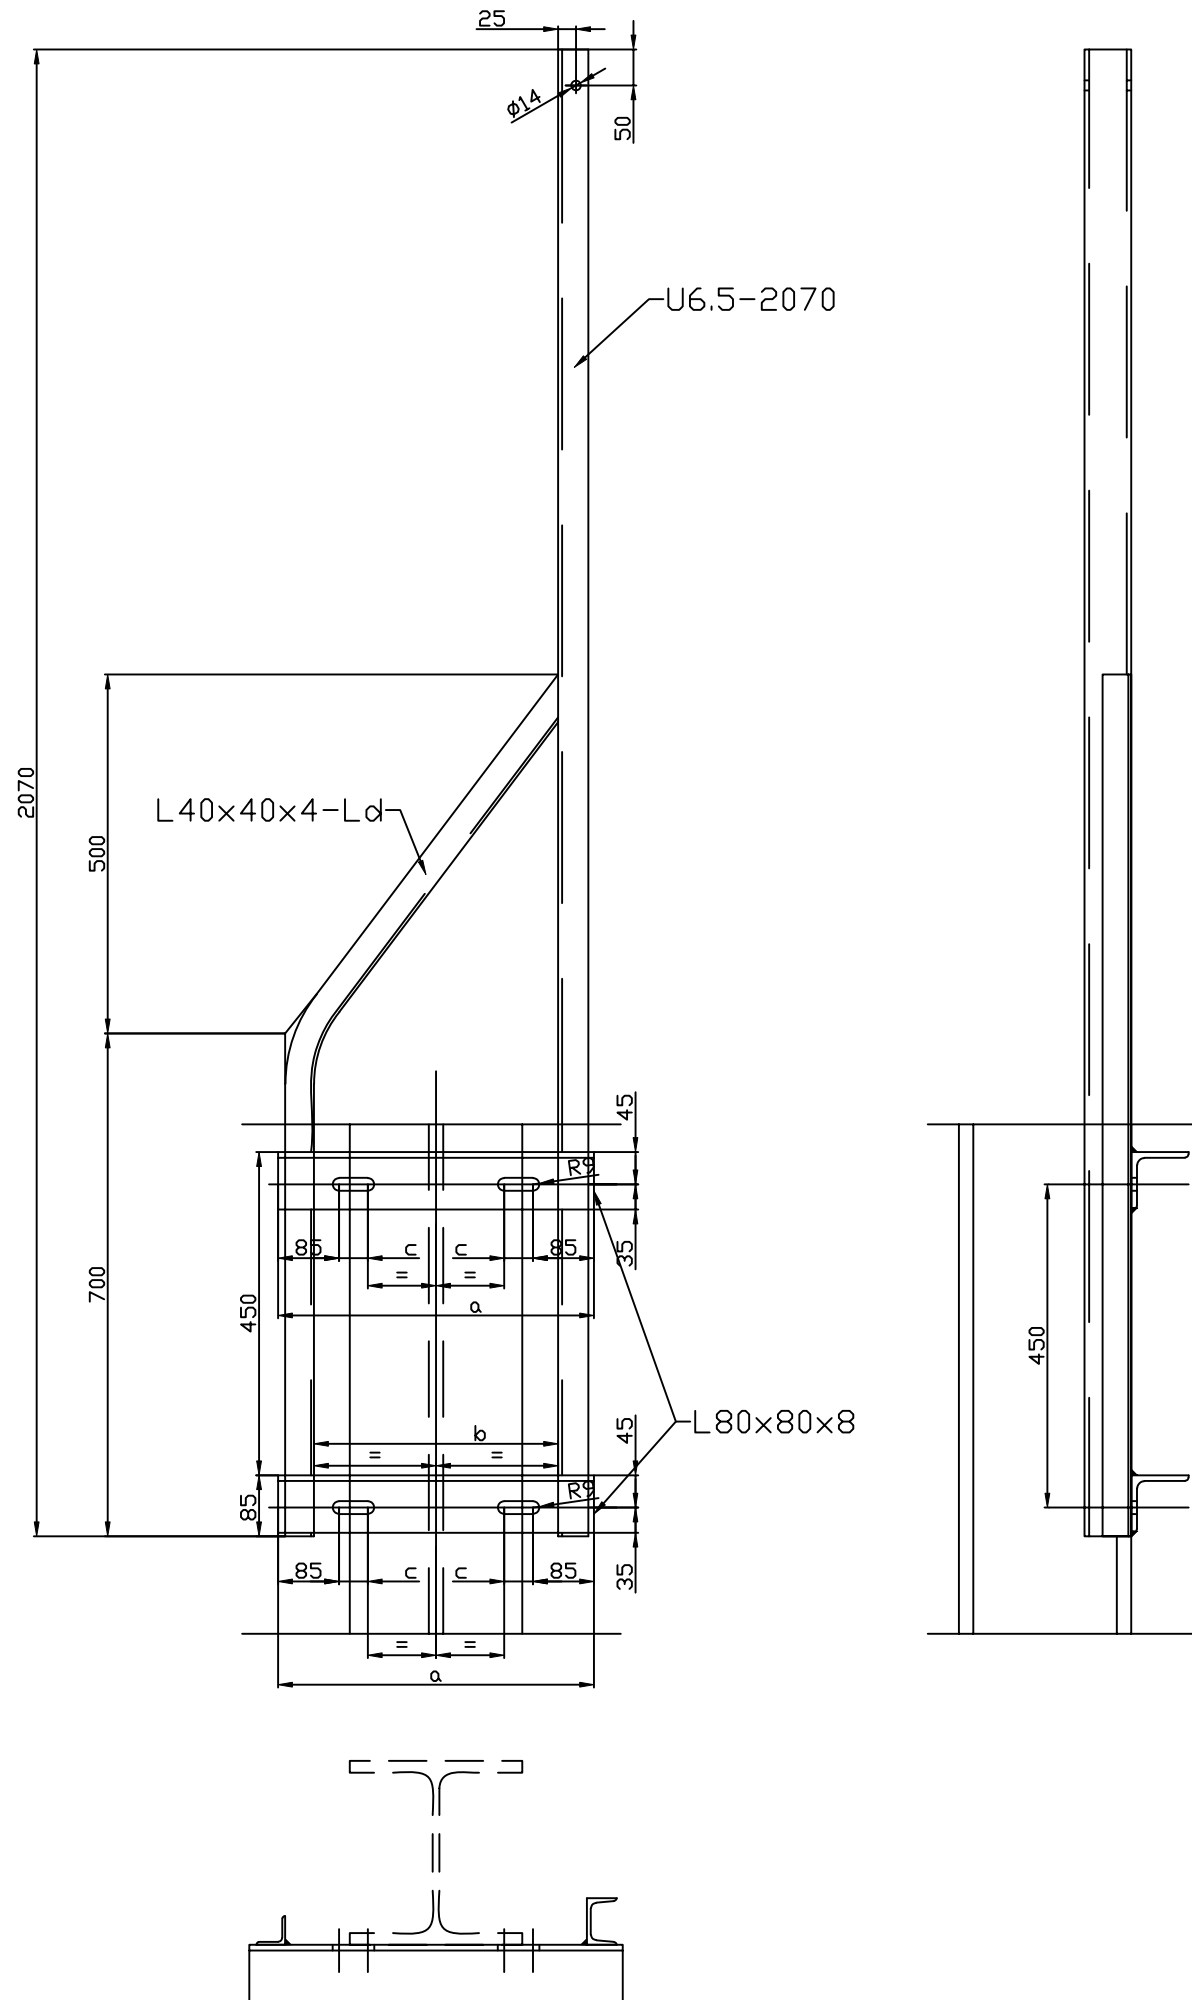

NOTE:

1. Continuous bead waterproof welds minimum thickness: 3.5mm
2. After welding and drilling, the assembly will be hot galvanized AT/OL/Zn600-STAS 7221-90

	Ld	a	b	c	
FROM HE 200 TO HE240	101	1323	440	340	40
FROM HE 260 TO HE320	102	1374	520	420	45

03LC00BDG252	***	SUPPORT FOR OPTICAL FIBER	S235JR	-
DRAWING NUMBER	MARK	DESIGNATION	MATERIAL TECHNICAL SPECIFICATION	UNIT MASS kg


SUPORT PENTRU FIBRA OPTICA
SUPPORT FOR OPTICAL FIBER

Numele fisierului/
CAD file name:
01LC00BDG252

Scara/
Scale:

Part
1 / 1


Rev.
0

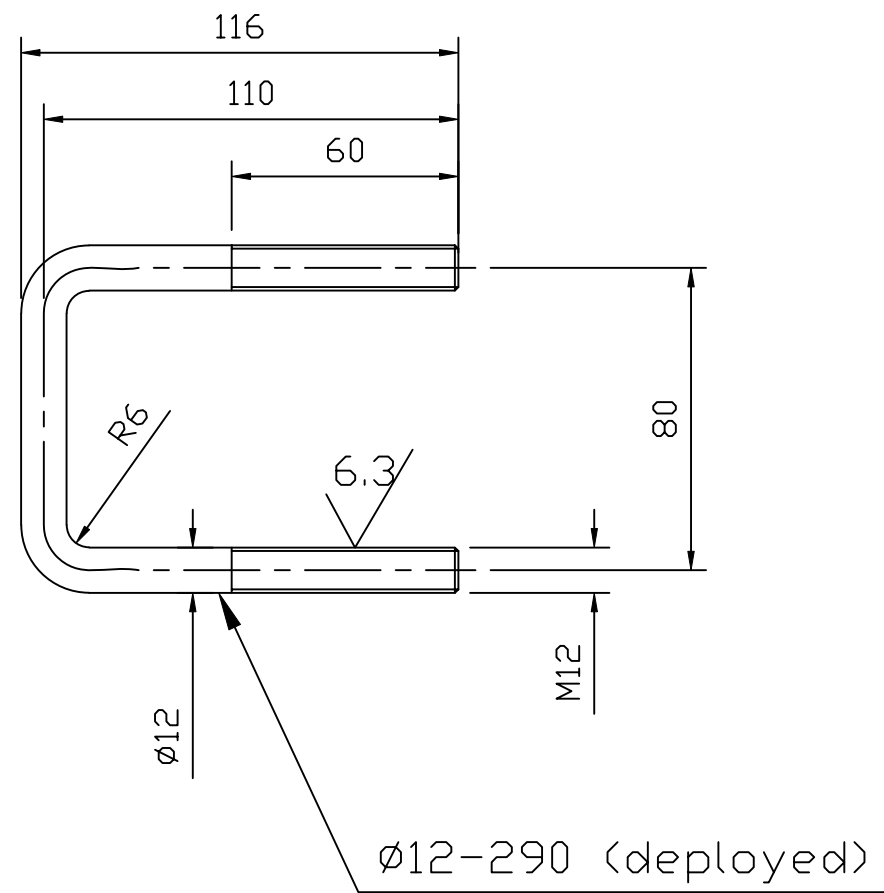

NOTE:

Will be hot galvanized AT/OL/Zn500, except threaders AT/OL/Zn310-STAS 7221-90.
 MATERIAL: S275JR

BOLT STRUT	Numele fisierului/ CAD file name:	Scara/ Scale:	Part	Rev.
	01LC00BDG253		1 / 1	0

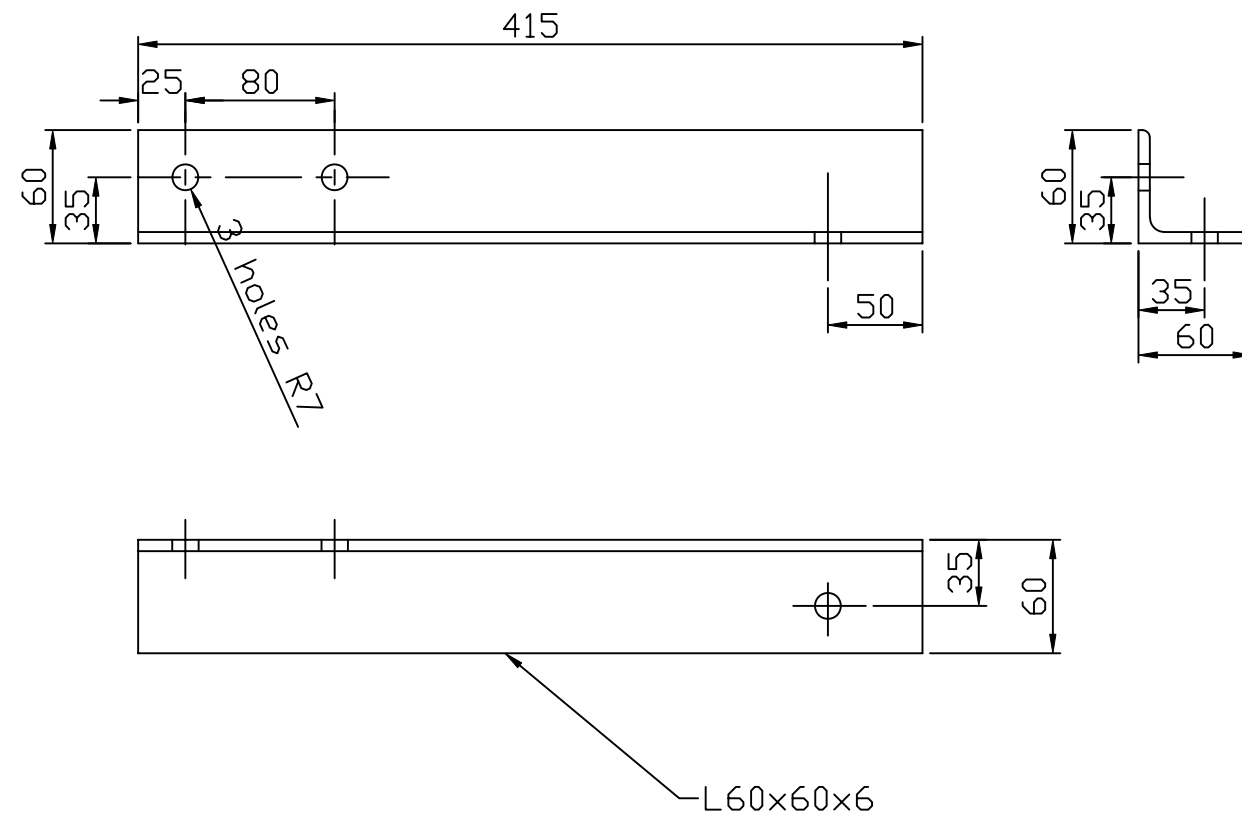

Note : After welding and drilling will be hot galvanized AT/OL/Zn600-STAS 7221-90.




01LC00BDG254	101	COUNTERPLATE (L 60*60*6)	S235JR	
DRAWING NUMBER	MARK	DESIGNATION	MATERIAL TECHNICAL SPECIFICATION	UNIT MASS kg

CONTRASUPORT
COUNTERPLATE

Numele fisierului/
CAD file name:
01LC00BDG254

Scara/
Scale:


Part	Rev.
1 / 1	0

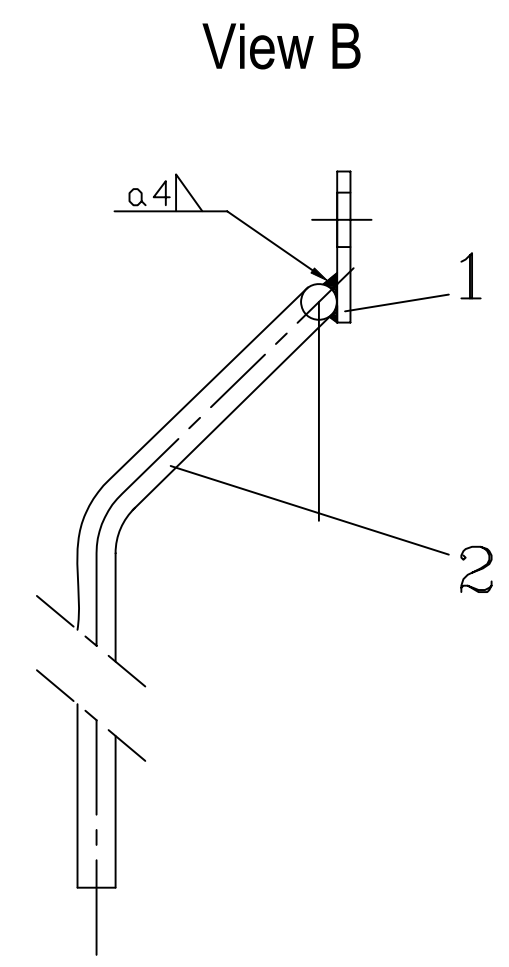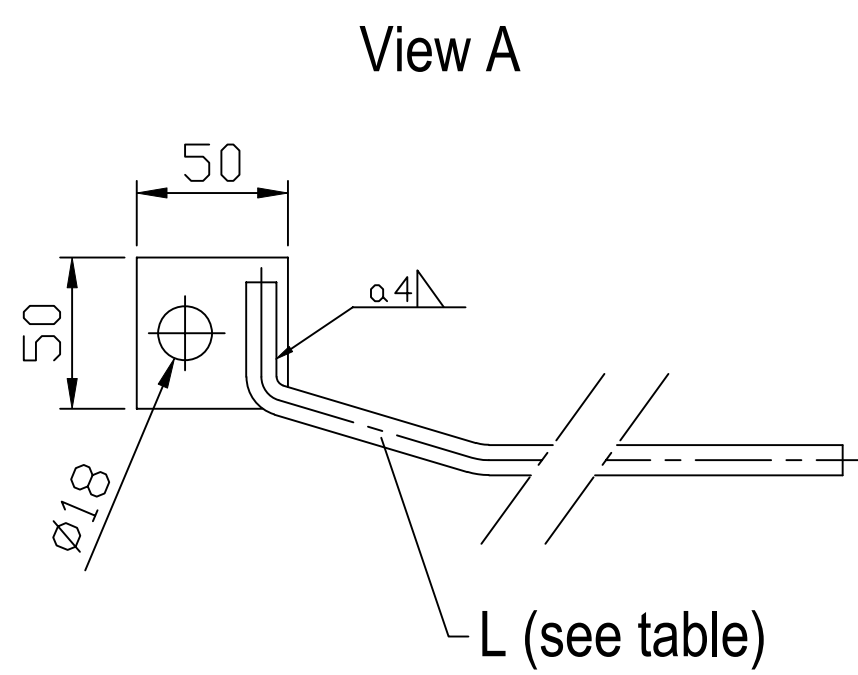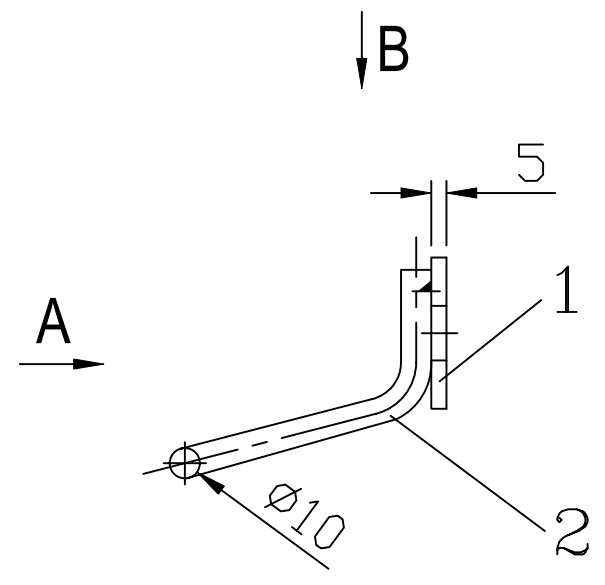


NOTE:
 Continuous bead waterproof welds minimum thickness: 4mm
 Between square washer and concrete steel rod

ITEM	DESIGNATION	Material	L (mm)			Mark group
			101	102	103	
2	CONCRETE STEEL ROD Ø10	S235JR	400	700	900	
1	SQUARE WASHER TYPE II	S235JR				

CONEXIUNE DE IMPAMANTARE EARTH CONNECTION	Numele fisierului/ CAD file name:	Scara/ Scale:	Part	Rev.
	01LC00BDG260		1 / 1	0

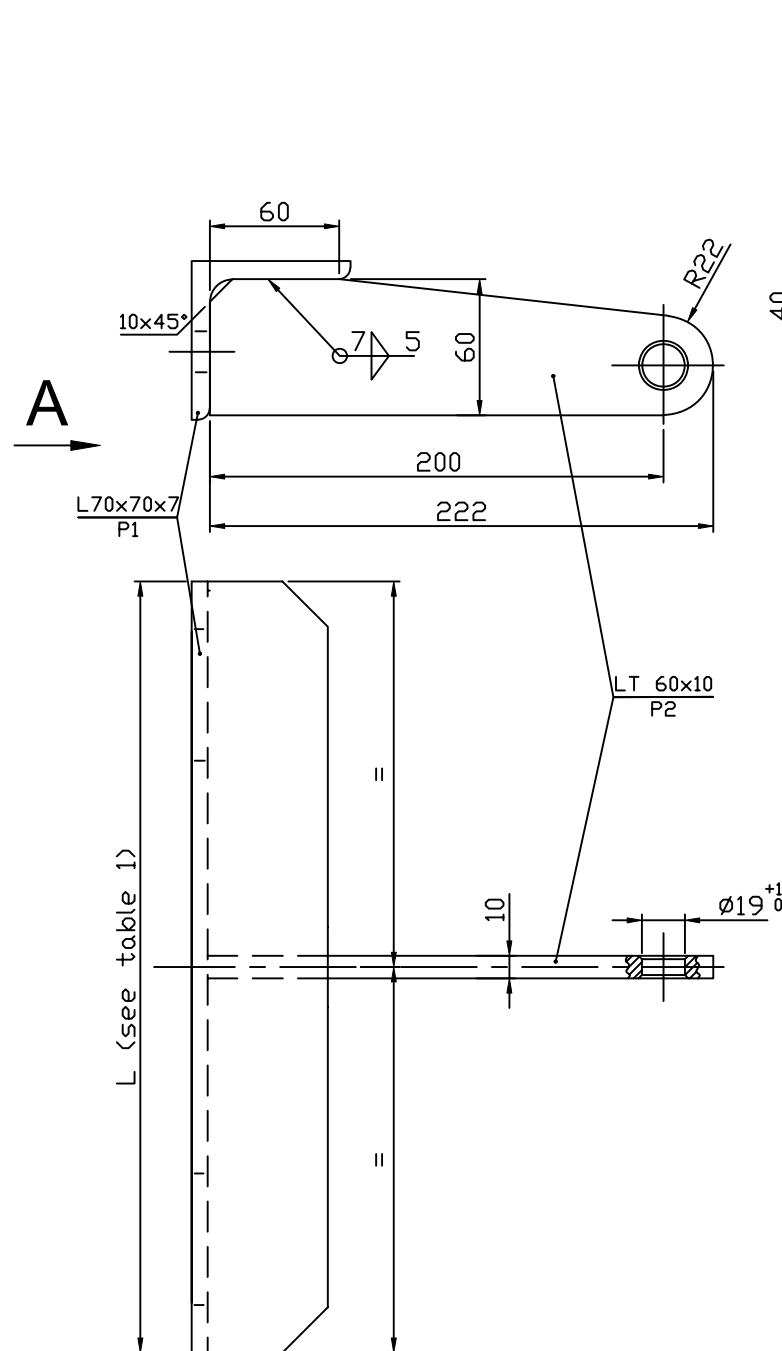


Mark 101
FROM HE 200 TO 240

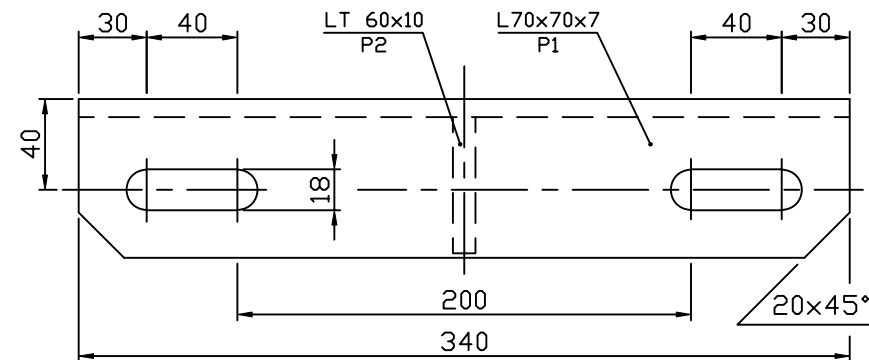

View A

Mark 102
FROM HE 260 TO 320

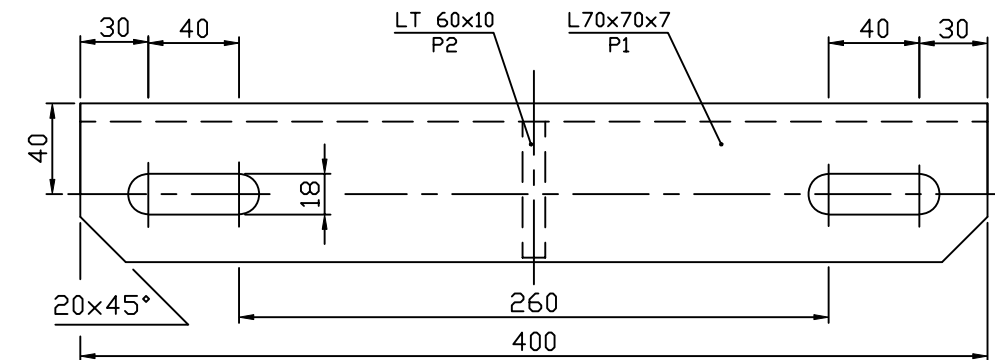

MARK	DESIGNATION	L
101	FROM HE 200 TO 240	340
102	FROM HE 260 TO 320	400

After welding and drilling will
be hot galvanized AT/OL/Zn600-STAS 7221-90.

102	COUNTERPLATE (L 70*70*7)	S235JR	3.36
101	COUNTERPLATE (L 70*70*7)	S235JR	2.86
MARK	DESIGNATION	MATERIAL TECHNICAL SPECIFICATION	UNIT MASS kg



CONTRASUPORT SPECIAL
SPECIAL COUNTERPLATE

Numele fisierului/
CAD file name:
01LC00BDG261


Scara/
Scale:

Part
1 / 1

Rev.
0

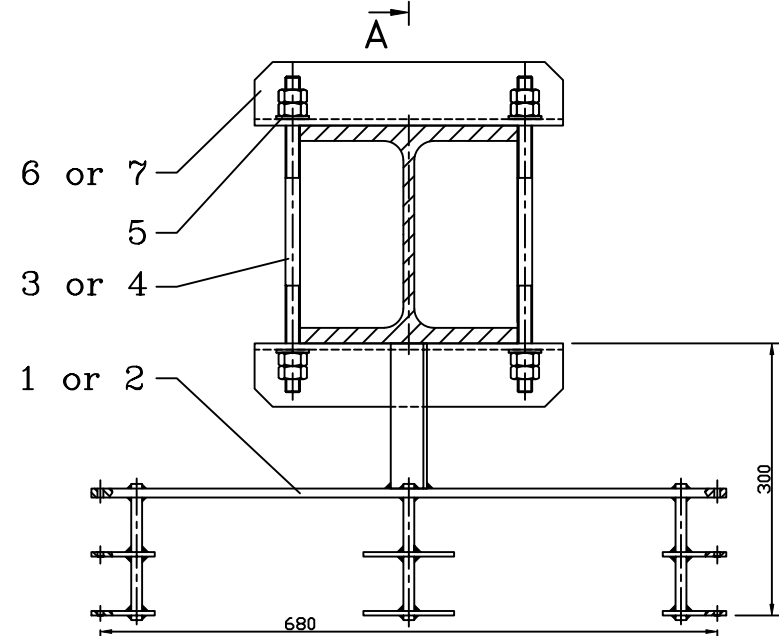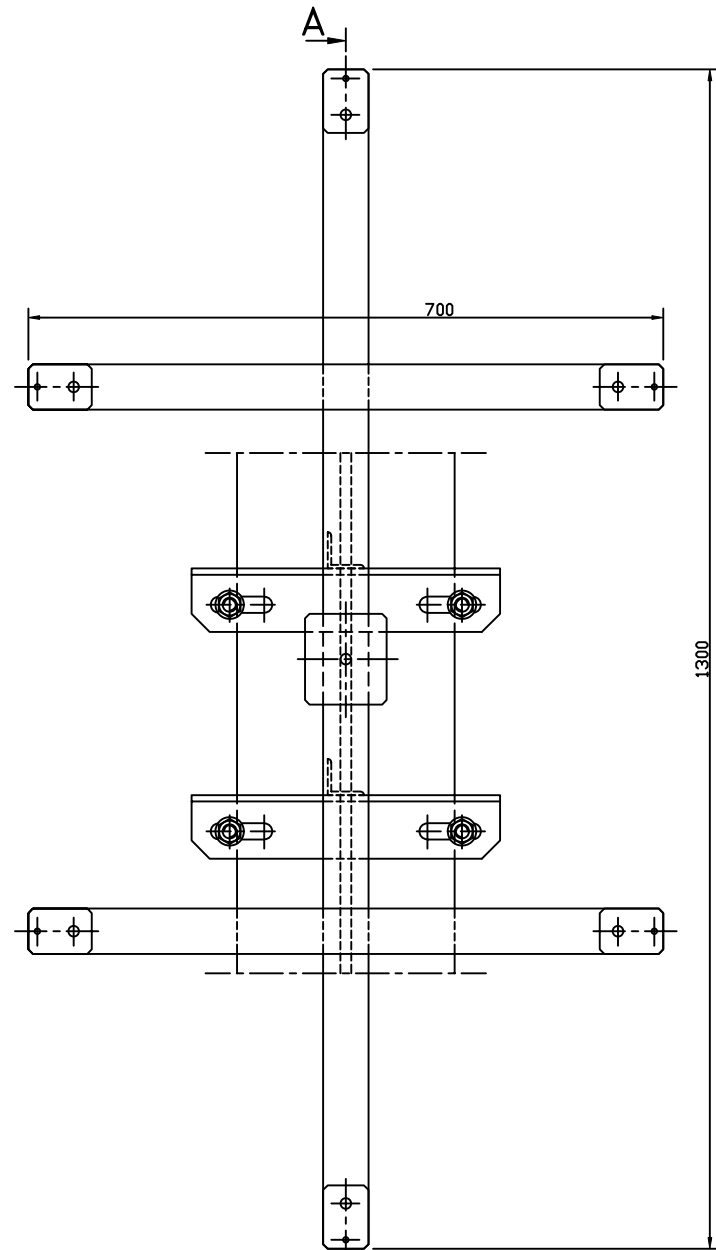

A-A

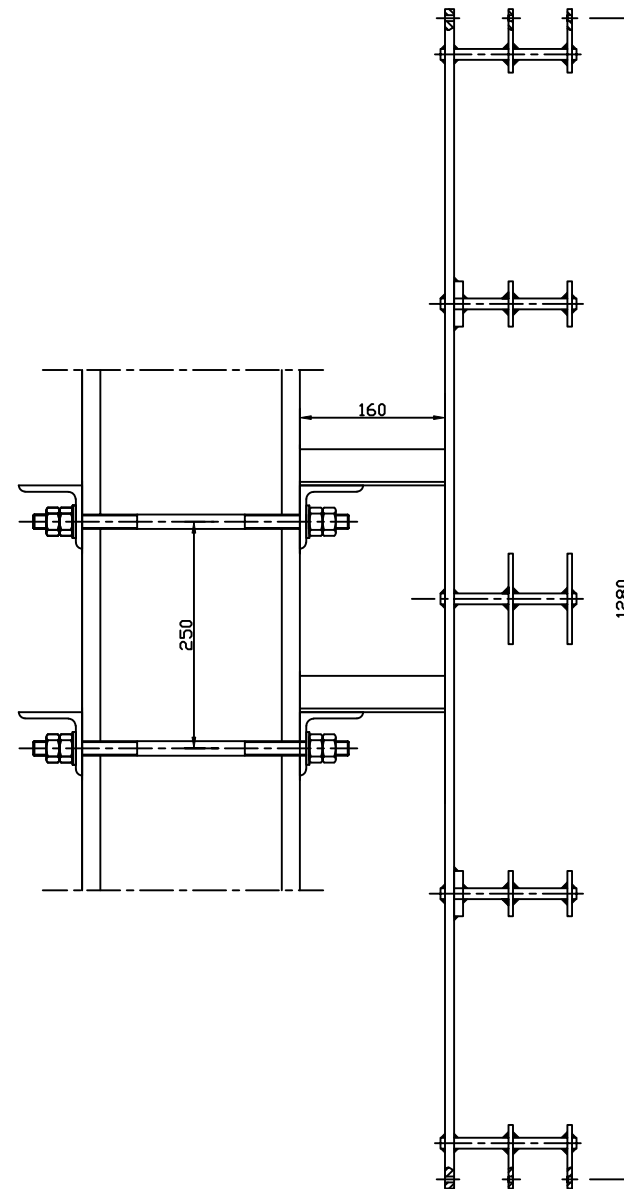







MARK	DESIGNATION
101	FROM HE 200 TO 240
102	FROM HE 260 TO 320

MARK. GROUP	QUANTITY	ITEM	DESIGNATION	UNIT MASS	REFERENCE DRAWING	MARK	
102	1	7	COUNTERPLATE	3.36	01LC00BDG090	102	
101	1	6	COUNTERPLATE	2.86	01LC00BDG090	101	
	4	4	5	WASHER M16	0.03	01LC00BDG142	16A110
	2	4	3	THREADED ROD M16- 350/100	0.55	01LC00BDG141	1611C3
	1	2	2	THREADED ROD M16- 450/100	0.70	01LC00BDG141	1611E4
	1	2	1	Q.F. SUPPORT	18.11	01LC00BDG271	102
	1	1	1	Q.F. SUPPORT	17.21	01LC00BDG271	101
					kg		

ANSAMBLU SUPTOR PENTRU FIBRA OPTICA
OPTICAL FIBER SUPPORT ASSEMBLY

Numele fisierului/
CAD file name:
01LC00BDG270


Scara/ Scale:	Part	Rev.
	1 / 1	0

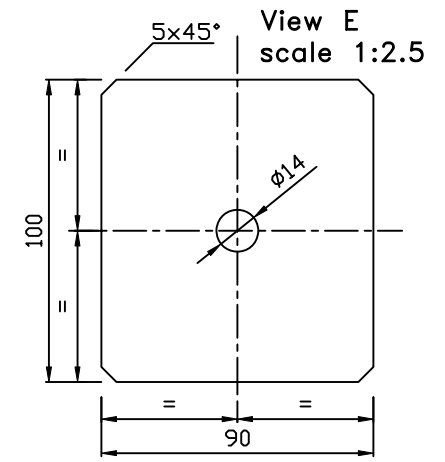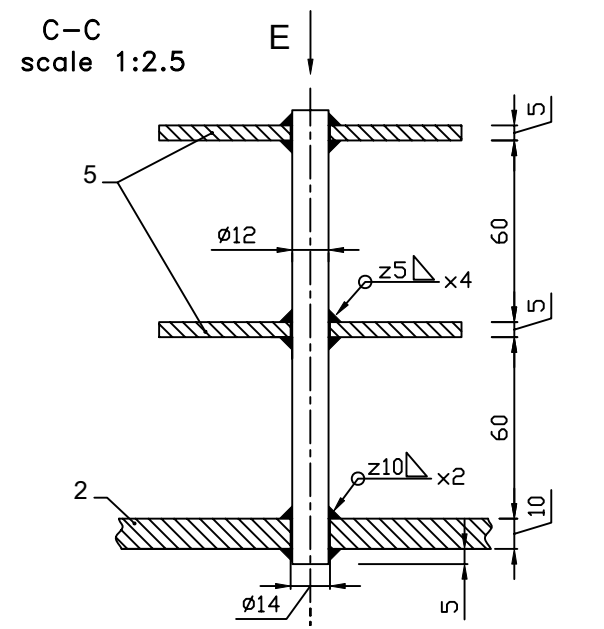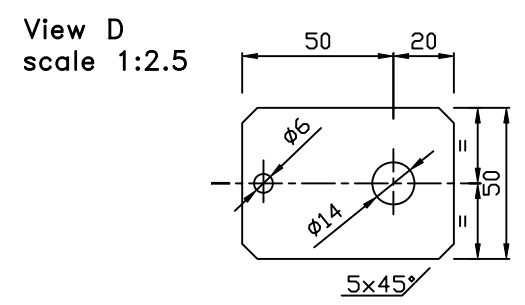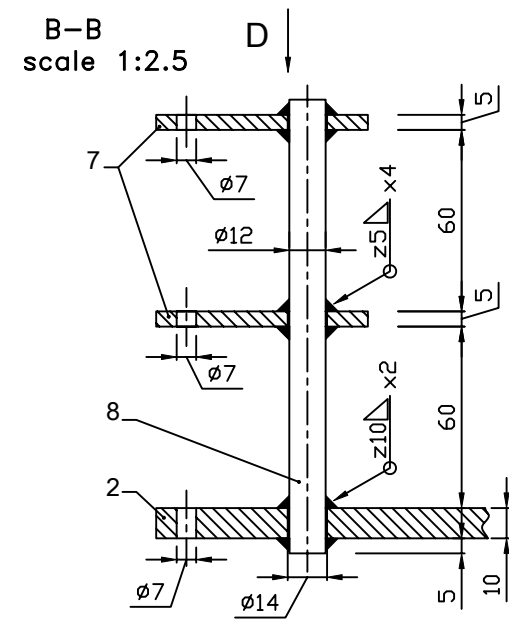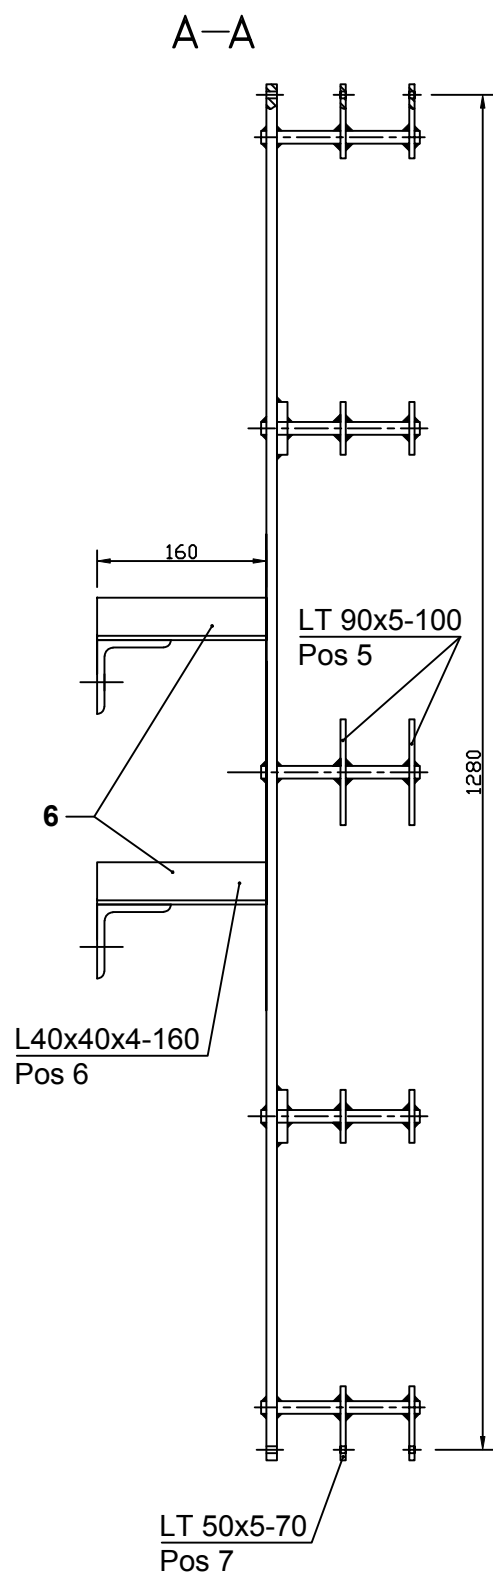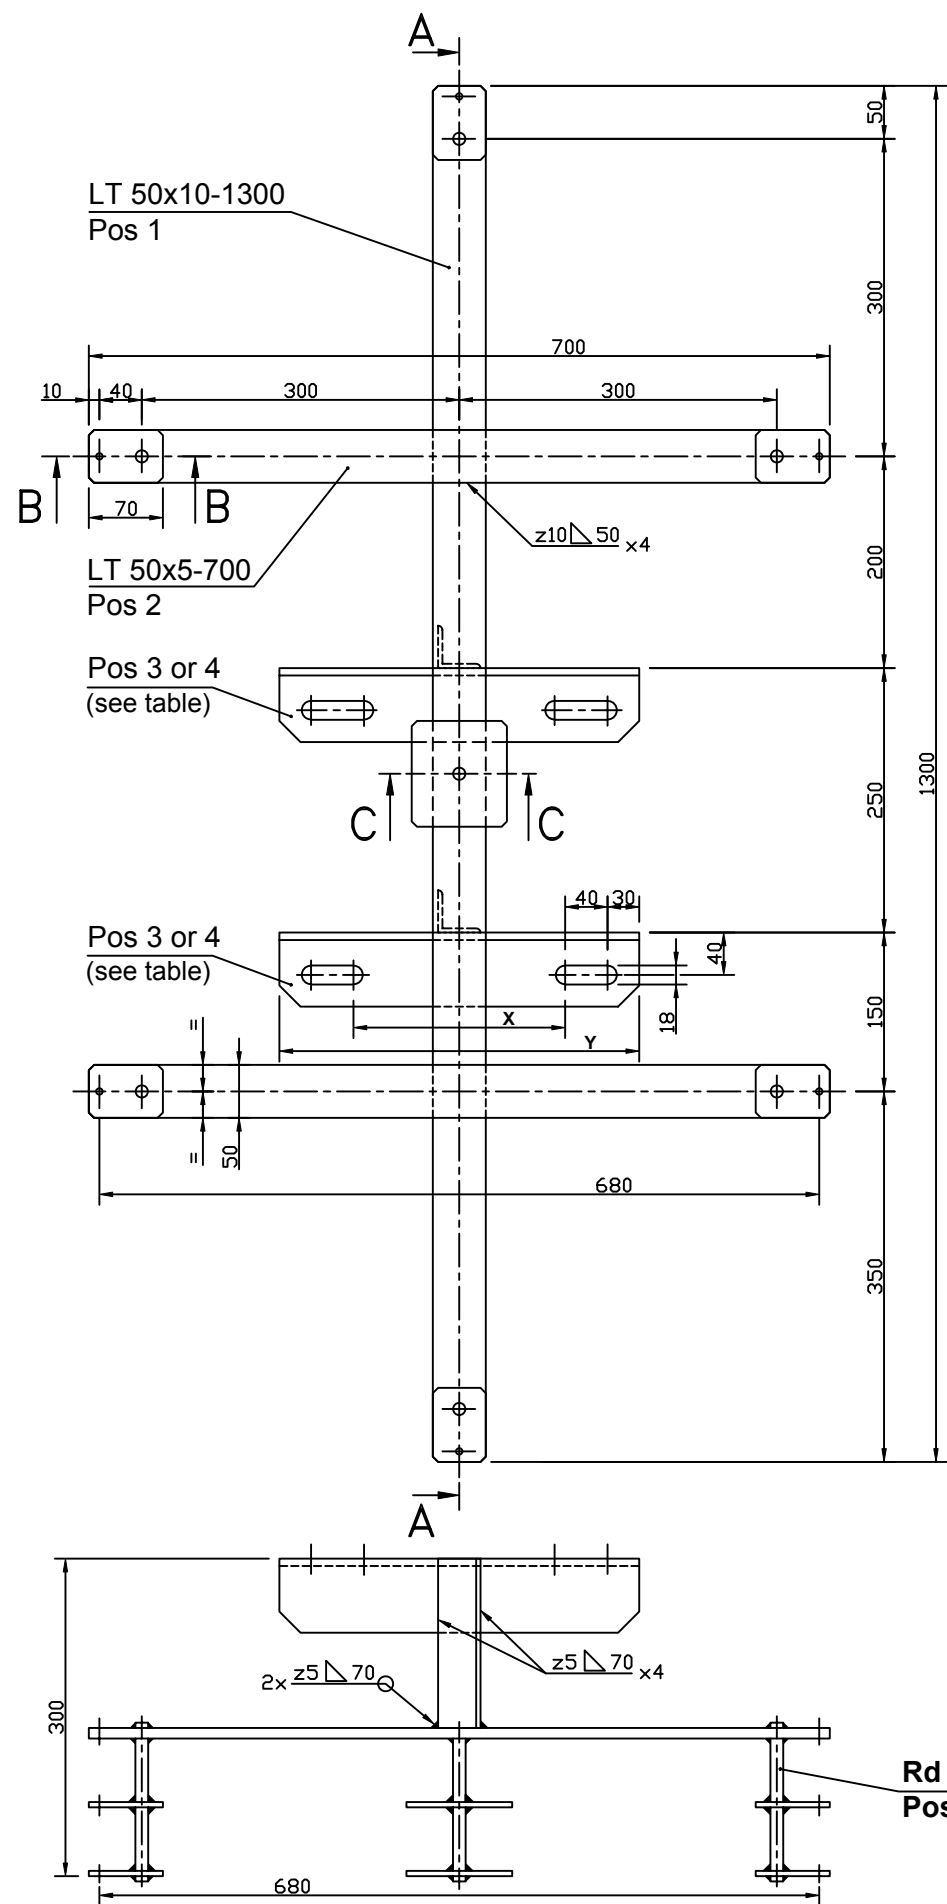

MARK	DESIGNATION	X	Y
101	FROM HE 200 TO HE 240	200	340
102	FROM HE 260 TO HE 320	260	400






MARK GROUP	ITEM	DESIGNATION	UNIT MASS (kg)	MATERIAL	
QUANTITY	7	7	8	Round $\phi 12 - 150$	S 235 JR
	12	12	7	PLATE (LT 50x5 - 70)	S 235 JR
	2	2	6	SPACER (L 40x40x4 - 160)	S 235 JR
	2	2	5	PLATE (LT 90x5 - 100)	S 235 JR
	2		4	COUNTERPLATE (L 70x70x7 - 400)	S 235 JR
		2	3	COUNTERPLATE (L 70x70x7 - 340)	S 235 JR
		2	2	FLAT BAR (LT 50x5 - 700)	S 235 JR
		1	1	FLAT BAR (LT 50x10 - 1300)	S 235 JR

SUPPORT FIBRA OPTICA OPTICAL FIBER SUPPORT		Numele fisierului/ CAD file name:	Scara/ Scale:	Part	Rev.
		01LC00BDG271		1 / 1	0

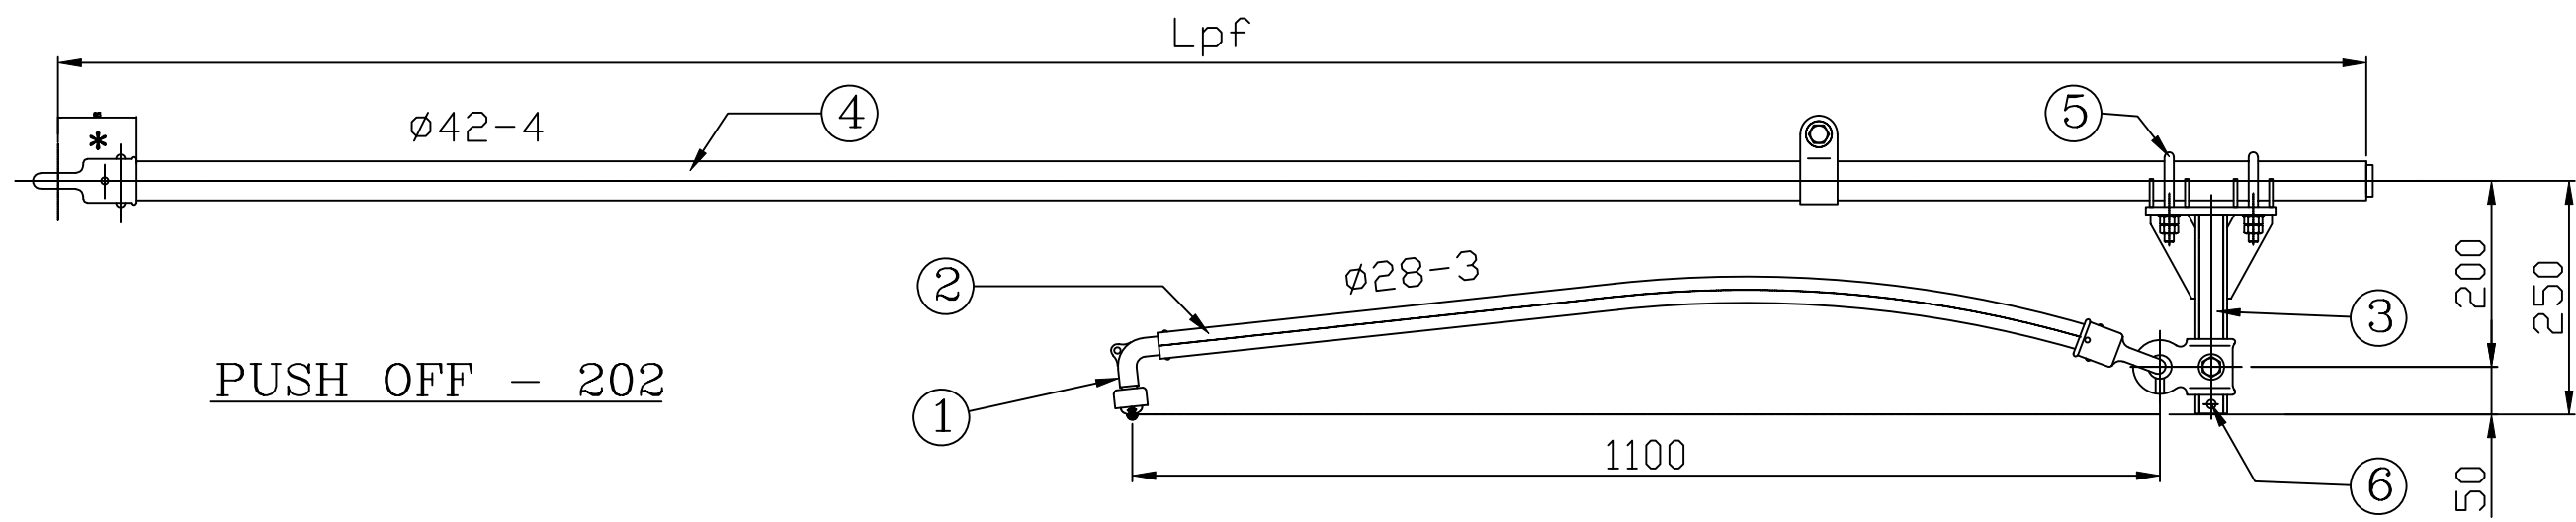




QUANTITY	1	6	WIRE $\varnothing 8$ L=100 (STAINLESS STEEL)		
	2	5	"U" BOLT M 10	01LC00BDG143	1021W3
	1	4	$\varnothing 42 \times 4$ TUBE FOR STEADY ARM	ELC 13-15.0BM	
	1	3	STAND OFF ASSEMBLY FOR STEADY ARM $\varnothing 34$	01LC00BDG273	
	1	2	1.1m STEADY ARM FOR CURVE	ELC 32-10.0A	
	1	1	ASSEMBLY CLAMP GROOVED CONTACT WIRE	ELC 32-9.5.5.0B	
MARK GROUP	SEE TABLE	ITEM	DESIGNATION	REFERENCE DRAWING	MARK

PORTFIXATOR $\varnothing 42 \times 4$ CU FIXATOR 1.1m PENTRU LINIE CURBA $\varnothing 42 \times 4$ REGISTRATION ARM WITH 1.1m STEADY ARM FOR CURVE	Numele fisierului/ CAD file name:	Scara/ Scale:	Part	Rev.
	01LC00BDG272		1 / 1	0

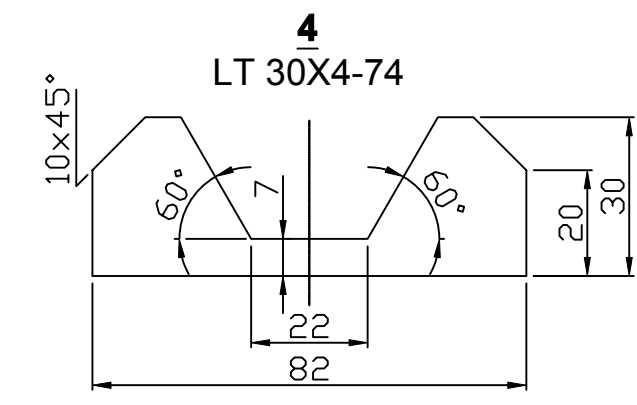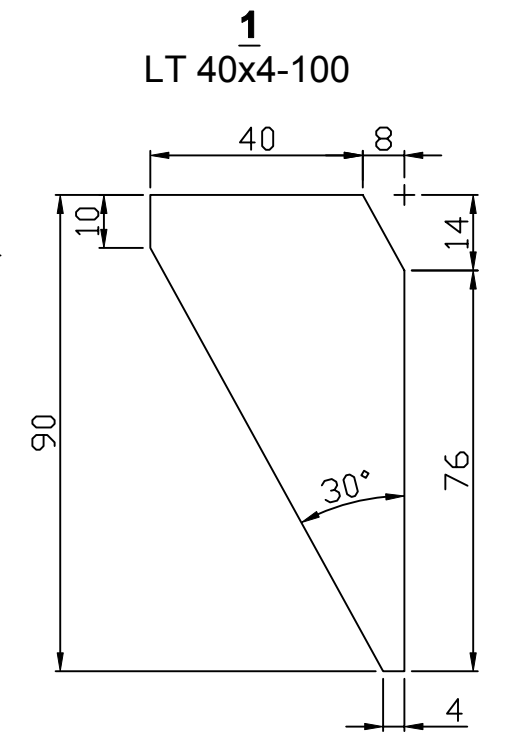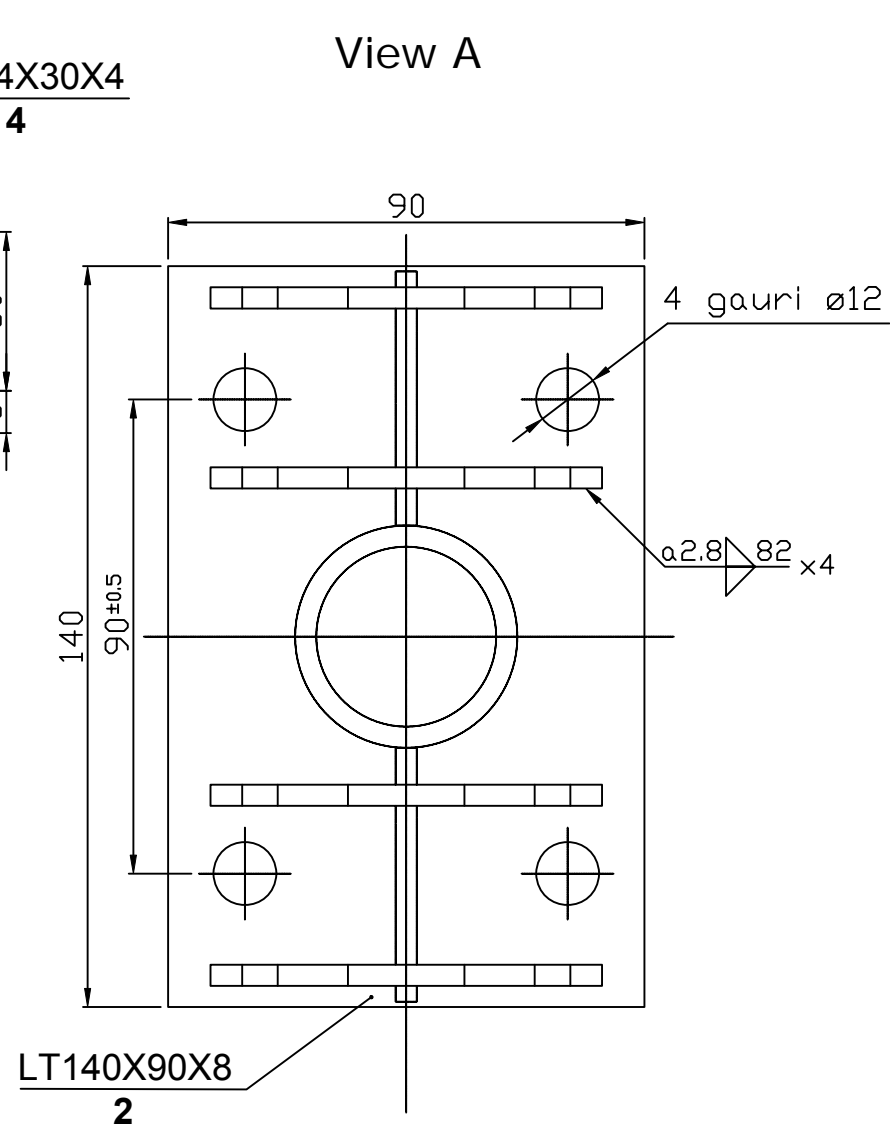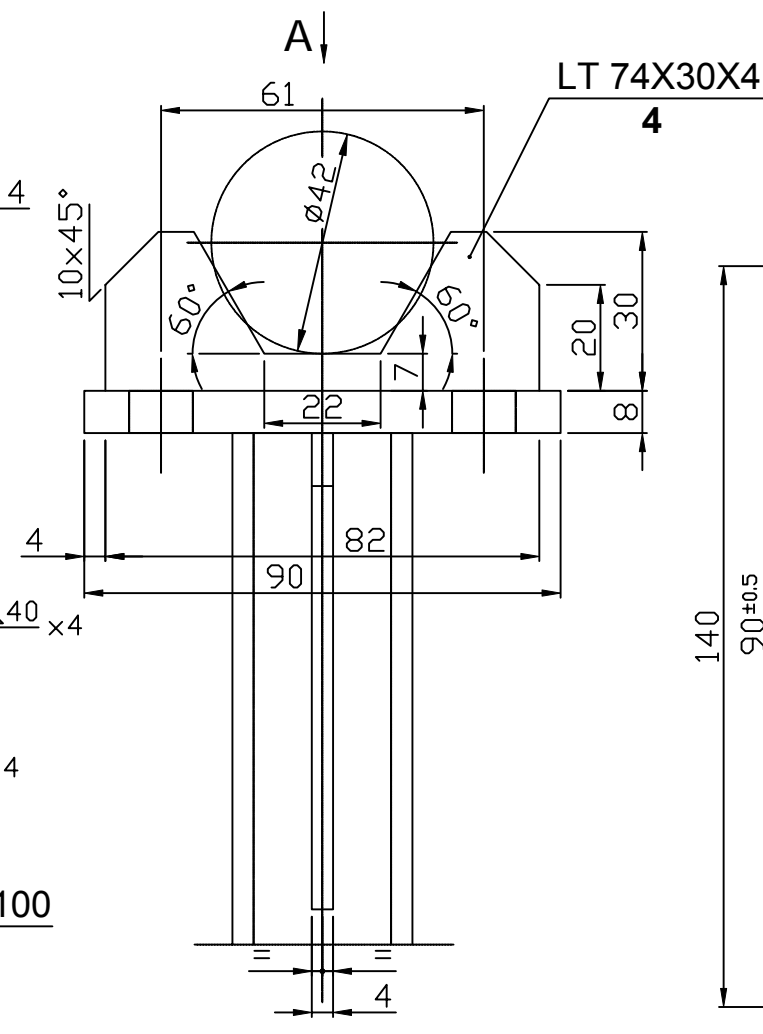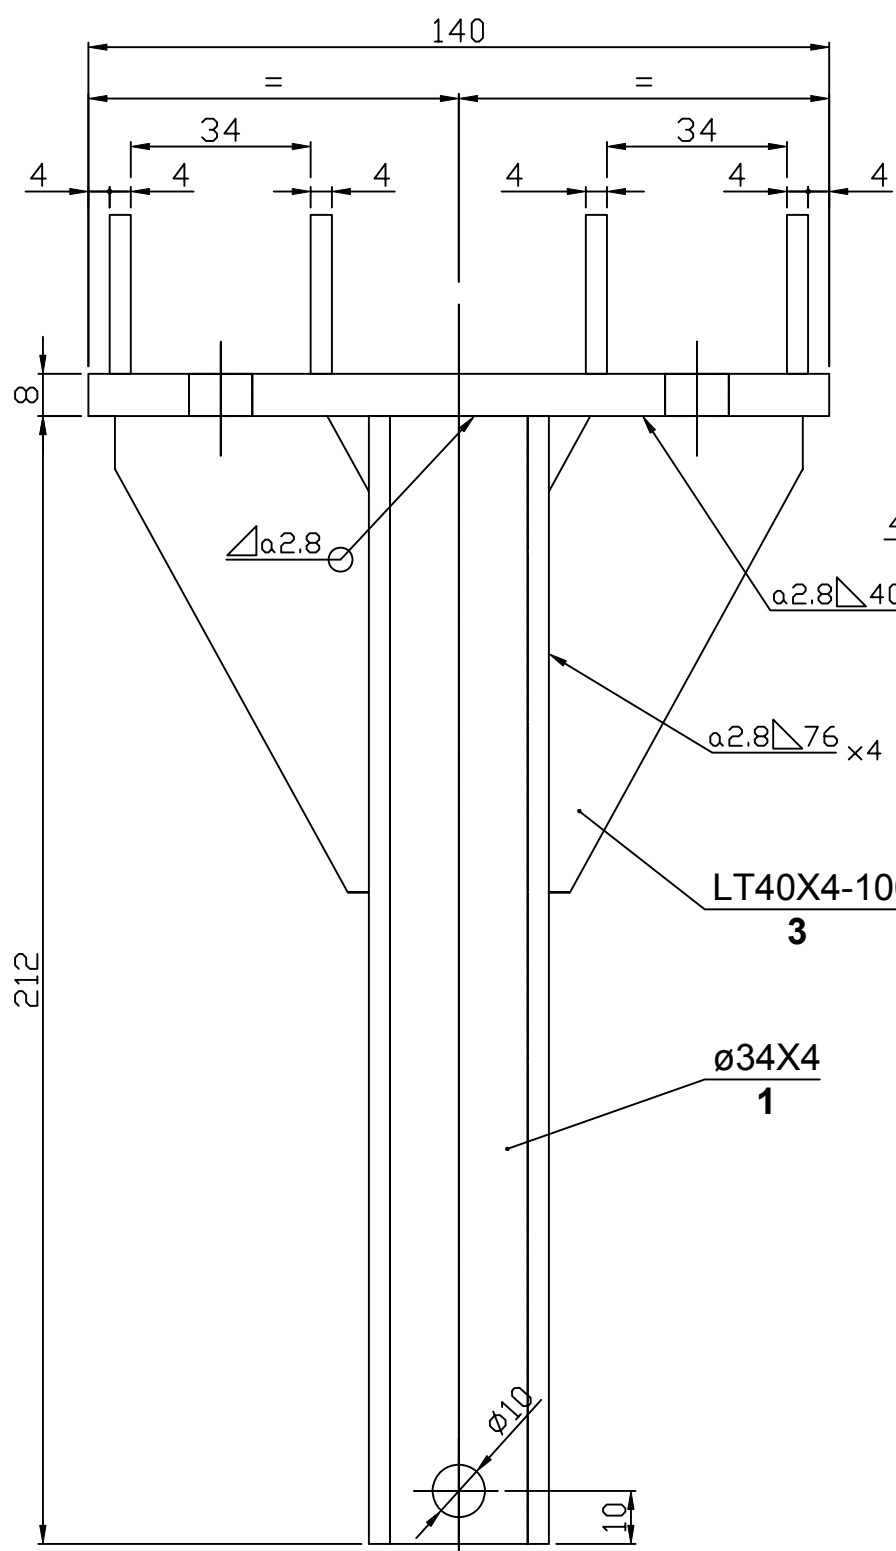

MARK GROUP	Pcs	ITEM	DESIGNATION	UNIT MASS	MATERIAL
QUANTITY	4	4	PLATE 74x30x4		S 235 JR
	2	3	RIB 40x4-100		S 235 JR
	1	2	PLATE 140x90x8		S 235 JR
	1	1	TUBE $\varnothing 34 \times 4$		S 235 JR



ATASAMENT PENTRU FIXATOR $\varnothing 34$ STEADY ARM BRACKET ATTACHMENT $\varnothing 34$	Numele fisierului/ CAD file name:	Scara/ Scale:	Part	Rev.
	01LC00BDG273		1 / 1	0

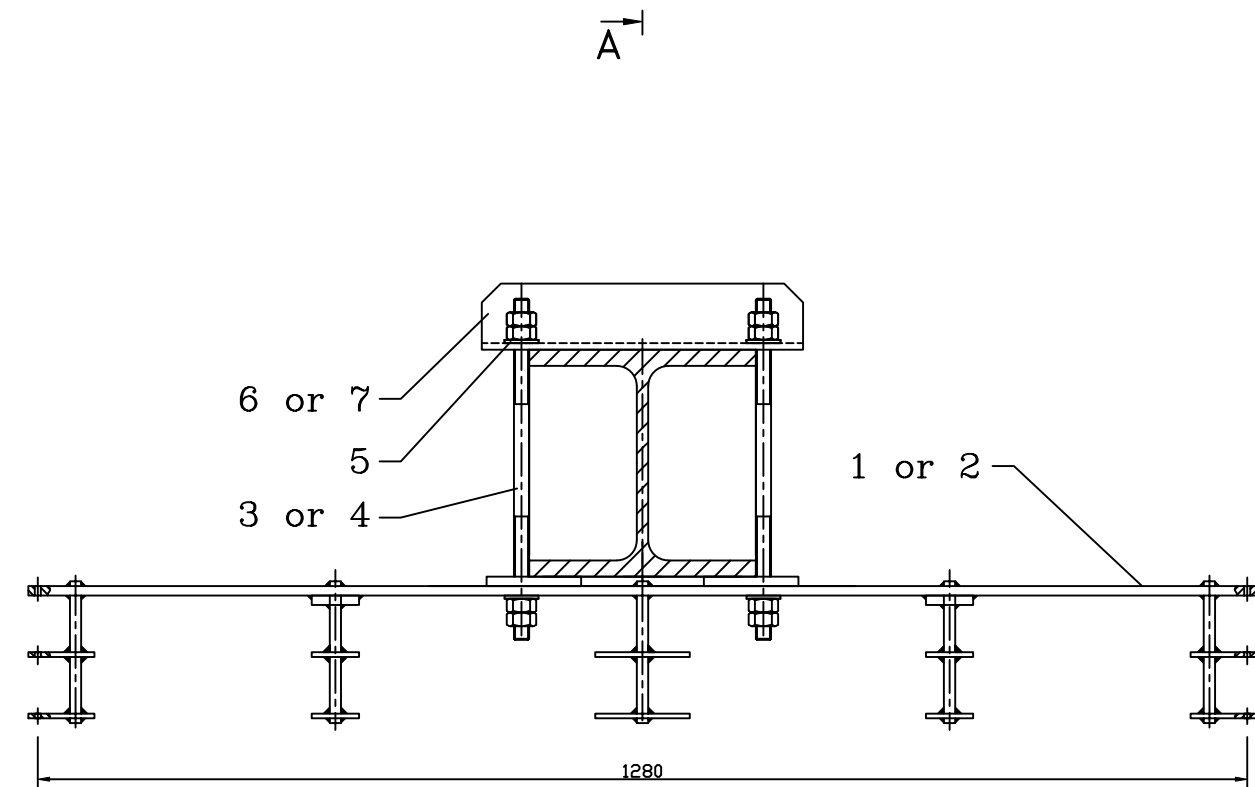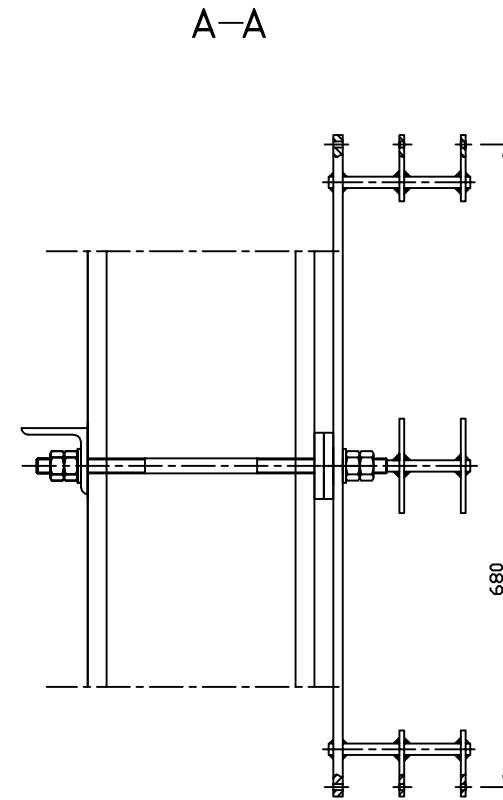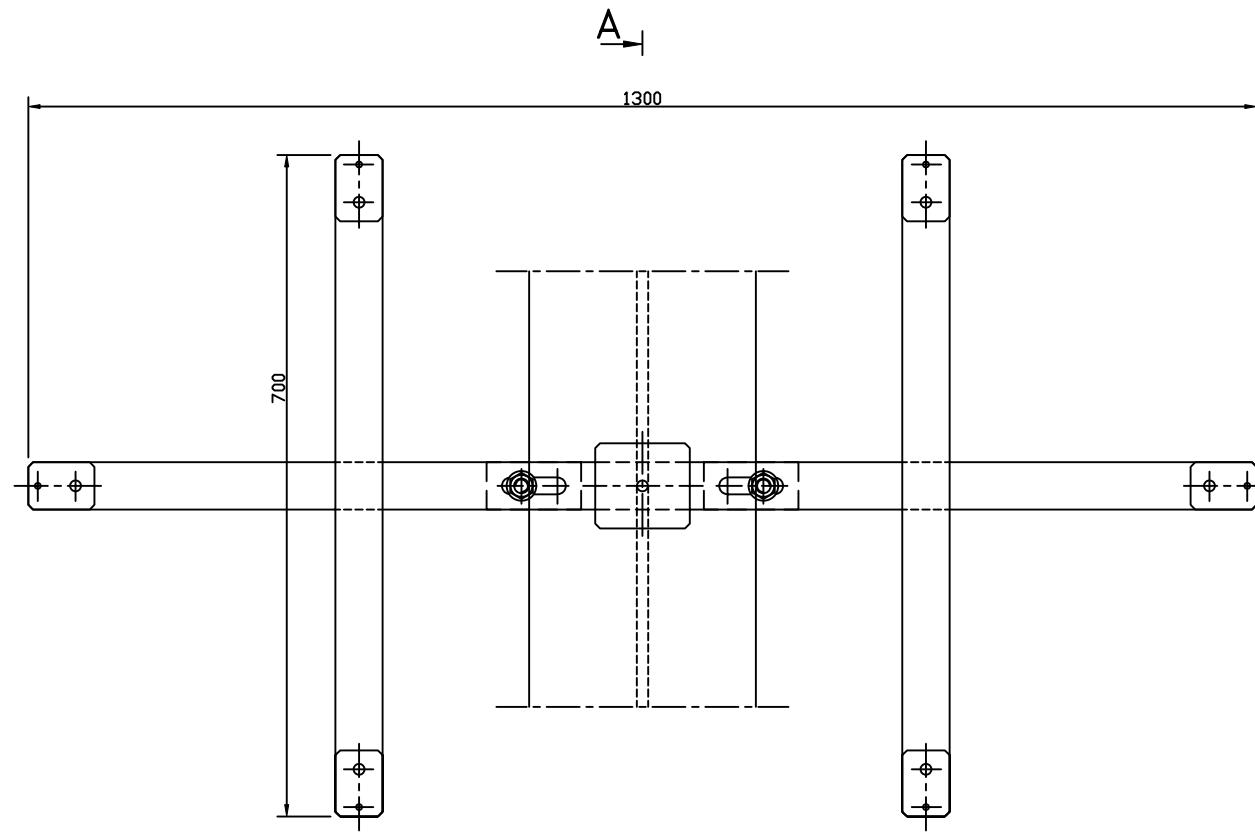

MARK	DESIGNATION
101	FROM HE 200 TO 240
102	FROM HE 260 TO 320





MARK. GROUP	QUANTITY	ITEM	DESIGNATION	UNIT MASS	REFERENCE DRAWING	MARK	
102	1	7	COUNTERPLATE		01LC00BDG090	102	
101	1	6	COUNTERPLATE		01LC00BDG090	101	
	4	4	5	WASHER M16		01LC00BDG142	16A110
	2	4	3	THREADED ROD M16- 350/100		01LC00BDG141	
	2	3	3	THREADED ROD M16- 450/100		01LC00BDG141	
	1	2	OF SUPPORT (for OF junction)		01LC00BDG276	102	
	1	1	OF SUPPORT (for OF junction)		01LC00BDG276	101	

SUPPORT PENTRU REZERVA DE FIBRA OPTICA (pentru joctiune FO) SUPPORT FOR RESERVE OF OPTICAL FIBER (for OF junction)	Numele fisierului/ CAD file name:	Scara/ Scale:	Part	Rev.
	01LC00BDG275		1 / 1	0

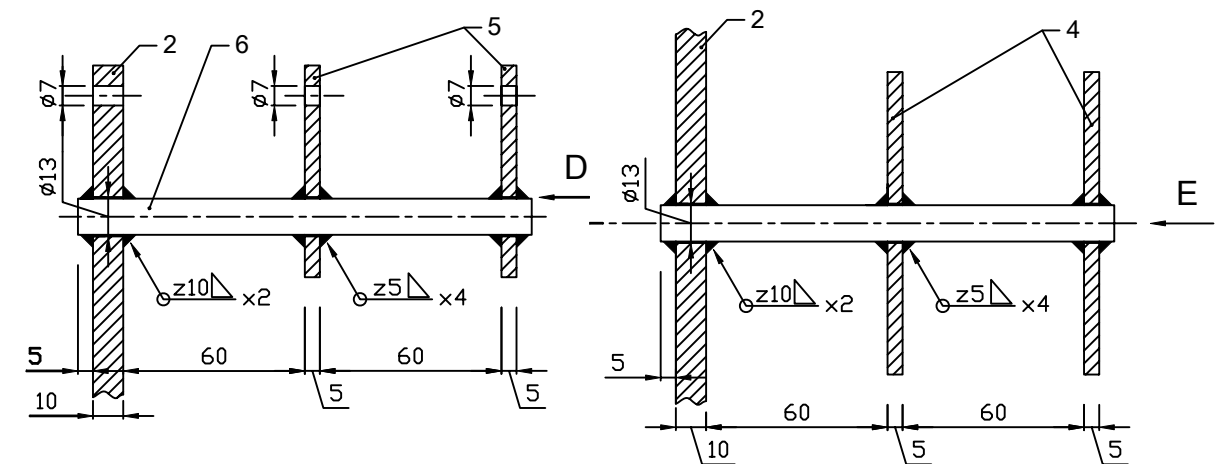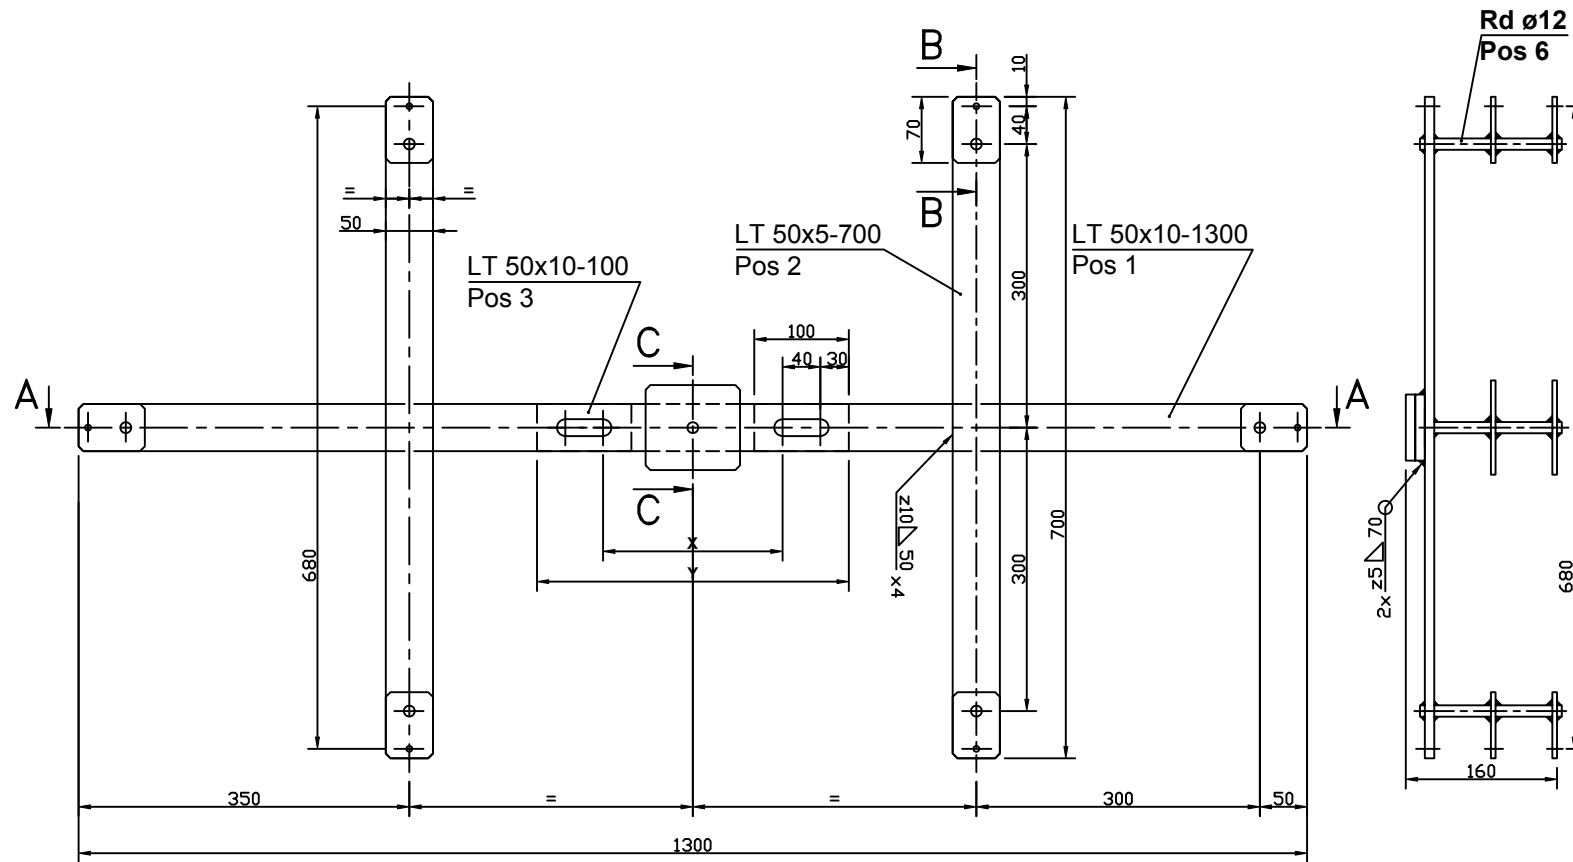

View D
scale 1:2.5


View E
scale 1:2.5

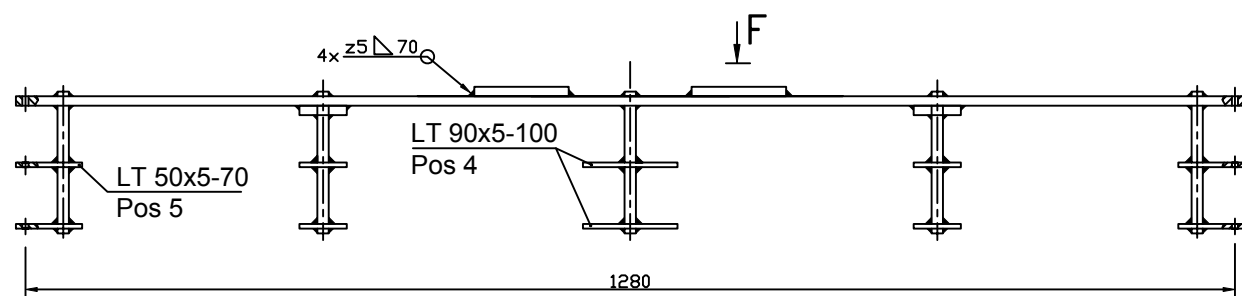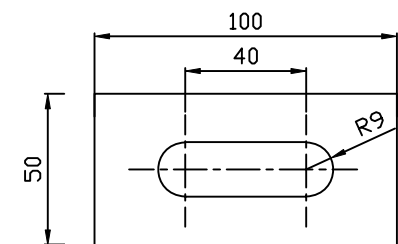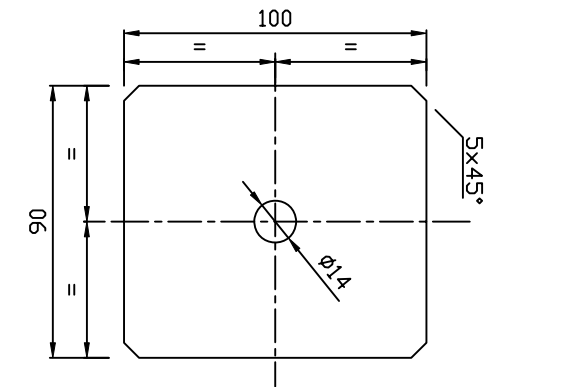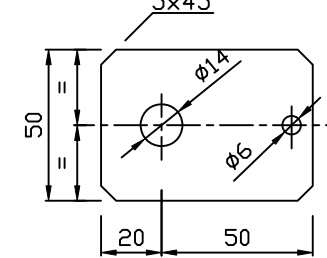

MARK	DESIGNATION	X	Y
101	FROM HE 200 TO HE 240	200	340
102	FROM HE 260 TO HE 320	260	400

MARK GROUP	QUANTITY	ITEM	DESIGNATION	UNIT MASS (kg)	MATERIAL
	7	6	Round $\phi 12$ - 150		S 235 JR
	12	5	PLATE (LT 50x5 - 70)		S 235 JR
	2	4	PLATE (LT 90x5 - 100)		S 235 JR
	2	3	FLAT BAR (LT 50x10 - 100)		S 235 JR
	2	2	FLAT BAR (LT 50x5 - 700)		S 235 JR
	1	1	FLAT BAR (LT 50x10 - 1300)		S 235 JR






SUPPORT FIBRA OPTICA (pentru jonctiune FO) OPTICAL FIBER SUPPORT (for OF junction)	Numele fisierului/ CAD file name:	Scala/ Scale:	Part	Rev.
	01LC00BDG276		1 / 1	0

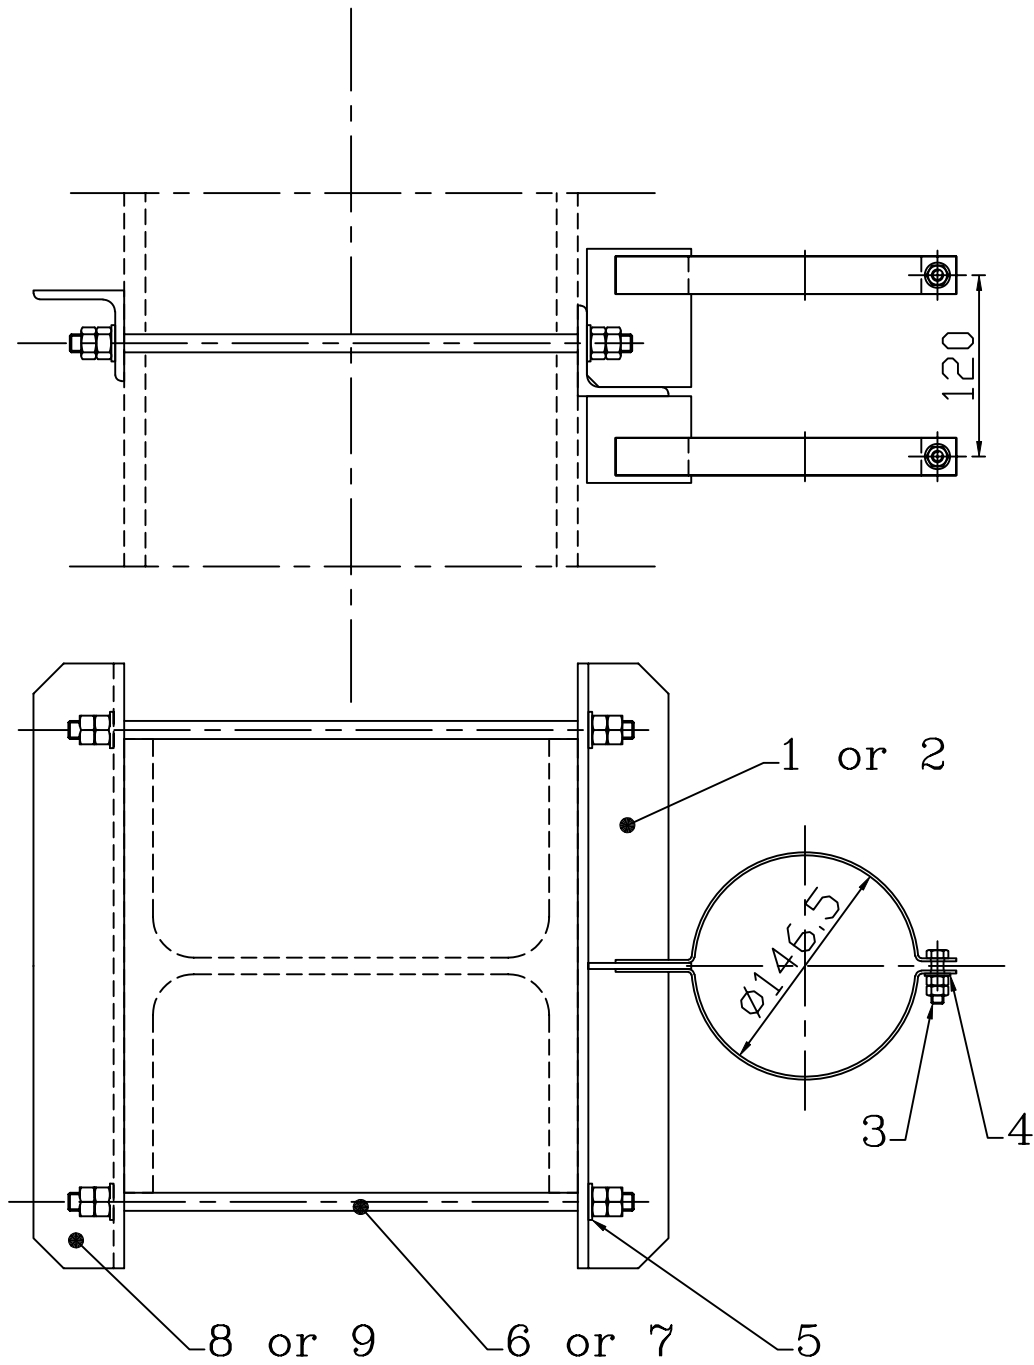


MARK. GROUP	QUANTITY	ITEM	DESIGNATION	UNIT MASS	REFERENCE DRAWING	MARK
	1	9	COUNTERPLATE FOR DF		01LC00BDG087	203
	1	8	COUNTERPLATE FOR DF		01LC00BDG087	103
	2	7	THREADED ROD M12-400/100		01LC00BDG141	1211C2
	2	6	THREADED ROD M12-350/100		01LC00BDG141	1211C2
	4	5	WASHER M12		01LC00BDG142	12A110
	2	4	WASHER M8		01LC00BDG142	08A110
	2	3	BOLT M8-40		01LC00BDG144	0813F1
	1	2	COUNTERPLATE FOR DF PLUG JUNCTION		01LC00BDG278	102
	1	1	COUNTERPLATE FOR DF PLUG JUNCTION		01LC00BDG278	101
102				kg		
101						

MARK	DESIGNATION
101	FROM HE 200 TO HE 240
102	FROM HE 260 TO HE 320


SUPPORT FIBRA OPTICA PENTRU JONCTIUNE OPTICAL FIBER SUPPORT FOR PLUG JUNCTION	Numele fisierului/ CAD file name:	Scara/ Scale:	Part	Rev.
	01LC00BDG277		1 / 1	0

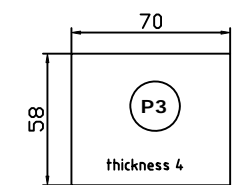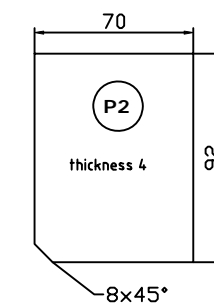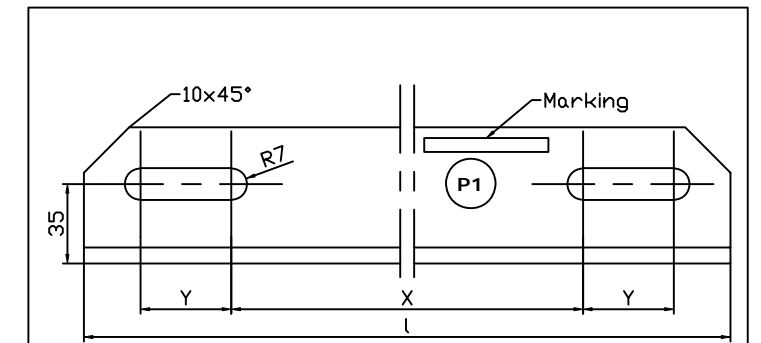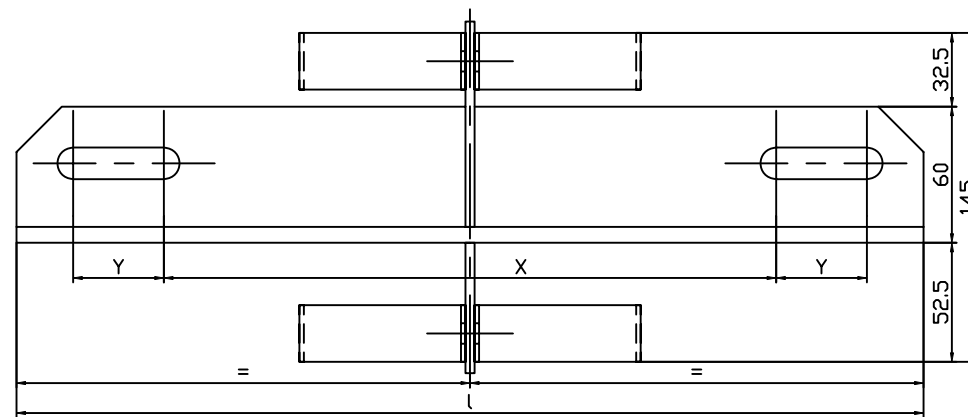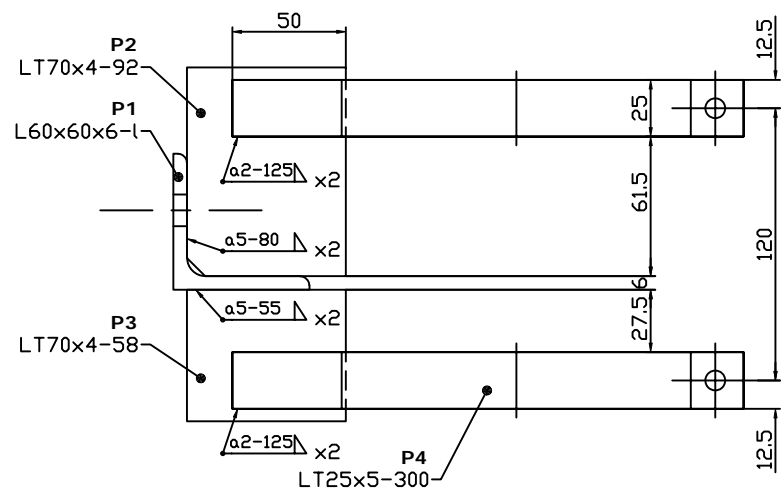

MARK	DESIGNATION	X	Y	I
101	FROM HE 200 TO HE 240	190	40	320
102	FROM HE 260 TO HE 320	250	50	400

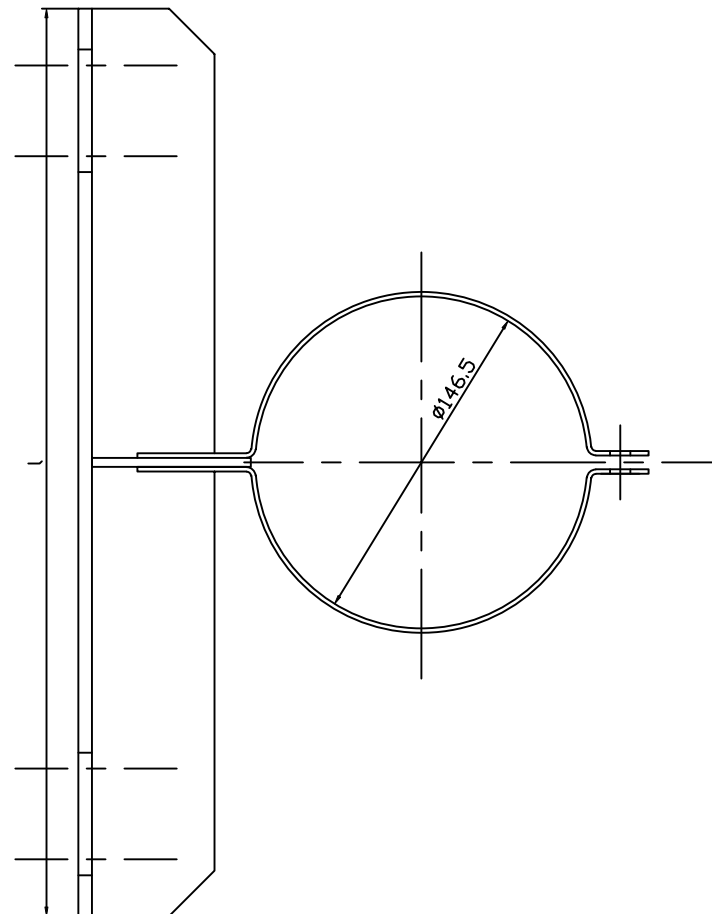

MARK GROUP	QUANTITY	ITEM	DESIGNATION	UNIT MASS (kg)	MATERIAL
	4	4	PLATE (LT25x5-300)		S 235 JR
	1	1	PLATE (LT70x4-58)		S 235 JR
	1	1	PLATE (LT70x4-92)		S 235 JR
	1	1	COUNTERPLATE (L60x60x6-400)		S 235 JR
		1	COUNTERPLATE (L60x60x6-320)		S 235 JR

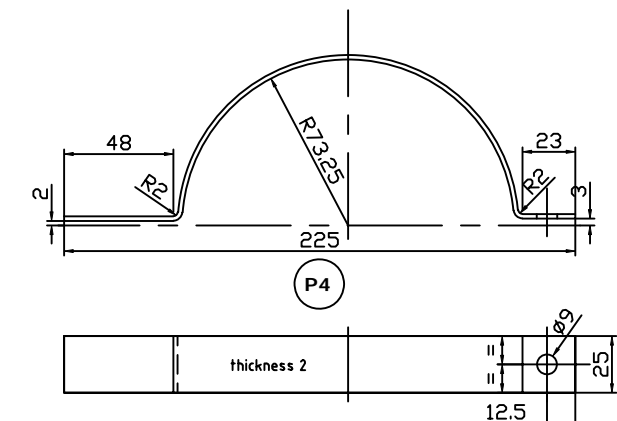



Note:

After welding and drilling will be hot galvanized AT/OL/Zn600-STAS 7221-90.

CONTRASUPORT PENTRU FIXARE JONCTIUNE COUNTERPLATE FOR OF PLUG JUNCTION	Numele fisierului/ CAD file name:	Scara/ Scale:	Part	Rev.
	01LC00BDG278		1 / 1	0

E (b) **NOTĂ:**

7. Se va zincă AT/OL/Zn 500-STAS 7221-90
 8. Înainte de zincare piesa se va trata termic astfel încât după zincare, caracteristicile mecanice ale materialului să nu fie diminuate.

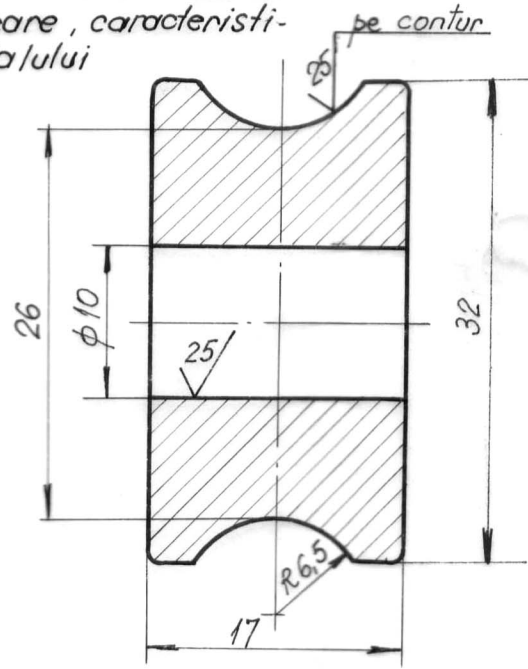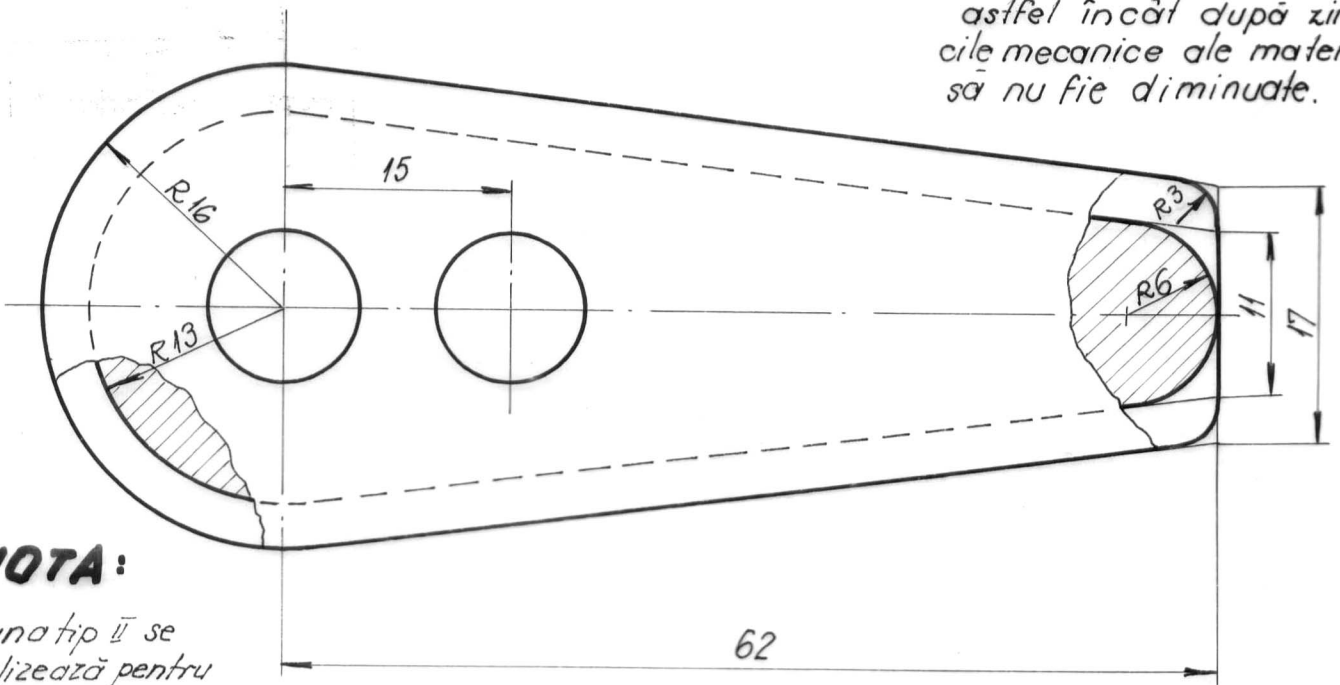

NOTA:

- 1- Pana tip II se utilizează pentru conductori cu secțiunea de $50 \div 70 \text{ mm}^2$
- 2-Vezi nota des. E-LC-2.3.0
- 3-Nu se admit sufluri mai adânci de 1mm și cu diametrul peste 5mm distanțate la min. 15mm.
- 4-Suprafața trebuie să fie fără fisuri și curățată de bavuri și cruste.
- 5-Deplasarea modelelor în planul de separare va fi max. 0,6 mm.
- 6-După turnare va urma o recoacere de feritizare - încălzire la 950°C și menținere 5 ore și răcire lentă de la 760°C la 700°C min. 20 ore
- 7-După tratament se va zincă AE (OL) ZD 40 SE / Fos STAS 7222-74 AT/OL/Zn 500/STAS 7221-82 90

De acord, Constructor

Șef proiect, ing. Spack I.

C.T.E. Ing. Ciortan P.

VIZAT
 Serviciul Electrificare
 Data

100/ ✓

c	1	Completat material	15.VIII-02	Ing. Novleanu
b	3	Actualizat STAS	28.X.1996	Ing. Novleanu
a	1	conf. minută	24.IV-84	25.IV-84 Ing. Novleanu
Proiectat	Ilie Traian		STW	
Desenat	Aldea R.		Rtl	
Verificat	Ing. Spack I.			
Contr. STAS	Ing. Bădăi L.			
Aprobat	Ing. Schmidt			
		b B 35.10 ©		
		Fmn 35.10		
		Masa netă: 0,170 Kg		

E-LC-2.3.3


I. P. C. F

2:1

PANA TIP II


E.I.E.U - Electrificare - LC 2 Data:

E

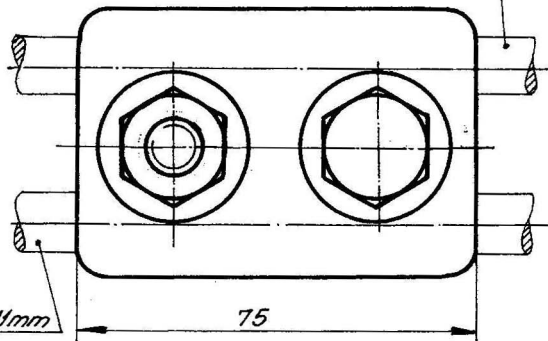Conductor de punere la pământ $\phi 10-12 \text{ mm}^2$ 

Conductor 9-11mm

75

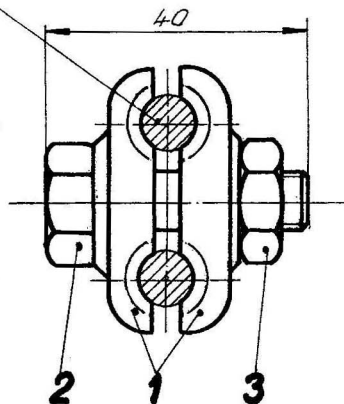

40

2

1

3

De acord,
constructorSef proiect,
ing. Spack I.C.T.E.,
ing. Ciortan P.

NOTA:

- 1- Prezentul plan are la bază
LC/C 48
- 2- Elementele se vor zincea
AT/OL/Zn 500 STAS 7221-82 (b)
~~AT/OL/Zn 40-SL/FG-90 (c)~~
~~STAS 7222-74~~
- 3- Clema este destinată
conductorilor cu $\phi 9-11 \text{ mm}$.

3	Piuliță M12-gr. 4.6	STAS 922-89 ⁸⁹ 76	2			0,016
2	Surub M12 x 40-gr. 4.6	SRISO 4016-94 (c) STAS 920-69	2			0,050
1	Falca de mei	E-LC-2-4.1	2	B35-10 FMM-35-10	(c)	0,225
Poz.	Denumirea	Nr. desen sau STAS	Buc.	Material	Observații	masa netă kg/buc
b 3	Actualizat STAS 28.8.1996	ing. Novleanu				
b' 1	conf. min. nr. 24 IV 84	25 IV 84	ing. Novleanu			
a 1	Modificări STAS 30.11.82	ing. Novleanu				
Proiectat ing. Novleanu						
Desenat Balinteanu						
Verificat ing. Spack I.						
Contr. STAS ing. Bodai L.						
Aprobat ing. Schmidt R.						
				E-LC-2-4.0		
				Masa netă: ~0,580kg		

I.P.C.F.



E.I.E.U.-Electricitare LC2

1:1

Data:

CLEMA DE LEGATURA ptr.
CONDUCTOR de PUNERE la PAMINT

SECȚIUNEA A-A

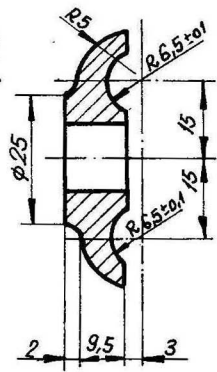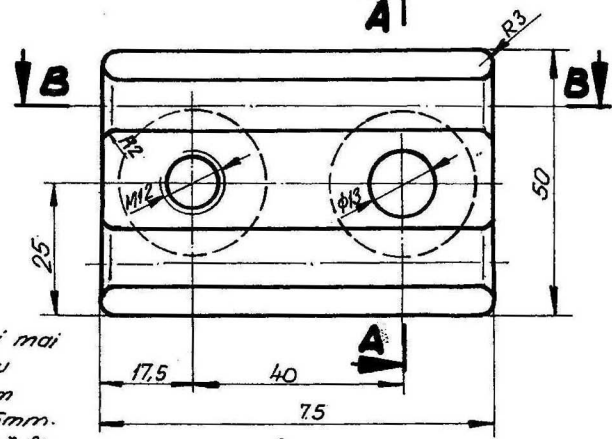

SECȚIUNEA B-B



NOTA:

- 1- Nu se admit sufluri mai adinci de 1mm si cu diametrul peste 5mm distantate la min. 15mm.
- 2- Suprafata trebuie să fie fără fisuri si curățată de bavuri și cruste.
- 3- Deplasarea modelelor în planul de separare va fi max. 0,6 mm.
- 4- După turnare, va urma o recoacere de feritizare încălzire la 950°C si mentinere 5ore și răcire lentă de la 760°C la 700°C min 20 ore
- 5- După tratament se va zince AE (OL) Zn 40-St /fos STAS 7222-74-ATLALZn500 STAS 7221-82
6. Sarcina admisibilă 100 daN Incercările se vor efectua conform STAS 1566 -80

b 1	Actualizat STAS 28 & 96	ing. Novleanu	
a 1	conf. minută 24. IV-84	25. IV-84	ing. Novleanu
Proiectat	ing. Novleanu		
Desenat	Balinteanu A.		
Verificat	ing. Spock I.		
Contr. STAS	ing. Bădăi L.		
Aprobat	ing. Ciortan P.		

Fm 35.10
B 35.10

E-LC-2-4.1


Masa netă: 0,225kg

I.P.C.F.

1:1

FALCA CLEMEI

N

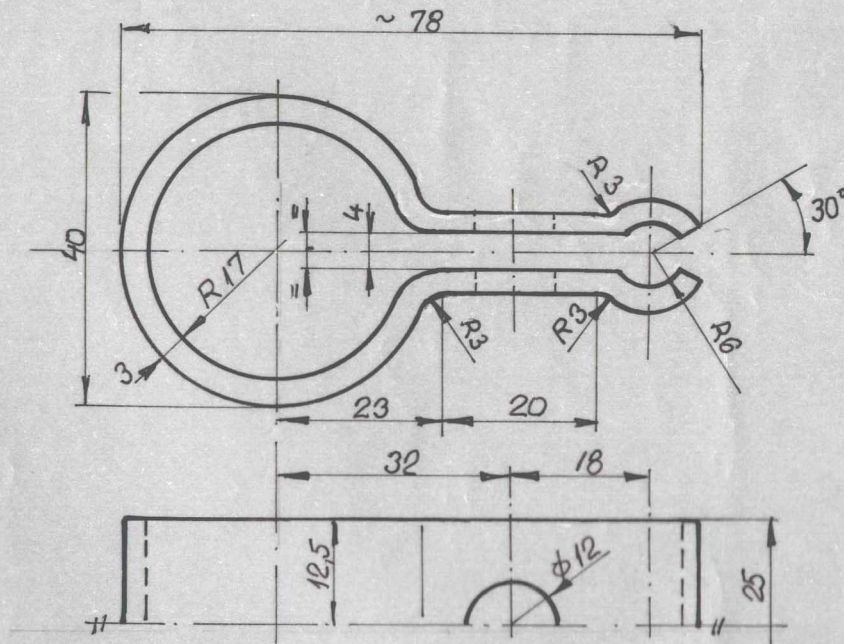

Lungimea desfășurată ~ 190

NOTĂ:


Se va zincă AT/OL/Zn 500 -
- STAS 7221 - 90

Șef proiect:
Ing. Cr. Popescu

D. G. I.
Anton

Proiectat	Ing. D. Navleanu								
Desenat	R. Navleanu								
Verificat	Ing. L. Bădăi								
Contr. STAS	Ing. D. Roman								
Aprobat	Ing. H. Tilichi								
I. S. P. C. F. E. I. E. U.									
COL. ELECTRIFICARE - LC									
				OL 37.2				ELC 5 - 4B	
				Masa netă: 0,3 kg					
				Scara:					
				1 : 1					
				Data: VIII 1997				COLIER	

NOTA

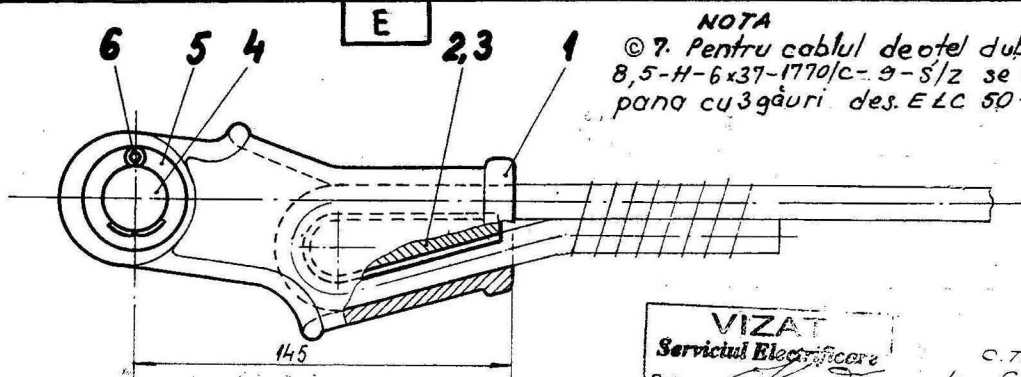

NOTA
 © 7. Pentru cablul de otel dublu normal
 8,5-H-6x37-1770/c-9-5/2 se va utiliza
 pana cu 3 găuri des. ELC 50-1.12A.

VIZAT
 Serviciul Electricare
 Data *[Signature]*

C.T.E.
 Ing. Ciortan P.

- Clema este destinată pentru conducătoare cu secțiunea de la 50÷100mm² și respectiv o sarcină de lucru max. 2000kgf.
- Nu se admit sufluri în adâncime mai mare de 1mm. și cu diametrul de 5mm. distanța minimă dintre două sufluri fiind de 15mm.
- Suprafața presei trebuie să fie lipsită de fisuri și se va curăța de bavuri și cruste
- Deplasarea admisibilă în planul de separare a modelelor va fi de cel mult 0,6mm.
- Suprafețele clemei și penei care vin în contact cu conductorul vor fi perfect netede și cu razele de racordare indicate în desen ptr. a se evita degradarea acestora.
- După turnare, piesa va fi supusă unei recoaceri de feritizare și arume:
 - încălzire la 950°C și menținerea la această temperatură minimum 5 ore.
 - răcirea lentă de la 760° la 720°C min 20 ore.

7. După tratamentul termic piesa va fi zincată - AE / OL / Zn 40 - SL / POS
 - STAS 7222-74 - AT10L/Zn 500/STAS 7221-82.90

6	Splint 4,5x40	STAS 1991-73.89	1	OL 00		0,005
5	Saibă Ø6x22	STAS 5200/4-91	1	OL 34.1n		0,018
4	Bolt B 22x55	STAS 5754-73	1	OL 50.1K		0,190
3	Pană tip II	E-LC-2.3.3.	1	OL 35-10 Fm n 35-40	Pentru conductor 50÷70mm ²	0,170
2	Pană tip I	E-LC-9.29.2	1	OL 35-10 Fm n 35-40	Pentru conductor 80÷100mm ²	0,125
1	Corp	E-LC-9.29.1	1	OL 35-10 Fm n 35-40		1,010

Poz.	Denumirea	Nr. desen sau STAS	Buc.	Material	Observații	Masa netă kg/buc.
d 13	Completat material	15-11-82 Ing. Nouleanu				
c 17	Completat	26.x.96 Ing. Novkany				
b 1	conf. minută	24 IV 84 Ing. Nouleanu				
a 2	Modificat	3Q-11.82 Ing. Nouleanu				
Proiectat	Ilie Traian	3/8				
Desenat	Aldoa R.	2/8				
Verificat	Ing. Spack I.	2/8				
Contr. STAS	Ing. Bădoi L.	2/8				
Aprobat	Ing. Schmidt H.	2/8				

E-LC-9.29.0

I. P. C. F.

1:2

**CLEMA TERMINALA
 CU PANA SI FURCA**



E.I.E.U. - Electricare-LC2

Data:

Masa netă : 1,490 Kg

VIZAT
Serviciul Electricificare
 Date *[Signature]*

Secțiunea A-A

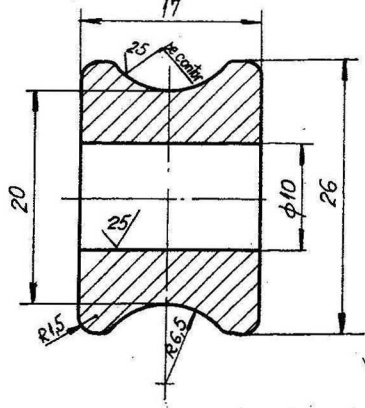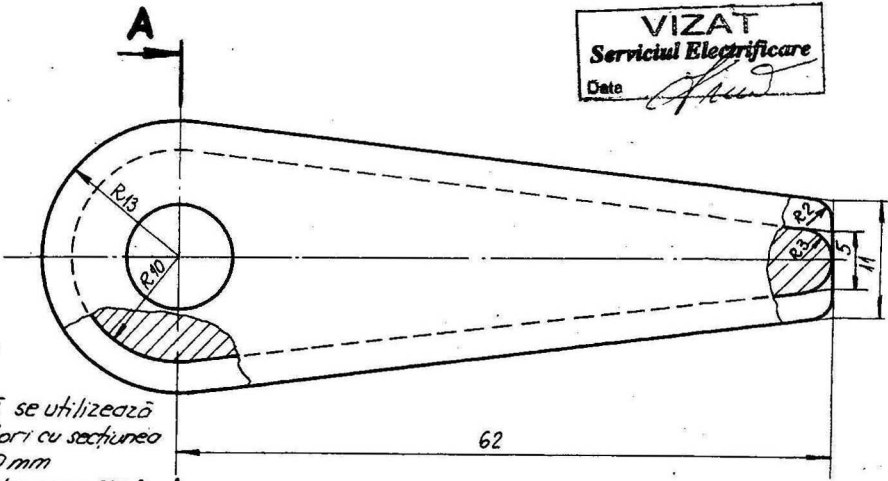

NOTA:

- 1- Pana tip I se utilizează pt. conductori cu secțiunea de 80 ÷ 100 mm
- 2- Vezi nota des. E-LC-9-290
- 3- Nu se admit sufluri mai adânci de 1mm și cu diametrul peste 5mm distantate la 15mm
- 4- Suprafața trebuie să fie fără fisuri și curățată de bavuri și cruste.
- 5- Deplasarea modelelor în planul de separare va fi max. 0,6 mm.
- 6- După turnare, va urma o recăzere de feritizare - încălzire la 950°C și menținere 5 ore și răcire lentă de la 760°C la 700°C în 20 ore
- 7- După tratament se va zincea ~~AT (OL) Zn 40 și / sau STAS 7222-94~~
~~AT (OL) Zn 40 și / sau STAS 7222-94~~
 AT (OL) Zn 500 / STAS 9221-82
8. Se va zincea AT (OL) Zn 500 - STAS 7221-90

NOTA

9. Înainte de zincare piesa se va trata termic, astfel încât, după zincare, caracteristicile mecanice ale materialului să nu fie diminuate.

C.T.E.
 Ing. Ciortan P.



c	1	Completat material	15-11-02	Ing. Novlescu	
b	3	Completat	26.x.96	Ing. Novlescu	
a	1	conf. minuta	24 IV B4	25 IV B4	Ing. Novlescu

Proiectat Ilie Trajan
 Desenat Aldea R.
 Verificat Ing. Spaciu
 Contr. STAS Ing. Bădăi L.
 Aprobata Ing. Schmidt

B 35 - 10
 Fm. 35-10
 Masa netă: 0,125 kg

E-LC-9.29.2


I.P.C.F.

2:1

PANA TIPI



E.I.F.U.-Electricare - LC2

Date:

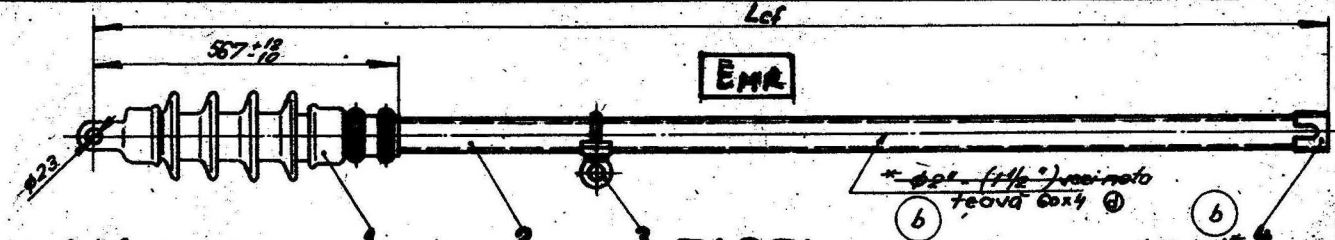

TABEL

Lungimea contrafisei Lcf	2630	2800	2910	3080	3220	3370	3520	3670	3840	4000	4170	4340	4510	4710	4910
Reper	01	02	03	04	05	06	07	08	09	10	11	12	13	14	15
L [mm]	2870	2910	2950	2990	3030	3070	3110	3150	3190	3230	3270	3310	3350	3390	3430
Masa [kg]	13,20	13,30	13,40	13,50	13,60	13,70	13,80	13,90	14,00	14,10	14,20	14,30	14,40	14,50	14,60
Masa netă (Kg.)	28,6	29,2	29,9	30,6	31,3	32,0	32,8	33,5	34,4	35,3	36,2	36,5	37,9	37,9	40,0

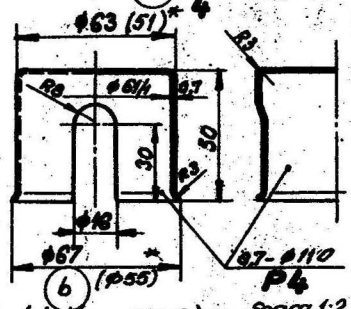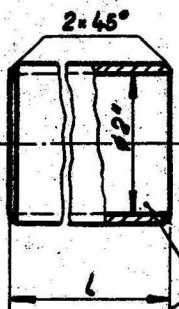

Teavă obişnuită zincată 2" x 3,65-1

NOTA:

Contrafisa poz. 2 are lungimea „L” conform tabel reper 01 ÷ 15

NOTA:

1. Capocul poz. 4 se va executa prin ambufisire.
2. Poz. 3 și 4 se vor executa conform desenului STAS 20011-87.
3. Prezentul desen are la bază următoarele planuri: LC/A 20 - LC/A 20-01, LC/A 20-01A, LC/c-50.
4. Pentru încercări ușoare se poate utiliza și teavă M 1 1/2" x 3,25 având diametrul de utilizare indicat în proiectele de execuție LC.

P2
Sc. 1:2

Poz.	Denumirea	Nr. desen sau STAS	Doc.	Material	Observații
4	Capoc	—	1		
3	Bridă cu cercel	E-LC-13-1.2.3.0	1		
2	Contrafisa	—	1	α 97.2K	
1	Izolator baston tip C	—	1		

Poz.	Denumirea	Nr. desen sau STAS	Doc.	Material	Observații
d 5	completat	26.x.95	ing. Andrei		
c 1	completat	24.11.84	ing. Andrei		
b 4	completat	20.4.82	ing. Novik		
a 2	Modificat	STAS	ing. Andrei		
	Proiectat	ing. Neutaru			
	Desenat	Bolinteanu			
	Verificat	ing. Spach I.			
	Contr. STAS	ing. Neutaru			
	Acordat	ing. Schimbirici			

E-LC-13-1.2.0

CONTRAFISA CU IZOLATOR
R.D.G.

I.P.C.F.


E.I.E.U. - Electricitate L.C. 2

1:10; 1:2

Data: 6.11.1978

CTE
ing. Oartan P.
De acord,
Constructor
[Signature]

E

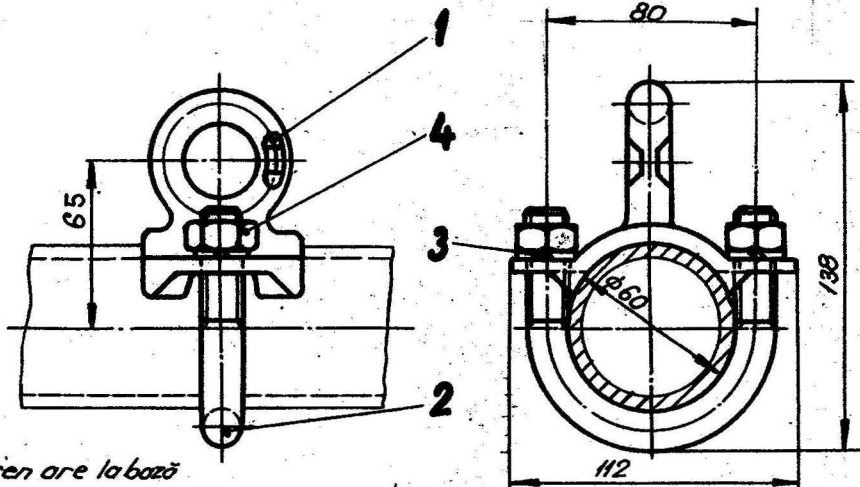

NOTA:

Prezentul desen are la bază următoarele planuri:

- LC/c 50
- LC/c 50-01
- LC/c 50-02

④	4	Piuliță M ¹² gr. 4.6	STAS 922-59	2	20 Cr 120	⑤	0,060
③	3	Saribă Grover MN 15	STAS 7666-56	2	ARC 6 A	⑥	Nichelat 0,010
②	2	Brătară	E-LC-13-1.2.3.2	1	OL 37-2 K	⑤	0,190
①	1	Ureche neseccionată	E-LC-13-1.2.3.1	1	B35-19 5mm 25-19		0,600
Poz.		Denumirea	Nr. desen sau STAS	Buc	Material	Observații	kg/buc.

C.T.E.,
ing. Ciortan
[Signature]





Sef proiect,
ing. Spock I.
[Signature]

De acord,
Constructor
[Signature]

c 5	Completări	26.11.56	ing. Morțanu				
b 3	Modificări material	26-07-76	ing. Nedrean				
a 2	Modificări	30.11.56	ing. Morțanu				
Proiectat ing. Morțanu							
Desenat Balăneanu							
Verificat ing. Spock I.							
Cont. STAS ing. Brății L.							
Acrobat ing. Schmitt H.				Masa netă: 0,830 kg			

E-LC-13-1.2.3.0

I.P.C.F.	1:2	BRIDA CU CERCEL
E.I.E.U. - Electrificare	Data:	

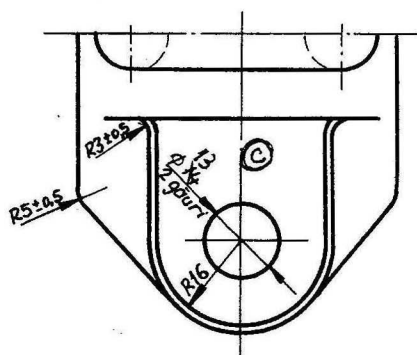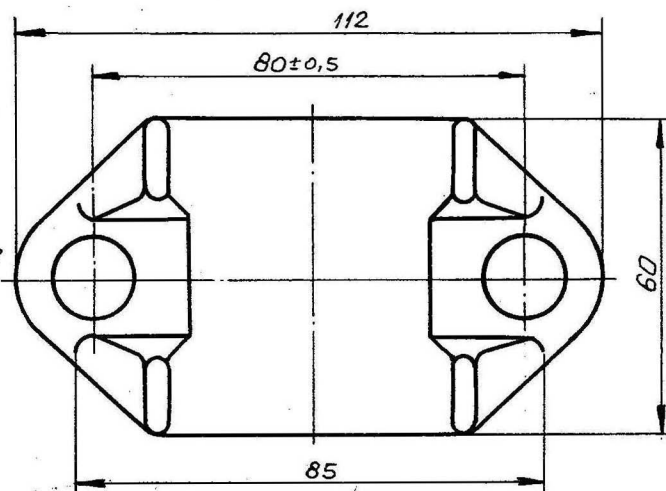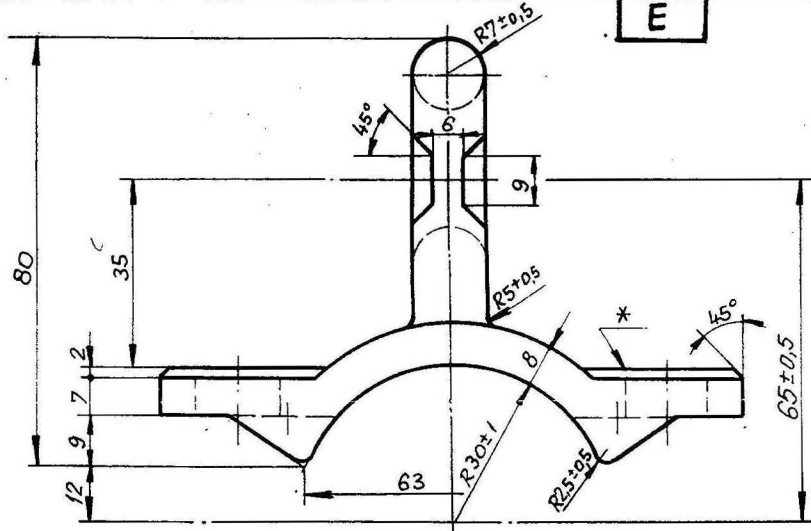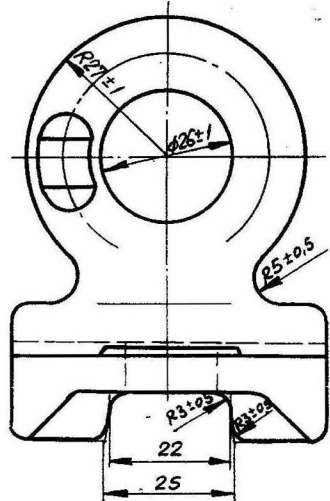

Ⓢ **NOTA**

9. Se va zincea AT/OL/Zn500-STAS 7221-90.
 10. Înainte de zincare piesa se va trata termic, astfel încât, după zincare caracteristicile mecanice ale materialului să nu fie diminuate

NOTA:

- 1-Nu se admit sufluri în adâncime mai mare de 1mm și cu diametrul mai mare de 5m, distanța minimă dintre două sufluri fiind de 15mm
- 2-Suprafața piesei trebuie să fie lipsită de fisuri și se va curăța de bavuri și cruste.
- 3-Deplasarea admisibilă în planul de separare a modelelor va fi de cel mult 0,6mm.
- 4-Se va insista asupra obținerii unui aspect curat, neted a suprafeții notate cu *.
- 5-După turnare, piesa va fi supusă unei recoaceri de fertizare și anume:
 - încălzire la 950°C și menținerea la această temperatură minim 5ore.
 - răcire lentă de la 760° la 700°C min 20 ore. @ AT/OL/Zn 500 /STAS 7221-92
- 6-După tratamentul termic piesa va fi zincată AT/OL/Zn 500-SI /Fos STAS 7222-74
- 7-Prezentul desen are la bază planul nr. LC/C 50-01
- 8-Sarcina admisibilă 500daN. Incercările se vor efectua conform STAS 1566-80

C.T.E., Șef proiect, De acord,
 ing. Ciortan P., ing. Spackl., Constructor

Spackl.

100 ✓ ✓

C 1	Modific. diam. gauri	1-09-03/ing. Navleanu	
b 3	Completări	26.x.96/ing. Navleanu	
a 1	cont. minuta	24.11.84 25.11.84/ing. Navleanu	
Proiectat		ing. Navleanu	
Desenat		Bolintineanu	
Verificat		ing. Spackl.	
Contr. STAS		ing. Bădiu L.	
Aprobat		ing. Schmidt M.	


Fm 35-10 E-LC-13-1.2.3.1

I.P.C.F.
 E.I.E.U.-Electrificare

1:1
 Masa netă:
 Data:

URECHE NESECȚIONATA

E

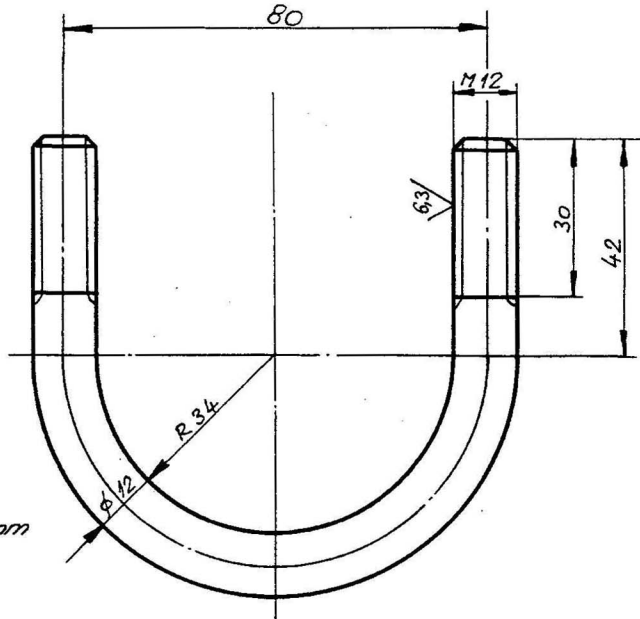

Lungimea desfășurată ~ 210 mm

NOTA:

- 1- Prezentul desen are la bază planul nr. LC/c 50-02
- 2- Se va cadmia #E/OL fed 12-51

STAS 7222-74
AT/OL/Zn 610/STAS 7221-82

C.T.E.,
ing. Ciortan P.

Șef proiect,
ing. Spack I.

Handwritten signature

Handwritten signature

De acord,
Constructor





C 1	Actualizare STAS	26.X.96	ing. Novleanu							
b 1	Modificat material	26-06-78	ing. Novleanu							
a 1	conf. minuta	24 IV 84	25 IV 84	ing. Novleanu						
Proiectat ing. Novleanu				20 Cr 130						
desenat <i>spalintineanu</i>				DL 37-2 K (b)		E-LC-13-1.2.3.2				
Verificat ing. Spack I.										
Contr. STAS ing. Bădi L										
Aprobat ing. Schmidt M.				Masa netă: 0,190 kg						



I.P.C.F.
E.I.E.U.- Electricitare

1:1
Data:

BRATARĂ

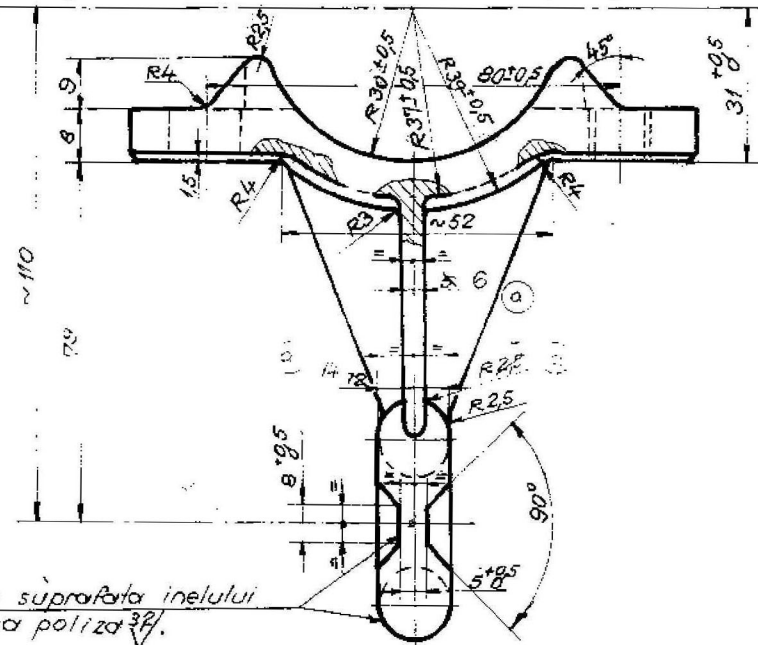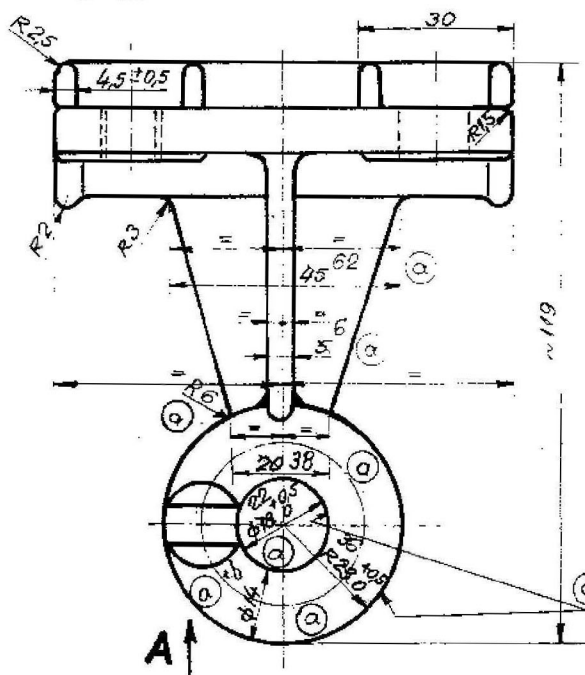

⊙ Toată suprafața inelului se va poliza 32.

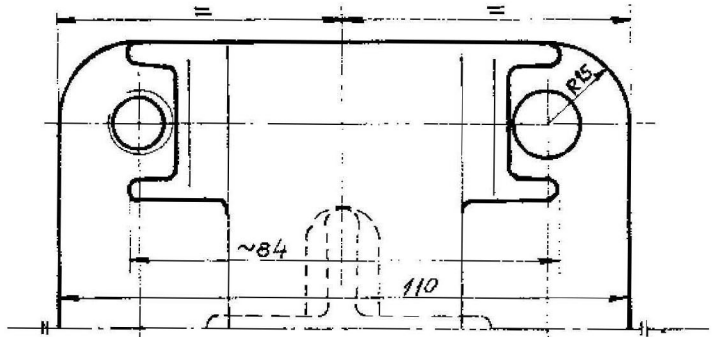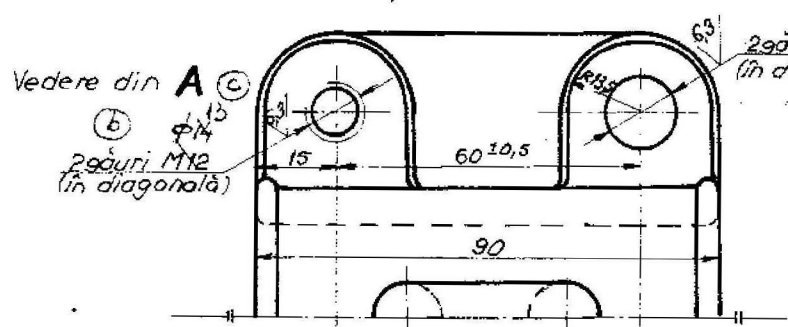


NOTA



1. Se va zincea AT/01/zn 600 - STAS 7221-90, cu exceptia filetelor AT/01/zn 310
2. După zincare piesa se va trata termic pentru defensionare
3. * Pentru zonele poluate reperul se va executa din Cu Al 10 Fe37, fără a se mai zincea, procedeu de turnare C

D.G.I.
Bintan

Sef proiect
Ing. Cr. Popescu

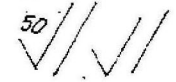

c 2	Modific. diam. găuri 1-09-02	Ing. Navileanu	
b 7	Modif. protecț. p.	18-07-98	Ing. Navileanu
a 11	Modif. protecț. p.	4.09.1998	Ing. D. Noviloban
Proiectant: Ing. Navileanu			
Desenat: Bodea F.			
Verificat: Ing. Bodea L.			
Conținut: STAS Ing. Roman			
Aprobat: Ing. Tilichi H.			
I.S.P.C.F. EIEU		Scara: 1:1	ELC 13 - 1.3.1.A
COL. ELECTRICITATE-LC		Masa netă:	
		Dotn: v. 1996	BRĂȚARĂ CU PIVOT

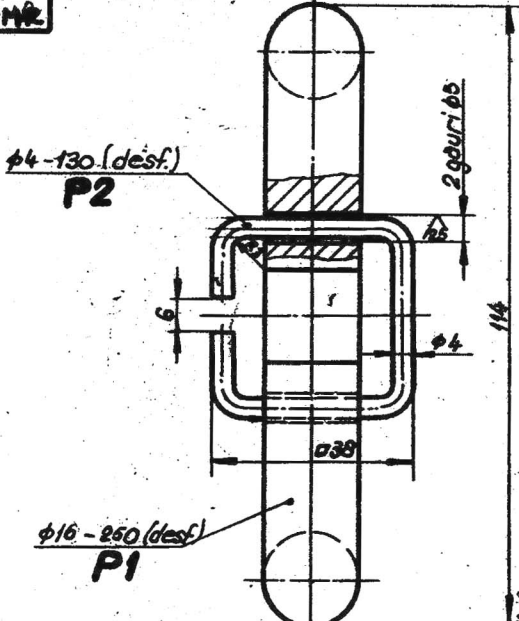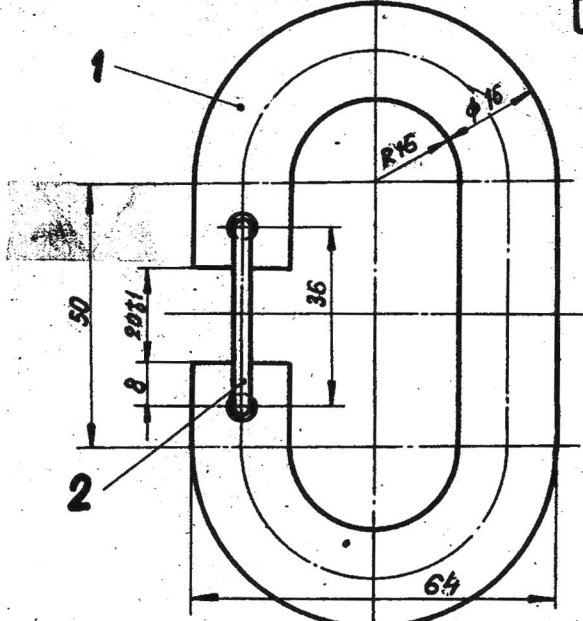

50/ ✓ ✓

2	Siguranță	—	1	Ţel zincat	0,014	
1	Cercel	—	1	OL 37.2K	0,480	
Poz.	Denumirea	Nr. desen sau STAS	Buc	Material	Obs	Pondere netă kg/buc

c	3	Actualizare STAS	20.X.96	Modificari		
b	1	cont. minime 24 si 24	25.IV.84	Modificari		
q	2	Modificat STAS	92.II.82	Modificari		
Proiectat		ing. Nevolescu				
Desenat		Bolinheanu				
Verificat		ing. Spack				
Conf. STAS		ing. Nevolescu				
Aprobat		ing. Schmitt				




E-LC-13-1.3.2.0

MOȘO NETĂ: 0,5 kg

NOTA:
1-Cercelul poz. 1 se va zinca
Atenție la 40 și Fos STAS 722-74
RT/OL Zn 500/STAS 7221-82. ©
2- Prezentul desen are la '90
bază planul LC/c-49-02/A

CTE
ing. Giortan P.
De acord,
Constructor
ing. Spack

I.P.C.F.
E.I.E.U.- Electricitate LC2
1:1
CERCCEL
Data: 5.VII.1976

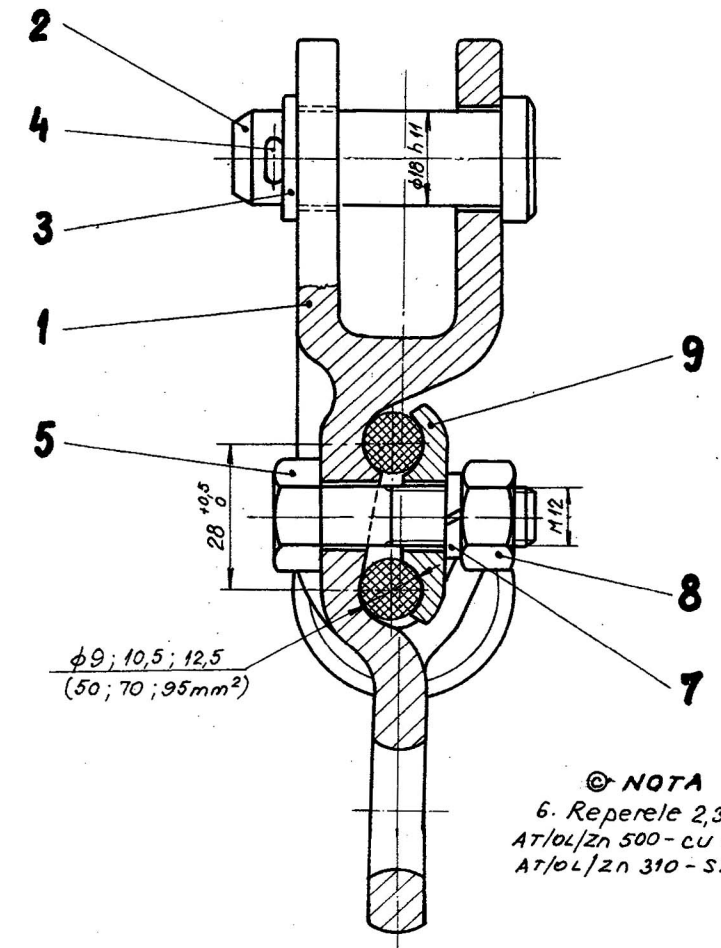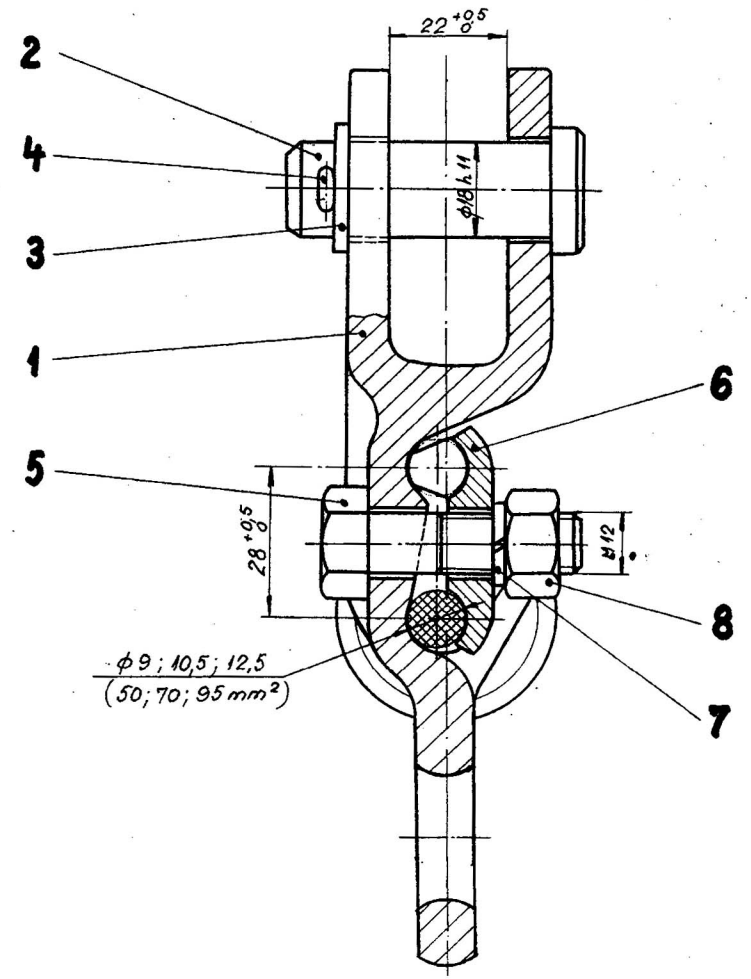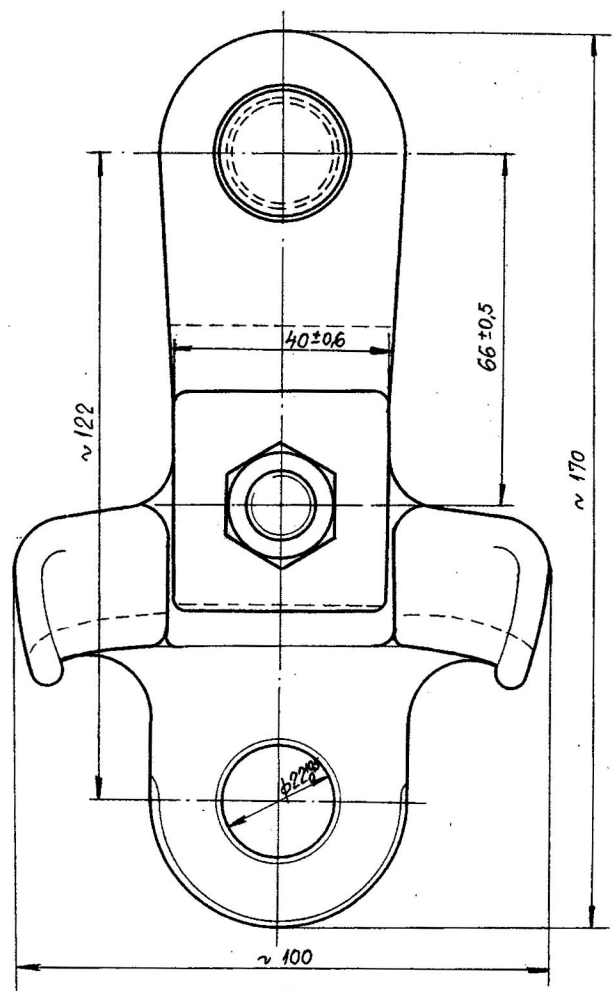

© **NOTA**
6. Reperele 2,3,4,5 și 8 se vor zincă AT/OL/Zn 500 - cu excepția filetelor AT/OL/Zn 310 - STAS 7221-90.

CTE
ing. Ciortan P.
[Signature]

Sef proiect,
ing. Spack I.
[Signature]

De acord,
Constructor
[Signature]

6

NOTA

1. Atiț șaua pentru 1 cablu cit și șaua pentru 2 cabluri se pot utiliza pentru cablurile purtătoare de 50; 70 și 95 mm² (φ9; φ10,5; φ12,5 mm)
2. Toate elementele șeii se vor zincă AT/OL/Zn 500/STAS 7221-82 ^(b) cu excepția poz. 5, 7 și 8 care se vor cadmia AE/OL/Cd12 - SL - FOS STAS 7222-74
3. Filetul șurubului poz. 5 și al piuliței poz. 8 se vor proteja cu vaselină anticorozivă pe timpul depozitării.
4. Prezentul desen are la bază planul LC/c-3 și LC/c-3A
5. Șaua se poate înlocui împreună cu brățara des. ELC 13-1.3.0, cu des. ELC 13-1.3.0A

1	-	9	Filieră ptr. 2 cabluri	E-LC-13.1.4.9	Fmn 35.10	Turnat	0,090
1	1	8	Piuliță M12 - gr.6.6	STAS 6245-65	20 Cr 130		0,016
1	1	7	Șaibă Grower MN12	STAS 7666-66	Arc 7A	Nichelat	0,003
1	1	6	Filieră ptr. 1 cablu	E-LC-13-1.4.6	Fmn 35.10	Turnat	0,095
1	1	5	Șurub M12x40 - gr.6.6	STAS 6220-65	20 Cr 130		0,050
1	1	4	Splint 4,5x28	STAS 1991-73	OL 34.1		0,005
1	1	3	Șaibă 7xT18	STAS 5200/4-71	OL 34.1		0,014
1	1	2	Bolt B18x50	STAS 5754-73	OL 50.1K		0,016
1	1	1	Șa	E-LC-13-1.4.1	Fmn 35.10	Turnat	1,000


Bucăți	Poz.	Denumirea	Nr. desen sau STAS	Buc.	Material	Observații	Masa netă Kg/buc.
130		C 9 Completări	26.x.96				
120		b 1 conf. minută 24 11 84	25 11 84				
		a 5 Modificat STAS	30.11.82				
		Proiectat	ing. Novleacu				
		Desenat	Aldea R.				
		Verificat	ing. Spack I.				
		Contr. STAS	ing. Novleacu				
		Aprobat	ing. Schimășcu				

E-LC-13-1.4.0

I.P.C.F. **1:1** **ȘA TIP I**


E.I.E.U. - Electricitate LC2 **Data: 24.11.976**

Masa netă: 1,300 kg

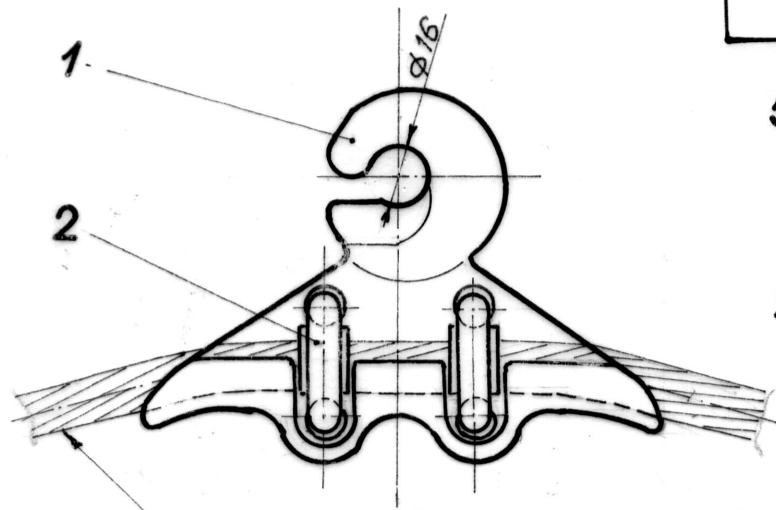

Cablu purtător 50; 70; 95 mm²
($\phi 9$; $\phi 10,5 \div 11$; $\phi 12,5$ mm)

N

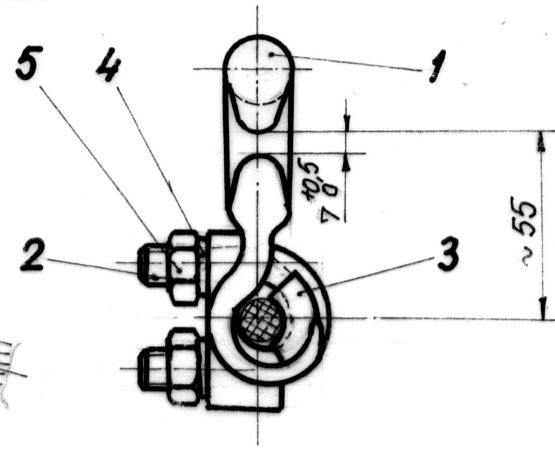

NOTA

D.G.I. *Kintan*

Șef proiect *[Signature]*

16

1. Reperele 1 și 3 se vor zincă AT/OL/Zn 600 - STAS 7221 - 90 înainte de zincare se vor detensiona printr-un tratament termic corespunzător.

2.* In cazul zonelor poluate reperetele 1 și 3 se vor executa din Cu Al 10 Fe 3T (nezincate).

3. Saibele poz. 4 se vor nichela AE/OL/Ni 40b - STAS 6705 - 90

Poz.	Denumire	Nr. desen sau STAS	Buc	Material	Obs	Masa netă kg/buc
5	Piuliță M10 - gr. 6.	STAS 922 - 89	2	20 Cr 130		0,011
4	Saibă N 10	SR 7666/2-94	2	OLC 55	nichelat	0,0025
3	Filieră	ELC13-1.4.3A	1	*T40C10		
2	Etrier	ELC13-1.4.2.A/I	2	20 Cr-130		
1	Sa I	ELC13-1.4.1A	1	*T40C10		

Proiectat Ing. Novleonu
Desenat Neagu M.
Verificat Ing. Bădăi L.
Contr. STAS Ing. Roman G.
Aprobat Ing. Tilichi H.

ELC 13 - 1.4.0A


**ISPCF
EIEU**

Masa netă:
scara
1:2


ȘA-I

Col. electrificarea - LC

Data: 05.1996

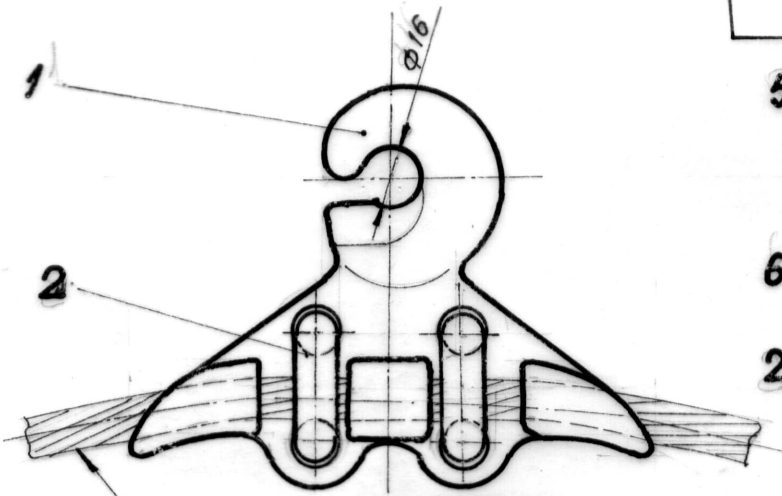

N

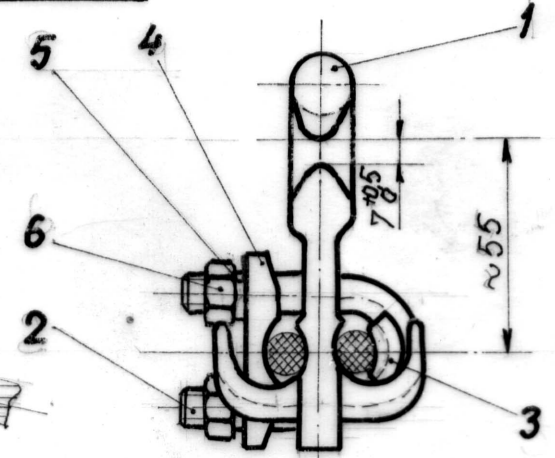

Cablu purtător 50·70·95 mm²
(φ 9; φ 10,5 ÷ 11; φ 12,5 mm)

D.G.J.
Cintan

Șef proiect

NOTA

1. Reperetele 1, 3 și 4 se vor zincă AT/OL/Zn 600 - STAS 7221-90; înainte de zincare se vor detensiona printr-un tratament termic corespunzător.

2.*In cazul zonelor poluate reperetele 1, 3 și 4 se vor executa din Cu Al 10 Fe 3 T (nezincate), procedeu de turnare C

6	Piuliță M 10 - gr. 6	STAS 922-89	2	20 Cr 130		0,011
5	Saibă N10	SR 7666/2-94	2	OL C 55	nichelat	0,0025
4	Plăcuță	ELC 13-1.4.4B	1	*T 40 C 10		
3	Filieră	ELC 13-1.4.3A	1	*T 40 C 10		
2	Etrier	ELC 13-1.4.2A/II	2	20 Cr 130		
1	Șa II	ELC 13-1.4.1.B	1	*T 40 C 10		
Poz.	Denumire	Nr. desen sau STAS	Buc.	Material	Obs.	Masa netă Kg/buc

Proiectat Ing. Novleanu D.
Desenat Neagu M.
Verificat Ing. Bădăi L.
Contr. STAS Ing. Roman O.
Aprobat Ing. Tilichi H.

ISPCF
EIEU

Col. electrificarea - LC

Masa netă
scara

1:2

Data: 05. 1996




ELC 13-1.4.0 B

ȘA-II



N

NOTĂ

1. Distanța între planurile de separare max 0,5 mm.
2. Muchiile necotate R0,5 mm
- 3.** Se va insista în mod deosebit pentru obținerea unei suprafețe curate lipsite de bavuri.
4. Se va zincea AT/OL/Zn 600 - STAS 7221.
- 5.* Pentru zone poluate se va executa oia Cu Al10Fe3T, nezinată, procedeu de turnare.

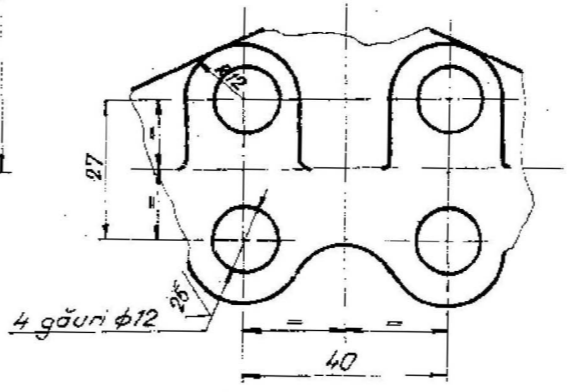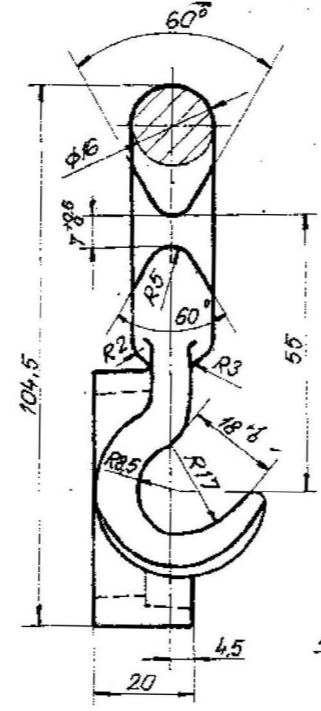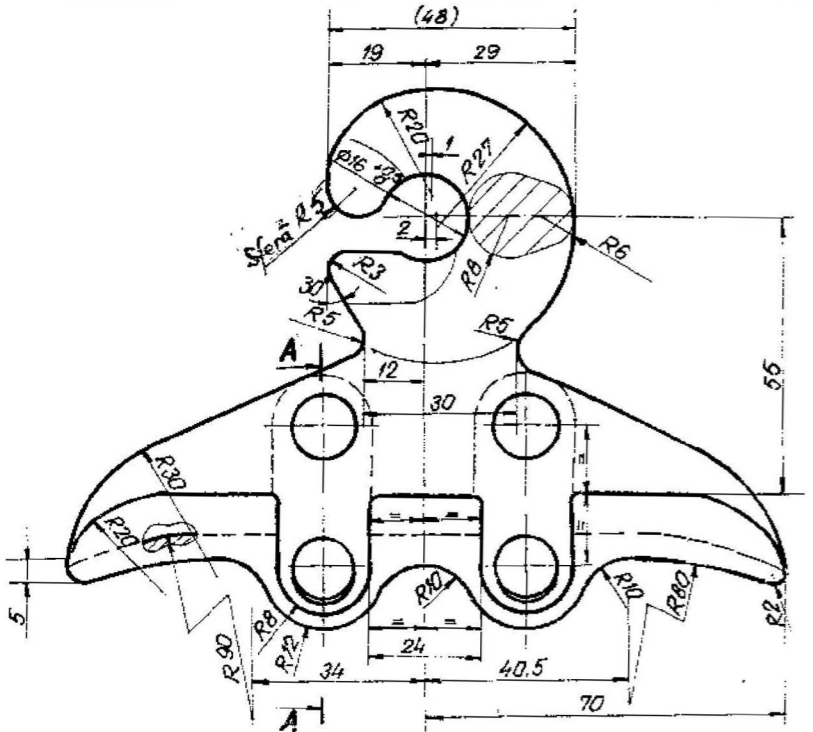


A - A

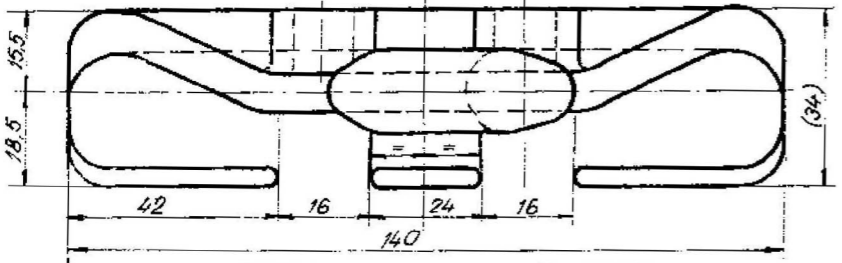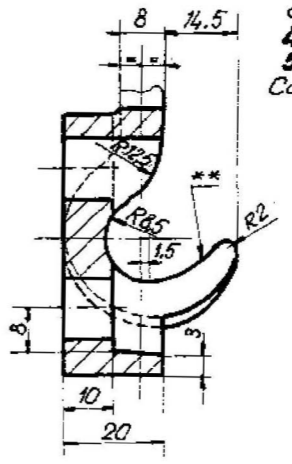

D.G.T.
Burtan

Sef proiect

Proiectat	Ing. Năvicanu		
Desenat	Aleogu M.		
Verificat	Ing. Bădi L.	* T 40C10	ELC 13-1.4.1A
Contr. STAS	Ing. Roman U.	Masa nea	
Aprobat	Ing. Iliechi H.	scara	SA I
I.S.P.C.F.		1:1	
E.I.E.U.			
Col. electricitare - LC		Data: v. 1996	

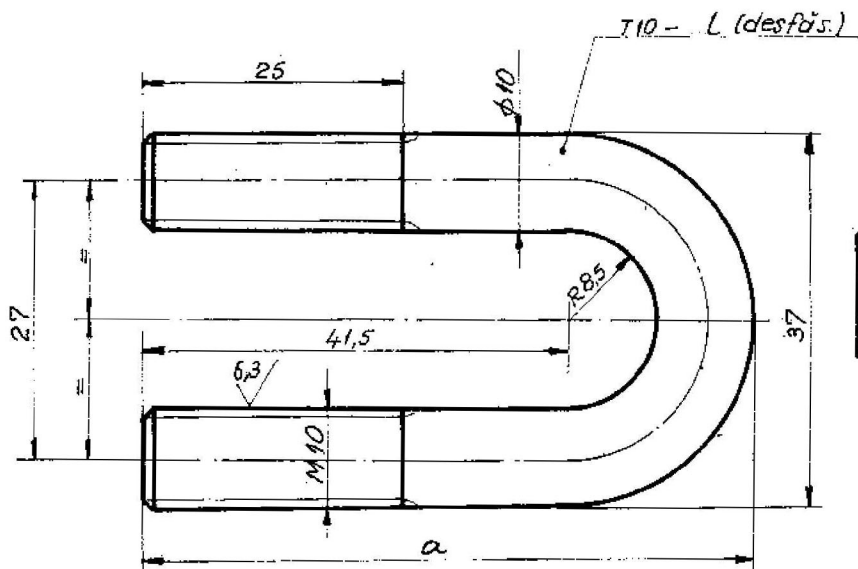

Tip	a	L	Masa (kg)
I	50	10,5	0,065
II	60	12,5	0,080

D.G.T. *Cuțan*



Sef proiect

Ing. Cr. Popescu

50/✓✓


Proiectat Ing. N. Veanu	20 Cr 130	ELC 13-1.4.2A
Desenat Bodea F.		
Verificat Ing. Bodea Z.		
Contr. STAS Ing. Romano O.		
Aprobat Ing. Tillich R.	Masa netă:	ETRIER
I. S. P. C. F.	Scara:	
EIEU	2:1	
COZ. ELECTRIFICARE-LO	Data: 4.1996	

N

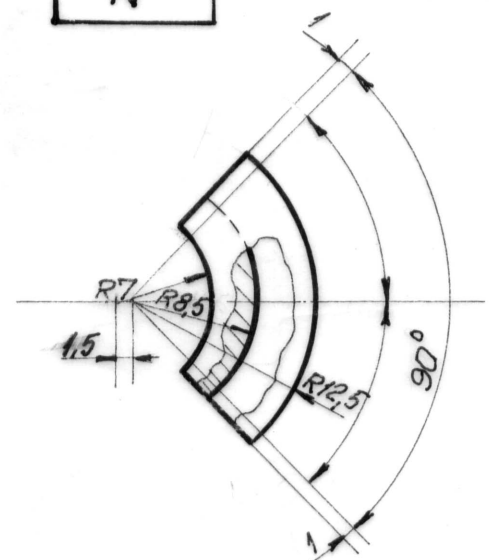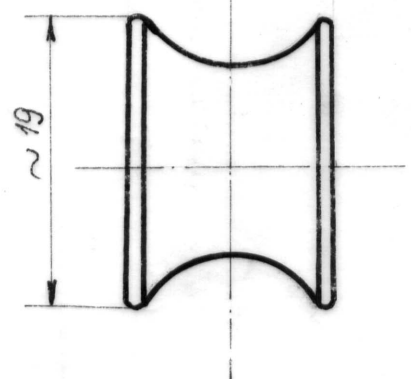

NOTA


1. Se va zincea AT/OL/Zn 600 STAS 7221 - 90 ; inaintede zincare se va detensiona prin tratament termic.
2. *Pentru zonele poluate filiera se va executa din Cu Al 10 Fe 3, nezincaata ; procedeu de turnare c

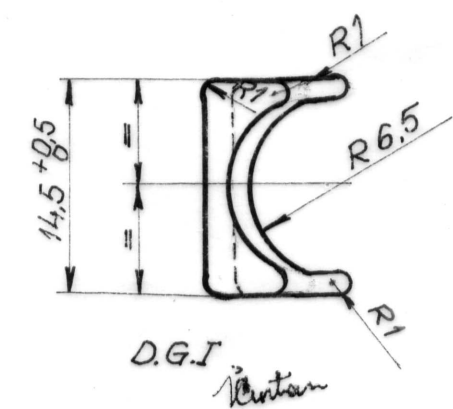


Se proiectat
[Signature]

19
50

Proiectat Ing. Navleanu D.		*T 40 C 10	ELC 13 - 1.4.3A
Desenat Neagu M.			
Verificat Ing. Bădăi L.			
Contr. STAS Ing. Roman D.			
Aprobat Ing. Tilichi H.			
I. S. P. C. F EIEU		scara 2:1	FILIERA
		Data: 05.1996	
Col. electrificare - LC			

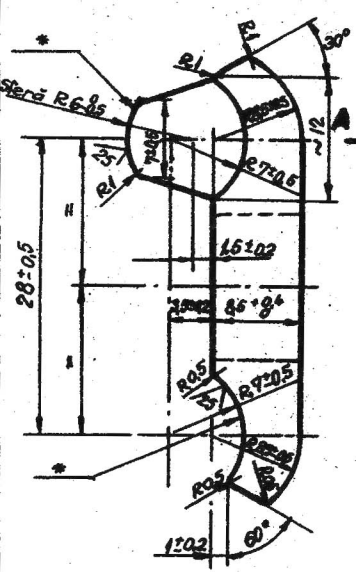


SECTIUNEA A-A

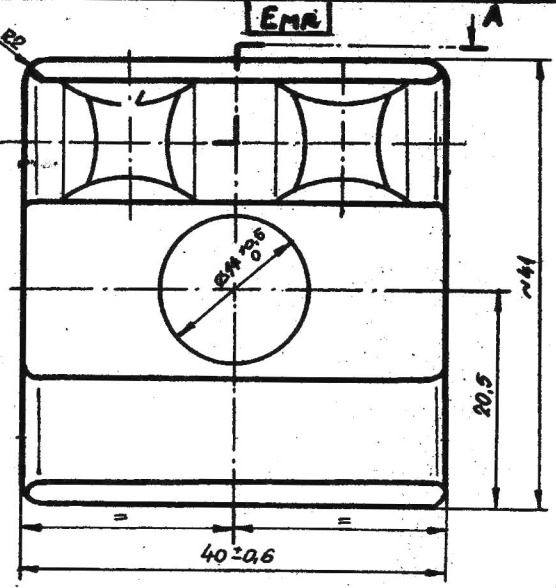

NOTA

1. Nu se admit surluri în adâncime mai mare de 1mm și cu diametrul mai mare de 6mm, distanța minimă dintre două surluri fiind de minim 18mm.
 2. Suprafața piesei trebuie să fie lipsită de fieruri și se va curăța de bavuri și cruste.
 3. Depășirea admisibilității în planul de separare a modelelor va fi de cel mult 0,6 mm.
 4. Se va insista asupra obținerii unei aspect curat, neted a suprafeții notate cu *
 5. După turnare, piesa va fi supusă unei recocerii de fertilizare și anume:
 - încălzire la 950°C și menținerea la ac. temperatură minimum 5 ore.
 - răcire lentă de la 750°C la 700°C min. 20 ore.
6. După tratamentul termic, piesa va fi zincată de 100g/m² în soluție de zinc în acid acetic.
 AT 100 / 20.300 / STAS 9221-82
 STAS 7222-74
7. Înainte de zincare piesa se va trata termic pentru defensionare

CTE De acord,
 ing. Clifton P. constructor
 [Signature]

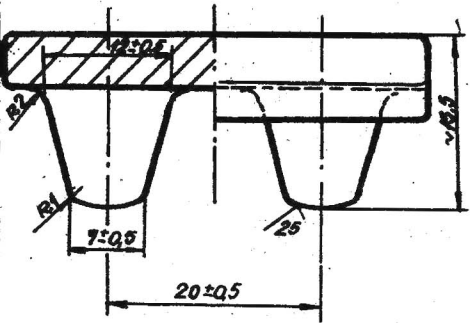

Sel proiect,
 ing. Spackl. [Signature]

Proiectat	Verificat	Contr. STAS	Executat	Material	EMR 32.10	E-LC-13-1.4.6
Desenat	Ing. Spackl.	Ing. Spackl.	Ing. Spackl.	Ing. Spackl.	Masa netă	

I.P.C.F.

E.I.E.U.
 Col. Electrificare LC 2

2:1



FILIERA PTR. 1 CABLU

Data: 8.11.1976

E

NOTA

1. Nu se admit cavități în adâncime mai mare de 1mm și cu diametrul mai mare de 5mm, distanța minimă dintre două cavități fiind de 15 mm.
2. Suprafața piesei trebuie să fie lipsită de fisuri și se va curăța de bavuri și cruste.
3. Deplasarea admisibilă în planul de separare a modelelor va fi de cel mult 0,6 mm.
4. Se va insista asupra obținerii unui aspect curat neted a suprafeții notate cu *
5. După turnare, piesa va fi supusă unei recondiții de fertizare și anume:
 - încălzire la 950°C și menținerea la această temperatură minimum 5 ore.
 - răcire lentă de la 700°C la 700°C min. 20 ore
6. După tratamentul termic se va zincifica:
 - ~~AE/OL/ET 40 SL/Fos STAS 922-74~~
 - ~~ET/OL/Zn 500 STAS 7221-02~~ ⁸⁰ (a) (b)
- (b) 7. Înainte de zincare piesa se va trata termic astfel încât după zincare caracteristicile mecanice ale materialului să nu fie diminuate.

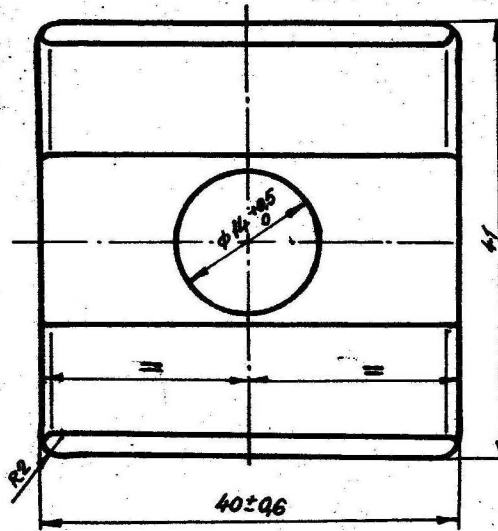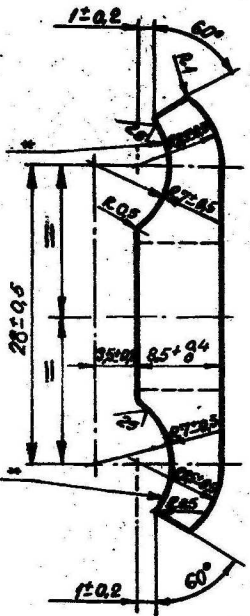

Seif proiect
Ing. Spăak I.

C.T.E.
Ing. Ciortea P.

De acord
Construcător

b 3	Completări	25.10.95	Intenționa SP
a 1	conf. minuta 24.V.84	25.10.95	Ing. Mănduc
Proiectat	Ing. Mănduc		
Desenat	Ing. M. N.		
Verificat	Ing. Mănduc		
Construcător	Ing. Mănduc		
Verificat	Ing. Mănduc		

B35-10
FMT 05.10 (b)



E-LC-13-1.4.9.

I.P.C.F.
E.I.E.U
Col. electrice LC2

FILIERĂ PENTRU
2 CABLURI

NOTA

- 1. Se va admira AE /
- 2. Pe timpul depozitării șilei va fi protejată cu vopsea anticorozivă.

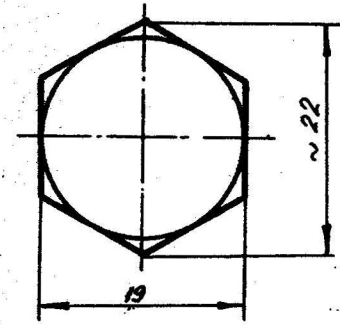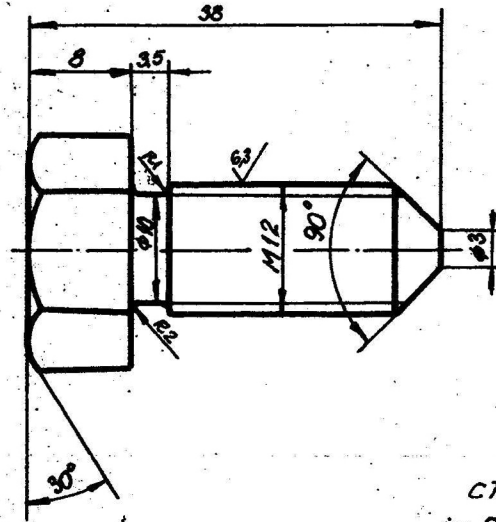

C.T.E.
ing. Ciortan P.
S.A.

Sef proiect,
ing. Spacu I.

De acord,
Constructor 25

2.3 Completari		26.3.86 in Moldova			
Proiectat	ing. Spacu I.				
Verificat	ing. Spacu I.				
Constr. STAS	ing. Spacu I.				
Aprobat	ing. Spacu I.				

ALCO-1R
20 Cr 130
Masa netă:

E-LC-13-3.3.B



I.P.C.F.

2:1



SURUB

E.I.E.U. Colectiv
Electrificarea LC2


Data: 9 noi 1976

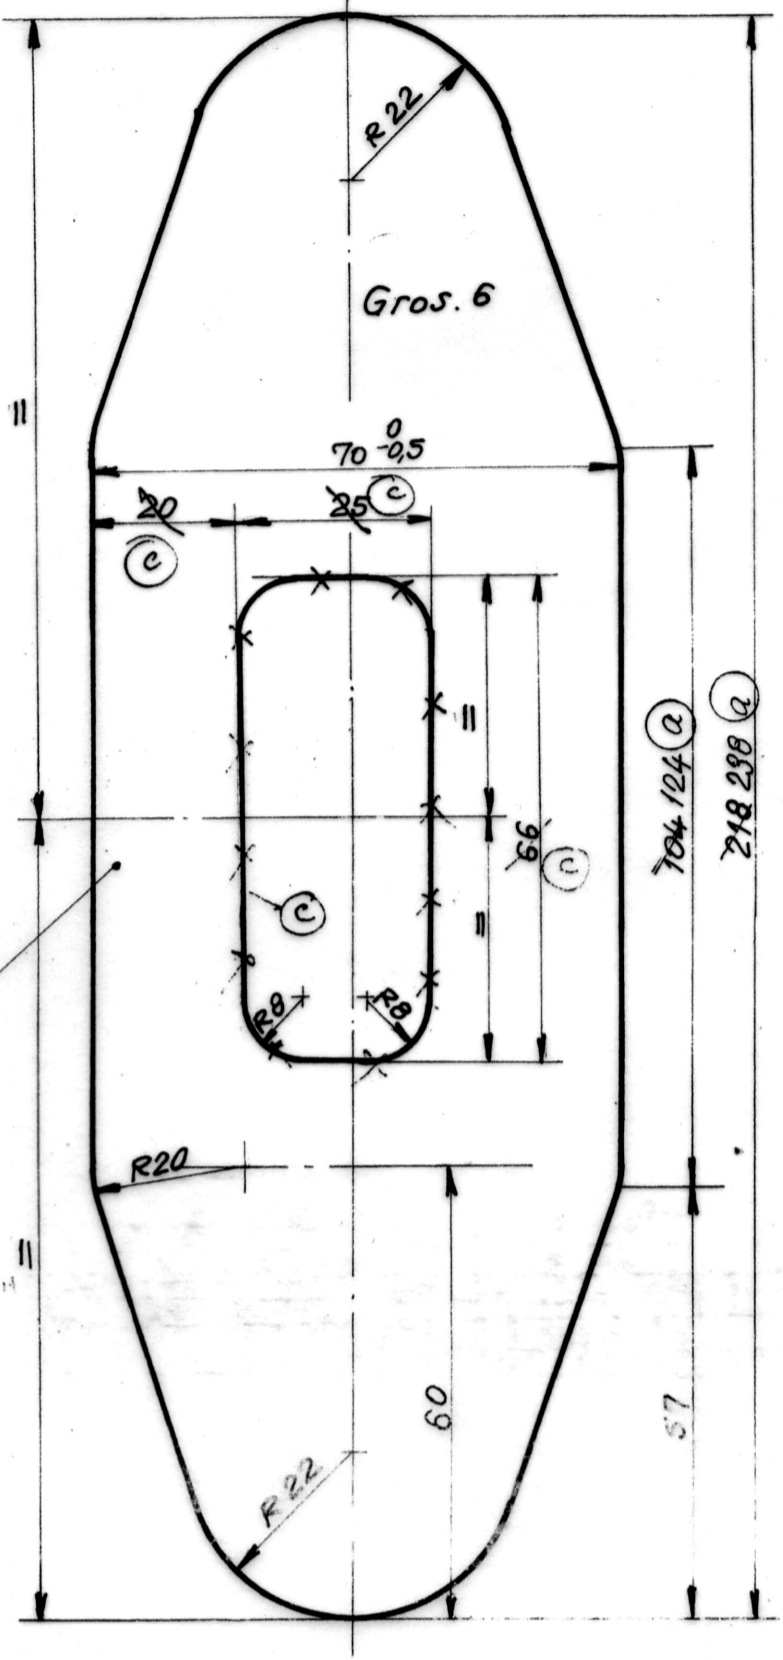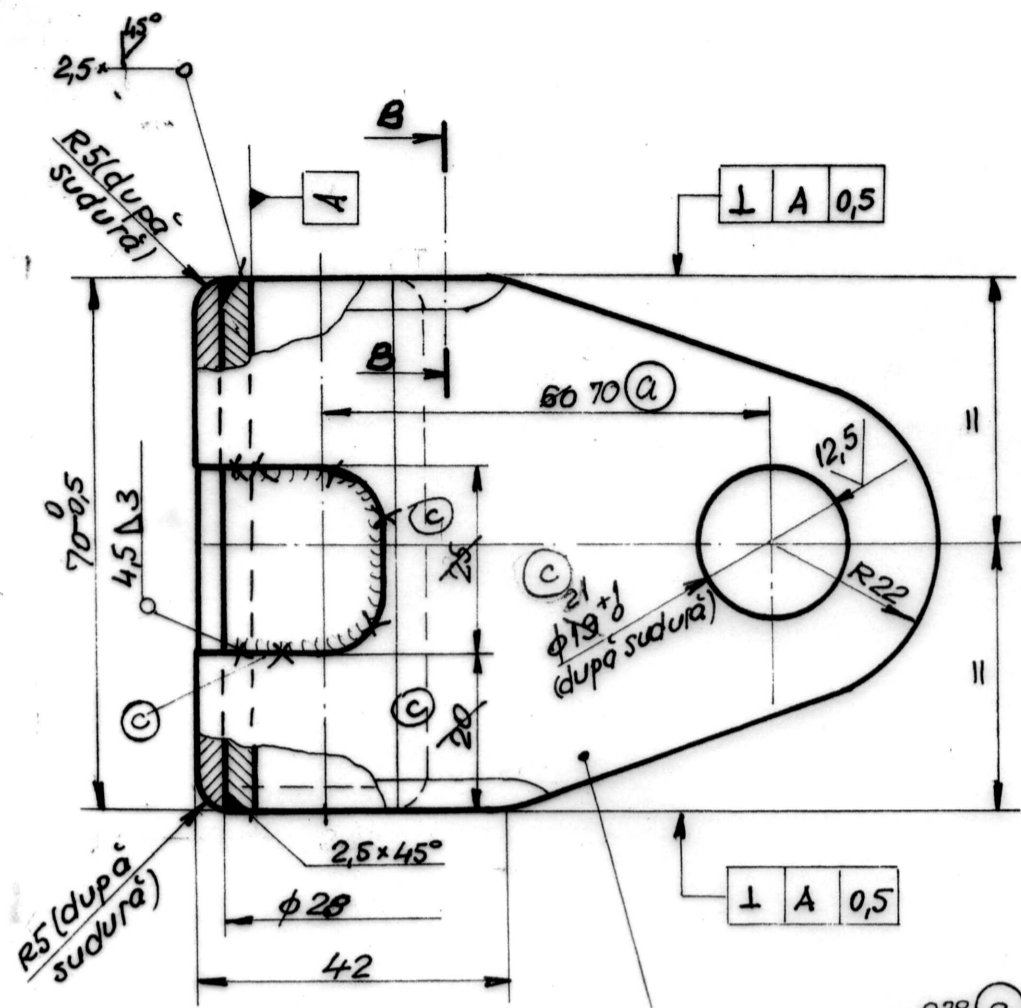

LT 70x6 - 216 (def.)
P1

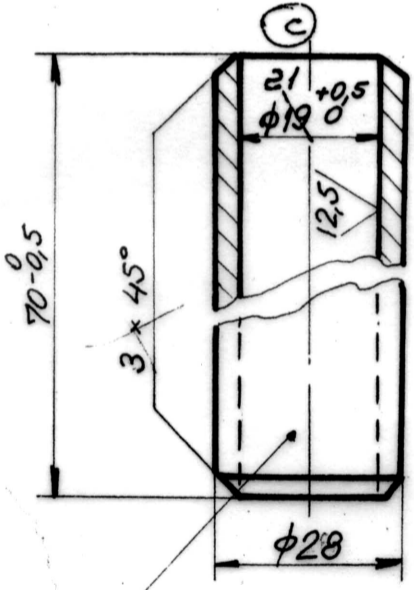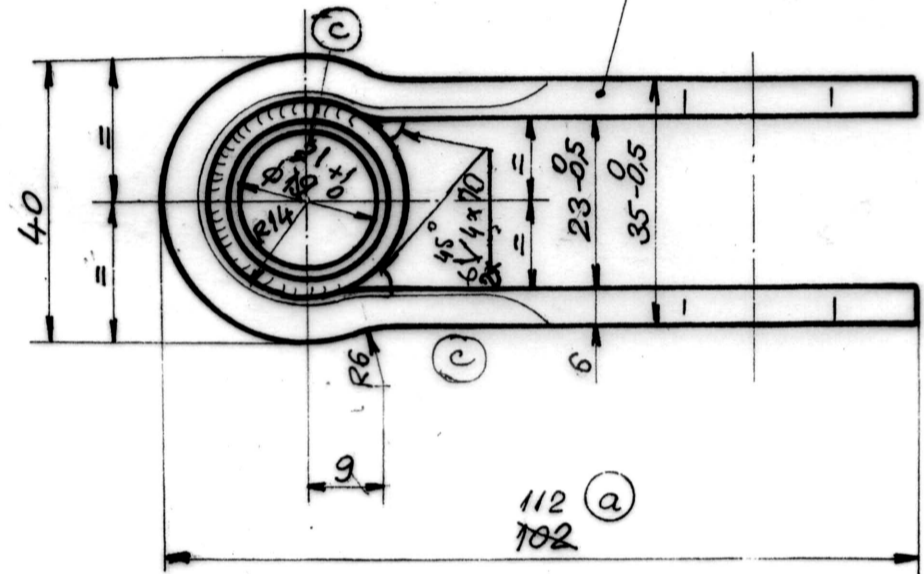

TEAVO^s 28x4,5-70
P2

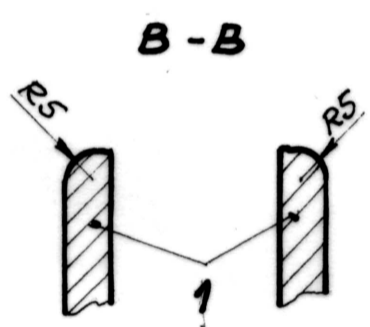

NOTA
1. Muchiile se vor teji 1x45°
2. După sudură se va zincea
AT/OL/Zn 600 - STAS 7221-90

50 ✓ ✓ ✓ (a)

D.G.J. Bintan
Sef proiect
Ing. Cr. Popescu






2	Ghidaj	-	1	OL 37.2	TEAVO ^s 28x4,5 STAS 530 14-87	0,185
1	Furcă	-	1	OL 37.2	LT 70x6 STAS 395-87	0,510
Poz.	Denumirea	Nr. desen sau STAS	Buc	Material	Observatii	Masa neto kg/buc

Modific prototip 14-09-01 Ing. D. Noykany
Modific prototip 5-11-96 Ing. D. Noykany
Proiectat Ing. Noykany
Desenat Bodea F.
Verificat Ing. Bobbi L.
Contr. STAS Ing. Roman
Aprobat Ing. Tilichi H

I.S.P.C.F.
EIEU
COL. ELECTRIFICARE-LC
Scara:
1:1
Data: VI. 1996

ELC 13-9.10 A
**BALAMA PTR.
TIRANT**

Desfășurata poz. 1

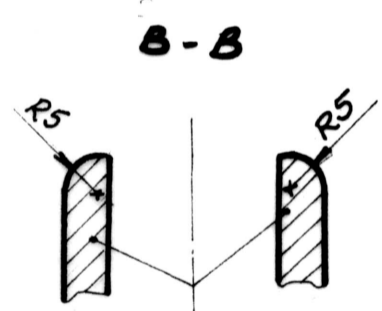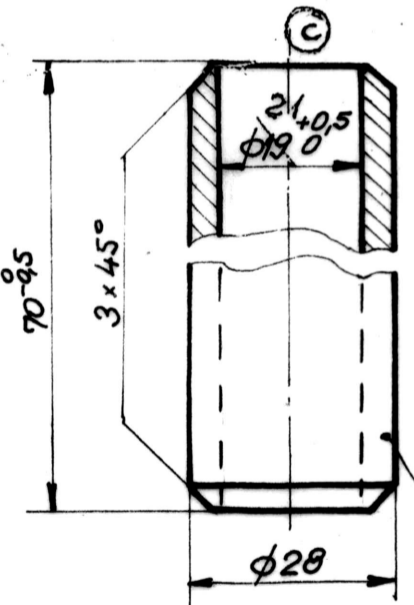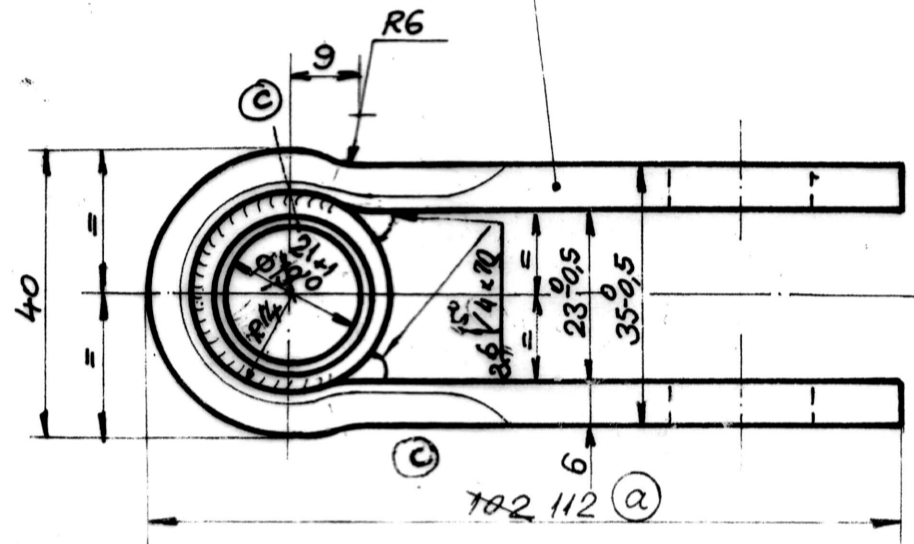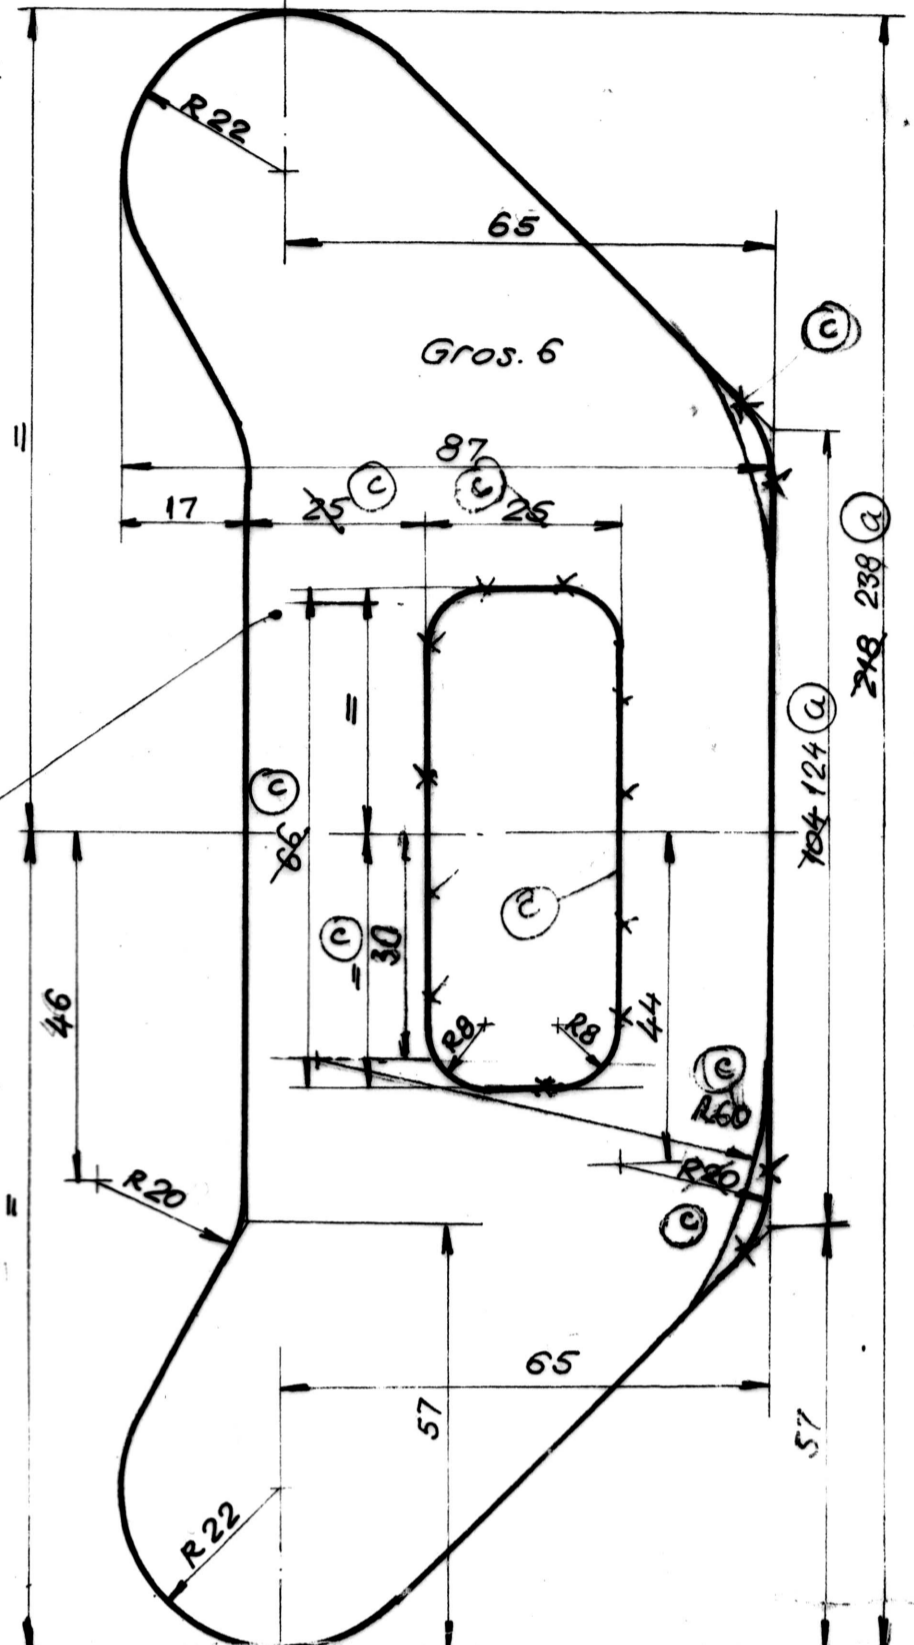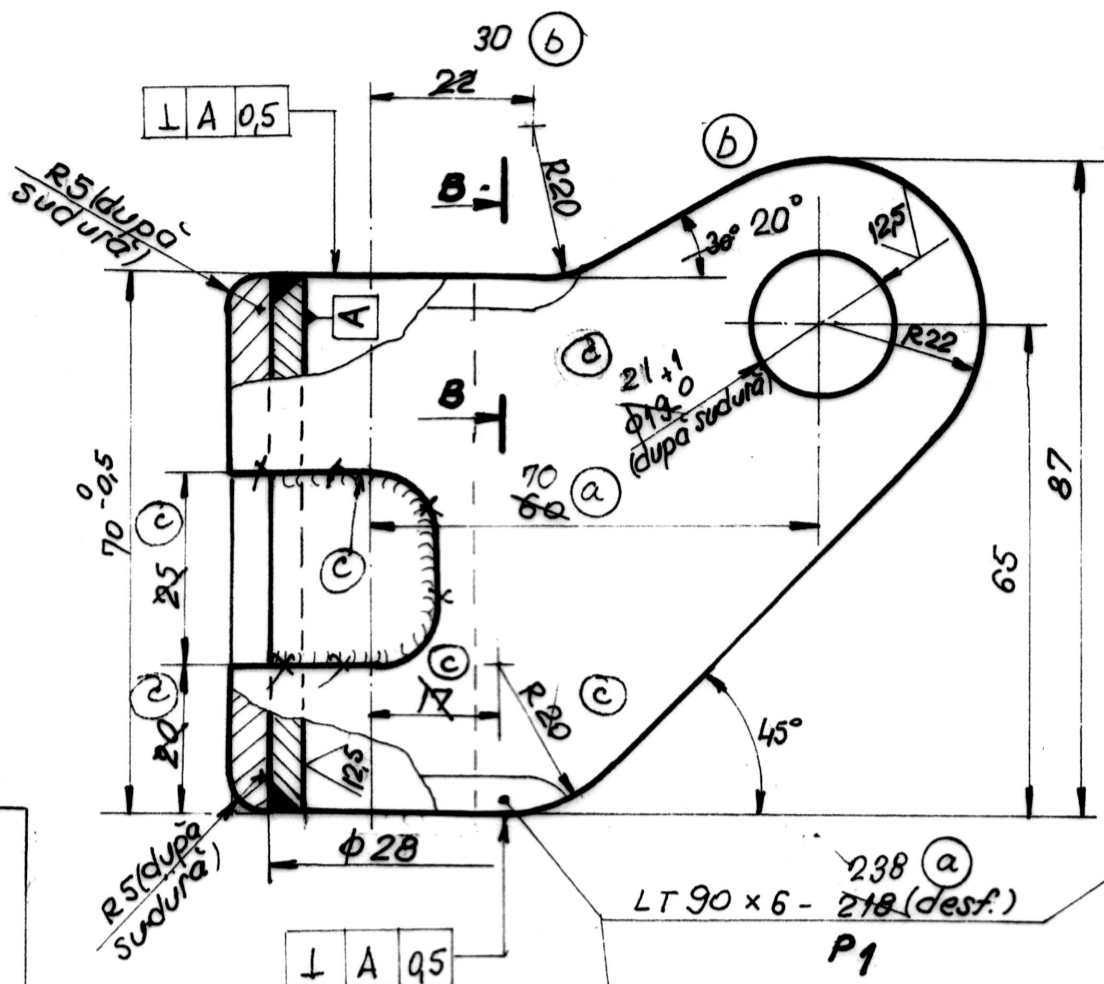


NOTA

1. Muchiile se vor tesii 1 x 45°
2. După sudură se va zincea AT/OL/Zn 600 - STAS 7221-90

Teavă 26 x 4,5 - 70
P2

D.G.I. Rintan
Sef proiect
Ing. Cr. Popescu

Poz	Denumirea	Nr. desen sau STAS	Buc	Material	Observatii	Masa netă kg/buc
2	Ghidaj	-	1	OL 37.2	Teavă 26 x 4,5 STAS 5301-87	0,185
1	Furcă	-	1	OL 37.2	LT 90 x 6 STAS 395-87	0,520
						Masa netă kg/buc
c/6 Modific prototip 14-09-01 Ing. Novleanu b/2 Modific prototip 7-11-96 Ing. D. Novleanu a/3 Modific prototip 5-11-96 Ing. D. Novleanu Proiectat Ing. Novleanu Desenat Badea F. Verificat Ing. Bădăi L. Contr. STAS Ing. Roman Aprobat Ing. Tilichi H.						
I.S.P.C.F. EIEU COL. ELECTRIFICARE-LC						Masa netă: 0,71 kg Scara: 1:1 Data: VI.1996
ELC 13 - 9.11.A BALAMA PTR. CONTRAFISA						

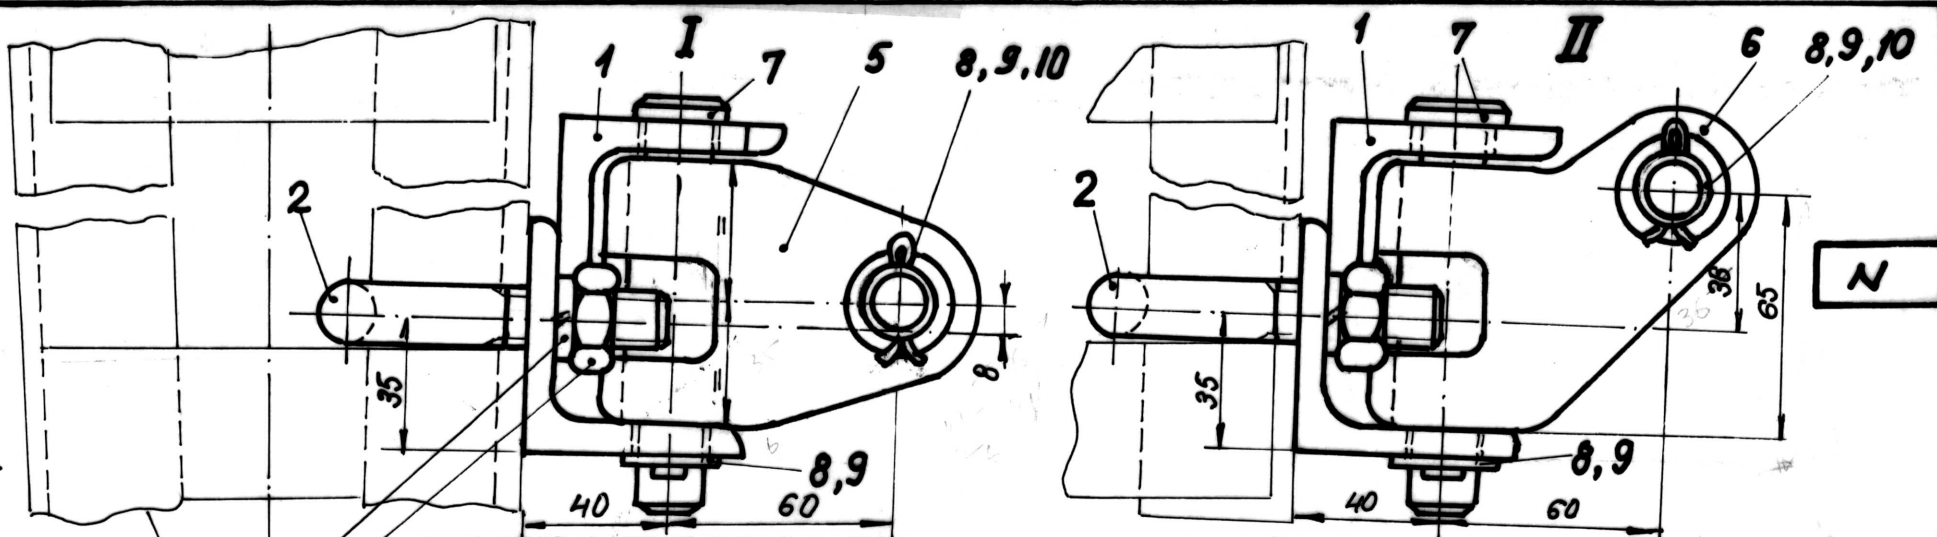

Pinten (montant)

D.G.I. Șef proiect
Bonton Ing. Cr. Popescu

NOTĂ:

1. Reperete se vor zincea AT/DL/Zn 600-STAS 7221-90 cu excepția filetelor: AT/DL/310.

2. Boltul poz. 7 se va monta cu capul în sus.

1	1	10	Bolt B ²⁰ x 50 @	STAS 5754/1-80		DL 50.1K		0,130
2	2	9	Splint 4,5 x 40	STAS 1991-89		DL 34		0,006
2	2	8	Saibă T ¹⁸ 20 @	STAS 5200/4-91		DL 34		0,013
1	1	7	Bolt B ¹⁸ x 110 @	STAS 5754/1-80		DL 50.1K		0,237
1	-	6	Balama pt. contrafisă	ELC 13-9.11-A				0,710
-	1	5	Balama pt. tirant	ELC 13-9.10-A				0,700
2	2	4	Piuliță	STAS 922-89		DL 37.2		0,030
2	2	3	Saibă 16	SR 7666/2-93		DLC 55		0,004
1	1	2	Bridă	ELC 13-13.2		DL 37.2	STAS 1800-87 ^{T16}	0,410
1	1	1	Support	ELC 13-13.1A				1,300

Bucăți	Poz.	Denumirea	Nr desen sau STAS	Buc.	Material	Observații	Masa netă
--------	------	-----------	-------------------	------	----------	------------	-----------

0	3	Modificare prototip	14.09.91	ing. Novleanu			
---	---	---------------------	----------	---------------	--	--	--

Proiectat	Ing. D. Novleanu	
Desenat	R. Novleanu	
Verificat	Ing. L. Bădoi	
Contr. STAS	Ing. O. Roman	
Aprobat	Ing. H. Tilichi	

ELC 13-13.0A

Masa netă:

I. S. P. C. F.
E. I. E. U.

Scara:
1:2

COL. ELECTRIFICARE-LC



Data: Ț 1997

CRAPODINĂ PT. O CONSOLĂ
SIMPLĂ PE PINTEN

N

NOTĂ

Se va zincea AT/OL/Zn
600 - STAS 7221-90

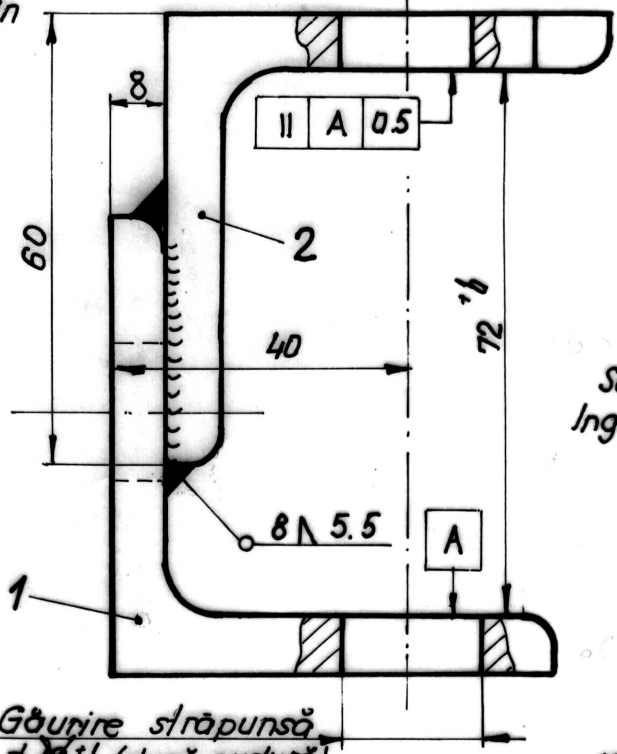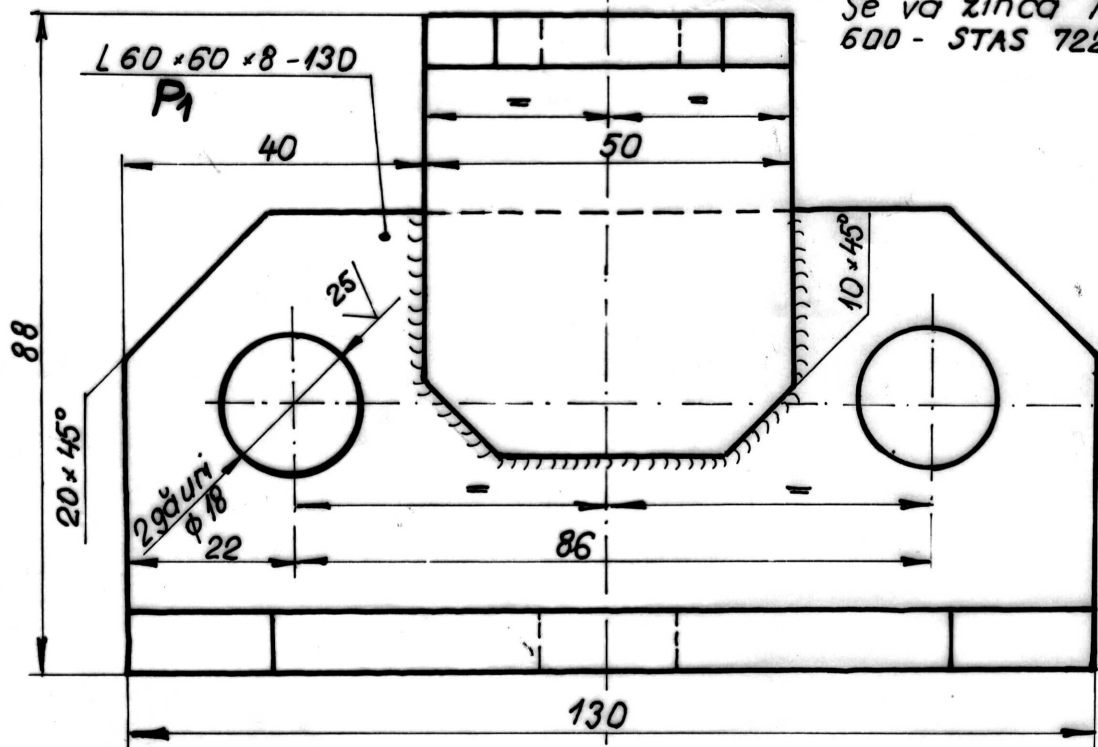


D. G. I.
Bitar

Șef proiect
Ing. G. Popescu

Găurire străpunsă
φ 18 (după sudură)
Q 21

100/

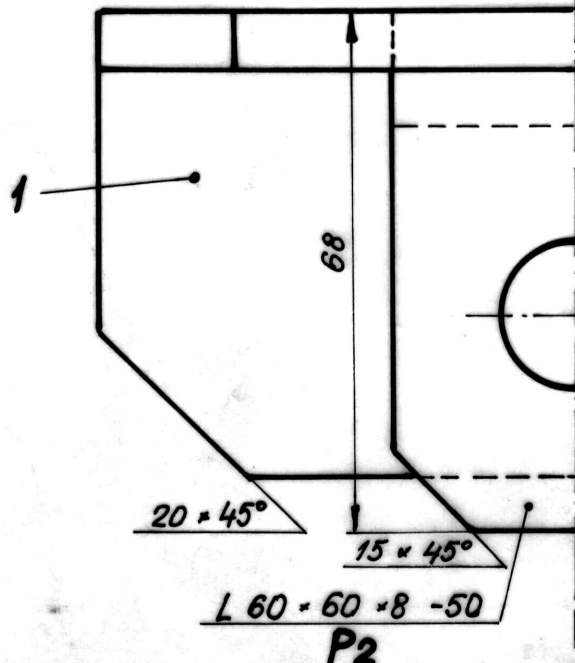


Poz.	Denumirea	Nr. desen sau STAS	Buc	Material	Observații	Masa netă kg/buc
2	Cornier	-	1	OL 37.2	L60*60*8	0.350
1	Cornier	-	1	OL 37.2	L60*60*8 STAS 424-91	0.92

a. 1 Modificare prototip 14.09.91. Ing. Novleanu
Proiectat Ing. D. Novleanu
Desenat R. Novleanu
Verificat Ing. L. Bădăi
Contr. STAS Ing. D. Roman
Aprobat Ing. H. Tilicchi

ELC 13 - 13.1 A

I. S. P. C. F.
E. I. E. U.
COL. ELECTRIFICARE - LC
Masa netă
Scara:
1:1
Data: V-1997

S U P O R T

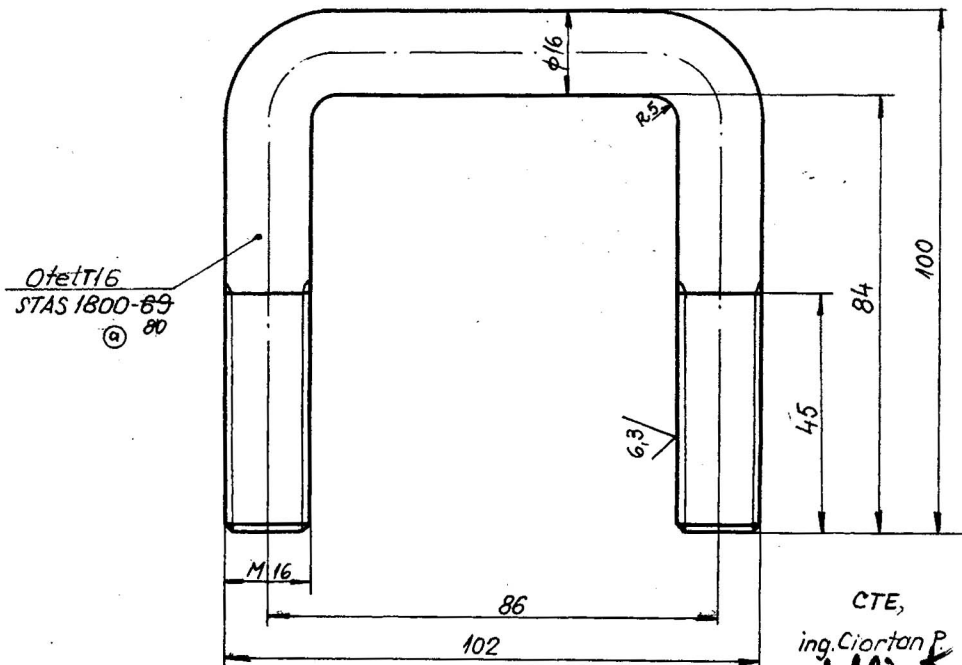

Lungimea desfășurată ~ 60 mm.

NOTA

1. Prezentul plan are la bază desen LC 523-1
2. Se va forja la cald
3. Se va ~~cazina~~ A5/OL/CT12 =
~~SL STAS 7222-74 A7/OL/zn610/~~
 STAS 7221-82 (b) Sef proiect,
 ing. Spack I.

b 1	conf. minuta	24 IV 84	25 IV 84	ing. Novleanu
a 1	Modificări	STAS	30.11.82	ing. Novleanu
Proiectat Ing. Novleanu D.				
Desenat Aldea R.				
Verificat Ing. Spack I.				
Contr. STAS Ing. Novleanu D.				
Aprobat Ing. Schimdti.				
OL 37-2K				E-LC-13-13.2
Masonetă: 0,41 Kg.				


I. P. C. F.

1:1


BRIDA

E. I. E. U. - Electricitare - LC 2

Data: 1 sept. 1976

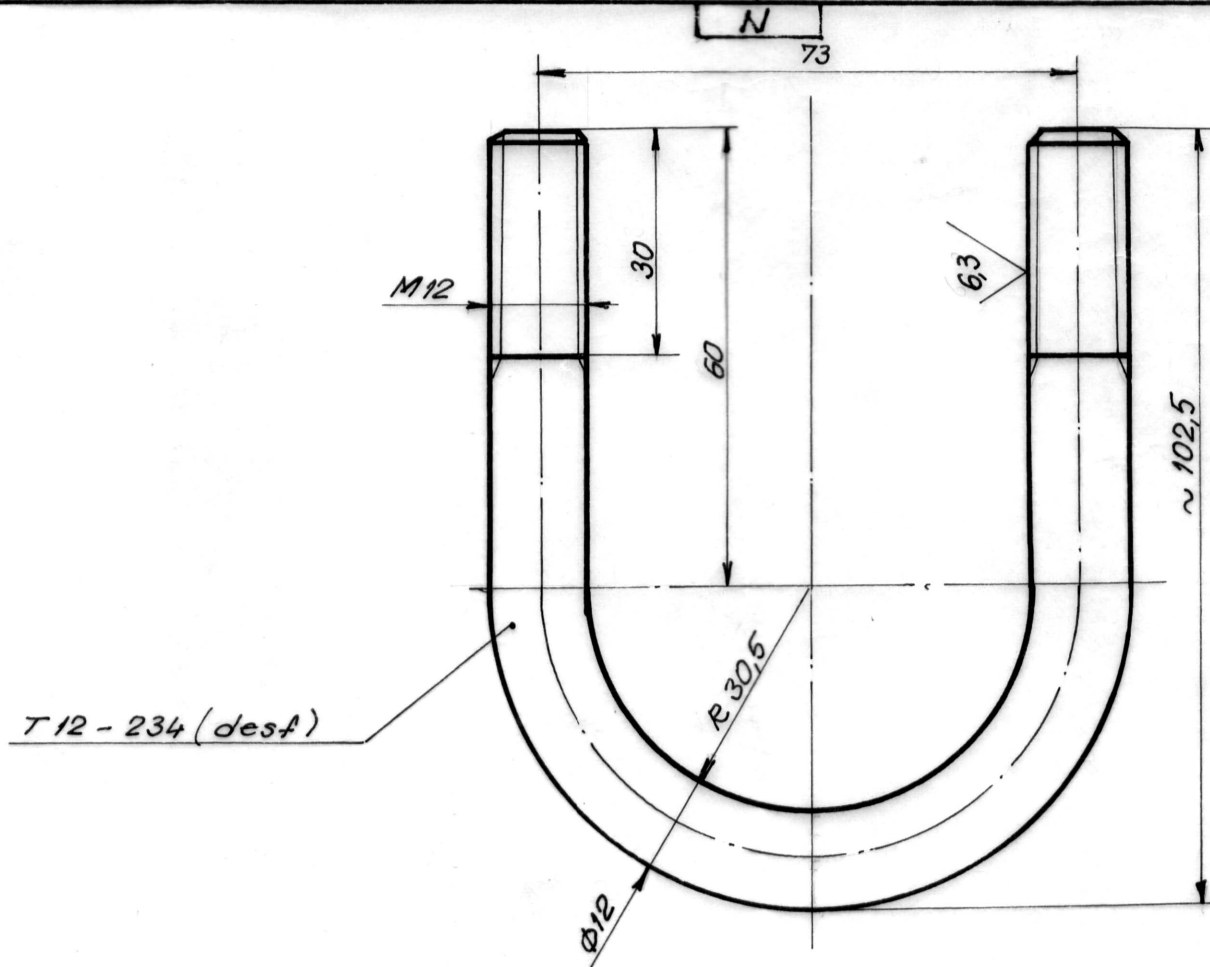


DGI,
Bintan

Set proiect


10


25


Proiectat Ing. Navleand Desenat Neagu M. Verificat Ing. Bădăi L. Contr. STAS Ing. Roman O. Aprobat Ing. Tilichi H.		20 Cr 130 Masa netă: 0,334 kg Scara: 1:1 Data: 06.1996	ELC 13-13.3B BRIDA
I.S.P.C.F EIEU Col. Electricare - LC			

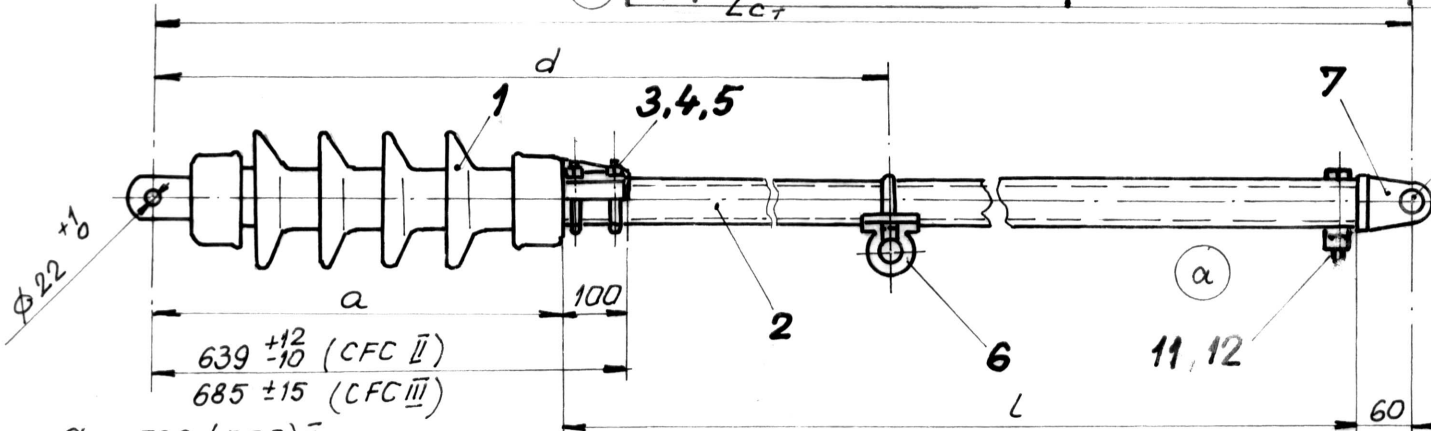

DGI,
Cintau
Set proiect,

$a = 539$ (CFC) II
 $a = 585$ (CFC) III

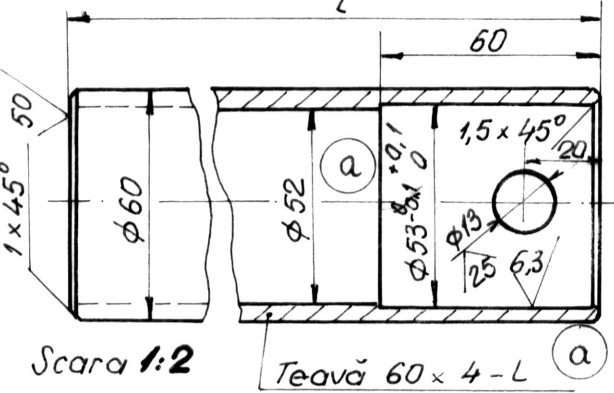

NOTA

1. Poz. 2, 7, 8, 9 și 10 se vor zincea termic AT/OL/Zn 500 - STAS 7221-90 cu de-tensionare prin tratament termic
2. Pentru zonele poluate se va utiliza izolatorul CFC III (poz. 1) iar pentru zonele normale CFC II
3. Brățara și piulițele din brida cu cercel poz. 6 vor fi din 20Cr130 iar saibele se vor nichela
4. Urechile capacului cu turcă poz. 7 se vor poziționa paralele cu urechea izolatorului.



Poz.	Denumirea	Nr. desen sau STAS	Buc.	Material	Observații	Masa netă Hg/buc.
11	Surub M12 x 90-gr 8-8	SRISO 4018-94	1	20 cr. 130		0,090
10	Splint 4,5 x 40	STAS 1991-89	1	OL 34		0,006
9	Saibă T18	STAS 5200/4-91	1	OL 34		0,013
8	Bolt, B18 x 50	STAS 5754/1-80	1	OL 50.1K		0,130
7	Capac cu turcă	ELC 13-14.7.0B	1			1,000
6	Bridă cu cercel	ELC 13-1.2.3.0	1			0,830
5	Piulită M12-gr 6	STAS 922-89	8	20 Cr 130		0,016
4	Saibă 12	SR 7666/2-94	4	OLC 55	Nichelat	0,003
3	Bridă	ELC 13-13.3.B	2	20 Cr 130	T12 STAS 1800-87 Teavă 60x4 STAS 404/1-87	0,034
2	Contrațisă	-	1	OLT 45		
1	Izolator baston CFC	Ceramica Turda	1	Portelan		

a 5 Modific prototip 9-27.98 Ing. O. Navleanu
Proiectat Ing. Navleanu
Desenat Neagu M.
Verificat Ing. Bădăi L.
Contr. STAS Ing. Roman O.
Aprobat Ing. Tilichi H.

ELC 13-14.0B

I. S. P. C. F.
EIEU
Col. electrificare - LC
Data: 06.1996

CONTRAFIȘĂ

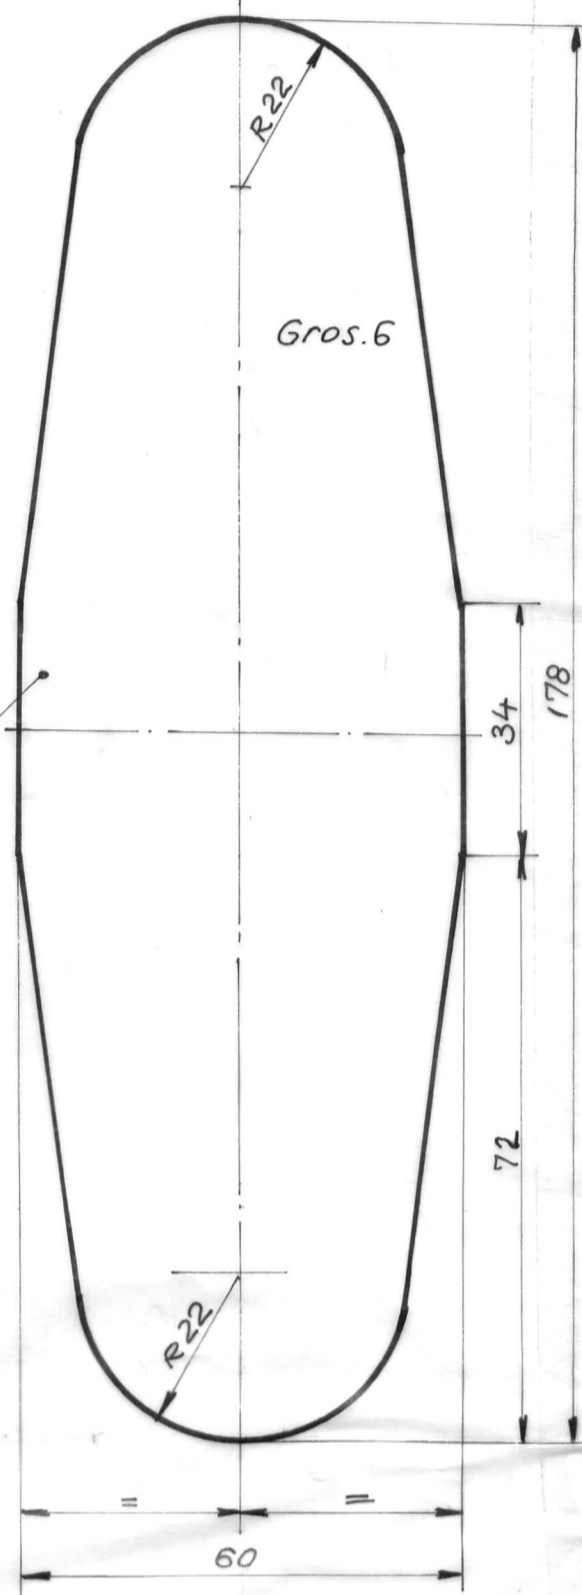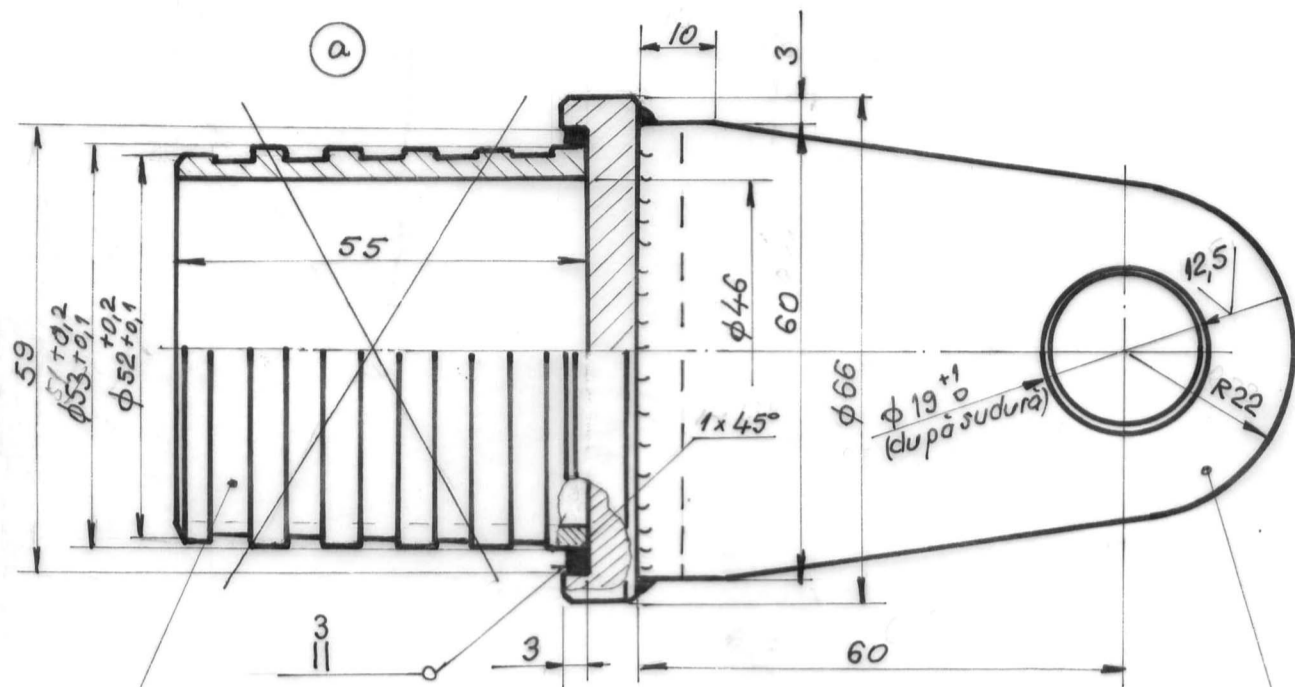


Teavă 54x4 - 55

P1

LT60x6 - 178 (desf.)

P3

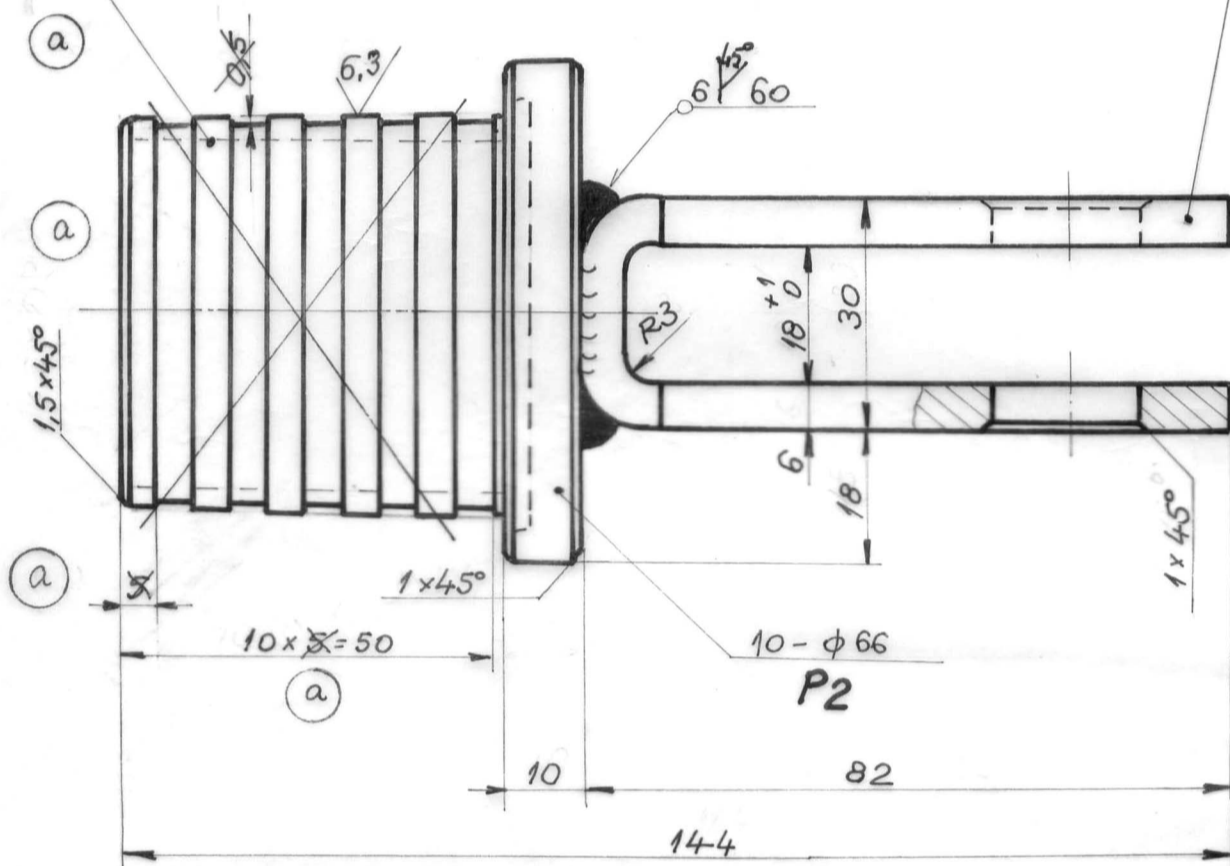

P2


NOTA

1. Prelucrarea canelurilor stutului poz.1 se va realiza după sudură
2. Se va zincea AT10L/Zn 600 - STAS 7221-91.
3. Capacul cu furcă, se va monta în capul contrafisei încă de la uzină.

D.G.I. *Rintan*

set proiect
Ing. Cr. Popescu

50

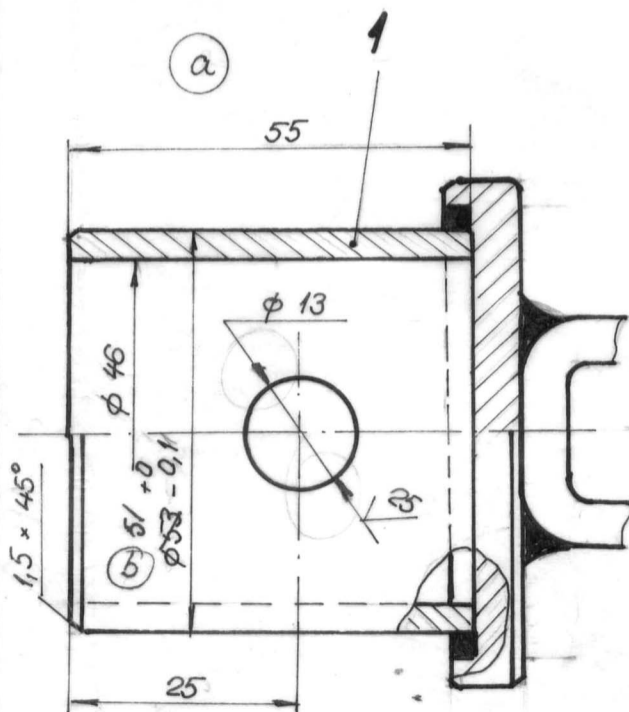

Poz	Denumirea	Nr. desen sau STAS	Buc	Material	Observatii	Masa netă Kg/buc
3	Furcă	-	1	OL 37.2	LT 60x6 STAS 395-87	0,440
2	Placă	-	1	OL 37.2	Tabla 10 STAS 505-86	0,270
1	Stut	-	1	OLT 35	Teavă 54x4 STAS 4041-87	0,270


5.3 Modific prototip 15-08-98 Ing. D. Novleanu
 6.6 Modific prototip 9-07-98 Ing. D. Novleanu
 Proiectat Ing. Novleanu
 Desenat Bădeș F.
 Verificat Ing. Bădeș L.
 Contr. STAS Ing. Roman
 Aprobă Ing. Tilichiu H.

Masa netă: 1,0Kg

ISPCF
EIEU
COL. ELECTRIFICARE-LC
Scara:
1:1
data: VI.1996

ELC 13-14.7.0B

CAPAC CU FURCĂ

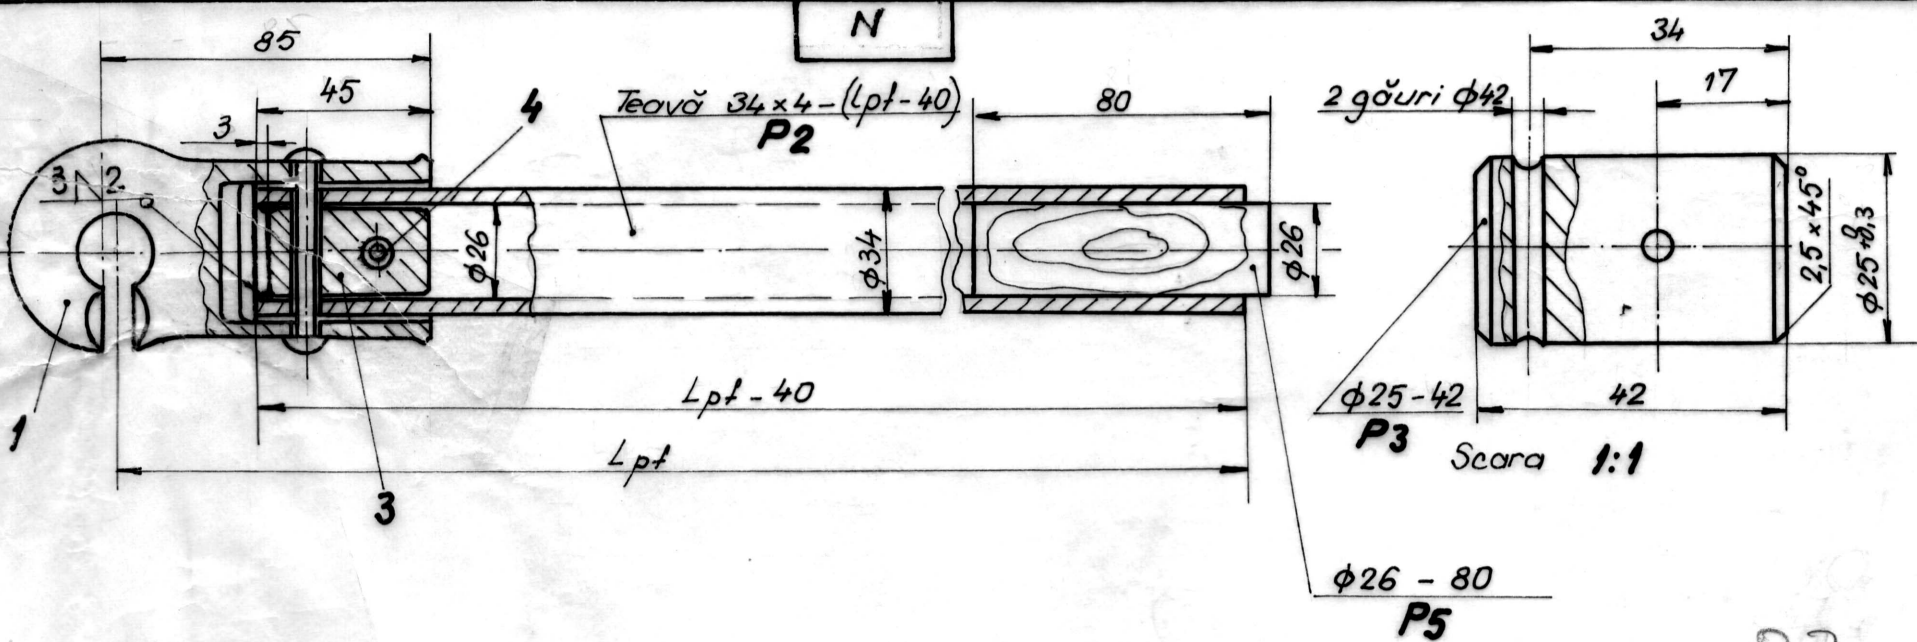

NOTA

1. Poz 1 si 2+3 se vor zincea AT/O₂/Zn 600 - STAS 7221 - 90
2. Lungimea L_{pt} se va lua din lista de montaj

DGI
Mintan

Se f proiect
[Signature]

22

Poz	Denumire	Nr. desen sau STAS	Buc	Material	Observatii	Masa neta kg/buc
5	Dop	-	1	lemn tag	gudronat	0,020
4	Nit 4x55	STAS 797-80	2	20Cr 130		0,010
3	Stuț	-	1	OL 37.2		0,160
2	Bară	-	1	OLT 45	Teavă 34x4 STAS 404/1-89	
1	Mută terminală 1' cu cearlig	ELC 32-2.2	1	Fmn 350		0,680

Proiectat Ing. Novleanu [Signature]
 Desenat Neagu M. [Signature]
 Verificat Ing. Bădăi L [Signature]
 Conf. STAS Ing. Roman O [Signature]
 Aprobat Ing. Tilichi H. [Signature]

I.S.P.C.F
EIEU

Col. Electrificare - LC


Masa netă
scara
1:2
(1:1)

Data: 06.1996

ELC 13-15.0B

PORTFIXATOR DREPT

Marc	Lpf
101	2000
102	2050
103	2100
137	3800

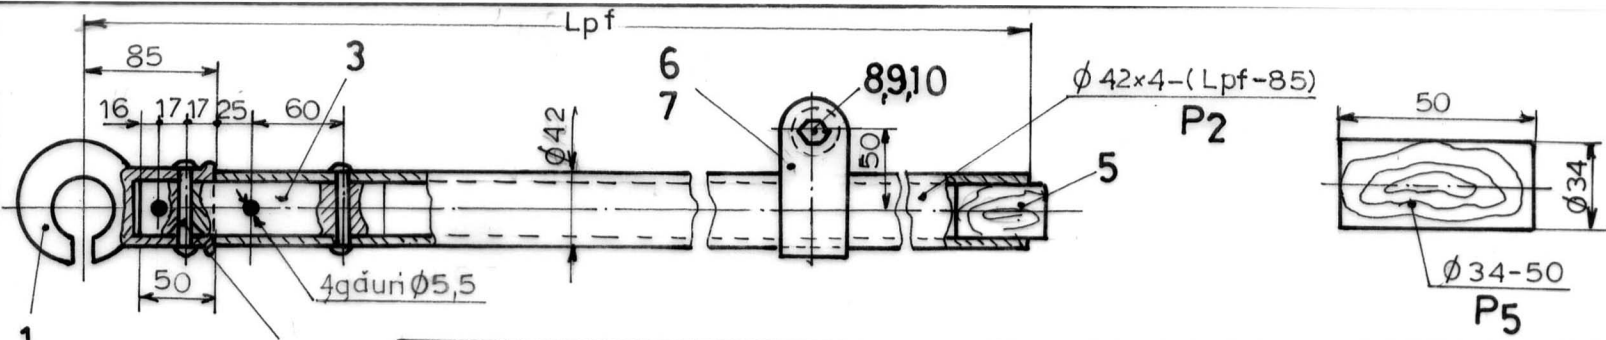

Approbation,
Ch. Voisin


[Signature]

	Data / Date	Nume / Name	Semnatura / Signature
Avizat Approved Consultant	8.11.2001	OVIDIU N. ROMAN	<i>[Signature]</i>
Aprobat Approved CFR	8.11.2001	TRUICA IONEL	<i>[Signature]</i>

138	3850
139	3900
140	3950
141	4000
142	4050
143	4100
144	4150
145	4200
146	4250
147	4300
148	4350
149	4400
150	4450
151	4500
152	4550
153	4600
154	4650
155	4700
156	4750
157	4800
158	4850
159	4900
160	4950
161	5000

Poz.	Denumirea	Nr. desen sau STAS	Buc	Material	Observatii	Masa neta kg/buc
10	Piuliță M10 - gr8	STAS 922-89	1	X20Cr130		
9	Șaibă N10	SR 7666/2-76	1	OLC55	Nichelat	
8	Șurub M10x35-gr.8.8	SRISO 4017-95	1	X20Cr130		
7	Pastilă	ELC13-15.7 BM	1	OL 37.2		
6	Bridă	ELC 13-15.6 BM	1	OL 37.2		
5	Dop	-	1	Lemn fag		
4	Nit phi 5 x60	STAS 797-80	4	X15 Cr08		
3	Ștuț	ELC 13-15.3 BM	1	OL 37.2		
2	Bară	-	1	OLT 45	phi 42-4	
1	Mufă terminală cu cârlig	ELC 32-2,2	1	B 35-10		



Proiectat	Ing. Novleanu D.					
Desenat	Badea F.					
Verificat	ing. Roman O.					
Contr. STAS	ing. Reghină R.					
Aprobat	ing. Tilichi H.					
ISPCF		Masa netă:		ELC 13-15.0 BM		
EIEU LC		Scara:				
SPE DROUARD		Data: XI.2001		PORTFIXATOR phi 42x4		

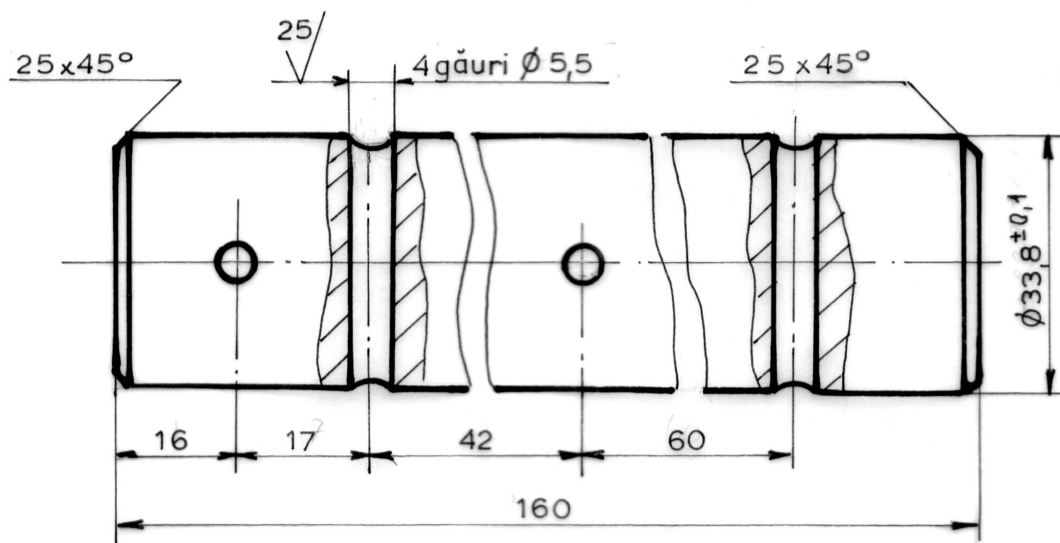

Approbation,
Ch. Voisin

Ch. Voisin

Proiectat ing. Novleanu		OL 37.2	ELC 13 - 15.3 BM
Desenat Badea F.			
Verificat ing. Roman O.			
Contr. STAS ing. Reghin R.			
Aprobat ing. Tilici H.		Masa netă:	Ș T U Ţ
ISPCF		Scara:	
EIEU LC		1:1	
SPIE DROUARD		Data: XI. 2001	

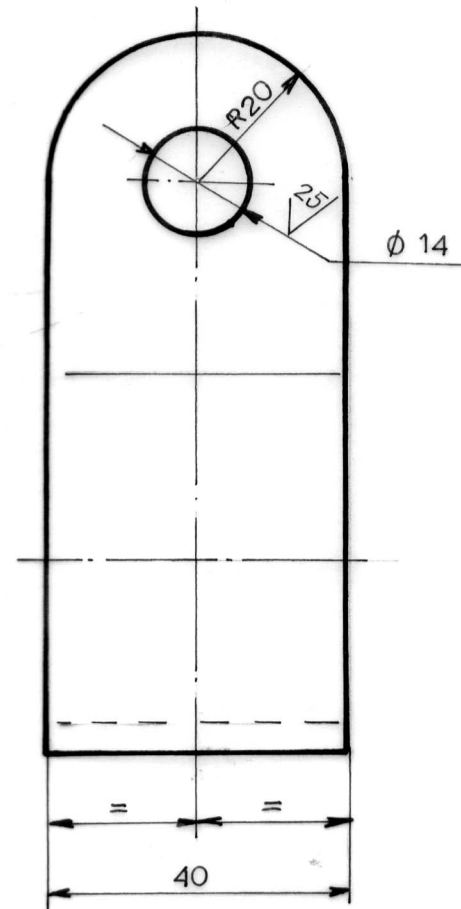
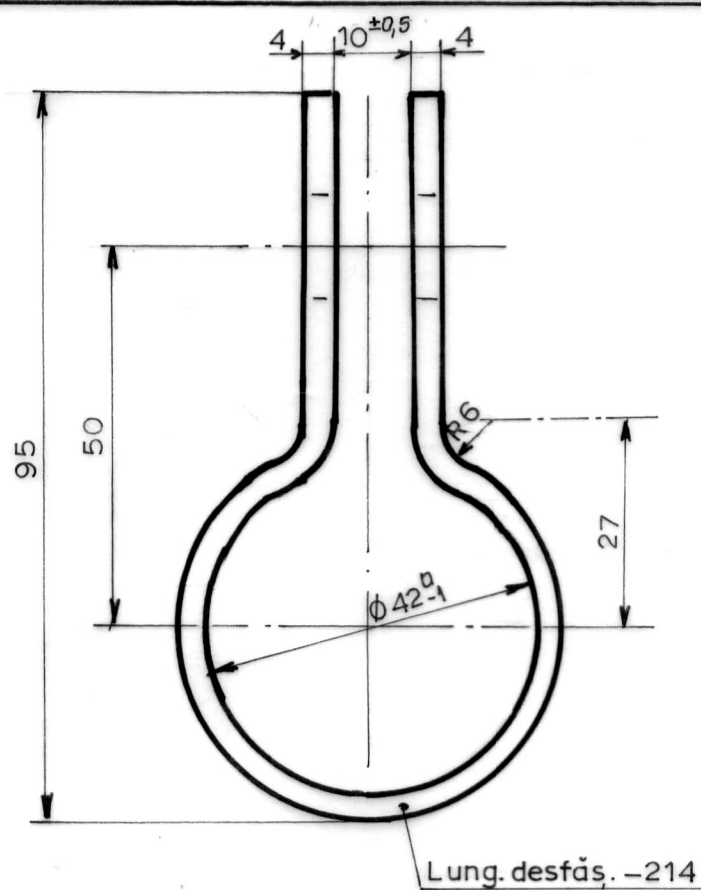


NOTA

Se va zinca AT/OL/Zn 500-
STAS 7221-90

Approbation,
Ch. Voisin

Proiectat		ing. Novleanu	OL 37.2	ELC 13-15.6BM
Desenat		Badea F.		
Verificat		ing. Roman O.	Masa neta	BRIDA
Contr. STAS		ing. Reghina R.		
Aprobat		ing. Tilichi H.	Scara: 1:1	BRIDA
EIEU		ISPCF LC		
SPIE DROUARD				

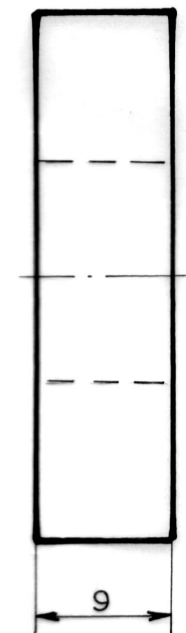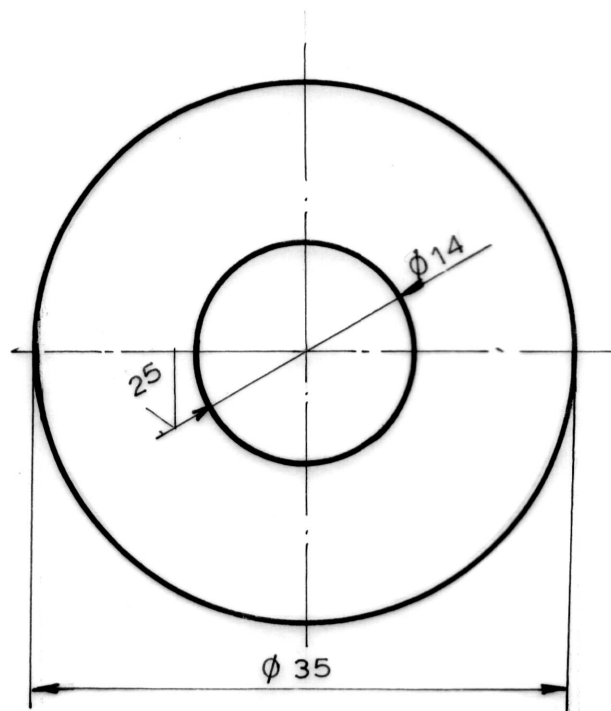


NOTA

1. Muchiile se vor teși $1 \times 45^\circ$
2. Se va zincea AT/OL/Zn 600 - STAS7221 -90

50 ✓✓

Approbation,
Ch. Voisin

Proiectat ing. Novleanu D.		OL 37-2	ELC 13-15.7 BM
Desenat Badea F.			
Verificat ing. Roman O.		Masa neta:	PASTILA
Contr. STAS ing. Reghinda R.			
Aprobat ing. Tilichi H.		Scara:	
EIEU ISPCF LC		2:1	
SPIE DROUARD		Data: XI.2001	

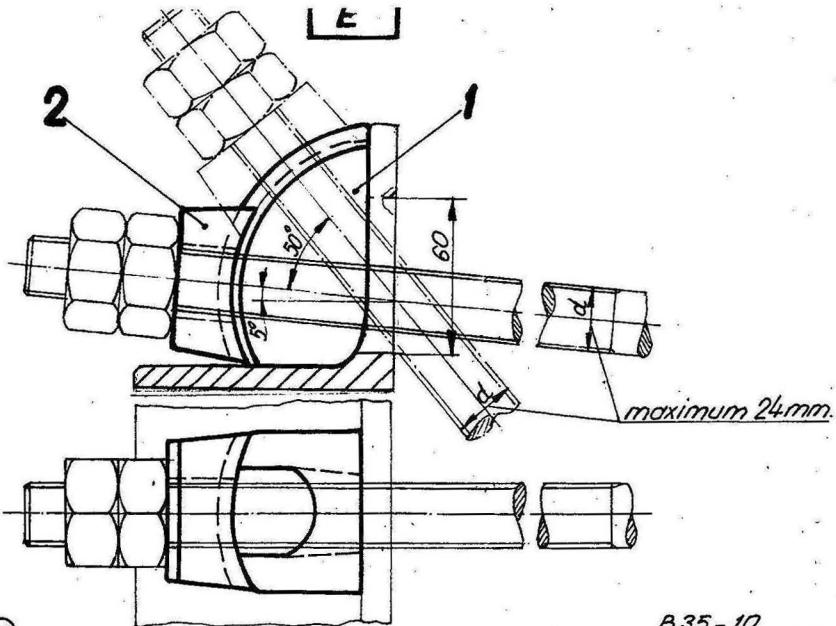

NOTA:

- 1-Sarcina admisibilă - 3000 daN
- 2-Sarcina maximă - 6000 daN
- 3-Elementele se vor zincea
-AE/OL/Zn40-SL/FOS

~~STAS 7222-74 AT/OL/Zn 500~~
STAS 7221-92

C.T.E.,
ing. Ciortan P.
[Signature]

Se f proiect,
ing. Spackl.
[Signature]

De acord,
Constructor
[Signature]




Poz.	Denumirea	Nr. desen sau STAS	Buc	Material	Observatii	Masa netă kg/buc
2	Saibă sferică	E-LC-16-12.3.2	1	Fmn 35-10		0,430
1	suport	E-LC-16-12.3.1	1	Fmn 35-10	B35-10	1,020
B35-10						
b 3	Actualizat STAS	26.10.96	ing. Novleanu			
a 1	continuut 24 iv 84	25 iv 84	ing. Novleanu			
Proiectat		ing. Novleanu				
Desenat		Balinleanu A				
Verificat		ing. Spackl. I.				
Confr. STAS		ing. Badăi L.				
Aprobat		ing. Schmidt H.				
						Masa netă: 1,450 Kg.

I.P.C.F.
E.I.E.U.-Electricare LC2

1:2
Data:

SAIBA DE COLT

E-LC-16-12.3.0

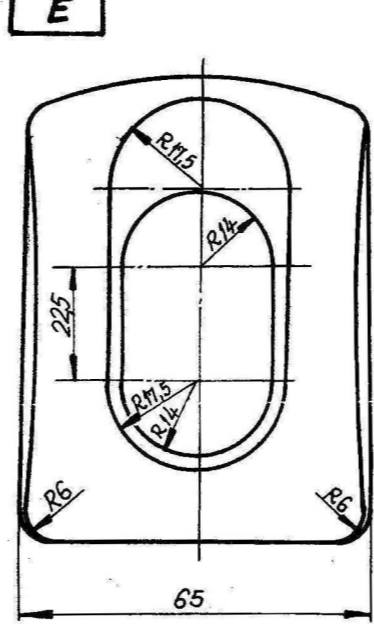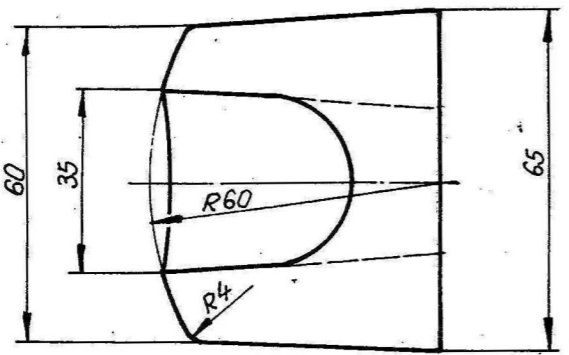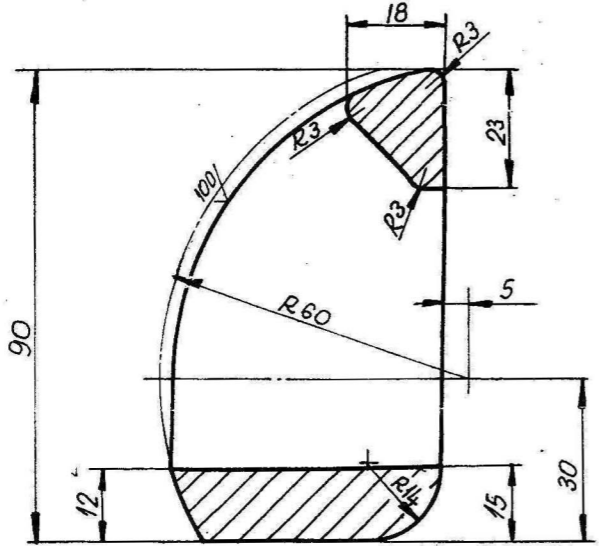

NOTA



- 1- Nu se admit sufluri mai adinci de 1mm. si cu diametrul peste 5mm distantate la 15mm.
- 2- Suprafata trebuie sa fie fara fisuri si curatata de bavuri si cruste.
- 3- Deplasarea modelelor in planul de separare va fi max. 0,6mm.
- 4- Dupa turnare, va urma o recoacere de feritizare incalzire la 950°C si mentinere 5 ore si racire lenta de la 760°C la 700°C min. 20 ore.
- 5- Dupa tratament se va zincati (cu Zn 40 si fos STAS 7222-74 AT/OL/Zn 500/STAS 7221-82) $\text{AT/OL/Zn 500/STAS 7221-82}$ AT
- 6- Se va zincati AT/OL/Zn 500
- 7- Inainte de zincare se va trata termic astfel incat, dupa zincare, caracteristicile mecanice ale materialului sa nu fie diminuate.

b	2	completari	26.10.96	ing. Novleanu	SU
a	1	cont. finalizat	24 IV 84	25 IV 84	ing. Novleanu
		Proiectat	ing. Novleanu		
		Desenat	Balinteanu		
		Verificat	ing. Spack, I.		
		Contr. STAS	ing. Boda, L.		
		Aprobat	ing. Schmidt		
					Masa neta: 1,020 kg.

I.P.C.F. **1:1** **SUPORT**

E.I.E.U.-Electricitate LC2 Data:

E-LC-16-12.3.1

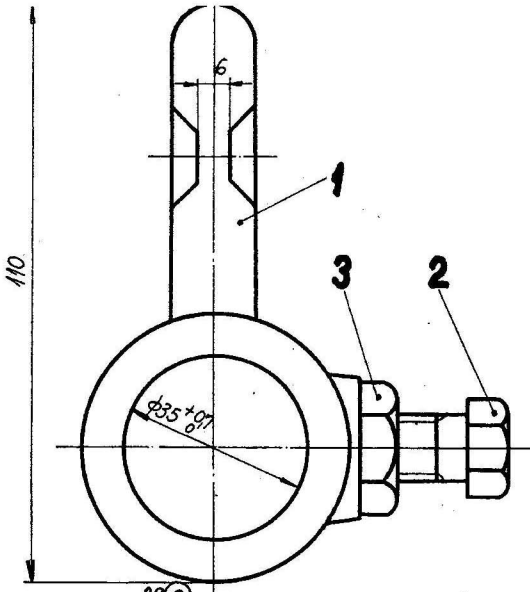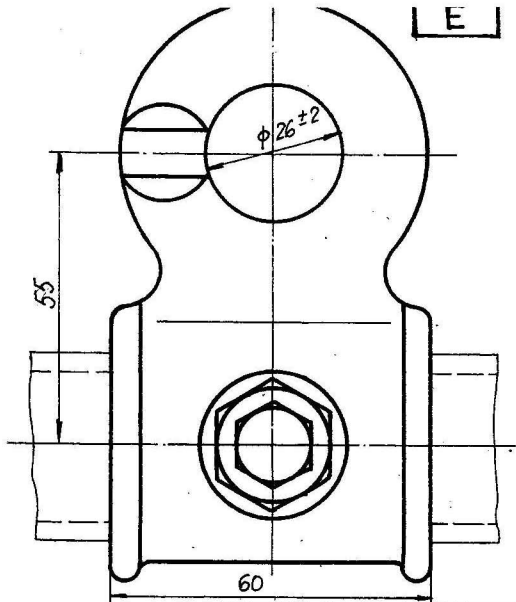

CTE
 Ing. Ciortan P.
[Signature]
 Șef Proiect
 Ing. Spack I.
 De acord
 Constructor
[Signature]

NOTA

- Elementele se vor zincea ~~AT/OL/zn 40~~ ^(c)
~~SL/FOS - STAS 7222-74~~ ~~AT/OL/zn 500~~
~~iar filelele, AT/OL/zn 310 - STAS 7221-82~~ ^(b)
- Prezentul plan are la bază desenul ^(c)
 nr. LC/c 10
 LC/c 10-01

Poz.	Denumirea	Nr. desen sau STAS	Buc.	Material	Observatii	Masa netă Kg/buc.
3	Piuliță M12 - gr. 4-6 ⁸	STAS 922-65	1	20Cr 13D		0,017
2	Surub M12x35-gr. 4-6 ⁸	E-LC-13-3.3.8	1	20Cr 13D		0,030
1	Mufă cu cercel	E-LC-26-4.7.1	1	Fm 35-10 B 35-10 ^(c)		0,610

c 4	Actualizat STAS	17-11-96	ing. Novkovanu			
b 1	conf. minuta	24.12.84	25.12.84	ing. Novkovanu		
a 1	Modificari	STAS	30/11-82	ing. Novkovanu		
Proiectat Ing. Novkovanu D.						
Desenat Țăbălineanu A.						
Verificat Ing. Spack I.						
Contr. STAS/Ing. Bădăi L.						
Aprobat Ing. Schmidt M.						
				Masa netă: 0,700 Kg		

E-LC-26-4.7.0

I. P. C. F.

1:1

MUFĂ 1" CU CERCEL

E. I. E. U - Electrificare - LC 2

Data:

E

CTE

Inq. Ciortan P.
seminat
Sef Proiect
Inq. Spack I.



De acord
Constructor
de

NOTA:

- 1- Nu se admit sufluri mai adinci de 1mm si cu diame-trul peste 5mm distantate la 15mm.
- 2- Suprafata trebuie să fie fără fisuri și curățată de bavuri și cruste
- 3- Deplosarea modelelor în planul de separare va fi max. 0,6 mm.
- 4- După turnare, va urma o recoacere de feritizare -incalzire la 950°C și menți-nere 5 ore și răcire lentă de la 760°C la 700°C min. 20 ore
- 5- După tratament se va zincea ~~AE folia Zn 40-51 Fos~~
STAS 7222-74 AT/OL/500

STAS 7221-82 (b)

6. Se va zincea AT/OL/zn 500-STAS 7221-80
7. Inainte de zincare se va trata termic astfel încât după zincare, caracte-risticile materialului să nu fie diminuate.

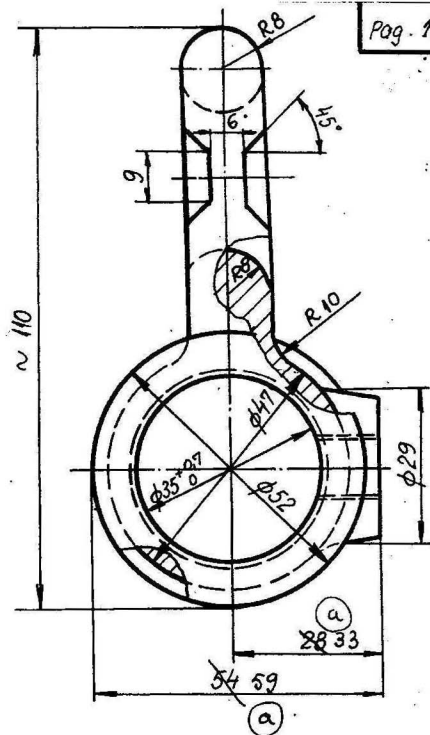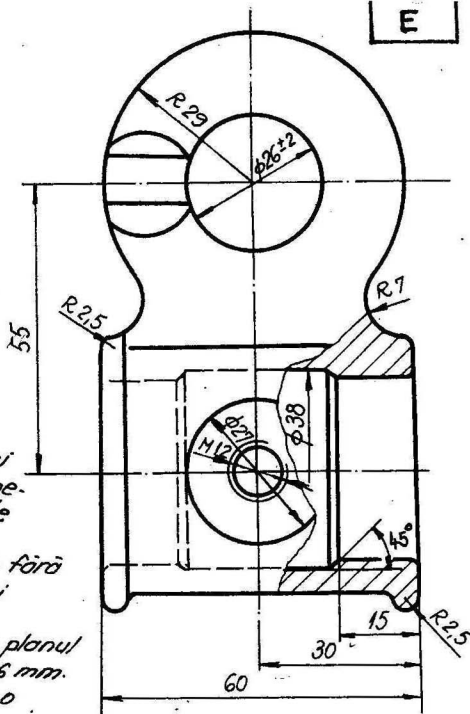

C 3	Completari	17-04-83	Inq. Novleanu
b 1	conf. minuta 24. 17. B4	25.12.84	Inq. Novleanu
a 2	Mediatic calitativa	1-01-81	Inq. Novleanu
Proiectat Inq. Novleanu D.			
Desenat Balinteanu A. CIB/C			
Verificat Inq. Spack I.			
Contn STAS Inq. Badai L.			
Aprobat Inq. Schmidt M.			

Fm 35-10
B 35-10

E-LC-26-4.7.1

Masa netă:


I. P. C. F.

1:1

MUFĂ

E.I.E.U - Electrificare - LC 2

Data:

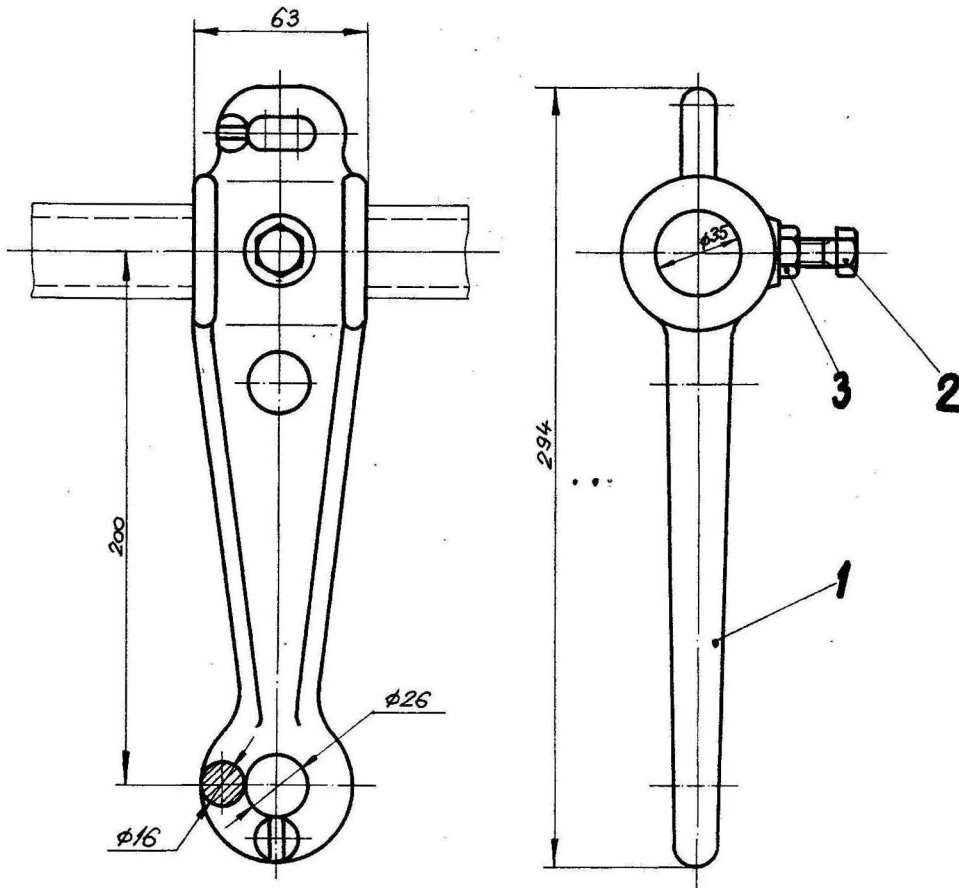

NOTA:

1-Elementele se vor zincui

~~AE/OL/Zn 40~~ ~~SL/Fos STAS 7222-74~~ AT/OL/Zn 500/STAS 7221-82 b

2-Prezentul plan are la baza

des. LC/c 11

LC/c 11-01

C.T.E.,
ing. Ciortan
[Signature]


Set proiect,
ing. Spackl
[Signature]

De acord,
Constructor
[Signature]

3	Piuliță M12 gr. 4.6	STAS 922-63	1	20 Cr 130	⊙	0,017
2	surub M12x30 gr. 4.6	STAS 920-63	1	20 Cr 130	⊙	0,030
1	Mufa	E-LC-27.4.8.1	1	Fr. 35-10 B. 35-10	⊙	1,600
Poz.	Denumire	Nr. desen sau STAS	Buc.	Material	Observatii	Masa neta kg/buc.

c	2	Actualizat STAS	17-04-81	ing. D. H. [Signature]		
b	1	conf. minuta 24.11.84	26.11.84	ing. Novleanu		
a	1	Modificari STAS	30.11.82	ing. Novleanu		
Proiectat		ing. Novleanu D.				
Desenat		Balinteanu A.				
Verificat		ing. Spackl I.				
Contr. STAS		ing. Bădoi L.				
Aprobat		ing. Schmidt M.				
				E-LC-27-4.8.0		
				Masa neta: 1,65 Kg.		




I.P.C.F.	1:2	MUFA 1" CU PINTEN SI OCHI
E.I.E.U.-Electrificare LC2	Data:	

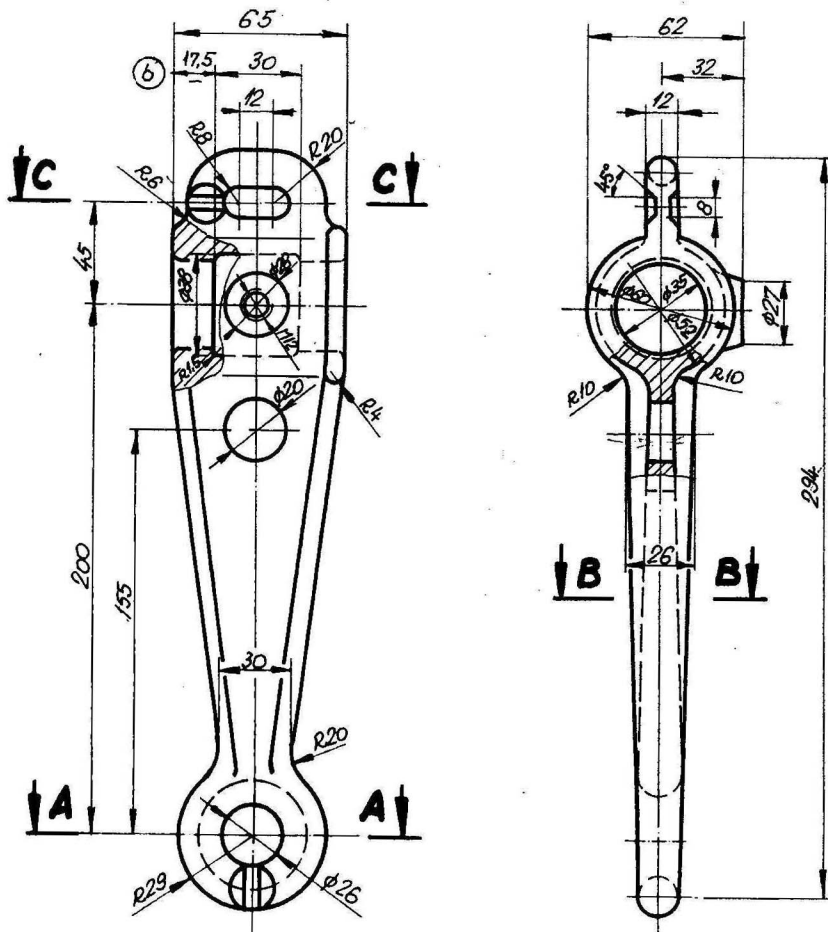

SECȚIUNEA A-A

SECȚIUNEA B-B

SECȚIUNEA C-C

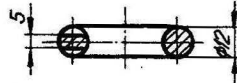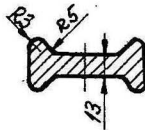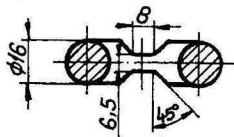**NOTA:**


- 1- Nu se admit sufluri mai adânci de 1mm și cu diametrul peste 5mm, distanțate la 15mm.
- 2- Suprafața trebuie să fie fără fisuri și curățată de bavuri și cruste.
- 3- Deplasarea modelelor în planul de separare va fi max. 0,6 mm.
- 4- După turnare, va urma o recoacere de fertizare - încălzire la 950°C și menținere 5 ore și răcire lentă de la 760°C la 700°C min. 20 ore.
- 5- După tratament se va zincă ~~AE fol Zn 40 - SL Fos STAS 7222-74~~ AT/04/Zn 500 STAS 7221-82 (a) (b)
- 6- Sălicitarea admisibilă 600 daN - Incercările pieselor se vor efectua conform STAS 1566-80
7. Înainte de zincare se va trata termic astfel încât după zincare caracteristicile mecanice ale materialului să nu fie diminuate.

C. T. E.,
ing. Ciortan P.Sef. proiect,
ing. Spack I.De acord,
Constructor

b	Actualizat	STAS 17-11-98	ing. Novleanu	17				
a	cont. minuta	24.11.84	26.11.84	ing. Novleanu	17			
Proiectat	ing. Novleanu D.							
Desenat	Bolinleanu A.							
Verificat	ing. Spack I.							
Contr. STAS	ing. Bădări L.							
Aprăbat	ing. Schmidt M.							
						Masa netă:	1,8 Kg	
I.P.C.F.						1:2	MUFA	
E.I.E.U.-Electricitate LC2						Data:		

E-LC-27-48-1

Fmn 35-10

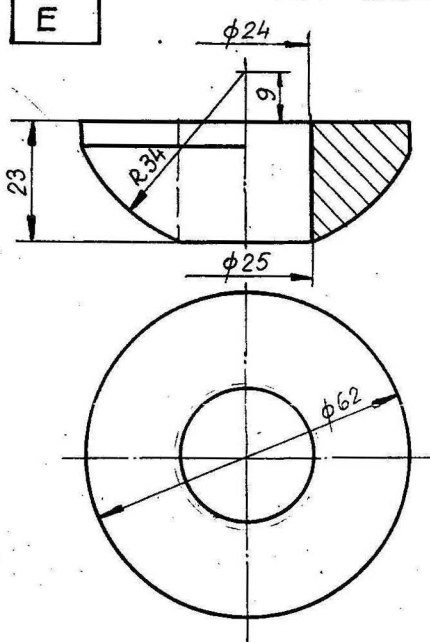

Notă:

- (a) Se va zincea AT/OL/Zn 500-STAS7221-22
- (b) Înainte de zincare, se va trata termic astfel încât, după zincare, caracteristicile mecanice ale materialului să nu fie diminuate.

CTE
Ing. Ciortan P.
[Signature]

Sef Proiect
Ing. Spack I.
[Signature]

De acord
Constructor
[Signature]

6.3	Completări	28.10.96	Ing. Novleanu D.
a.1	cont. minută 24.4.94	26.4.94	Ing. Novleanu D.
	Proiectat Ing. Novleanu D.		
	Desenat Bobinteanu A.		
	Verificat Ing. Spack I.		
	Contr. STAS/Ing. Bădai L.		
	Aprobat Ing. Schmidt M.		



FC-30 (b)
Fc 300/SRISO 185-94
Masa netă: 0,290 Kg.

E-LC-31-5

I.P.C.F
E.I.E.U - Electrificare - LC2

1:1
Data:

SAIBA SFERICA

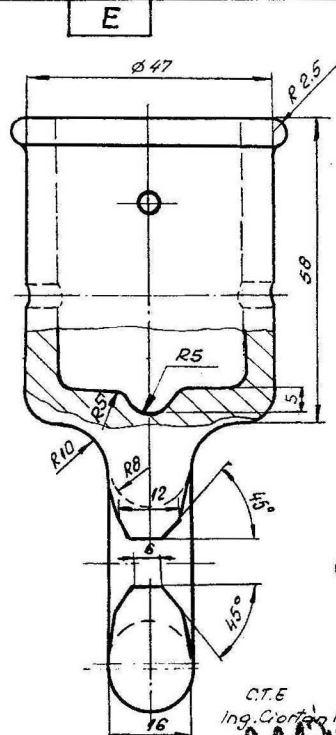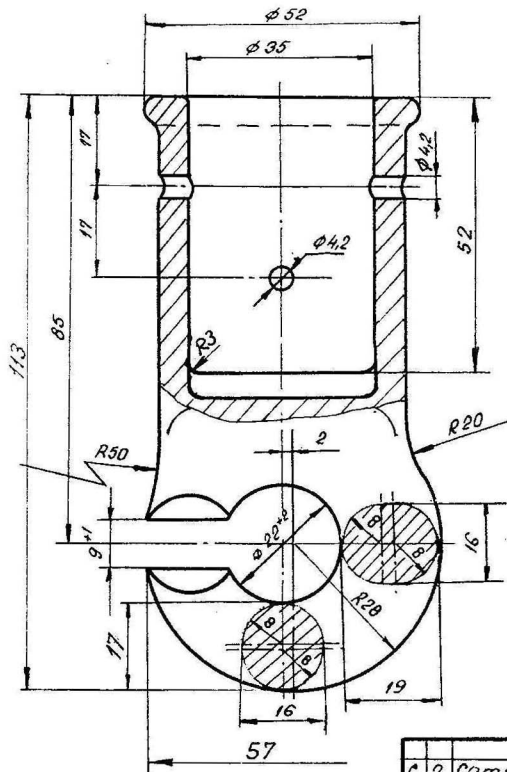

NOTA

1. Nu se admit sufluri mai adinci de 1 mm. si cu diametrul peste 5 mm distanțate la 15 mm.
2. Suprafețele trebuie să fie fără fisuri și curățate de bavuri și cruste.
3. Deplasarea modelelor în planul de separare va fi max. 0,6 mm
4. După turnare, va urma o recăocere de fe ritizare - încălzire la 950 mm și mentinere 5 ore și răcire lentă de la 760°C la 700°C minimum 20 ore
5. După tratament se va zinc ^(C) AE (04) Zn 40 Si / 105 STAS 7222-74. AT / 01 / Zn 500 / STAS 7221-82 ^(B)
6. Prezentul plan are la bază desenul LC/c 8
7. Înainte de zincare se va trata termic astfel încât după zincare caracteristicile materialului să nu fie diminuate.

C.T.E
Ing. Corina
admit

Șef Proiect
Ing. Spackl


De acord,
Constructor

6. Sarcina admisibilă 550 daN
încercările pieselor se vor
efectua conform STAS 1566-80

c 2	Completări	26.10.96	Ing. Novleanu						
b 1	conf. minuta 24 nr 4	26.11.84	Ing. Novleanu						
a 1	modif. STAS	30.11.82	Ing. Novleanu						
Proiectat Ilie Traian									
Desenat Ion Dtescut				Fm 35-10					
Verificat Ing. Spackl				STAS 569-50					
Contr. STAS Ing. Băbii L.				20-79					
Aprobat Ing. Schmidt H.				Masa netă: 0,68 kg					
i.p.c.f.				scara:					
Col. Electrificare				1:1					
				Data: 10.11.76					
				E-1C-32-2.2					
				MUFĂ TERMINALĂ 1" CU CÎRLIS					

NOTA:

1. Se va zincea AT10L/Zn 500/STAS 7221-82 90 (b)
(a)

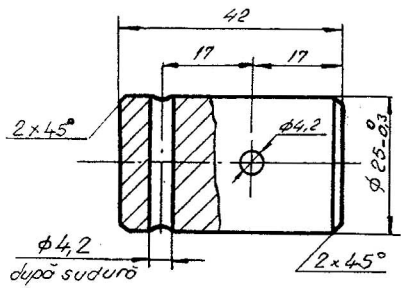

C.T.E.
ing. Gortan P.
[Signature]

Șef Proiect
ing. Spock I.
[Signature]

De acord,
constructor
[Signature]

b 1	Actualizat STAS	26.10.95	ing. Navleanu						
a 1	conf. minuta 24, IV 84	26.11.84	ing. Navleanu						
Proiectat	ing. Hiuți I.								
Desenat	ing. Ionițescu R.								
Verificat	ing. Frincu I.								
Contr. șef	ing. Marinescu D.								
Executat	ing. Schmidt H.								
				DL 37.2k		E-CC-32-2.4			
				Masa netă: 0,160g					


IPCF
Col. Electrificare
scara: 1:1
Data: 10.XII.76

ȘTUT

N

NOTĂ:

1. Muchiile se vor teși $1 \times 45^\circ$
2. Se va zincea AT/OL/Zn 610-STAS7221-90

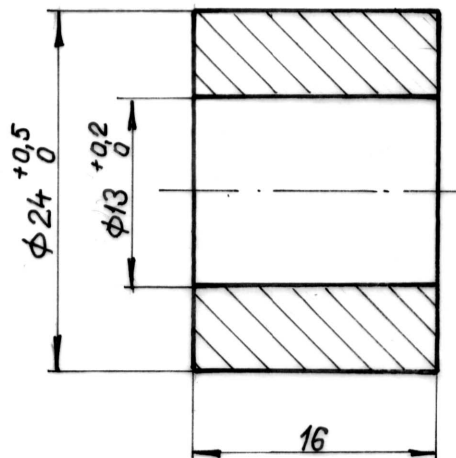

28

25



D. G. I.


Kant

Șef proiect
Ing. Cr. Popescu

Proiectat	Ing. D. Novleanu	OL 37.2	ELC 32-9.11.6 B
Desenat	R. Novleanu		
Verificat	Ing. L. Bădăi		
Contr. STAS	Ing. D. Roman		
Aprobat	Ing. H. Tilichi	Masa netă: 0,034	
I. S. P. C. F. E. I. E. U.		Scara: 1:1	D I S T A N Ţ I E R
COL. ELECTRIFICARE-LC		Data: VII 1997	

NOTĂ:

Se va zinca fermic
AT/OL/Zn 500-STAS 7221-90.


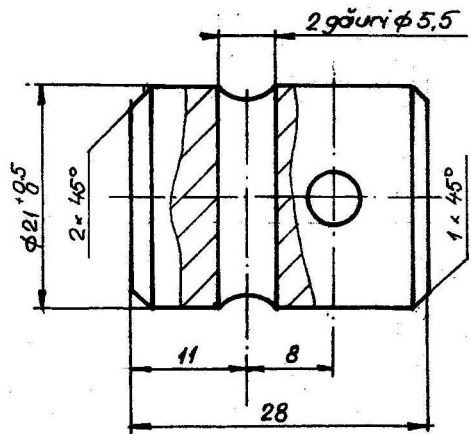


D.G.I.
Bentzu

sef proiect
Ing. Cr. Popescu
[Signature]

Proiectat Ing. D. Novkari		OL 37.2	ELC 32 - 9.2A
Desenat R. Novkari			
Verificat Ing. L. Bădoi		Masa nr. 001514	DOP
Contr. STAS Ing. D. Roman			
Aprobat Ing. H. Tilișchi		Scara:	DOP
I.S.P.C.F. E.I.E.U.		2:1	
COLECTRIFICARE - L.C.		Data: VI 1997	

6) Sarcina admisibilă 500 daN
 Incercările pieselor se vor efectua conform STAS 1566-80

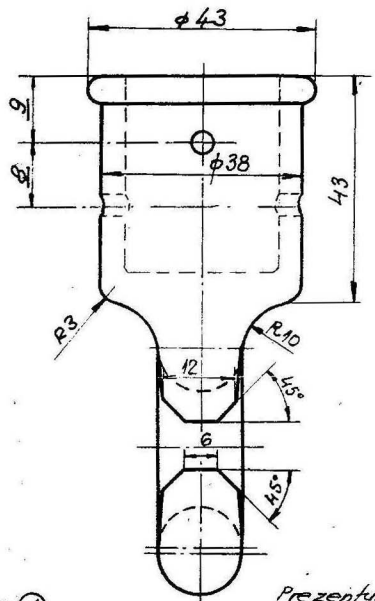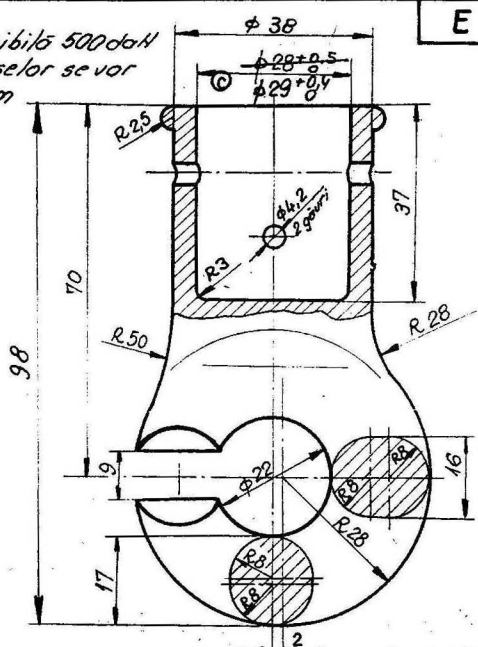

NOTA

1. Nu se admit sufluri mai adânci de 1mm și cu diametrul 5mm distanțate la 15mm.
2. Suprafețele trebuie să fie fără fisuri și curățate de bavuri și cruste.
3. Deplasarea modelelor în planul de reparare va fi de max. 6mm.
4. După turnare va urma o recăldere de ferilizare - încălzire la 960°C și menținere la această temperatură și răcire lentă de la 760°C la 700°C minimum 20 ore.
5. Înainte de zincare se va trata termic pentru detensionare.

Sc va zinca AT10L/Zn500/STAS7221-80

C.T.E
 ing. Costar P

Sef Proiect
 ing Spack I

De acord,
 constructor

d 2	Completari	26.10.96	ing. Novikova
C 2	Inlocuirea teava fixator	27.08.96	ing. Novikova
b 1	conf. minuta 24.04.84	25.04.84	ing. Novikova
a 1	Modificat STAS	30.11.82	ing. Novikova
Proiectat		11e Traian	26
Desenat		Aldea R	R4e
Verificat		ing. Spack I	
Contr. STAS		ing. Bădăil	
Aprobat		ing. Schmidt M	

Fmm 350 ©
 Fmm 95-10 ©
 STAS 569-79

E-LL-32-9.3


Scara:

1:1


Data: 14.11.76

IPCF
 Col. Electricare

Mufa terminală 3/4" cu cârlig

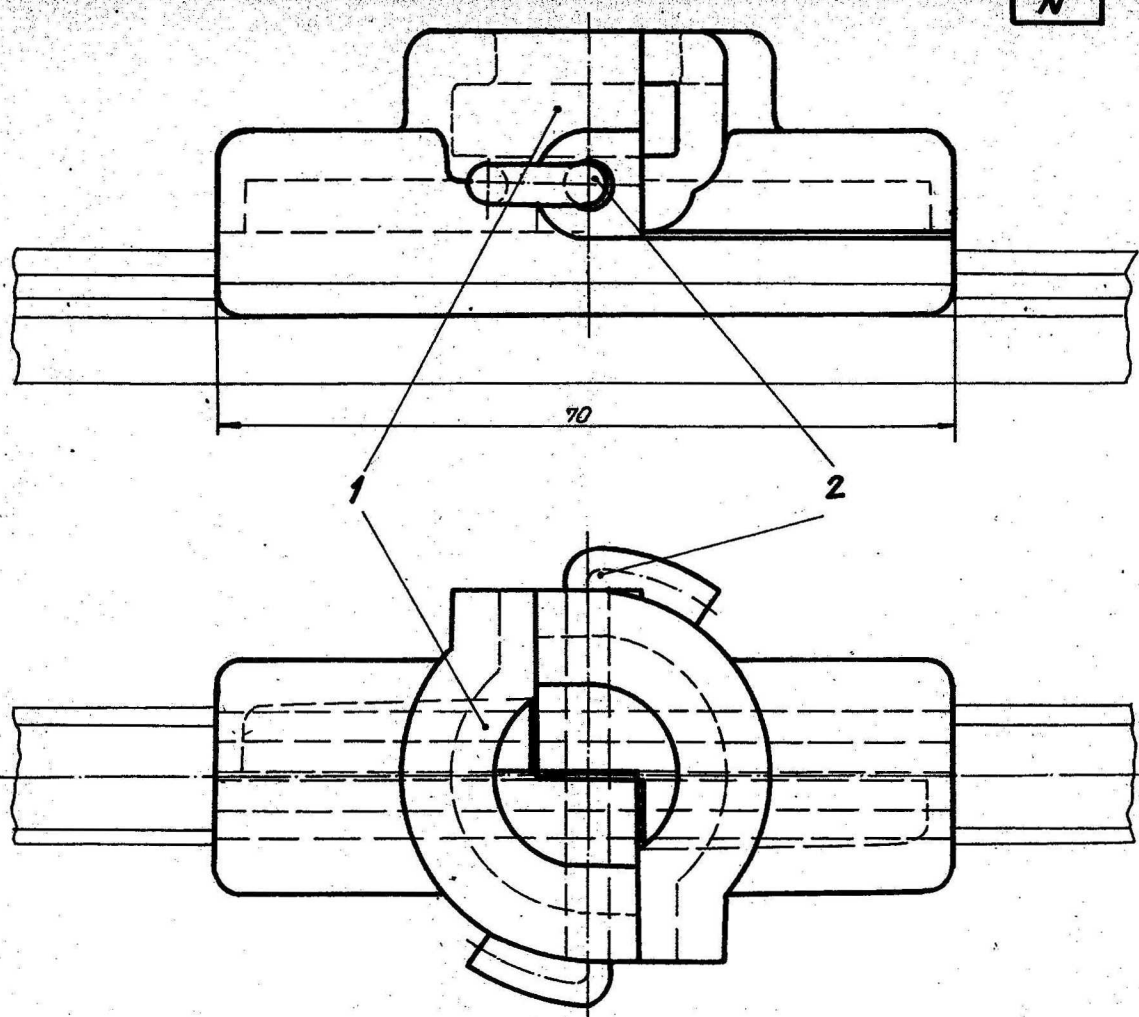

N

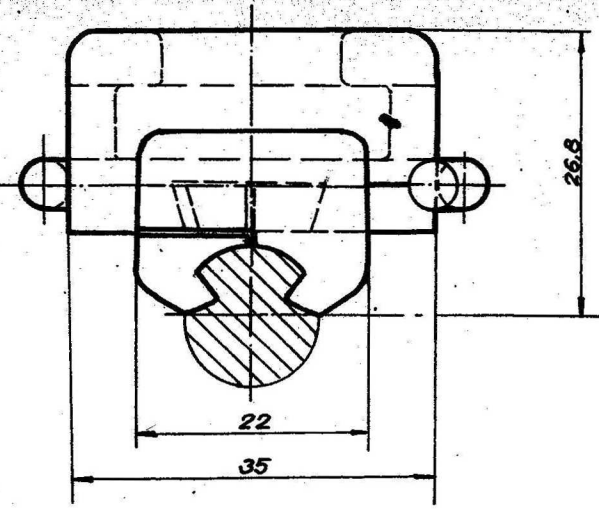

NOTA
Prezentul plan este valabil numai pentru echipamentul liniei de contact din Romania.

DGI
Nutan

Sef proiect
Ing. Cr. Popescu

2	Splint 4x60	-	1	20 Cr 130		0,005
1	Falcă clemă	ELC 32-9.5.5.1 B	2	CuAl 10 Fe 3	Tip turnare	0,100
Pos.	Denumire	Nr. desen sau STAS	Buc	Material	Obs.	Masa kg/buc

Proiectat Ing. Mărkăniș
Desenat Neagu M.
Verificat Ing. Cădăi L.
Contr. SIA Soria Roman P.
Aprobat Ing. Tilichiu I.






Masa netă: 0,205kg

ISPCF
EIEU

scara
2:1


Data: 07.1997

ELC 32 - 9.5.5.0B
**CLEMA DE FIXARE PRIN
SERTIZARE PE FIR TTF 100**

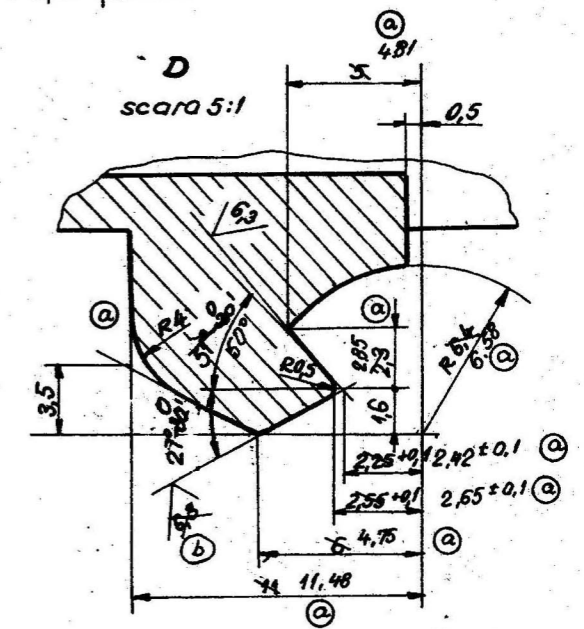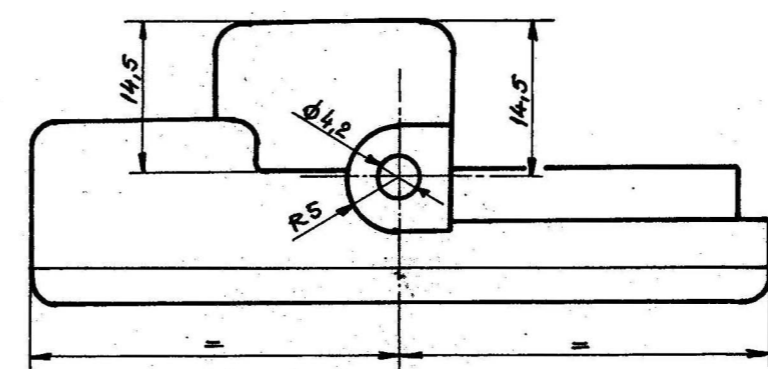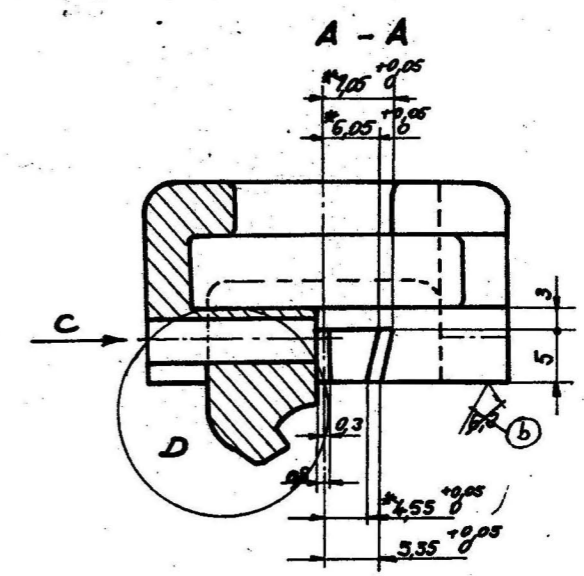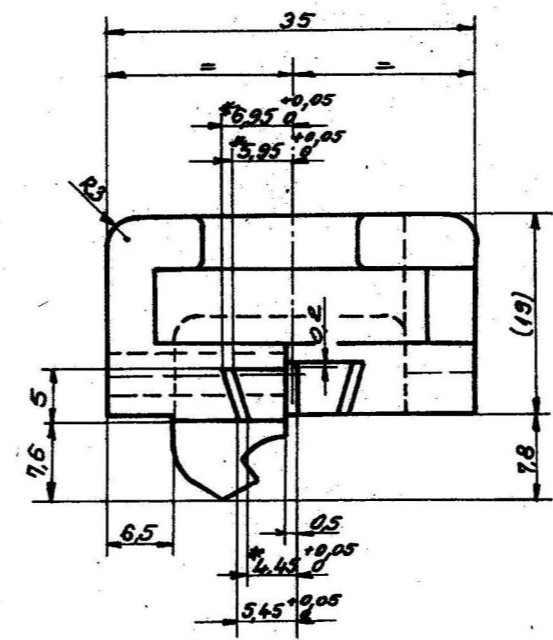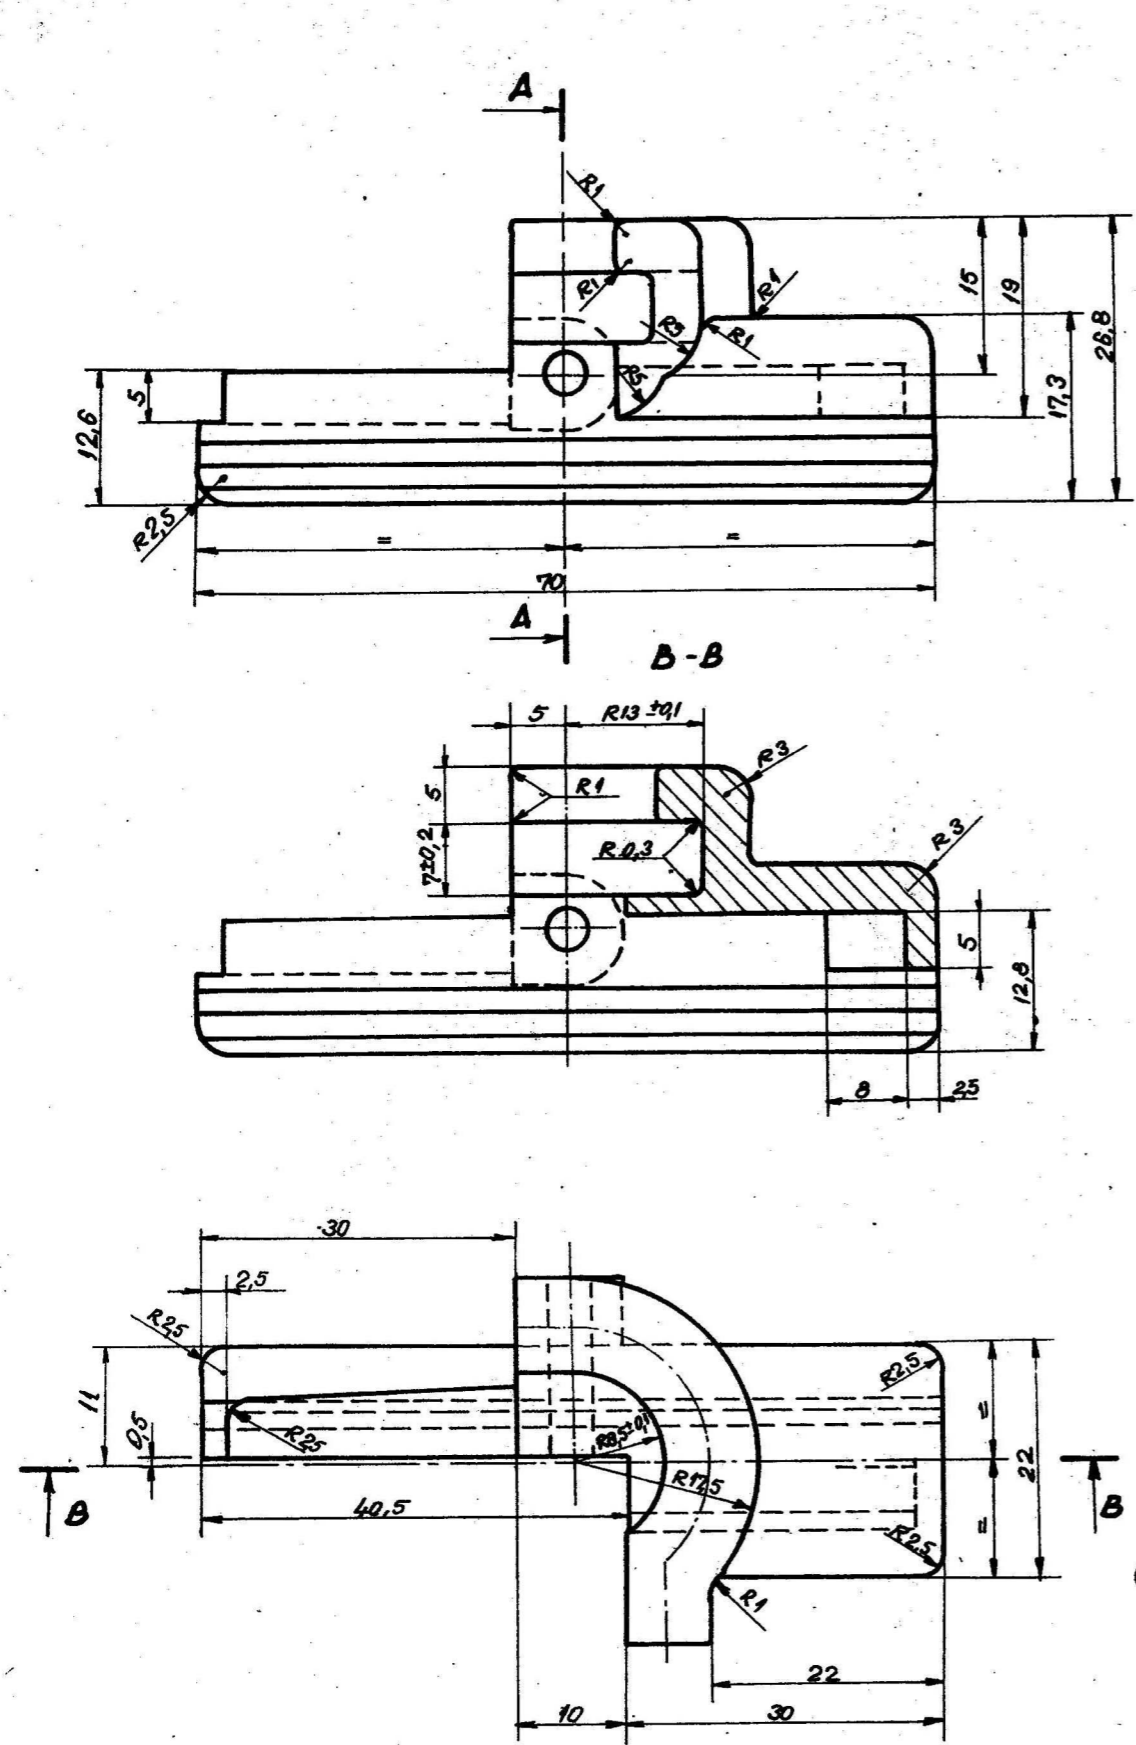

NOTA

1. Tolerantele de execuție ale piesei, cu excepția celor notate cu *, vor fi 0,2
2. Tolerantele notate cu * sunt astfel alese încât să permită montajul manual al celor 2 fălcii ca în figura de mai jos, la cota A=10mm pentru profilul minimal al firului de contact TF 100 (conform STAS 686-71) și A=19mm pentru profilul maximal al aceluiași fir de contact.
3. Verificarea fălcilor se va efectua pentru toate bucățile, după care fălcile se vor livra împerecheate, legate cu sîrmă prin gaura de splint.
4. Fălcile se execută prin turnare sub presiune, aboterile fiind conform CT - SR ISA 8062 - 98

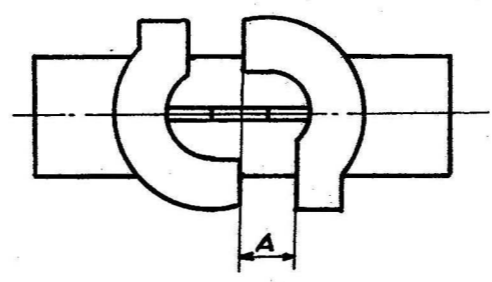


set proiect
ing. Cr. Popescu

D.G.I.
Rutan

0,825

b.4. Adaptat după STAS 11-11-98		Cu Al0 Fe3T	
a.9. Valori: profilul 11-11-98		tip turnare, c	
Proiectat: Năneanu		Scara: 2:1 (2:1)	
Desenat: Bădea F.		Masa netă: 0,100	
Verificat: Bădea F.		Data: VII.1997	
Conf. STAS 11-11-98		CHEMA DE FIXARE PRIN SECȚIONARE	
Aprobat: V. T. D. C. H. A.		COL. ELECTRIFICARE-LO	
I.S.P.C.F. EIEU		ELC 32-9.5.5.1B	
COL. ELECTRIFICARE-LO		FALCA CLEMA	

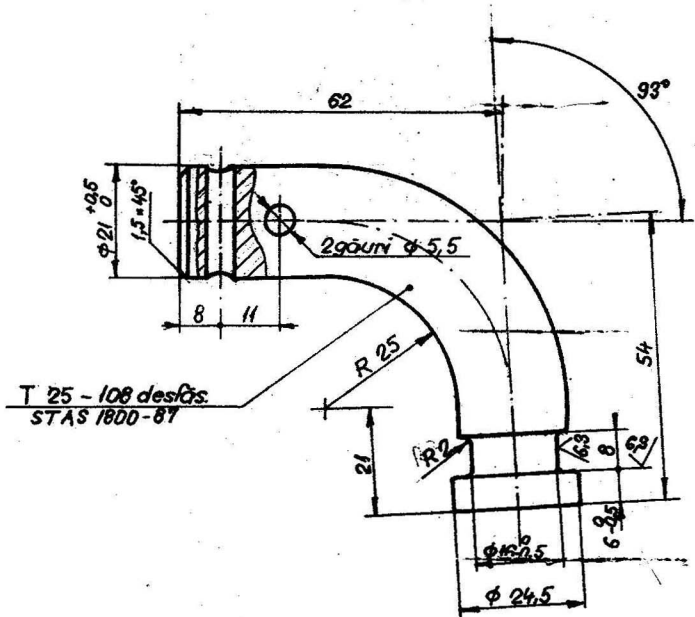

NOTĂ:

1. Muchiile și razele necotate se vor executa R1
2. Se va zincea AT/OL/Zn610 STAS 7221-90
3. Ciocul se va forja la cald.

T 25 - 108 desf. STAS 1800-87

25

12.5 / / / /


D.G.I. Năntan

Șef proiect
Ing. Cr. Popescu

Proiectat/ing. D. Novikaru		DL 44.2	ELC 32 - 9.6A
Desenat/ R. Novikaru			
Verificat/ing. L. Bădăi		Masa netă: 0,3kg	C I O C
Concl. STAS/ing. O. Roman			
Aprobat/ing. H. Tilișchi		Scara: 1:1	
I. S. P. C. F. E. I. E. U.			
CDL ELECTRIFICARE - L.C.		Data 01.1997	

DGI,
Bintan

Sef. proiect
Ing. Cr. Popescu

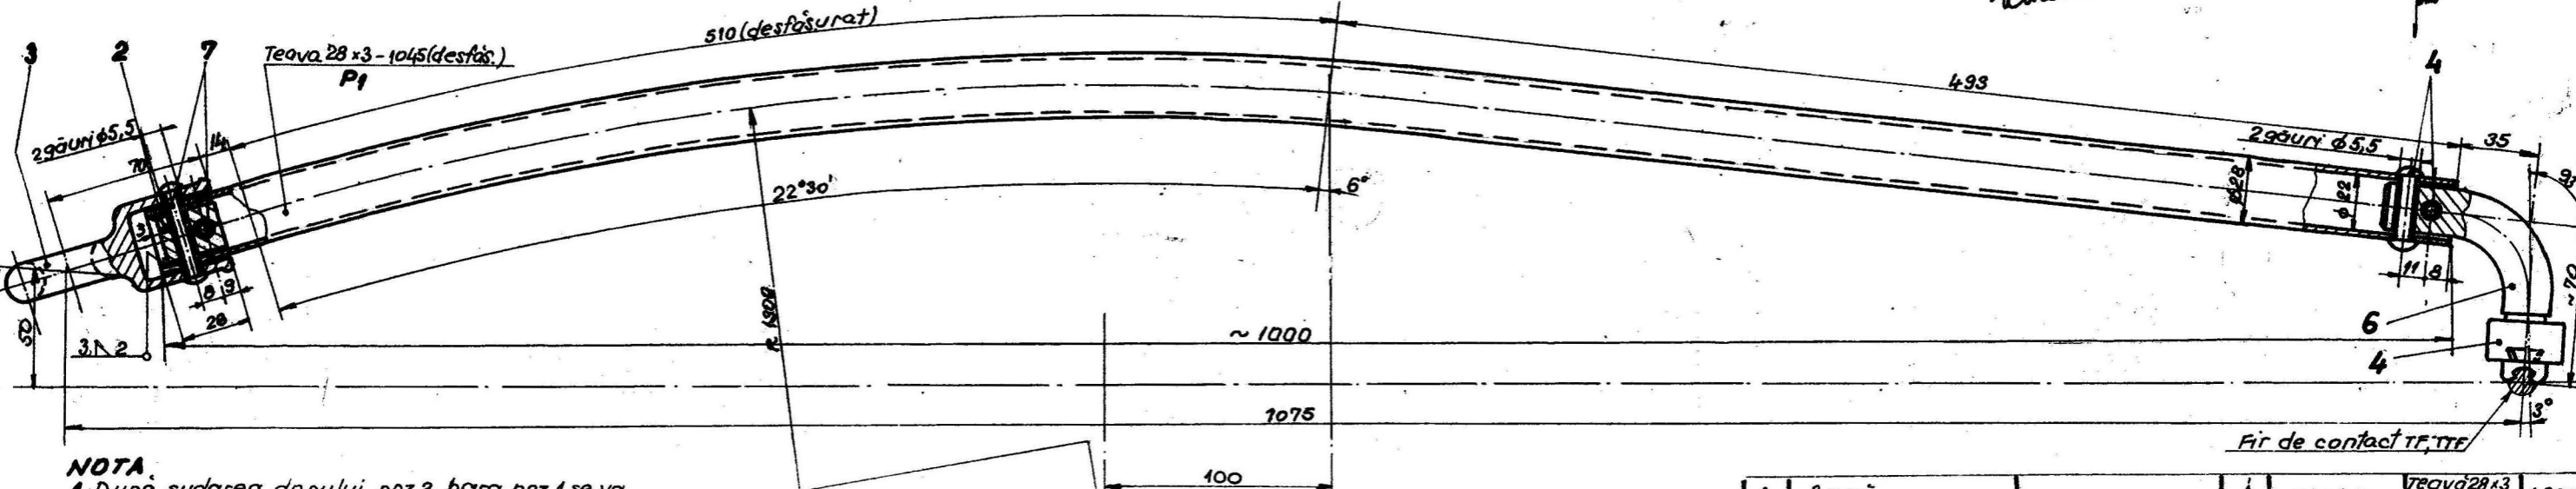

NOTA
 1. După sudarea dopului poz. 2, bara poz. 1 se va zincă AT/OL / Zn 500 - STAS 7221-90
 2. Muchiile barei se vor țese $1 \times 45^\circ$

Poz.	Denumirea	Nr. desen sau STAS	Buc	Material	Observatii	Mg/buc
7	Nit 5x50	STAS 797-80	2	15 Cr 08		0,207
6	CiOC	ELC 32-9.6A	1	OL 44		0,300
5	Clema de fixare serrizată ptr. TTF	ELC 32-9.5.5.08	1			0,205
4	Nit 5x40	STAS 797-80		15 Cr 08		0,008
3	Mufa terminală 3/4" cu carlig	ELC 32-9.3	1	B 35-15	STAS 5322-95	0,460
2	Dop	ELC 32-9.2A	1	OL 37.2	STAS 1000-87	0,075

Poz.	Denumirea	Nr. desen sau STAS	Buc	Material	Observatii	Mg/buc
1	Bară	-	1	OLT 45	Teava 28 x 3 STAS 4041-87	1,930

Proiectat de: *Novleanu*
 Desenat de: *Bodea F.*
 Verificat de: *Bodea L.*
 Contr. STAS de: *Roman O.*
 Aprobat de: *Tilici H.*


I.S.P.C.F.
EIEU

Scara: 1:2

COL. ELECTRIFICARE-10 Data: VI.1997

ELC 32-10.0.A

FIXATOR CURBAT DC'

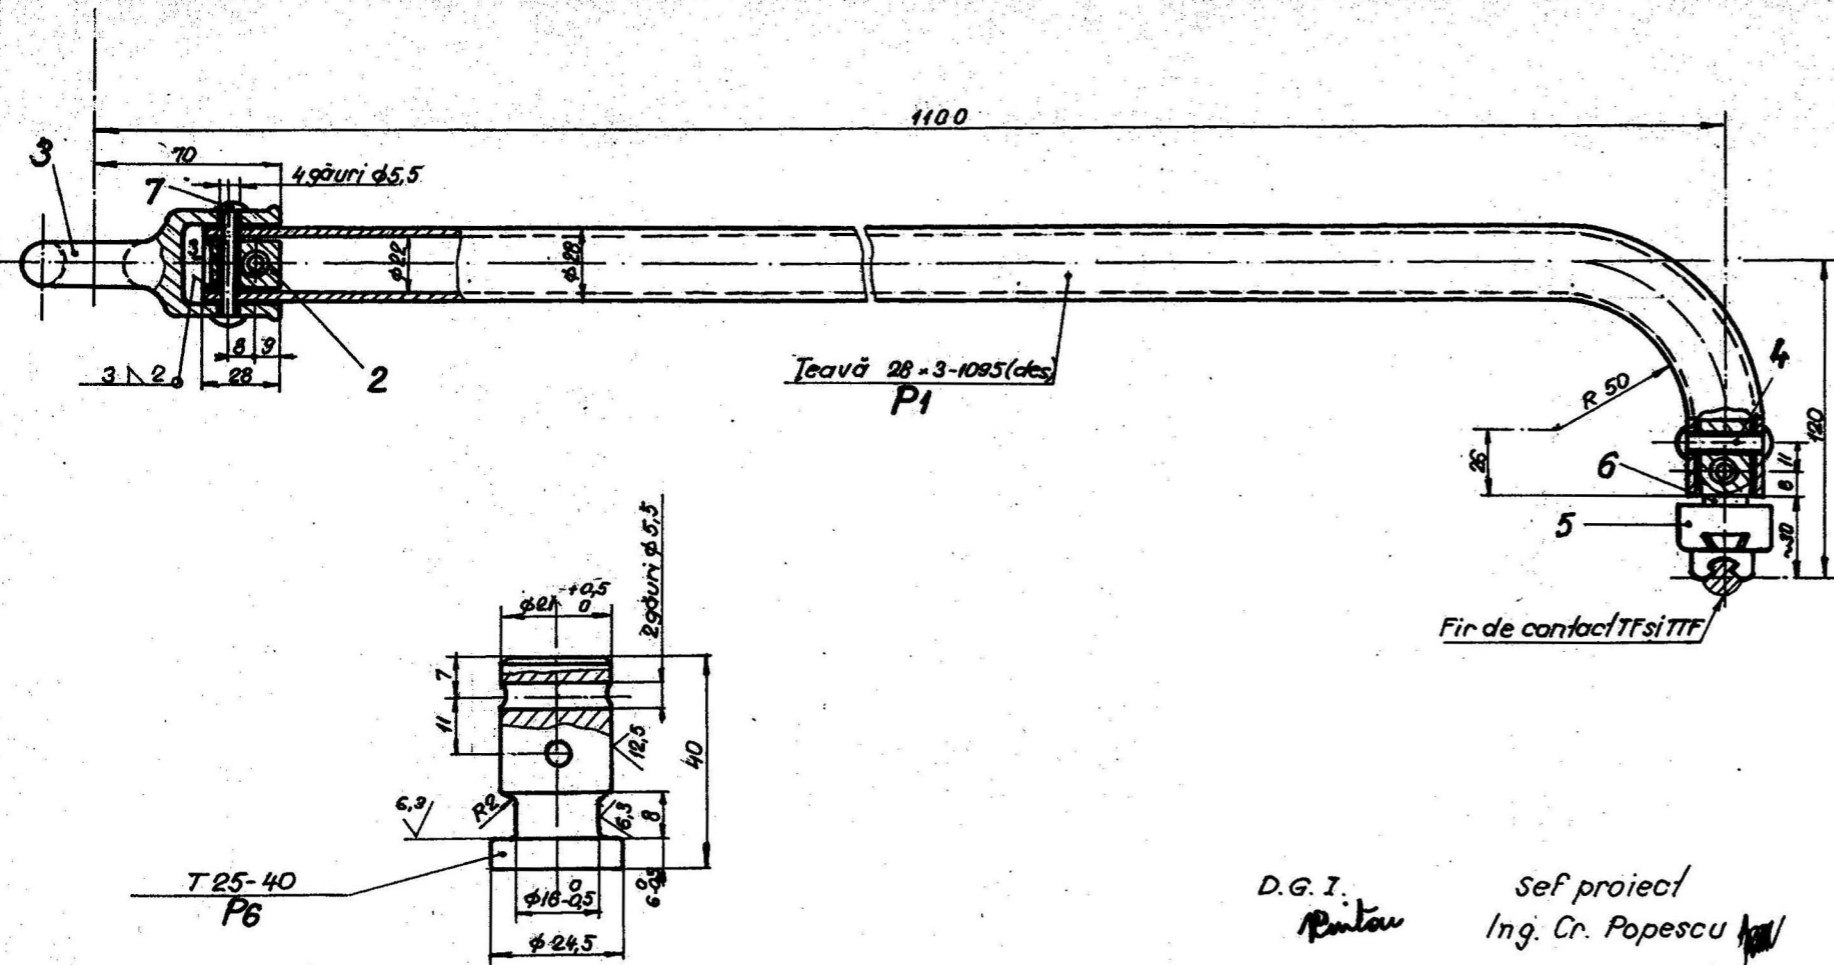

NOTĂ:

1. Mușchiile și razele necotate ale reperelor 1, 2 și 6 se vor executa $1 \times 45^\circ$, respectiv R1.
2. După sudură reperele 1 și 2 se vor zincea AT/OL /zn 500 - STAS 7221 - 90
3. Ciocul poz. 6 se vor zincea AT/OL /zn 610.

Poz.	Denumirea	Hr. desen sau STAS	Buc	Material	Observatii	Masa kg/buc
7	Nit 5x50	STAS 797-80	2	5 Cr 08		0,008
6	Cioc	ELC 32-11.0A poz.6	1	OL 44	T 25 STAS 100-87	0,100
5	Clemă de fixare, sertizată, de fir TTF	LGVR 1-9.5-50	1			0,205
4	Nit 5x40	STAS 797-80	2			0,007
3	Mufă terminată 3/4" cu carlig.	ELC 32-9.3	1	B: 35-10	SRI 50 3322-95	0,460
2	Dop	ELC 32-9.2A	1	OL 37-2		0,075
1	Bară	-	1	OLT 45		2,030

Proiectat: Ing. D. Nărbanu
 Desenat: R. Nărbanu
 Verificat: Ing. L. Bădoi
 Confir. șef: Ing. D. Roman
 Aprobat: Ing. H. Mălich

D.G.I. *Pintau*
 Șef proiect
 Ing. Cr. Popescu


Masa netă: 2914g

ELC, 32 - 11.0A

I.S.P.C.F.
 E.I.E.U.
 COL. ELECTRIFICARE-LC

Scara:
 1:2
 (1:1)
 Data: 0 1997

FIXATOR CURBAT
 PENTRU ACE DCA

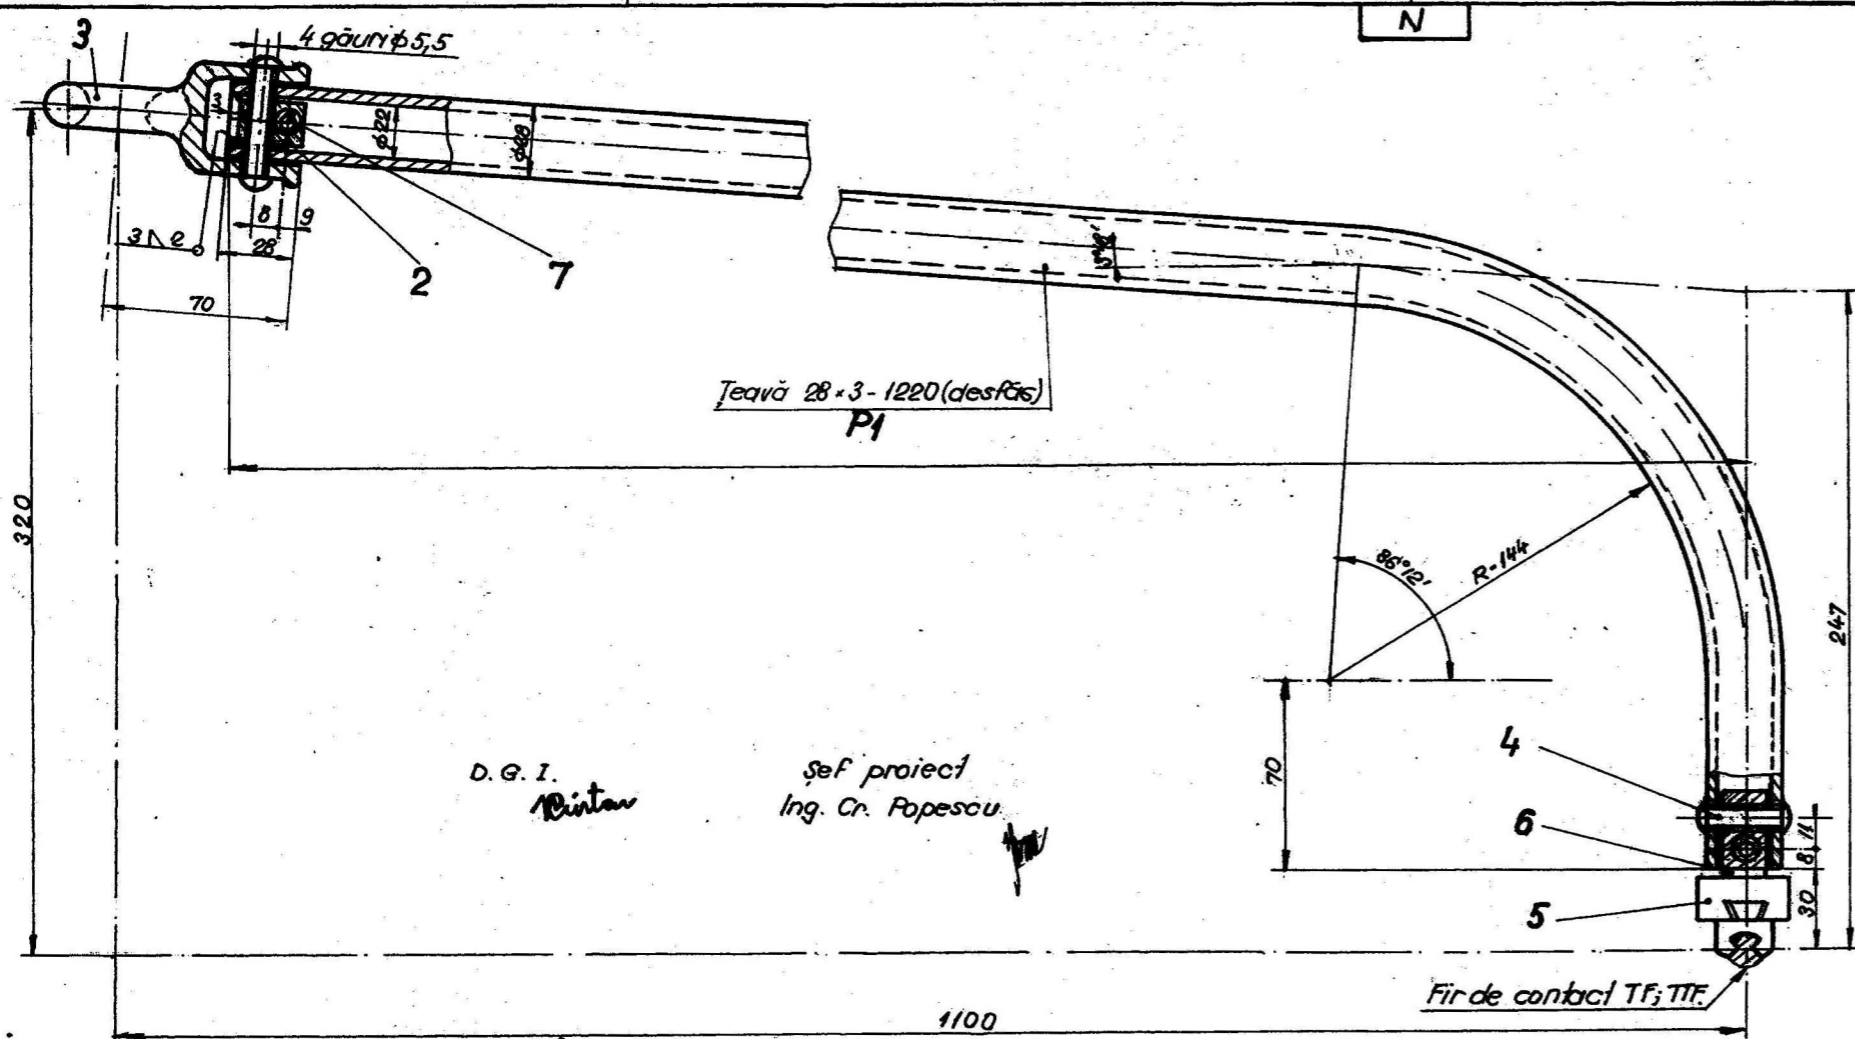

D.G.I. *Rintan*
 Șef proiect
 Ing. Cr. Popescu

NOTĂ:

1. Muchiile și razele necotate ale reperelor 1, 2 și 6 se vor executa $1 \times 45^\circ$, respectiv R1.
2. După sudură reperele 1 și 2 se vor zincea AT/OL/Zn 500-STAS 7221-90
3. Ciocul poz. 6 se vor zincea AT/OL/Zn 610

Poz.	Denumirea	Mr desen sau STAS	Buc	Material	Observatii	Masa kg/buc
7	Niț 5 x 50	STAS 797-80	2	15Cr 08		0,008
6	Cioc	ELC 32-11.0A poz 6	1	OL 44	T25 STAS 1800-87	0,100
5	Placă de fixare sertizată pe ACIF	LCVR 1 - 9.5-5-08	1			0,205
4	Niț 5 x 40	STAS 797-80	2	15Cr 08		0,007
3	Mură terminată 3/4" cu carlig	ELC 32-9-3	1	B: 35-10	SRSO 6322-35	0,460
2	Dop	ELC 32-9.2A	1	OL 37-2		0,075
1	Bară	-	1	OLT 45		2,060

Proiectat Ing. D. Nărbănu
 Desenat R. Nărbănu
 Verificat Ing. L. Bădări
 Conf. STAS Ing. O. Roman
 Aprobat Ing. H. Tilihoi

Masa netă: 3,44 kg


ELC 32 - 12.0A

**I.S.P.C.F.
E.I.E.U.**

Scara:
1:2
(1:1)

**FIXATOR CURBAT
PTR STALPUL MEDIAN DCM**

CDL ELECTRIFICARE-IC Data:

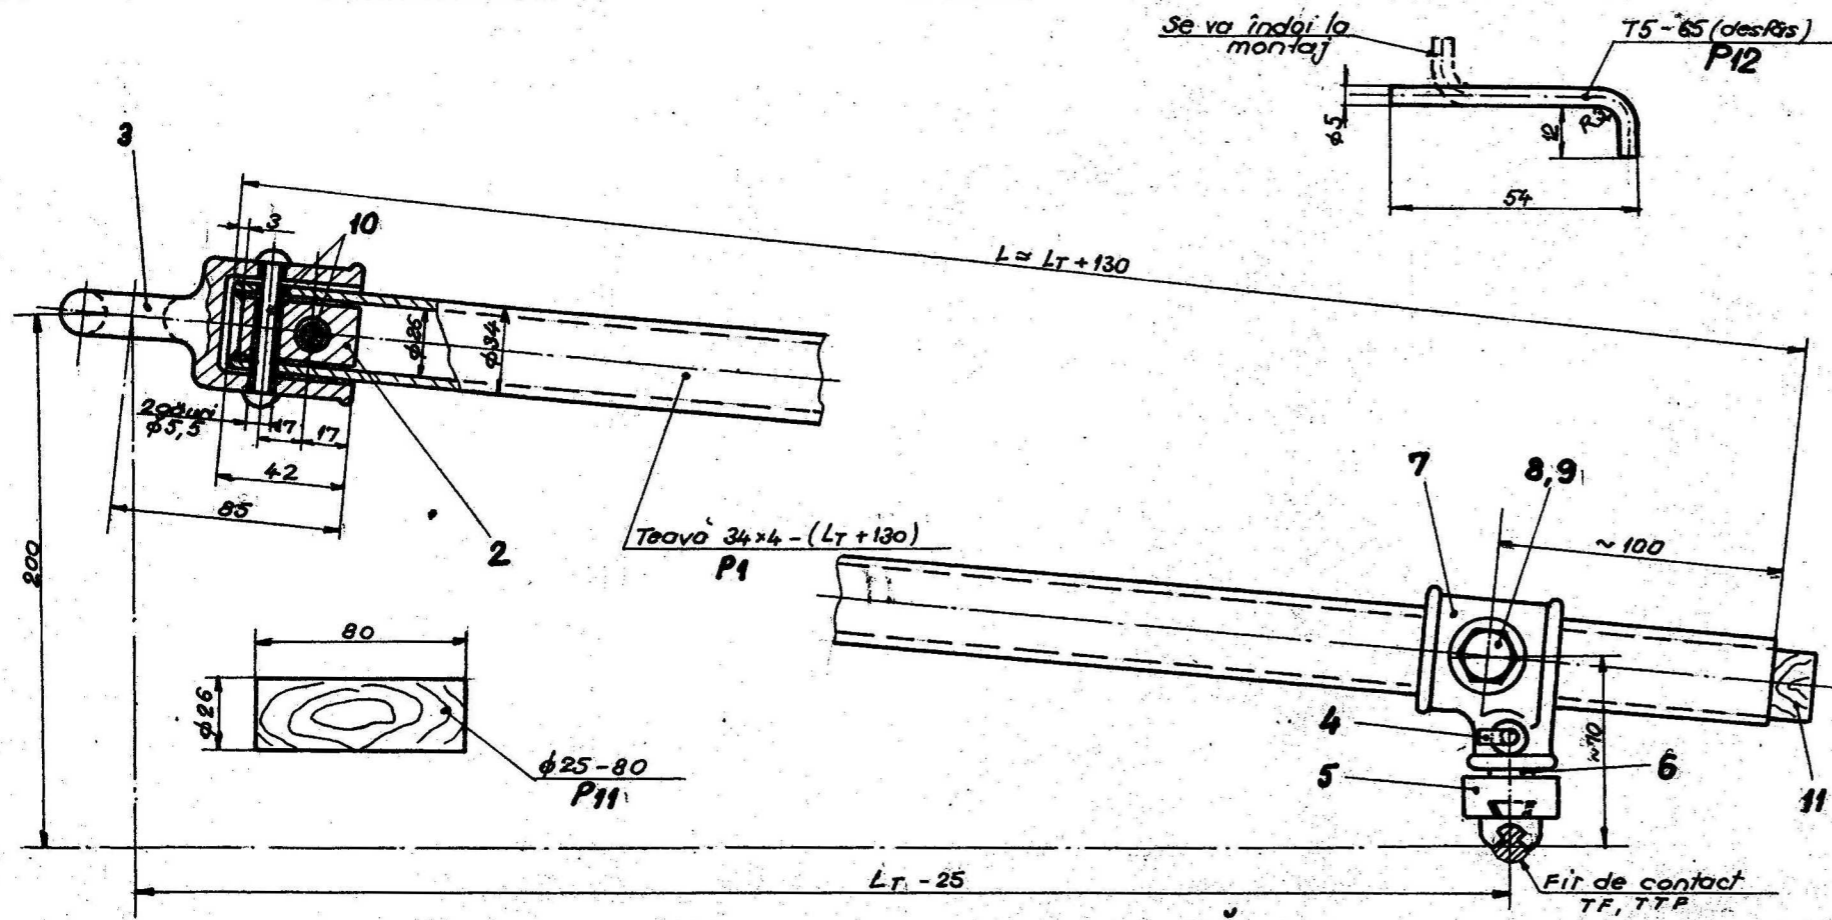

NOTĂ:
 5. Reperele 8 și 9 se vor zincă AT/OL/Zn 500-STAS 7221-90
 cu excepția filetelor AT/OL/Zn 310.

NOTA
 1. După sudarea dopului poz. 11, bara poz. 1 se va zincă AT/OL/Zn 500-STAS 7221-90
 2. Muchiile barei se vor țese 1x45°
 3. Cota Lt se va lua din fișa de montaj.

DG 1
 Nintan
 Șef proiect
 Ing. Cr. Popescu

Poz.	Denumirea	Nr. desen sau STAS	Quc	Material	Observații	Masa netă
11	Dop	-	1	Lemn țig sudronat		0,020
10	Niț 5x60	STAS 797-80	2	15 Cr 08		0,009
9	Piuliță M12-04	STAS 922-89	1			0,016
8	Șurub M12x30-4.6	SR ISO 4016-94	1			0,040
7	Mufă	ELC 32 - 13.7.A	1	B 35 - 10		0,350
6	Cioc filetat	ELC 32 - 13.6.A	1			0,080
5	Placă de fixare spiralată pt. fit de contact TTF	ELC 32 - 9.5-5.0B	1			0,205
4	Siguranță	-				0,050
3	Mufă terminată 1" cu carlig	ELC 32 - 2.2	1	B 35 - 10	SR ISO 922-89	0,680
2	Știft	ELC 32 - 2.4	1	OL 37.2	T25 STAS 1000-87	0,160
1	Bară	-	1		TEAVĂ 34x4 STAS 20411-87	
Masa netă:						

Proiectat în. Măneanu
 desenat. Badea F.
 Verificat în. Badea L.
 Contr. STAS în. Raman O.
 Aprobat în. Iliechi H.



ELC 32 - 13.0.A

I.S.P.C.F.
 EIEU

Scara:
 1:2

FIXATOR DE ANCORARE

COL. ELECTRIFICARE - LG DOTO: V.1997

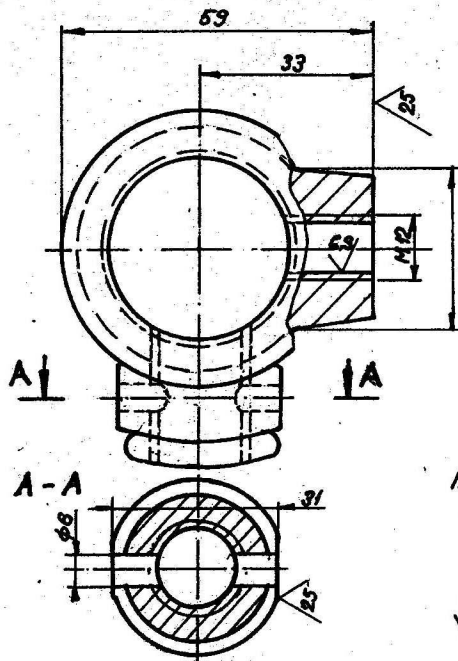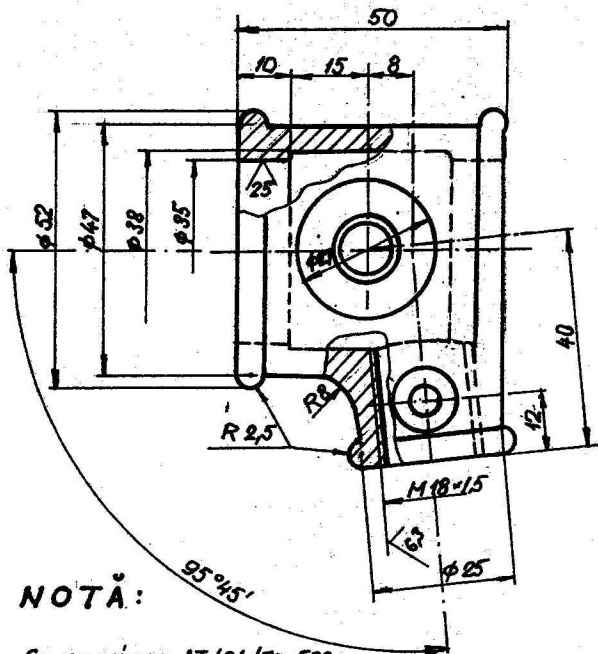


D. G. I.
Bintay
 Șef proiect
 Ing. G. Popescu
 50 ✓ ✓

NOTĂ:

1. Se va zincua AT / OL / Zn 500 - STAS 7291 - 90
2. Piesa se poate obtine si prin prelucrarea (filetarea) mușei vechi, des. ELC 32-13-4-1 după care se va rezinca AT / OL / Zn 300.

Proiectat	Ing. D. Novileanu		
Desenat	R. Novileanu		
Verificat	Ing. L. Bogdan	B 35 - 10	ELC 32 - 13.7A
Contr. șt.	Ing. O. Roman	Masa nr. 10 - U. 3510	
Aprobat	Ing. H. Tilihă		
I. S. P. C. F. E. I. E. U.		Scara: 1 : 1	M U F Ă
COL. ELECTRIFICARE - L.C. Data: VI - 1997			

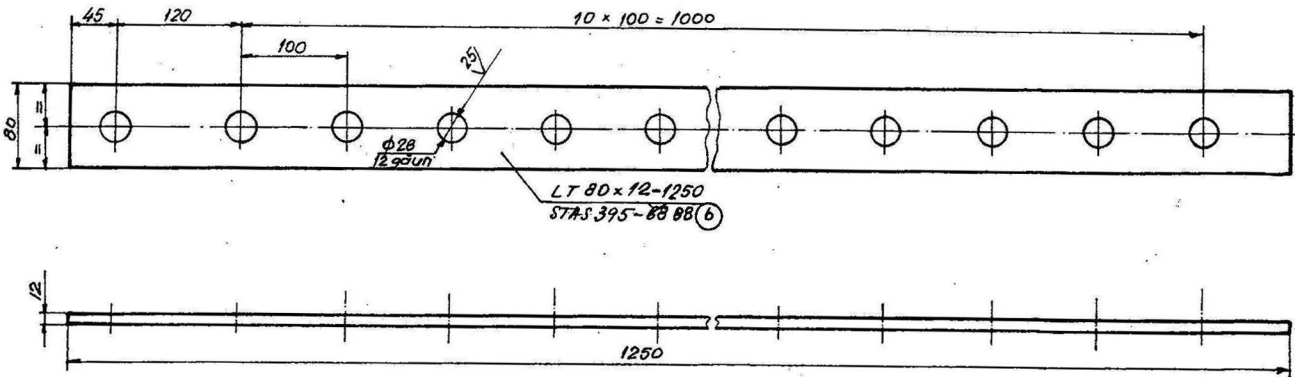

SEF PROIECT
ING. SPACK I.

DE ACORD
CONSTRUCTOR

C.T.E.
ING. CIORTAN P.

6
90

- NOTA AT/OL/Zn 610 STAS 7221-82
- Se va zina ~~AE/OL/Zn 40-345-85~~ STAS 7222-74
 - Prezentul plan are la baza desenul LC/A 48-D1.2.

b 2	Actualizat STAS.	28.10.96	ing. Novleanu
a 1	conf. minuta 24, 14.84	25.11.84	ing. Novleanu
Proiectat	Ilie Traian	24	
Desenat	Badea F.	24	
Verificat	ing. Spack I.	24	
Contr. STAS	Ilie Traian	24	
Approbat	ing. Schmidt	24	

OL 37-2K


Masa netă: 9,500kg.

E-LC-49 17


I.P.C.F.
EIEU
CDL. ELECTRIFICARE - LC2

Scara:
1:5
Data: XI.1976


PLACA DE
REGLARE

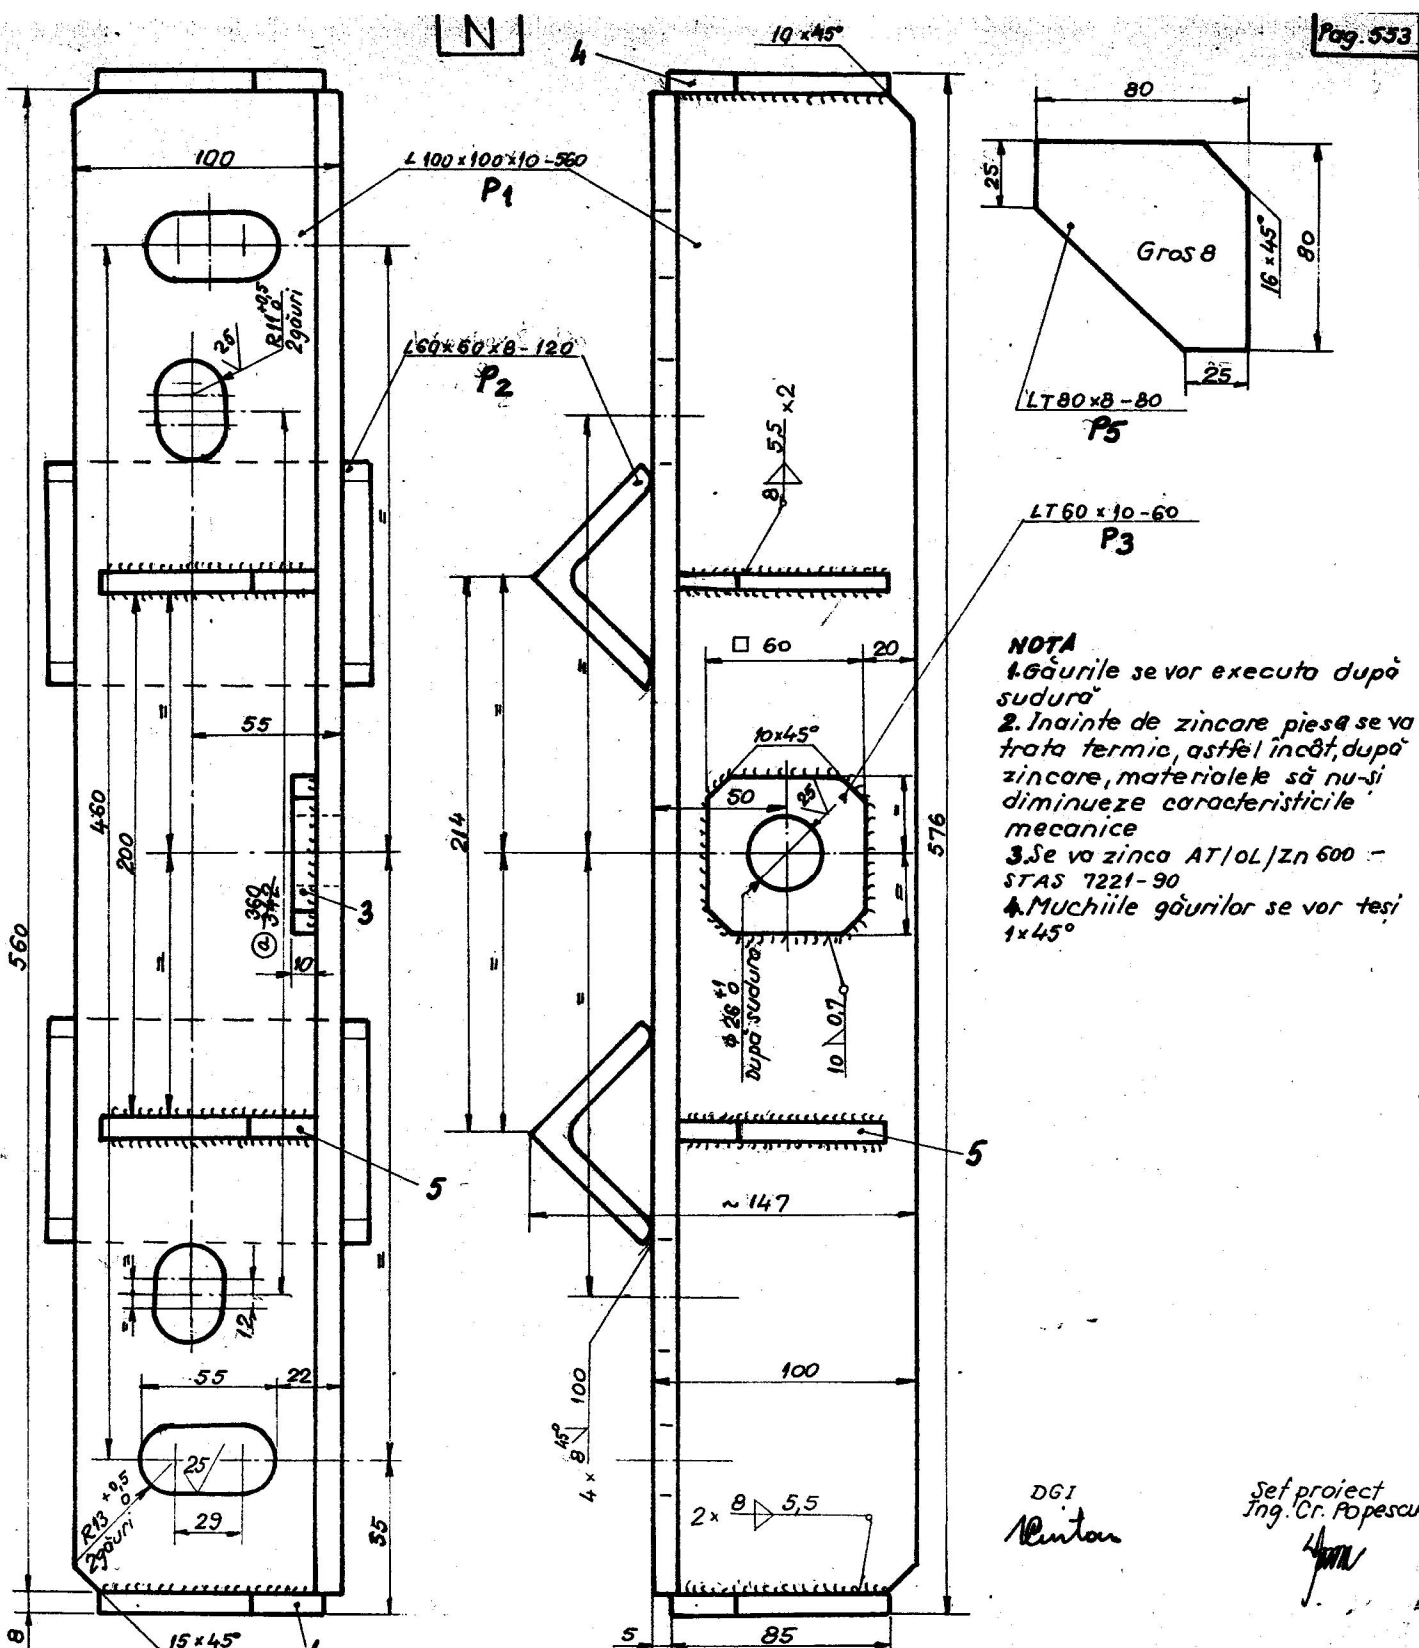

DGI
 Nintan
 Șef proiect
 Ing. Cr. Popescu

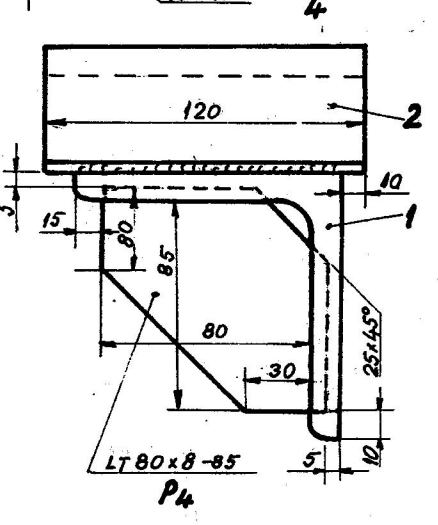

Poz	Denumirea	Hr. desen sau STAS	Buc	Material	Observatii	Masa neta
5	Nervura	—	2	OL 37.2	LT 80x8 STAS 395-88	0,300
4	Nervura	—	2	OL 37.2	LT 80x8 STAS 395-88	0,310
3	Adaos	—	1	OL 37.2	LT 60x10 STAS 395-88	0,280
2	Distanțier	—	2	OL 37.2	L 60x60x8 STAS 424-91	0,850
1	Lonjeron	—	1	OL 44.2	L 100x100x10 STAS 424-91	8,400
Paz		Denumirea	Hr. desen sau STAS	Buc	Material	Observatii
a. 1 Adaptat pe stăb. exist. 22.08.01 Ing. Novacanu Proiectant Ing. Novacanu Desenat Rodea F. Verificat Ing. Romoș Contr. STAS Ing. Mișu I. Abrobat Ing. Tilișchi I.						
IS PCF EIEU COL. ELECTRIFICARE - LC			SCARA: 1:2 data: x.1997		ELC 50 - 3.1A TRAVERSA PTR. SECP 6	

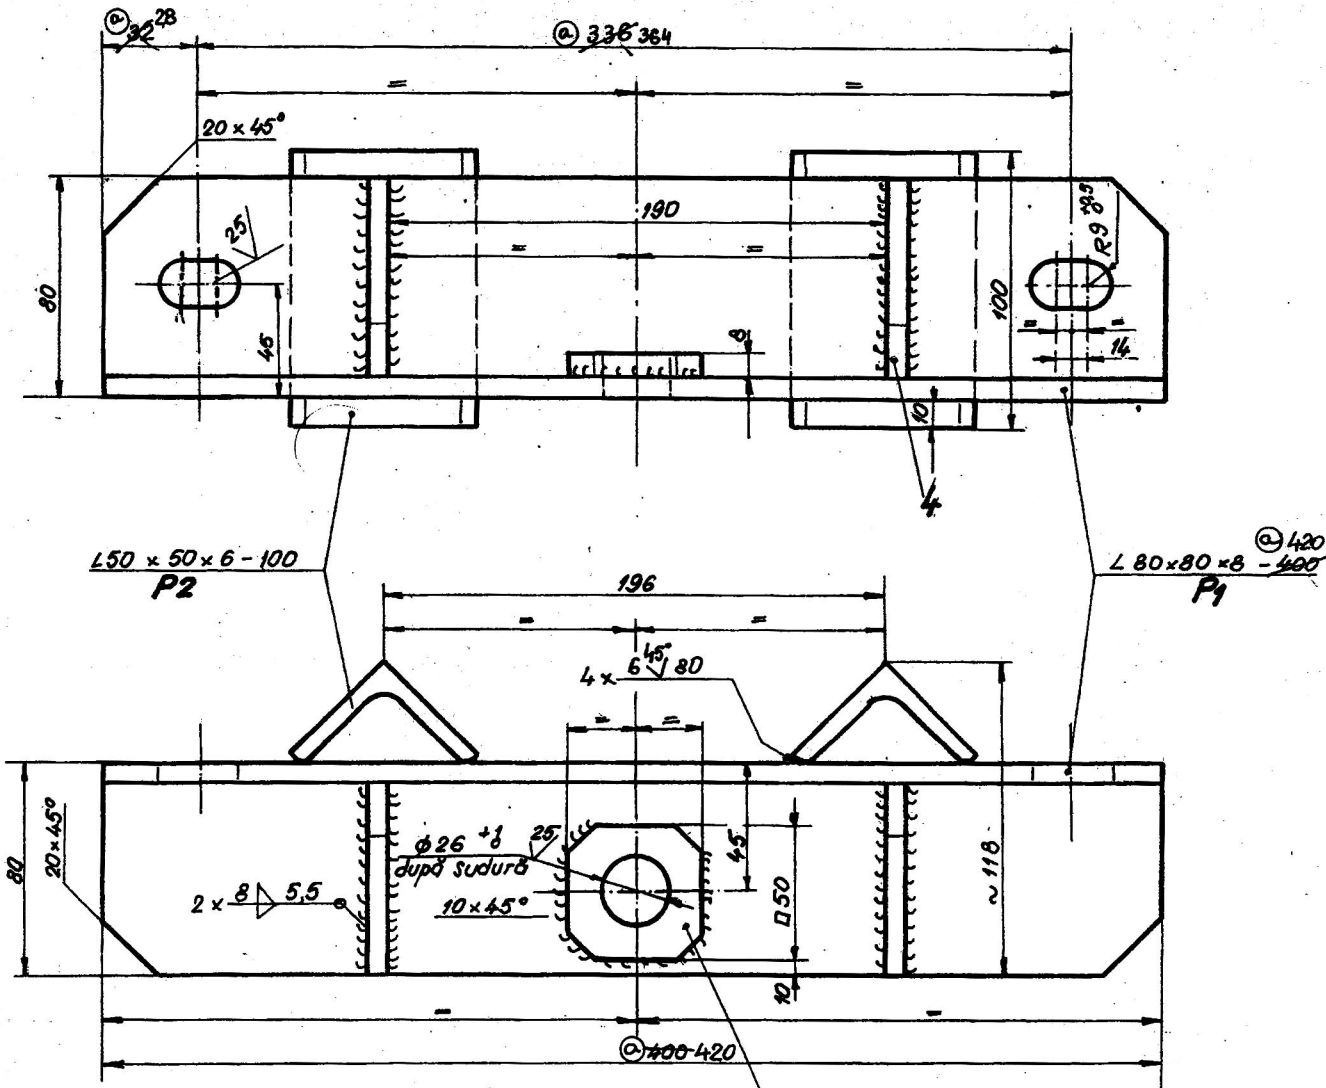


NOTA

1. Găurile se vor executa după sudură
2. Înainte de a încadra piesa va fi supusă unui tratament termic de detensionare ales astfel încât, după răcire, caracteristicile mecanice ale materialelor să nu fie diminuate
3. Se va utiliza AT/DL/Zn 600 - STAS 7221-90
4. Muchiile găurilor se vor teji 1x45°.

DGT
Bintan


Set proiect
Ing. Cr. Popescu

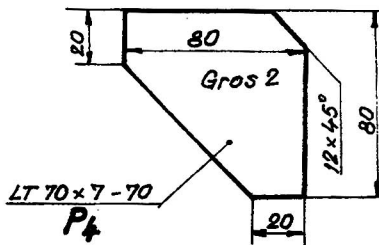

50

Poz	Denumire	Nr. desen sau STAS	Buc	Material	Observatii	Masa netă kg/buc
4	Nervură	—	2	OL 37.2	LT 70 x 7	0,220
3	Adaos	—	1	OL 37.2	LT 50 x 8 STAS 395-88	0,120
2	Profil	—	2	OL 37.2	L 50 x 50 x 6	0,360
1	Lanjeron	—	1	OL 37.2	L 80 x 80 x 8 STAS 424-91	3,850

<p>2.4. Alaplat se stabilesc exist. 22.08.71. Ing. Norbanu</p> <p>Proiectat Ing. Norbanu</p> <p>Desenat: Horgan M. J. J. J.</p> <p>Verificat: Horgan M. J. J. J.</p> <p>Contr. Ing. Miutic I. S. S. S.</p> <p>Aprubat: Ing. Tilihich I. S. S. S.</p> <p>Masa netă: 5,15 kg</p>		<p>ELC 50 - 13.1A</p>
<p>I.S.P.C.F. EIEU</p>	<p>Scara</p>	<p>TRAVERSA</p>
<p>COL. ELECTRIFICARE - LC</p>	<p>Data</p>	

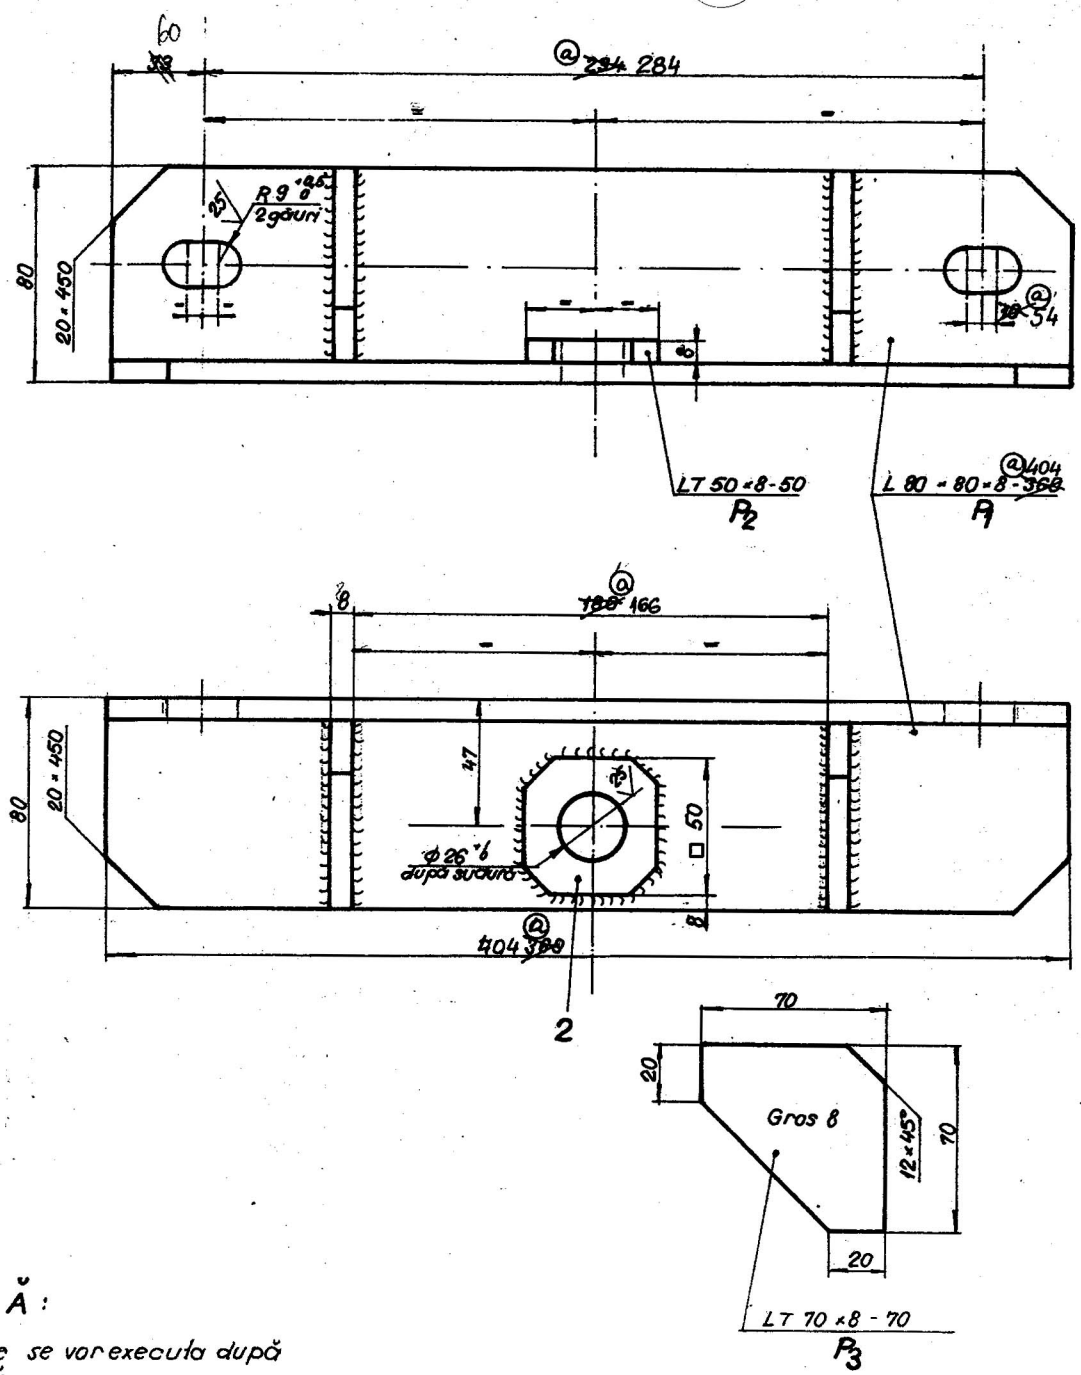

NOTĂ:

1. Găurile se vor executa după sudură.
2. Înainte de zincare piesa se va trata termic, astfel încât după zincare caracteristicile mecanice ale materialelor să nu fie diminuate.
3. Se va zincea AT/OL/Zn600 STAS 7221-90
4. Muchiile găurilor se vor țeși 1 x 45°.

D. G. I.
Dimitrie

șef proiect:
Ing. Cr. Popescu

50

Poz.	Denumirea	Nr desen sau STAS	Buc.	Material	Observatii
3	Nervură	-	2	OL 37-2	LT 70 x 8 0,220
2	Adaos	-	1	OL 37-2	LT 50 x 8 STAS 595-88 0,120
1	Lonjeron	-	1	OL 37-2	L 80 x 80 x 8 STAS 424-91 0,230


0.17 Modificare proiect 14.09.01 Ing. Abileanu
 Proiectat Ing. D. Novleanu
 Desenat R. Novleanu
 Verificat Ing. D. Roman
 Contr. STAS Ing. I. Miuli
 Aprobat Ing. H. Tilihoi

ELC 50 - 14.1A

I. S. P. C. F.
E. I. E. U.


Soara:
1:2

TRAVERSĂ

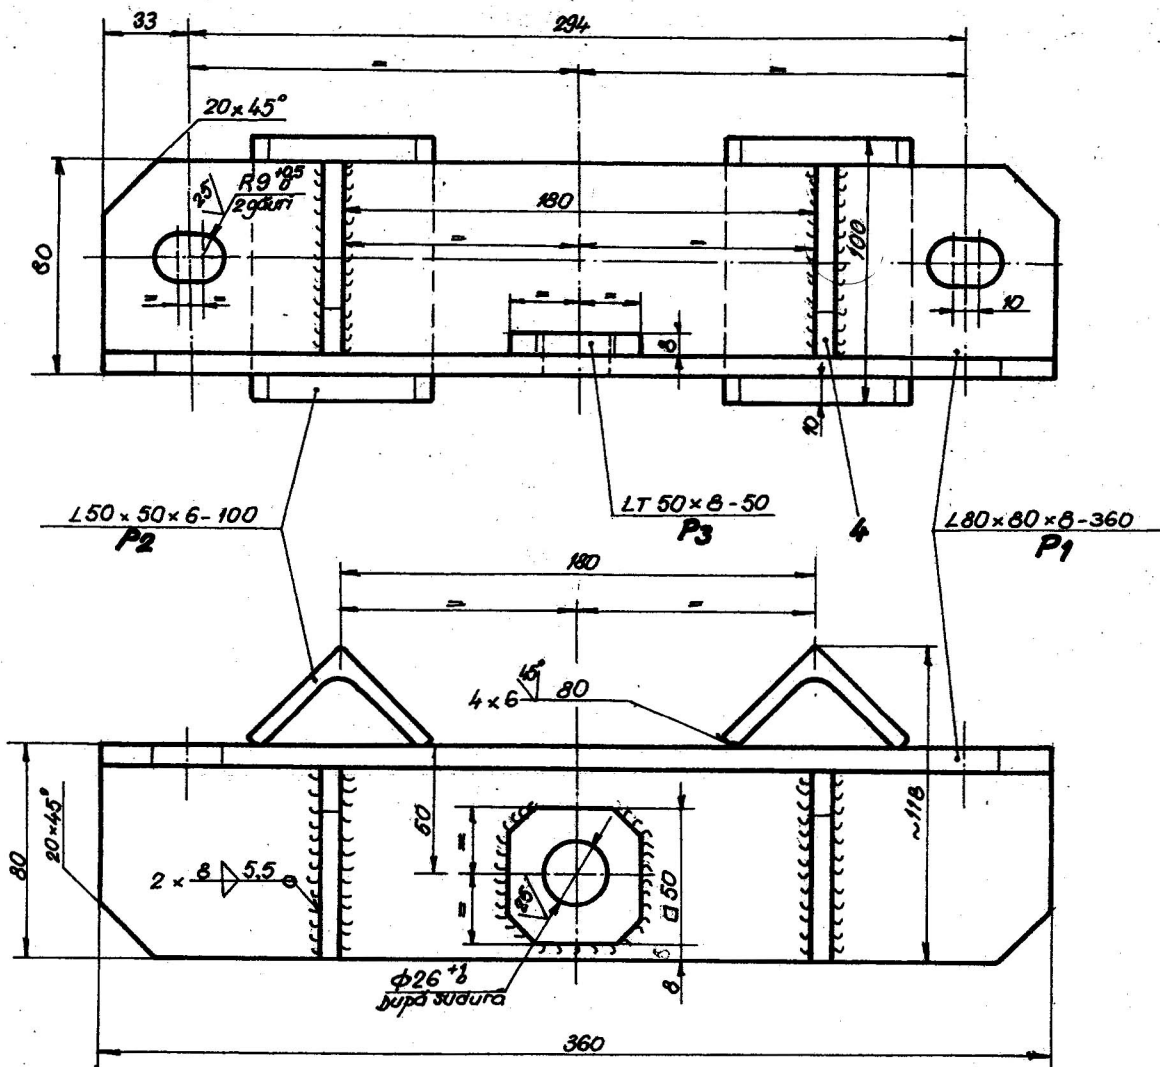

NOTA'

1. Găurile se vor executa după sudură.
2. Înainte de zincare, piesa va fi supusă unui tratament termic, astfel ales încât după zincare caracteristicile mecanice ale materialelor să nu fie diminuate.
3. Se va zincă AT/OL/Zn 600 - STAS 7221-90
4. Muchiile găurilor se vor tesa, 1x45°

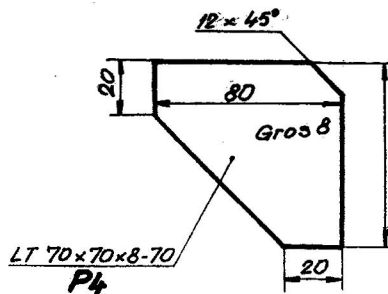

DGI,
Runtan

Sef proiect
Ing. Cr. Popescu

LM

4	Nervură	—	2	OL 37.2	LT 70x8	0,220
3	Adaos	—	1	OL 37.2	LT 50x8 STAS 395-88	0,120
2	Profil	—	2	OL 37.2	L 50x50x6	0,360
1	Lonjeron	—	1	OL 37.2	L 80x80x8 STAS 424-91	3,470

Proiectat: Vnz. Navicanu
Desenat: Neagu M
Verificat: Ing. Roman D
Cons. STAS: Ing. Murel J
Aprobat: Ing. Tillich H

Masa netă: 4,9 kg


I.S.P.C.F
EIEU

Scara
1:2

ELC 50 - 15.1A

TRAVERSA'

E

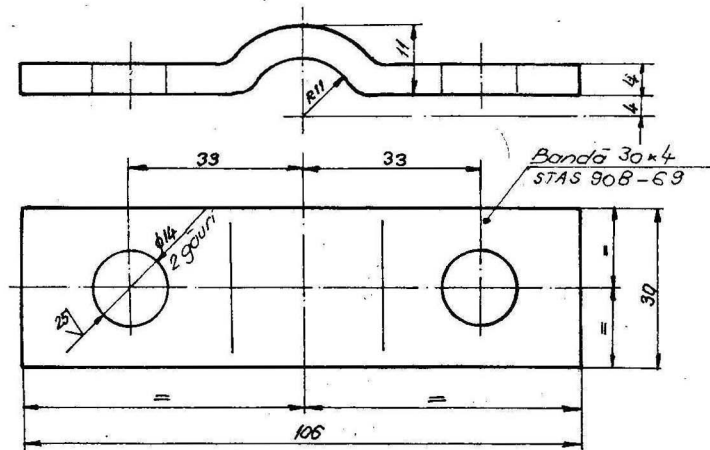

NOTA

- Se va zincea AEFOT/2n 40-AT/OL/2n 610
SLT/FS STAS 7222-74 STAS 7221-82 (A)
30 (B)
- Prezentul plan are la
baza desenul LCJA 44-07.

C.T.E.

ING. CIORTAN P.

SEF PROIECT


ING. SPACK I.

DE ACORD

CONSTRUCTOR

61	Completari	06.10.96	ing. H. B. G. G.				
91	conf. minuta	24.11.84	26.11.84	ing. H. B. G. G.			
Proiectat Ilie Traian							
Desenat Badea F.							
Verificat Ing. Spack I.					DL 37.2K		
Contr. STAS Ilie Traian							
Aprobat Ing. Schmidt					Masa neta: 1.500 Kg.		
I. P. C. F.				Scara:		E-LC-51.22	
EIEU				1:1			
COL. ELECTRIFICARE - LC2				Data: XII.1976		SCOABA	

N

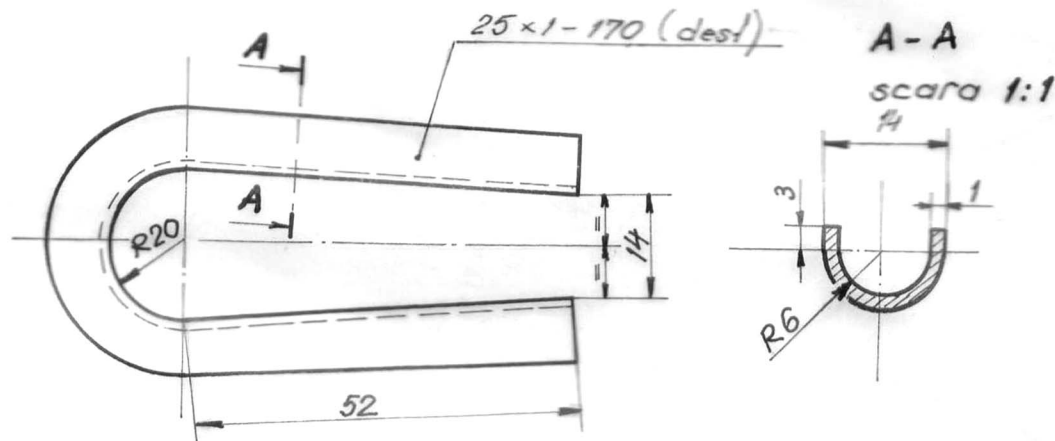

NOTA



1. Se va zincea AT/OL/Zn 500
STAS 7221 - 90
2. Prezentul plan are la baza
desenul LC/FO 4235 - 1.0

De acord DGI,
Centru

Se proiect,
Inq. C. Popescu

Proiectat Ilie Traian		TDAI	ELC/CFO 1-8
Desenat Neagu M.			
Verificat Inq. Bădăi L.			
Contr. STAS Inq. Navileanu D.			
Aprobat Inq. Tilichi H.			
ISPFC EIEU		Masa netă: 0,035kg	RODANȚĂ
Col. electrificare - LC		scara 1:1	
		Data: 05.1996	

N

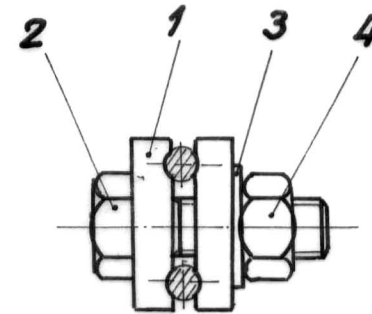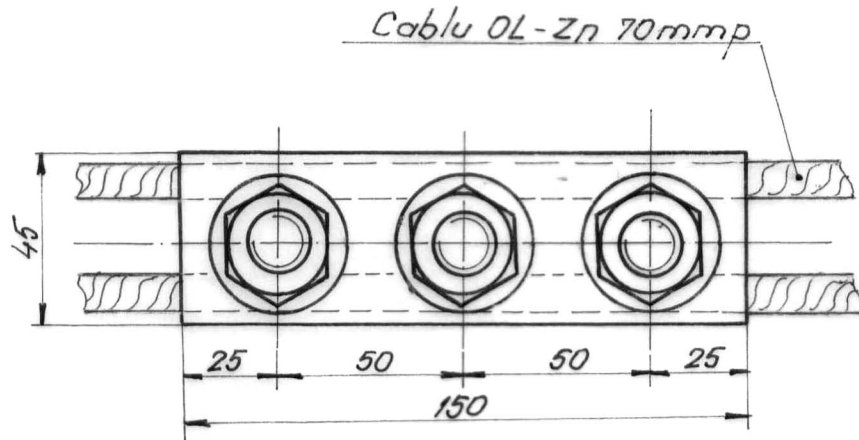

De acord DGI,

Set proiect

Handwritten signature

Handwritten signature

NOTA

Filetele se vor zince:
AT/OL/Zn 310 STAS 7221-90

Poz.	Denumire	Nr. desen sau STAS	Buc.	Material	Observ.	Masa netă kg/buc
4	Piuliță M16 gr.4.6	STAS 922 - 89	3			0,030
3	Șaibă 18	STAS 5200/4 - 91	3			0,011
2	Șurub M 16x50-gr.4.6	SRISO 4017-94	3			0,110
1	Falcă clemă	ELC/CFO 1 - 12.1	2	OL 37.2		0,480

Proiectat *Ilie Traian*
Desenat *Neagu M.*
Verificat *Ing. Bădăi L.*
Contr. STAS *Ing. Novleanu D.*
Aprobat *Ing. Tilichi H.*


Masa netă: 1,42 Kg
scara
1:2

ELC/CFO 1-12.0



**CLEMA DE LEGARE CU
TREI ȘURUBURI**

Col. electrificare - LC

Data: 05.1996

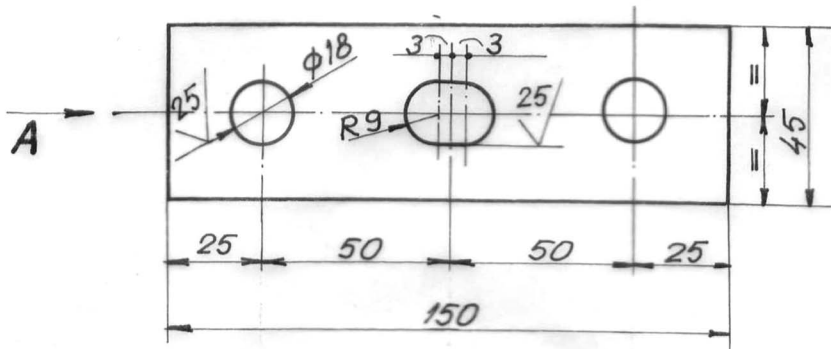

POZITIA GĂURILOR PENTRU
A DOUA FALCĂ

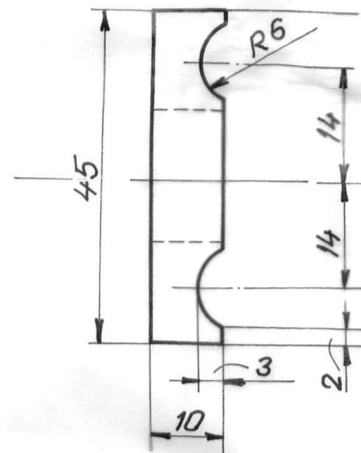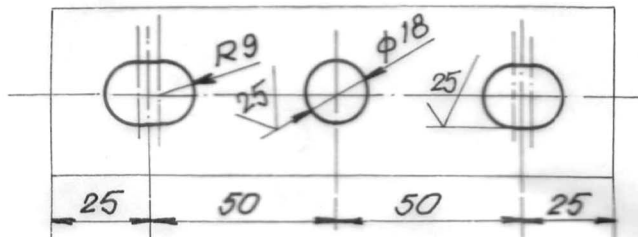

NOTA


1. Se execută 1 buc. conform desen și 1 bucată cu găurile conform detaliului alăturat.
2. Piesele se vor zincea AT/OL/Zn 600 STAS 7221-90
3. Muchiile se vor rotunji cu R1

De acord DGI

Seș proiect
Ing. C. Popescu

Proiectat Ilie Traian		OL 37.2	ELC/CFO 1-12.1
Desenat Neagu M.			
Verificat Ing. Bădăi L.			
Contr. ST 15 Ing. Novleanu			
Aprobat Ing. Tilichi H.		Masa netă: 0,48 Kg	FALCĂ CLEMĂ
ISPCF EIEU		scara 1:2 (1:1)	
Col. electrificare - LC		Data: 05.1996	

Consolă susținere
poz 2+14 în plan ELC/CFO 29-0

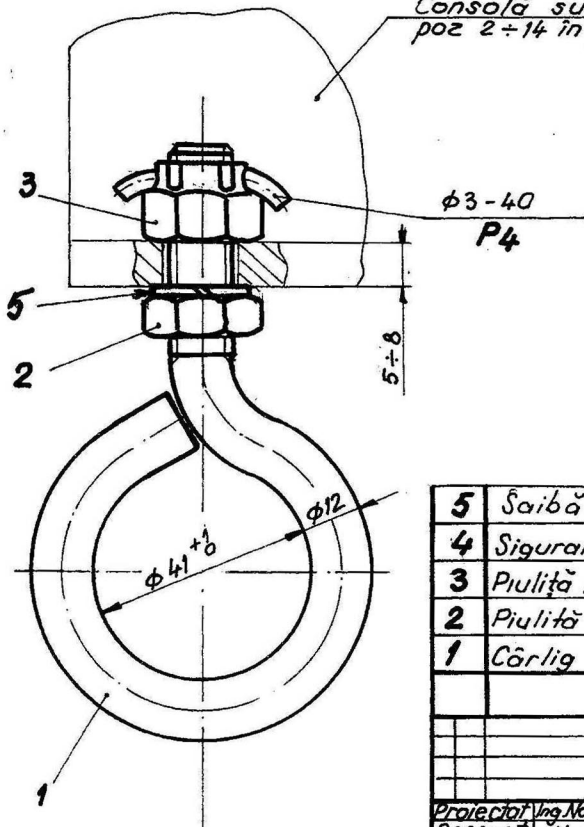

5	Saibă M12	SR 7666/2-94	1	OLC55	Zincat	0,003
4	Sigurantă	-	1	15Cr 08	sârmo $\phi 3$	0,003
3	Piuliță M12-gr.4.6	STAS 4073-90	1		zincat	0,019
2	Piuliță M12-gr.4.6	STAS 922-89	1		zincat	0,016
1	Cârlig	ELC/CFO 3-15.1B	1	OL 37.2		0,142

Proiectat Ing. Novleanu L.
Desenat Neagu M.
Verificat Ing. Roman O.
Centr. STAS Ing. Roman N.
Aprobat Ing. Tilichi H.

Masa netă: 0.18 Kg

I.S.P.C.F.
EIEU

Scara
1:1


ELC/CFO 3-15.0B

CÂRLIG TIP A



COL. ELECTRIFICARE-LC Data: 02.2000

NOTA

1. Cârliqul se va torza la căld.
2. Se va zincă AT/OL/Zn600 cu excepția filetului AT/OL/Zn310 STAS 7221-90.
3. Înainte de zincare se va detensiona prin tratament termic astfel încât după zincare, caracteristicile mecanice ale materialului să nu fie diminuate.
4. După zincare se va grundui și vopsi cu vopsea din două componente, nuanță verde închis.

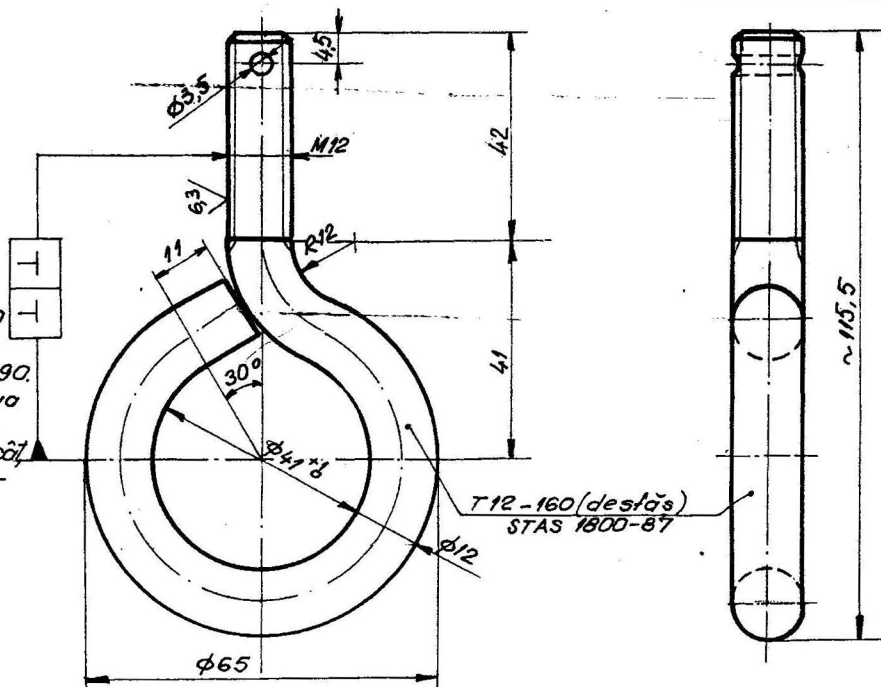

Proiectat	Vn. Năveanu				
Desenat	Negoiu M.	PLA			
Verificat	Vn. Roman O.	PLA			
Contr.	STAS Ia Roman N.	PLA			
Aprobat	Vn. Tilici H.	PLA			
			OL 37.2		ELC/CFD 3-15.1B
			Masa netă: 0,142kg		
			scara 1:1		
I.S.P.C.F. EIEU					CÂRLIG
COL. ELECTRIFICARE-LC			Data: 02.2000		

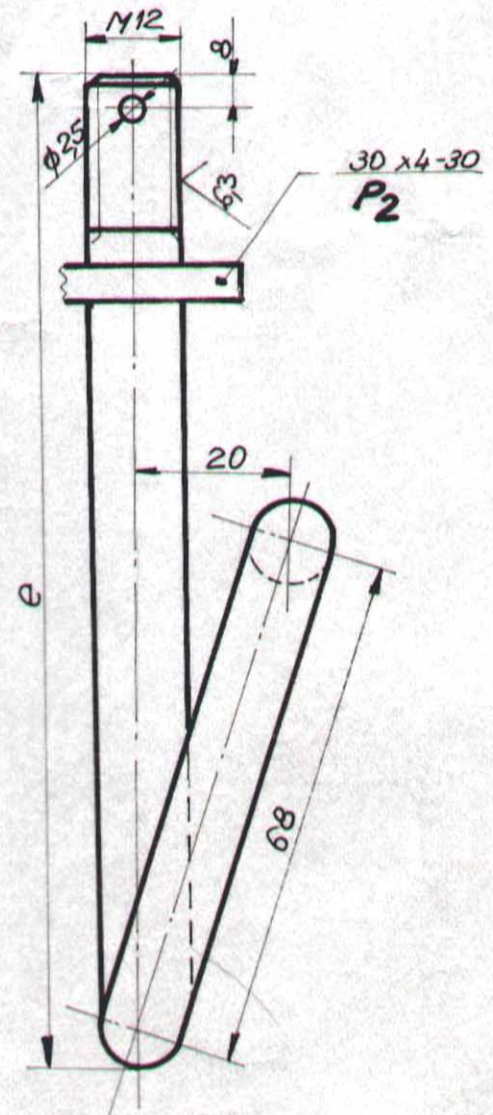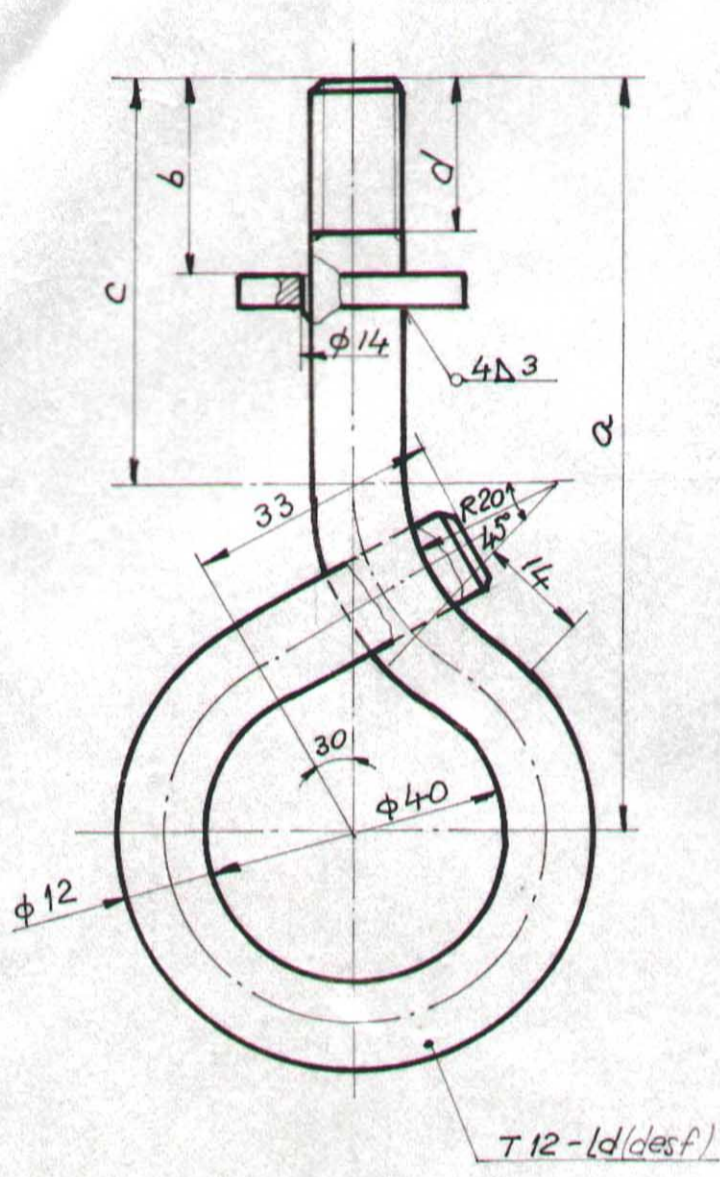

TIP	a	b	c	d	e	ld	Masa (kg)
I	85	30	40	25	137	210	0,24
II	125	80	80	25	158	250	0,28

NOTA

1. Prezentul plan are la bază des. LC/FO 4235-3.15.0
2. După sudarea elementelor, se va zincea AT/OL/Zn 600 STAS 7221-90 și filetele se vor zincea AT/OL/Zn 310 STAS 7221-90

De acord DGI,
Winkler

Sef proiect
 ing. C. Popescu

Poz.	Denumirea	Nr. desen sau STAS	Buc	Material	Observatii	Masa neta (kg/buc)
2	plăcută	—	1	OL 37.2	Banda 30x4 STAS 908-90	
1	Cârlig	—	1	OL 37.2	T 12 STAS 1800-87	

Proiectat *Ilie Traian*
 Desenat *Badea F.*
 Verificat *ing. Bădăi L.*
 Contr. STAS *ing. Novleanu*
 Aprobata *ing. Tilichi H.*

ELC/CFD 3-15.0


I.S.P.C.F.
EIEU
 COL. ELECTRIFICARE-LC

Scara:
1:1

CÂRLIG

Data: V. 1996


Varianta	Cotă			Masa (Kg)
	R	R+220	L	
I (sta/p SECP6)	165	385	310	2.70
II (sta/p SECP5)	140	360	630	2.37
III (sta/p SECP4)	120	340	570	2.15

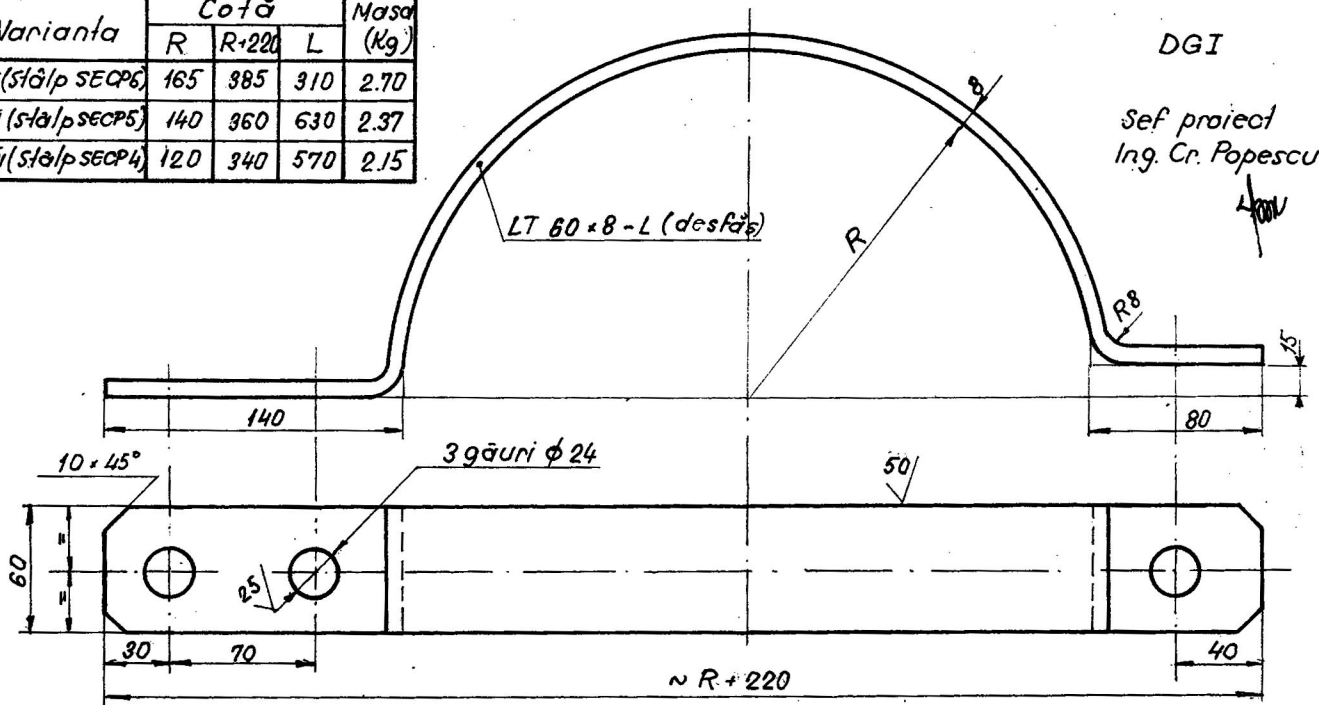

NOTĂ:

Se va zincea AT/OL/Zn610
STAS 7221-90.

Proiectat	ing. D. Noylean		
Desenat	R. Noylean		
Verificat	ing. L. Bădoi		
Contr. STAS	ing. O. Roman		
Approbat	ing. H. Tillich		
I.S.P.C.F. EIEU		RCA-37 OL37-2	EP 2610 - 4.1 A
COL. ELECTRIFICARE-LO		Masa netă:	SEMIBRIDĂ
		Scara: 1:2.5	
		data:	

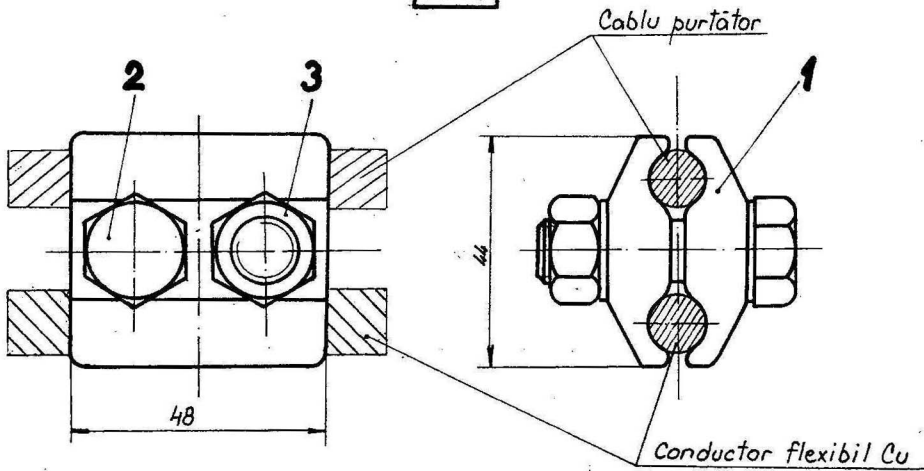

NOTA

Clema este destinata pentru legatura electrica a conductorului de cupru flexibil de 70 mm² cu conductori BM 70 mm², OL Zn 50 mm², OL Zn 70 mm².

C.T.E.
Inq. P. Ciortan

Ptr. conformitate cu desenul original ICPTT
Inq. D. Navleanu

Sef proiect
Inq. I. Spack

De acord
Constructor

3	Piulita M12	STAS 922-76	2	STAS 2700/4-80	Cadmiață sau zincată	0,016
2	Surub M12x40	STAS 920-69	2	STAS 2700/3-80	Cadmiaț sau zincat	0,148
1	Falca clema	LECP-01	2			0,155
Poz.	Denumirea	Nr. desen sau STAS	Buc.	Material	Observații	Masa netă Kg/buc

Proiectat	Inq. Marinescu
Desenat	Sanda I.
Verificat	Inq. Petrescu
Contr. STAS	Inq. Marinescu
Aprobat	Inq. Petrescu

Masa netă:


LECP-00

I.C.P.T.T.

1:1

Data: noe. 1978

CLEMA DE LEGATURA ELECTRICA PE CABLU PURTATOR

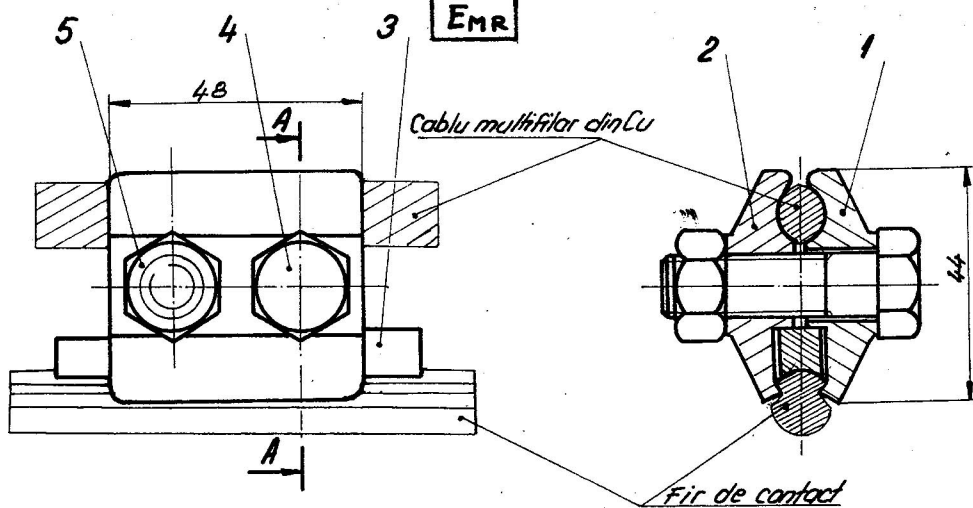

NOTĂ:

Clema este destinată pentru legătura electrică a conductorului de cupru flexibil de 70m² la firul de contact TF 85, TF 100, UIC 80, UIC 100.

După montarea clemei pe firul de contact capătul despicat al penei se va desface.

C.T.E
ing. P. Gortan

Pentru conformitate cu desenul original I.C.P.T.T.
ing. D. Navleanu

Șef proiect
ing. I. Spac

De acord constructor

5	Piulița M12-9r.0.4	STAS 922-76.89	2	STAS 2700/4-80	cadmiat sau zincat	0,0156
4	Surub M12x40-9r.0.4	STAS 920-62	2	STAS 2700/5-80	cadmiat sau zincat	0,0484
3	Pană	LEFC-03	1		se va cașita	0,040
2	Falcă clemă (stg.)	LEFC-02	1			0,155
1	Falcă clemă (dr.)	LEFC-01	1			0,155
Poz.	Denumirea	Nr. desen sau STAS	Buc	Material	Observații	Masa netă

a. 2	Actualizat STAS	24.X.96	ing. Navleanu
	Proiectat	ing. Marinescu	
	Desenat	Sanda I	
	Verificat	ing. Petrescu	
	Contr. STAS	ing. Marinescu	
	Aprobat	ing. Petrescu	

Masa netă: 0,474g

I.C.P.T.T

Scara:
1:1

Data: noi. 1978

LEFC-00
CLEMA DE LEGĂTURĂ
ELECTRICĂ PE FIRUL
DE CONTACT